


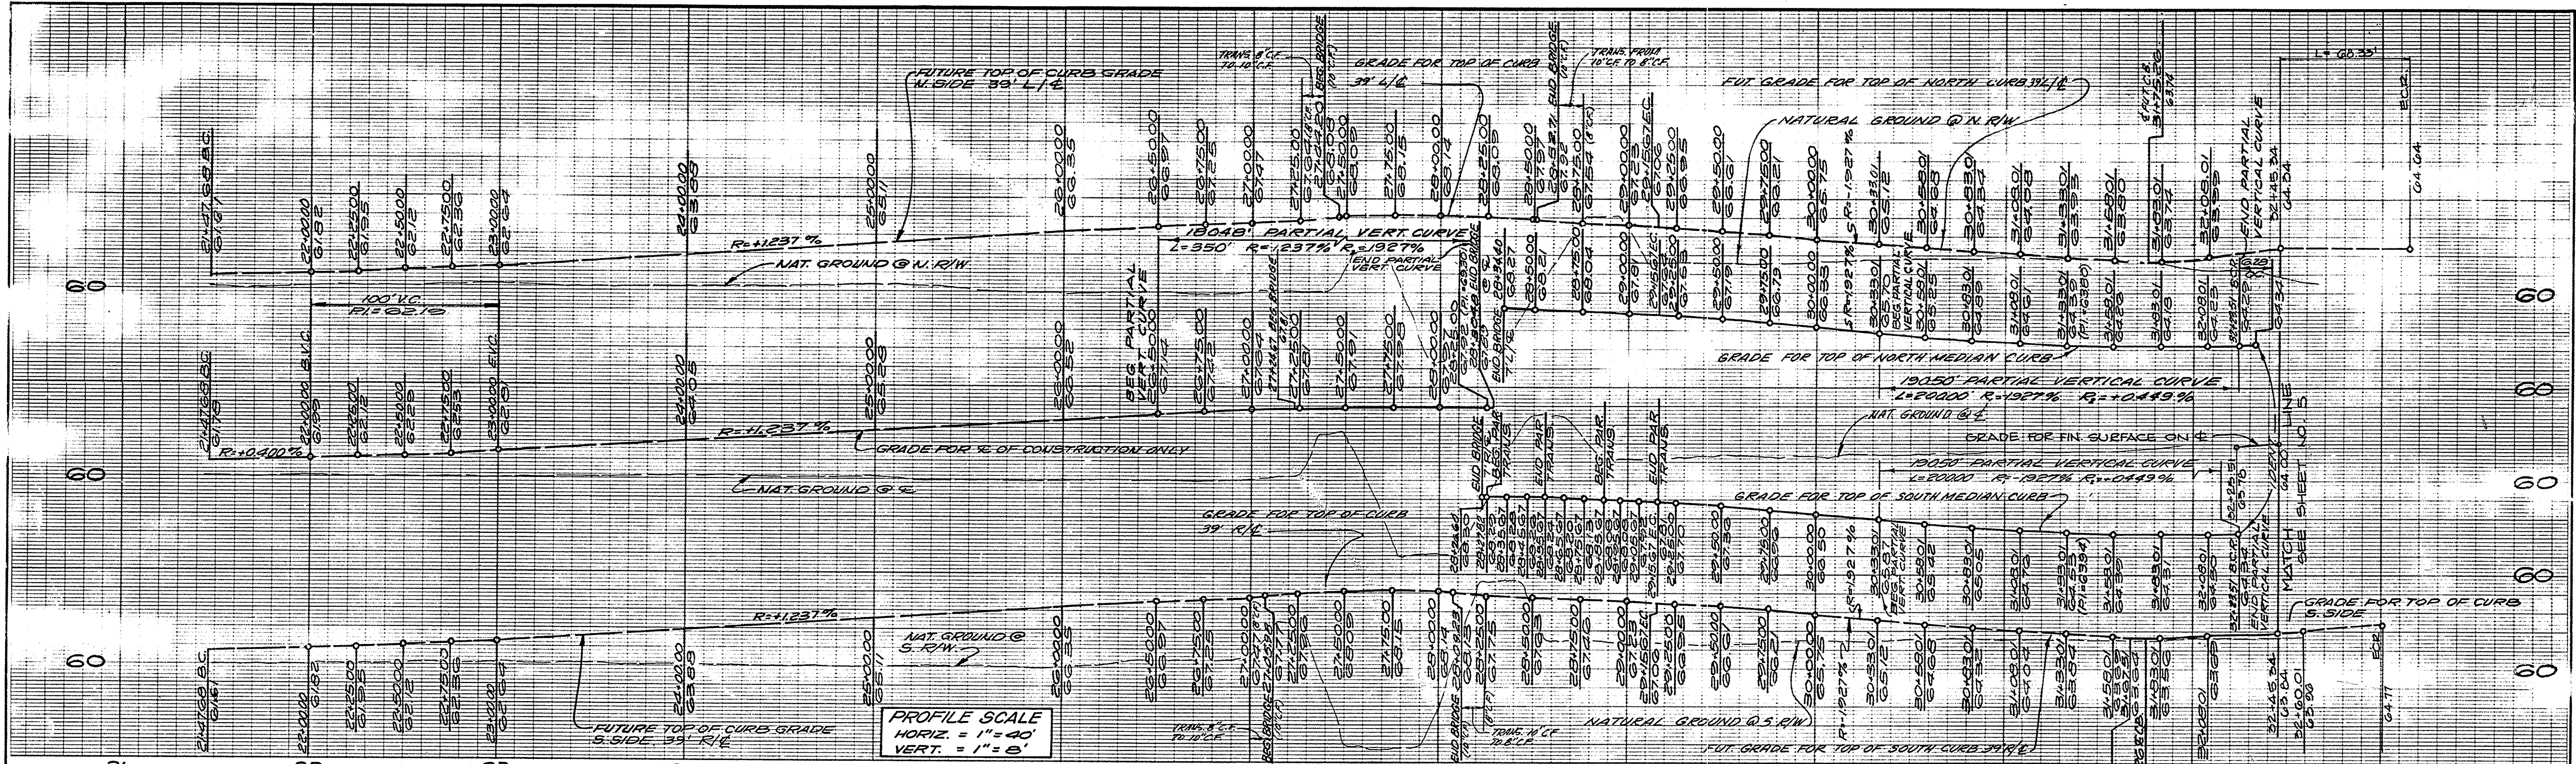


CONSTRUCTION NOTES

1. CONST. 0.40' A.C. WITH SEAL COAT OVER 0.65' A.B. WITH PRIME COAT OVER 0.70' L.T.S. PER TYPICAL SECTION ON SHEET N-2
2. CONST. 0.25' A.C. SHOULDER ON NATIVE SOIL
3. JOIN & FEATHER EXIST. PAVEMENT AS REQUIRED BY FIELD ENGINEER
4. CONST. 4" CURB & GUTTER PER STD. PLAN N-200
5. CONST. CURB & GUTTER PER DETAIL "A" ON SHEET N-2
6. CONST. 6" A.C. BERM PER DETAIL "B" ON SHEET N-2
7. CONST. PARABOLIC CURB TRANSITION PER STD. PLAN N-107
8. ADJUST TO FINISHED GRADE (CONTRACTOR)
9. CONTRACTOR TO SALVAGE & DELIVER TO CITY YARD

11. TO BE REMOVED & RELOCATED BY CONTRACTOR
12. PROTECT IN PLACE
13. CONST. SIDEWALK RETURN PER STD. PLAN N-202
14. CONSTRUCT LOCAL DEPRESSION
15. EARTHWORK & GRADING AS INDICATED ON CROSS SECTIONS SHEET NOS. 21 & 22
16. FOR DETAILS, SEE SH. NO. 17 & 18

NOTE: SEE SH. NO. 8 FOR BRIDGE DETAIL

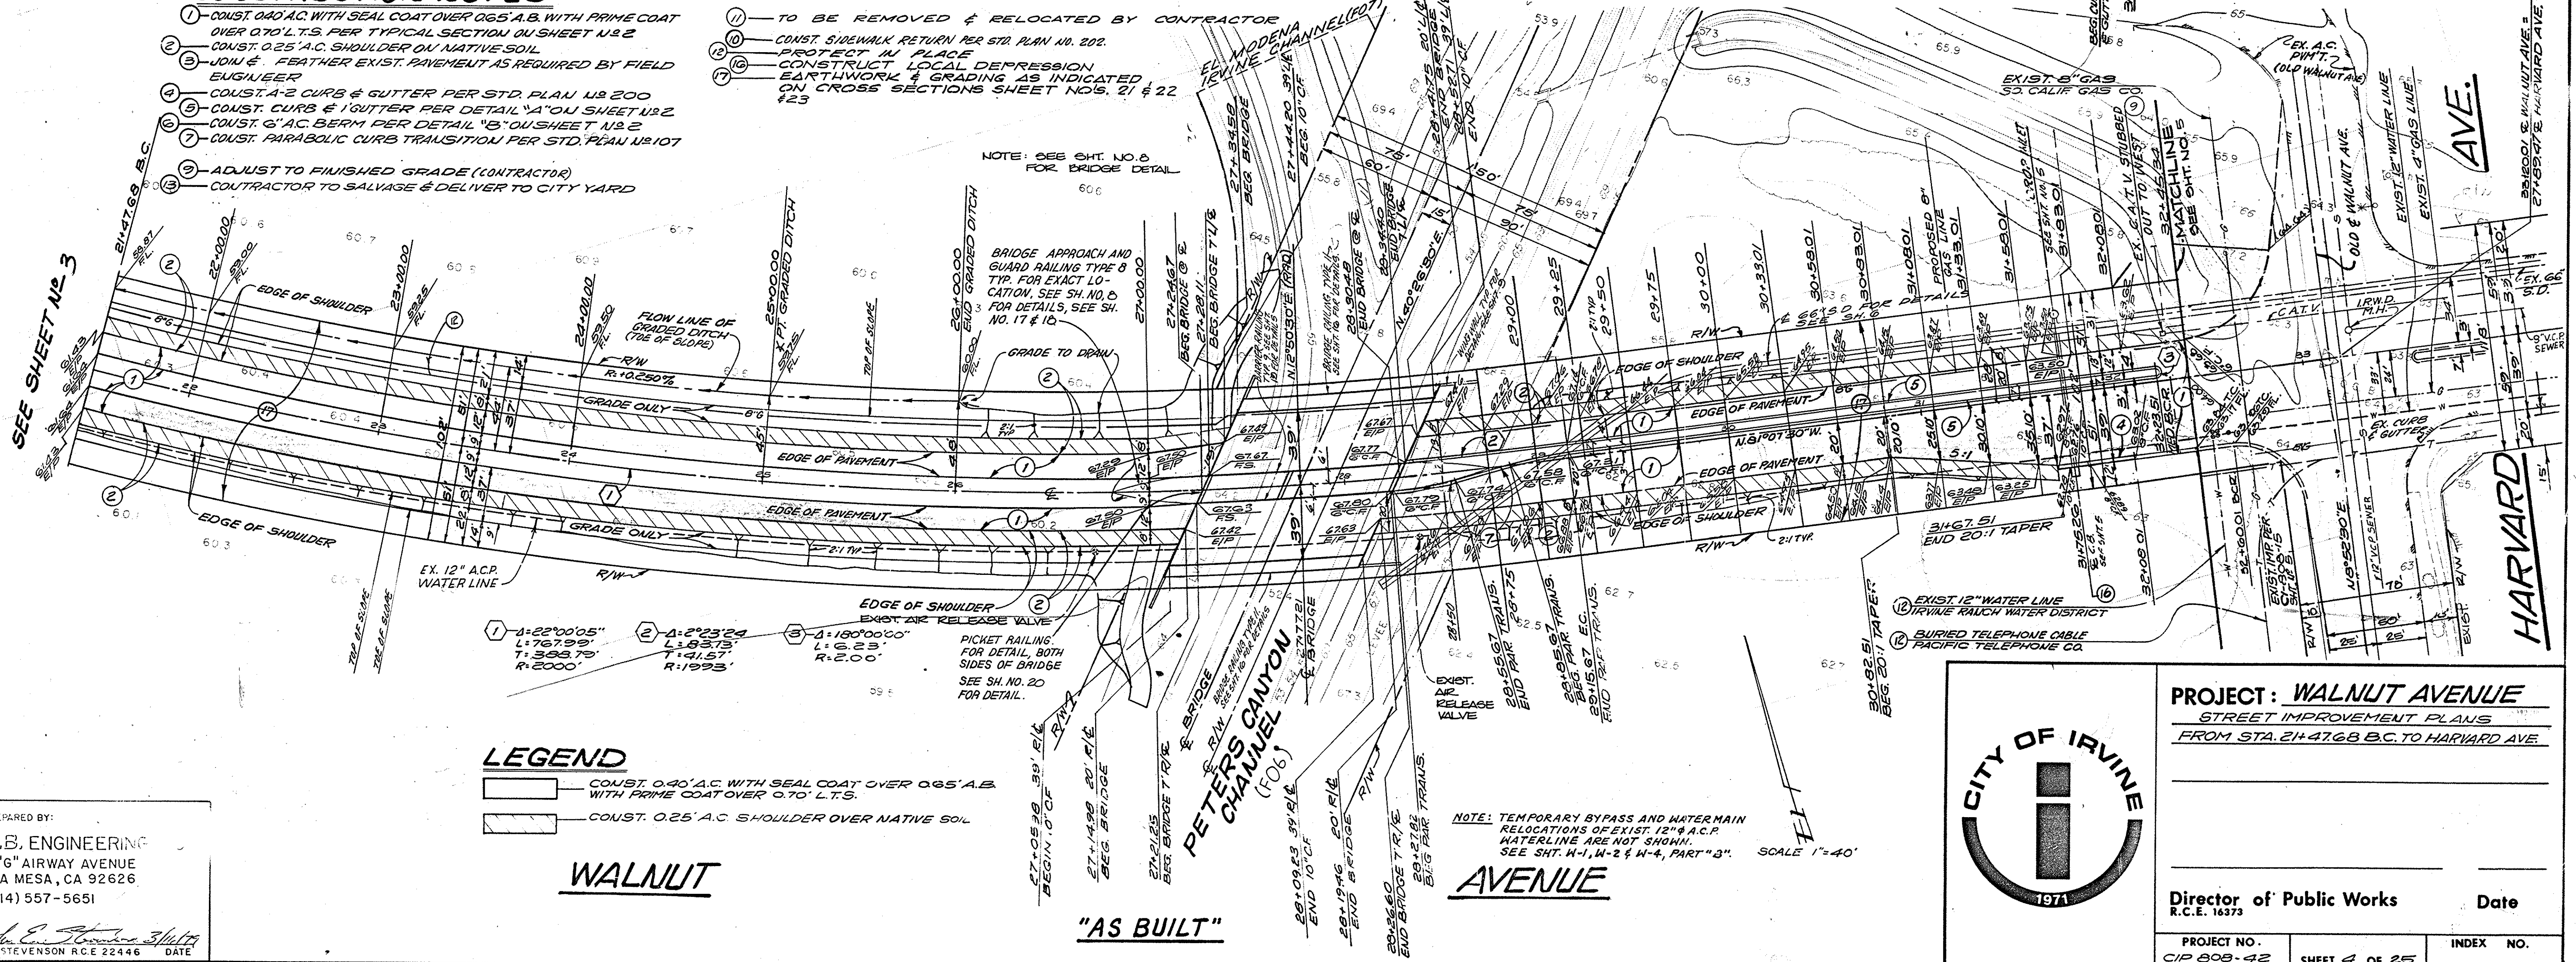


LEGEND

- 0.40' A.C. WITH SEAL COAT OVER 0.65' A.B. WITH PRIME COAT OVER 0.70' L.T.S.
- 0.25' A.C. SHOULDER OVER NATIVE SOIL

WALNUT

"AS BUILT"

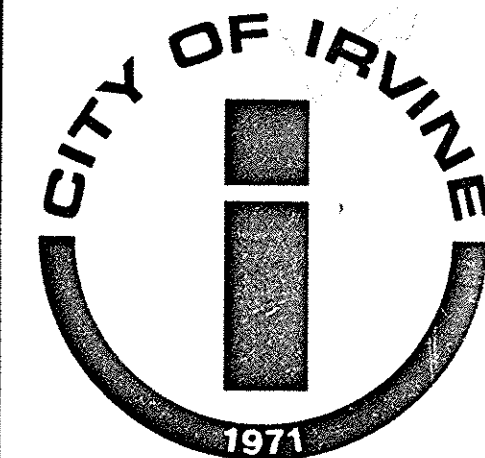

PROJECT: WALNUT AVENUE
STREET IMPROVEMENT PLANS
FROM STA. 21+47.68 B.C. TO HARVARD AVE.

Director of Public Works
R.C.E. 16373

Date

PROJECT NO. CIP 808-42
SHEET 4 OF 25
INDEX NO.

DESIGNED BY:
R.G.B. ENGINEERING
3183 "G" AIRWAY AVENUE
COSTA MESA, CA 92626
PH. (714) 557-5651

JOHN E. STEVENSON R.C.E. 22446
DATE

NOTE: TEMPORARY BYPASS AND WATER MAIN RELOCATIONS OF EXIST. 12" A.C.P. WATERLINE ARE NOT SHOWN. SEE SH. N-1, N-2 & N-4, PART "3". SCALE 1" = 40'

AVENUE

HARVARD

AVE.

21+47.68 B.C. TO HARVARD AVE