
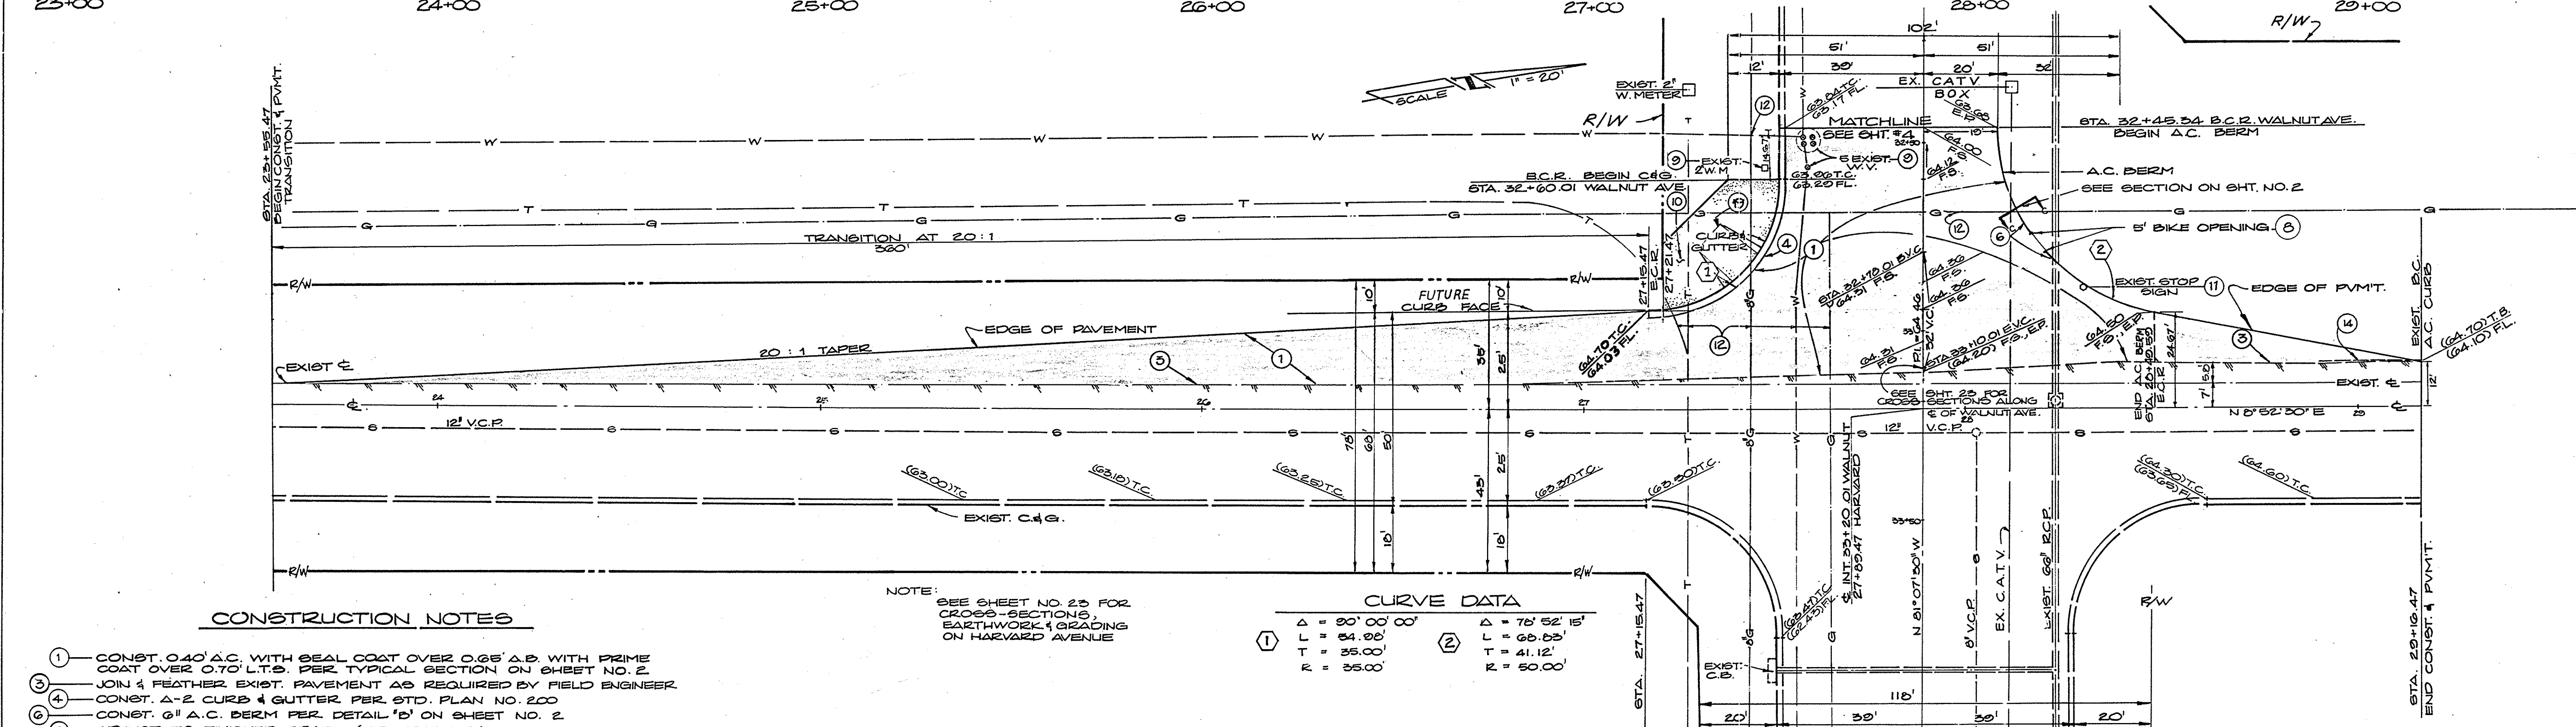


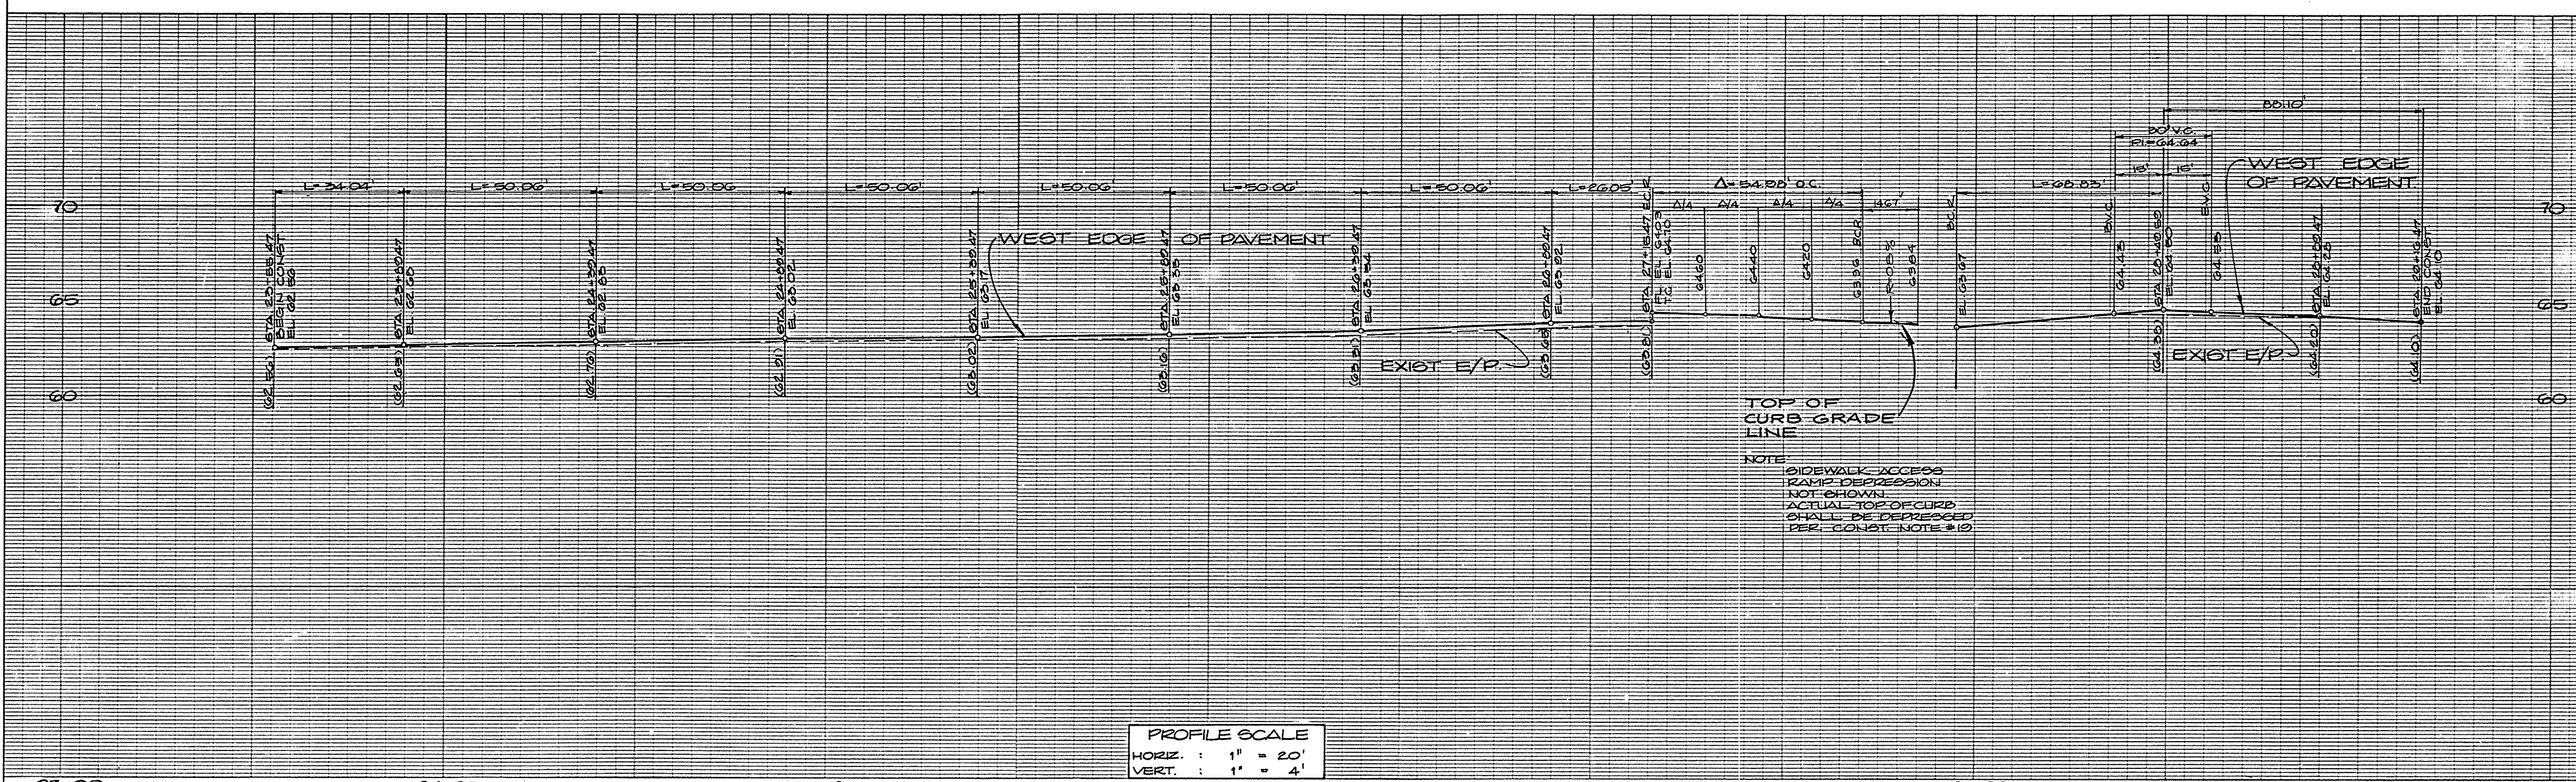

CONSTRUCTION NOTES

- 1 - CONST. 0.40' A.C. WITH SEAL COAT OVER 0.65' A.B. WITH PRIME COAT OVER 0.70' L.T.S. PER TYPICAL SECTION ON SHEET NO. 2
- 3 - JOIN & FEATHER EXIST. PAVEMENT AS REQUIRED BY FIELD ENGINEER
- 4 - CONST. A-2 CURB & GUTTER PER STD. PLAN NO. 200
- 6 - CONST. 6" A.C. BERM PER DETAIL 'D' ON SHEET NO. 2
- 9 - ADJUST. TO FINISHED GRADE (CONTRACTOR)
- 14 - REMOVE EXIST. 6" A.C. BERM.
- 11 - TO BE REMOVED & RELOCATED BY CONTRACTOR
- 10 - CONST. SIDEWALK. RETURN PER STD. PLAN NO. 202.
- 12 - PROTECT IN PLACE
- 13 - CONST. WHEEL CHAIR RAMP DEPRESSION ONLY IN A.C. BERM FOR BICYCLES PER STD. PLAN NO. 203.
- 15 - CONST. SIDEWALK ACCESS RAMP PER STD. PLAN NO. 203.

NOTE: SEE SHEET NO. 23 FOR CROSS-SECTIONS, EARTHWORK & GRADING ON HARVARD AVENUE

CURVE DATA

1	$\Delta = 90^{\circ} 00' 00''$	$\Delta = 76^{\circ} 52' 15''$
	$L = 54.00'$	$L = 68.83'$
	$T = 35.00'$	$T = 41.12'$
	$R = 35.00'$	$R = 50.00'$

HARVARD AVENUE

"AS BUILT"

WALNUT AVENUE

NO.	DATE	REVISIONS
7		
6		
5		
4		
3		
2		
1		

DRAWN BY: <u>R.J.B.</u> DESIGNED BY: <u>M.N.M.</u> CHECKED BY: <u>J.J.B.</u>	DATE DATE DATE	PLANS PREPARED BY: R.G.B. ENGINEERING, INC. 3183 "G" AIRWAY AVENUE COSTA MESA, CA 92626 PH. (714) 557-5651	WALNUT AVENUE BRIDGE OVER PETERS CANYON WASH WALNUT AVENUE CITY OF IRVINE COMMUNITY DEVELOPMENT DEPARTMENT	PROJECT NO. SHEET 5 OF 25
	DATE: <u>6/1/79</u> R.C.E. NO. <u>22446</u>			
	DATE:			
	DATE:			