



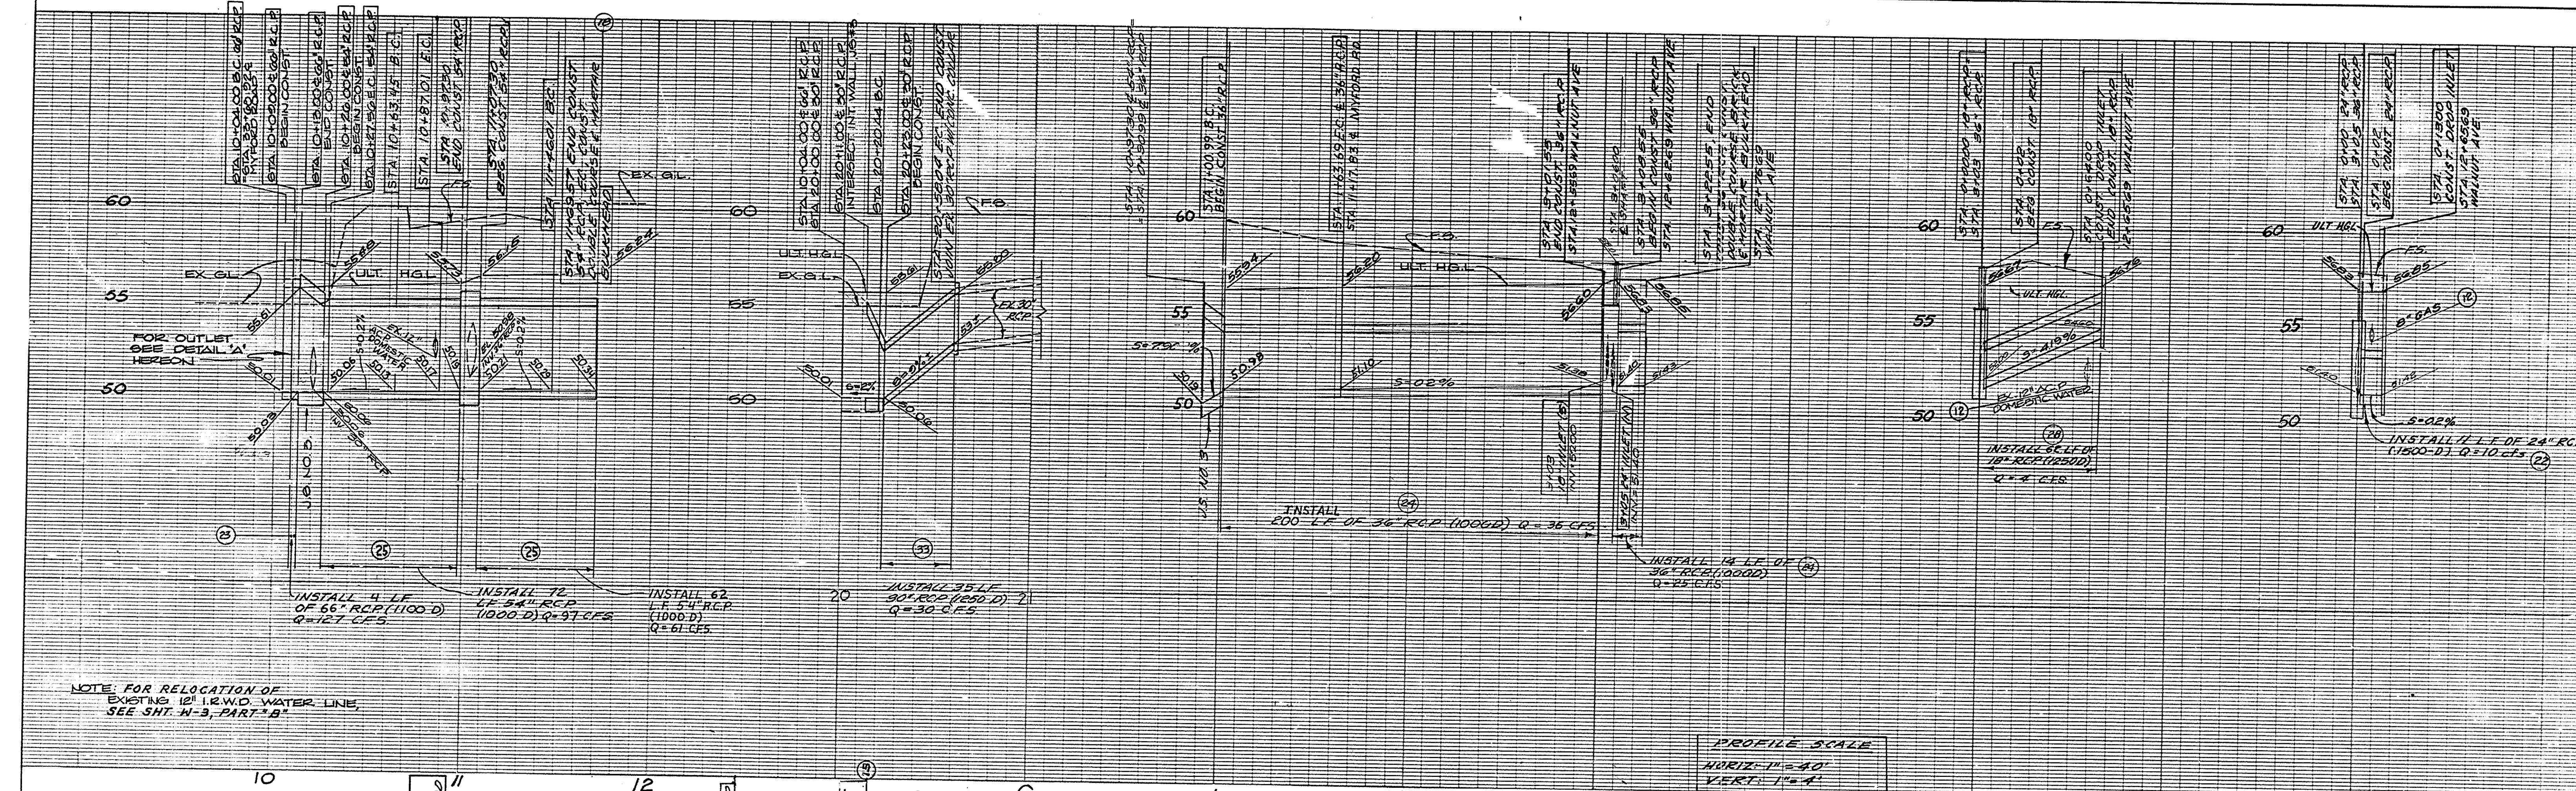

NOTE: FOR RELOCATION OF EXISTING 12\"/>



PROFILE SCALE
HORIZ: 1\"/>

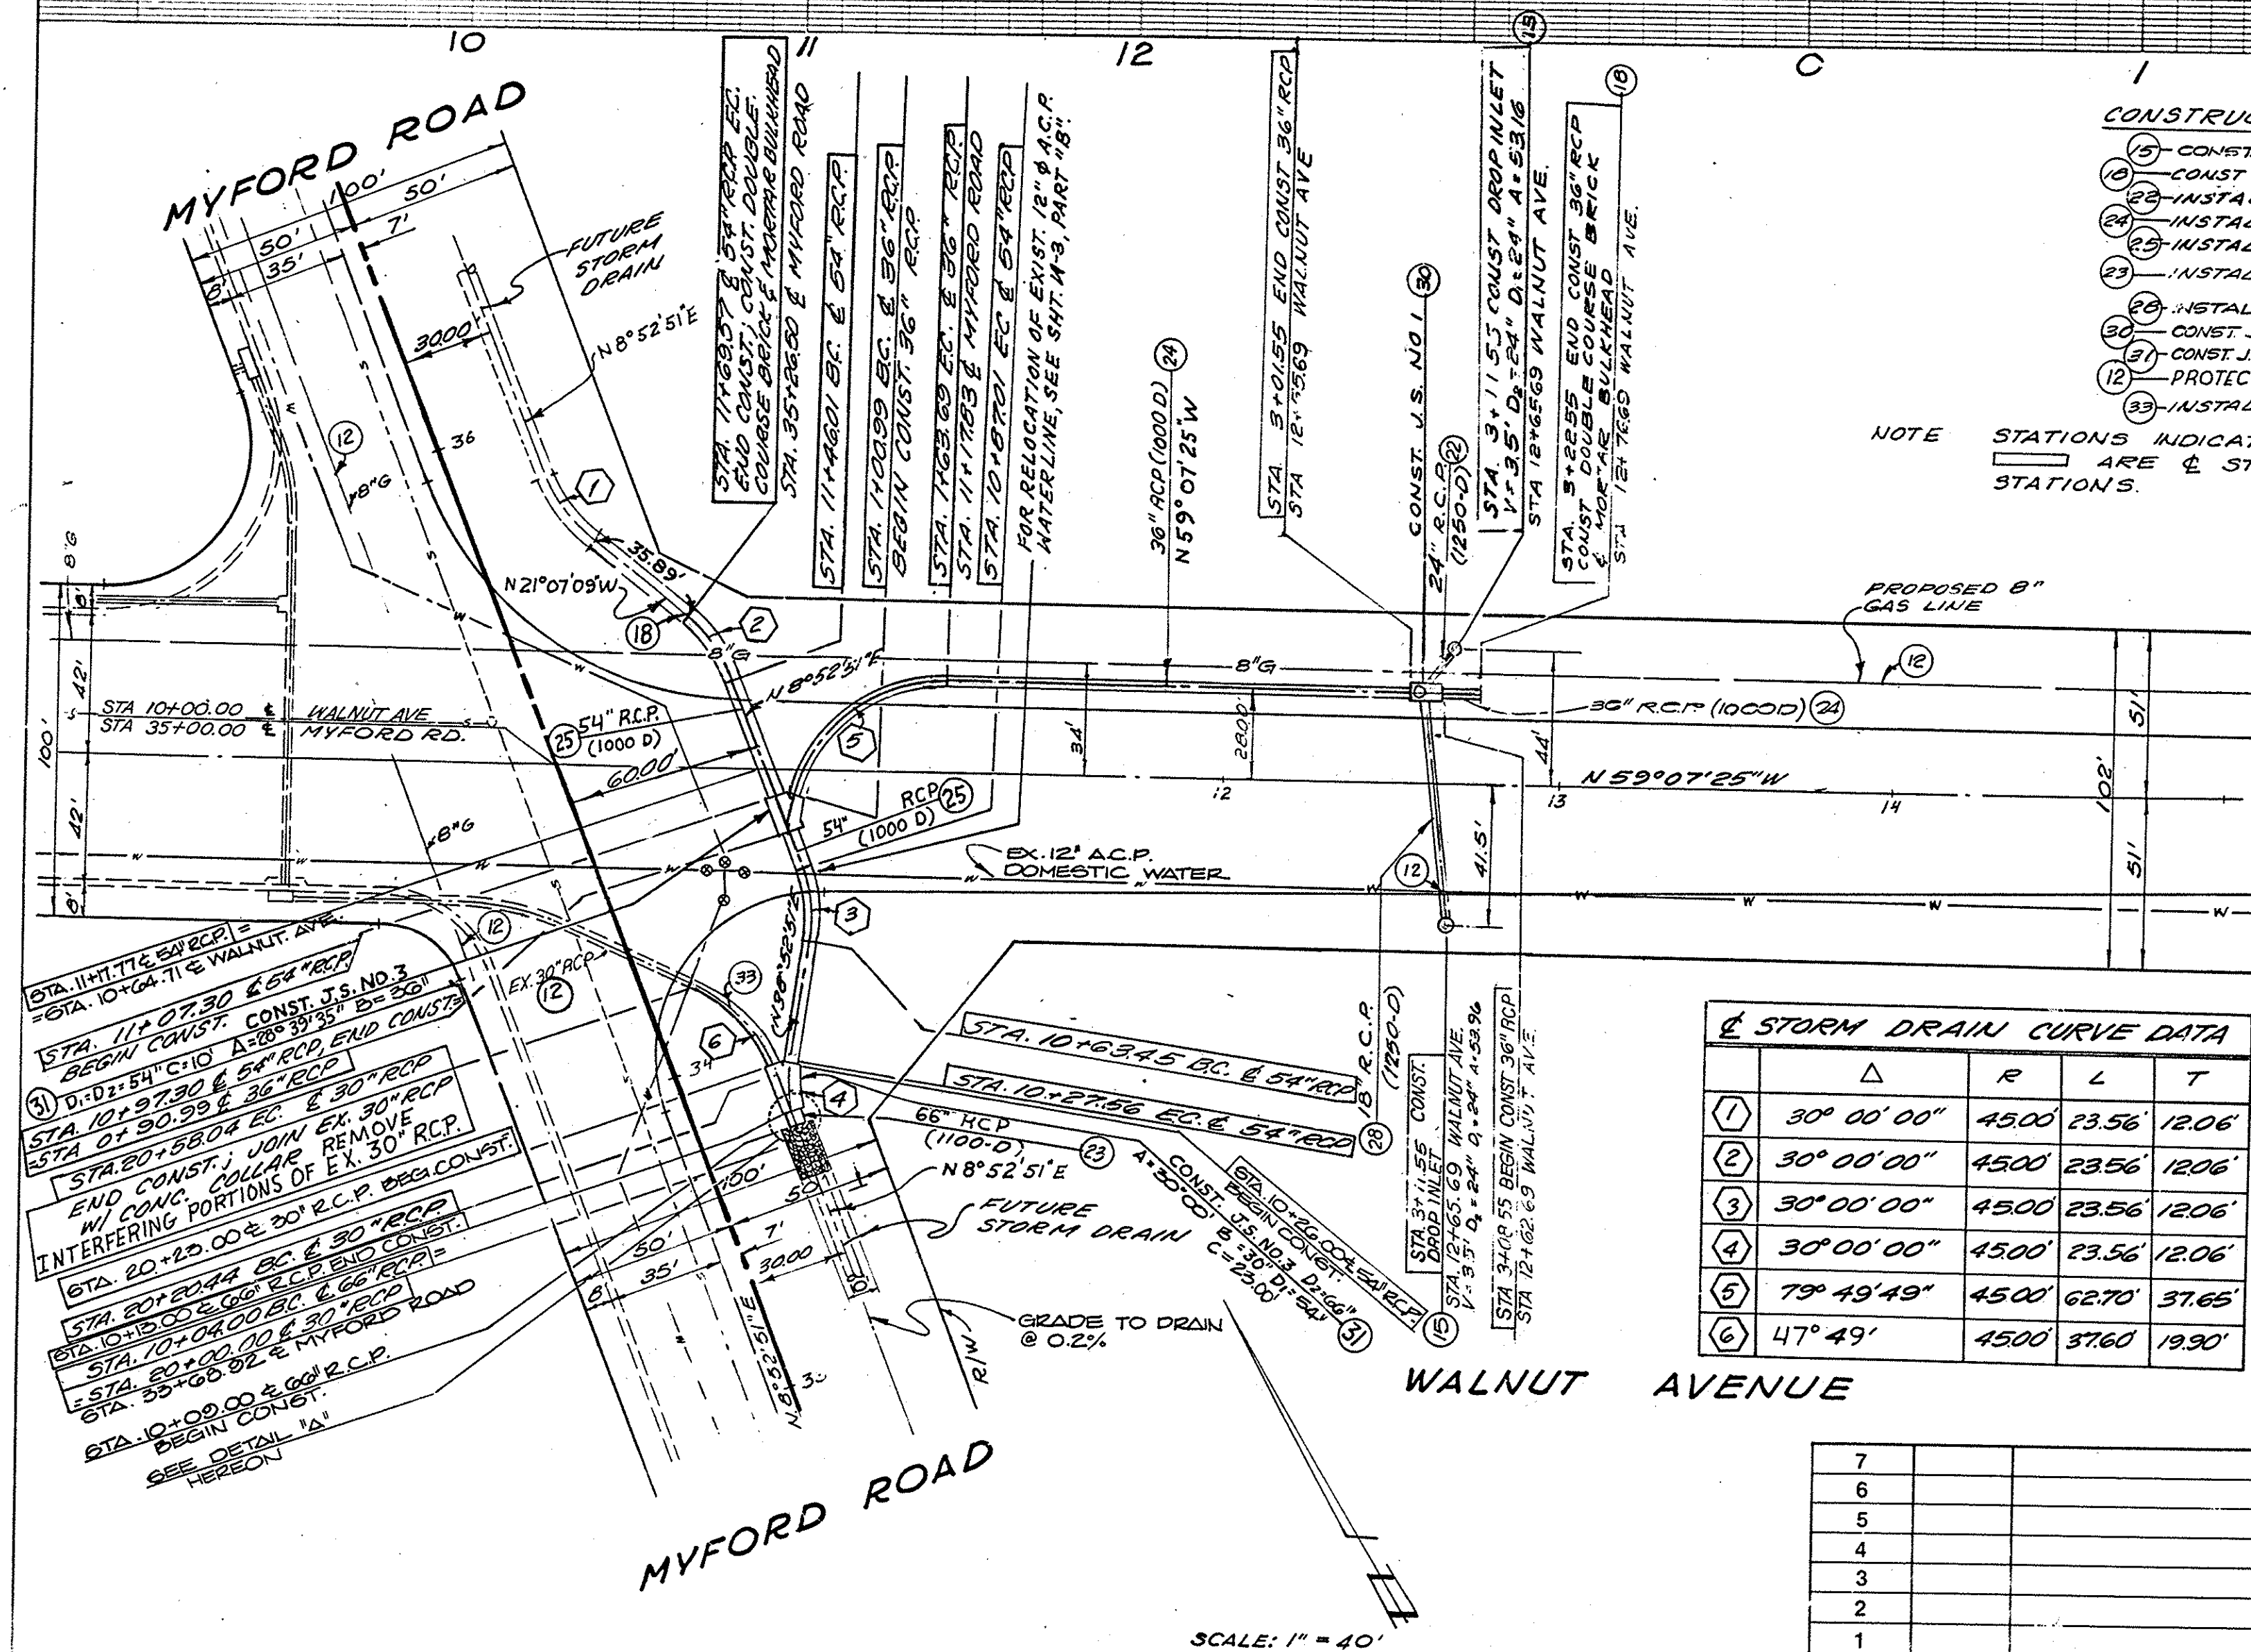

CONSTRUCTION NOTES

1. CONST. 6\"/>

NOTE: STATIONS INDICATED BY ARE & STORM DRAIN STATIONS.

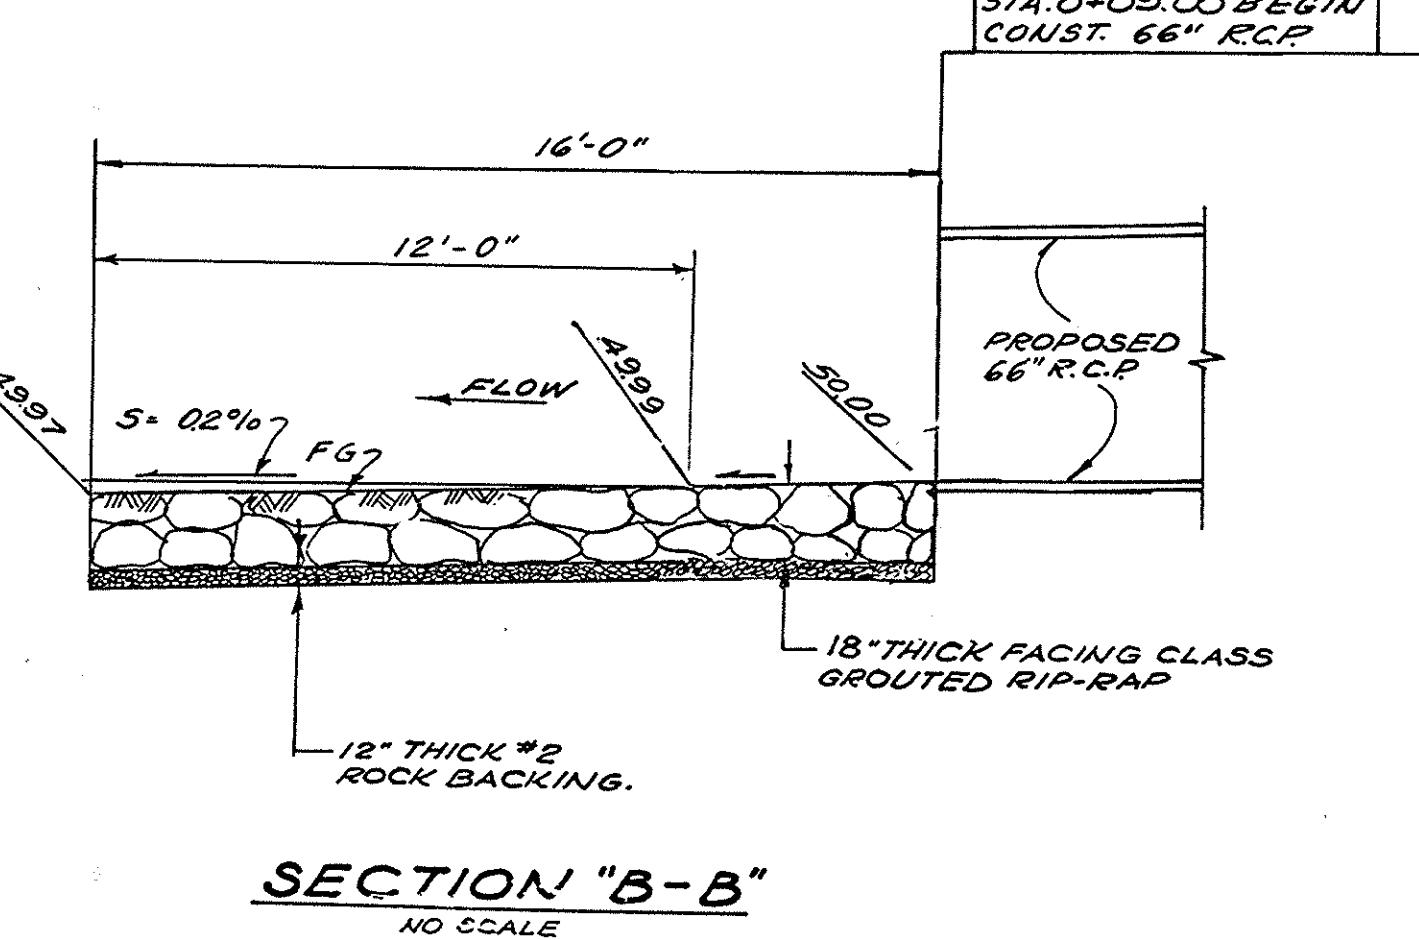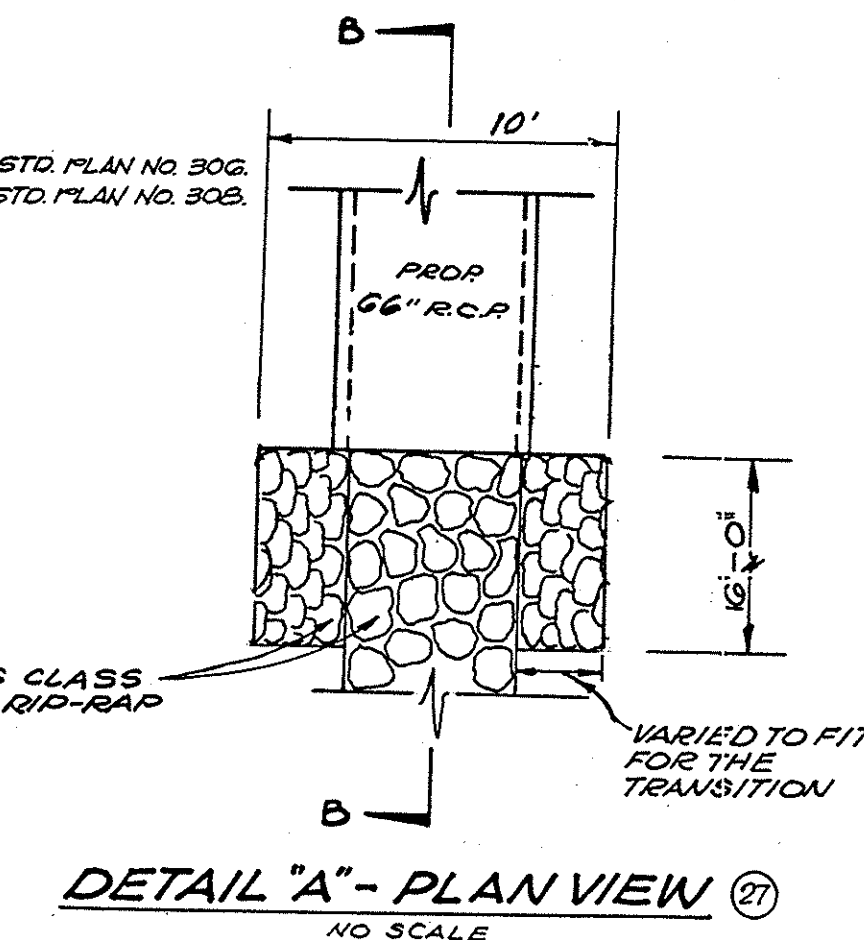

STORM DRAIN CURVE DATA				
Δ	R	L	T	
1	30° 00' 00"	4500	23.56	12.06'
2	30° 00' 00"	4500	23.56	12.06'
3	30° 00' 00"	4500	23.56	12.06'
4	30° 00' 00"	4500	23.56	12.06'
5	79° 49' 49"	4500	62.70	37.65'
6	47° 49'	4500	37.60	19.90'

"AS BUILT"

NO.	DATE	REVISIONS
7		
6		
5		
4		
3		
2		
1		

PLANS PREPARED BY:
R.G.B. ENGINEERING, INC.
3183 "G" AIRWAY AVENUE
COSTA MESA, CA 92626
PH. (714) 557-5651

WALNUT AVENUE
STORM DRAIN IMPROVEMENT PLAN

CITY OF IRVINE
COMMUNITY DEVELOPMENT DEPARTMENT

PROJECT NO.
SHEET 7
OF 25