


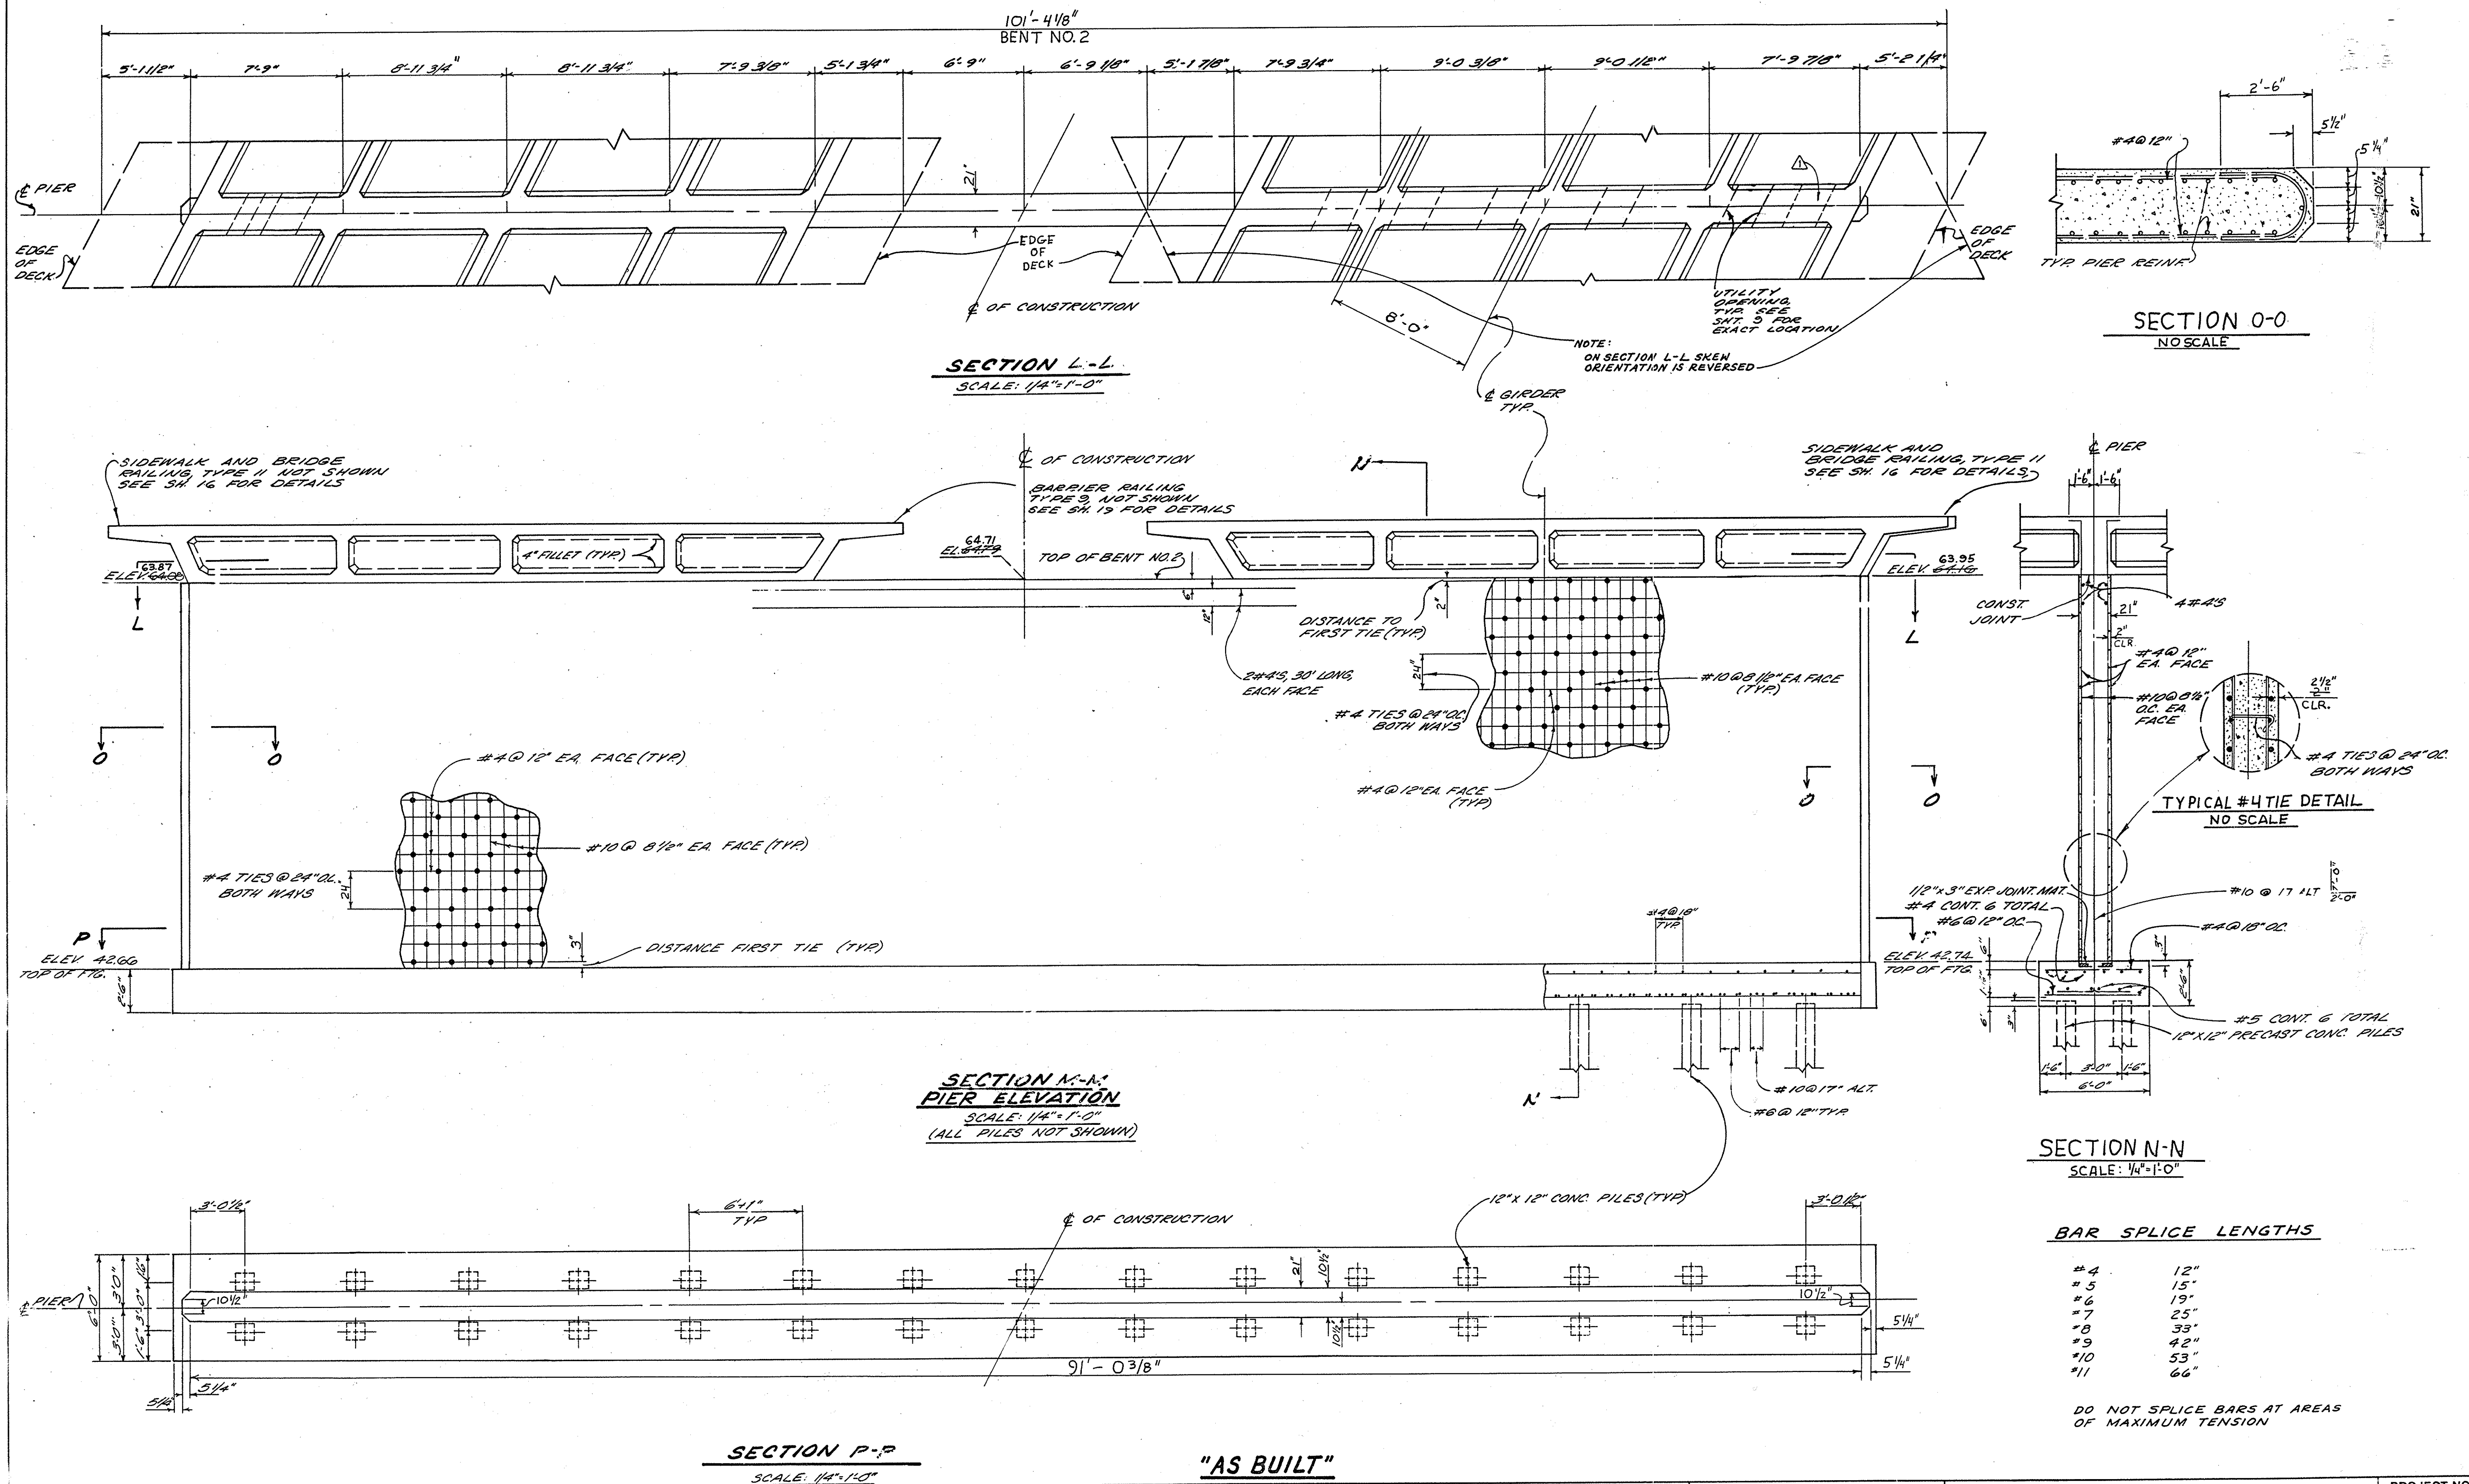

NO.	DATE	REVISIONS
7		
6		
5		
4		
3		
2		
1		
1		REV. LOCATION OF EDISON CO. UTILITY OPENING

PLANS PREPARED BY R.G.E. ENGINEERING, INC. 3183 "G" AIRWAY AVENUE COSTA MESA, CA 92626 PH. (714) 557-5651	DRAWN BY: <u>K.H.</u> DATE: <u></u>
DESIGNED BY: <u>J.I.</u> DATE: <u></u>	CHECKED BY: <u>J.I.</u> DATE: <u></u>

WALNUT AVENUE BRIDGE OVER PETERS CANYON WASH	PROJECT NO. <u></u>
PIER DETAILS	SHEET <u>12</u>
CITY OF IRVINE COMMUNITY DEVELOPMENT DEPARTMENT	OF <u>25</u>