
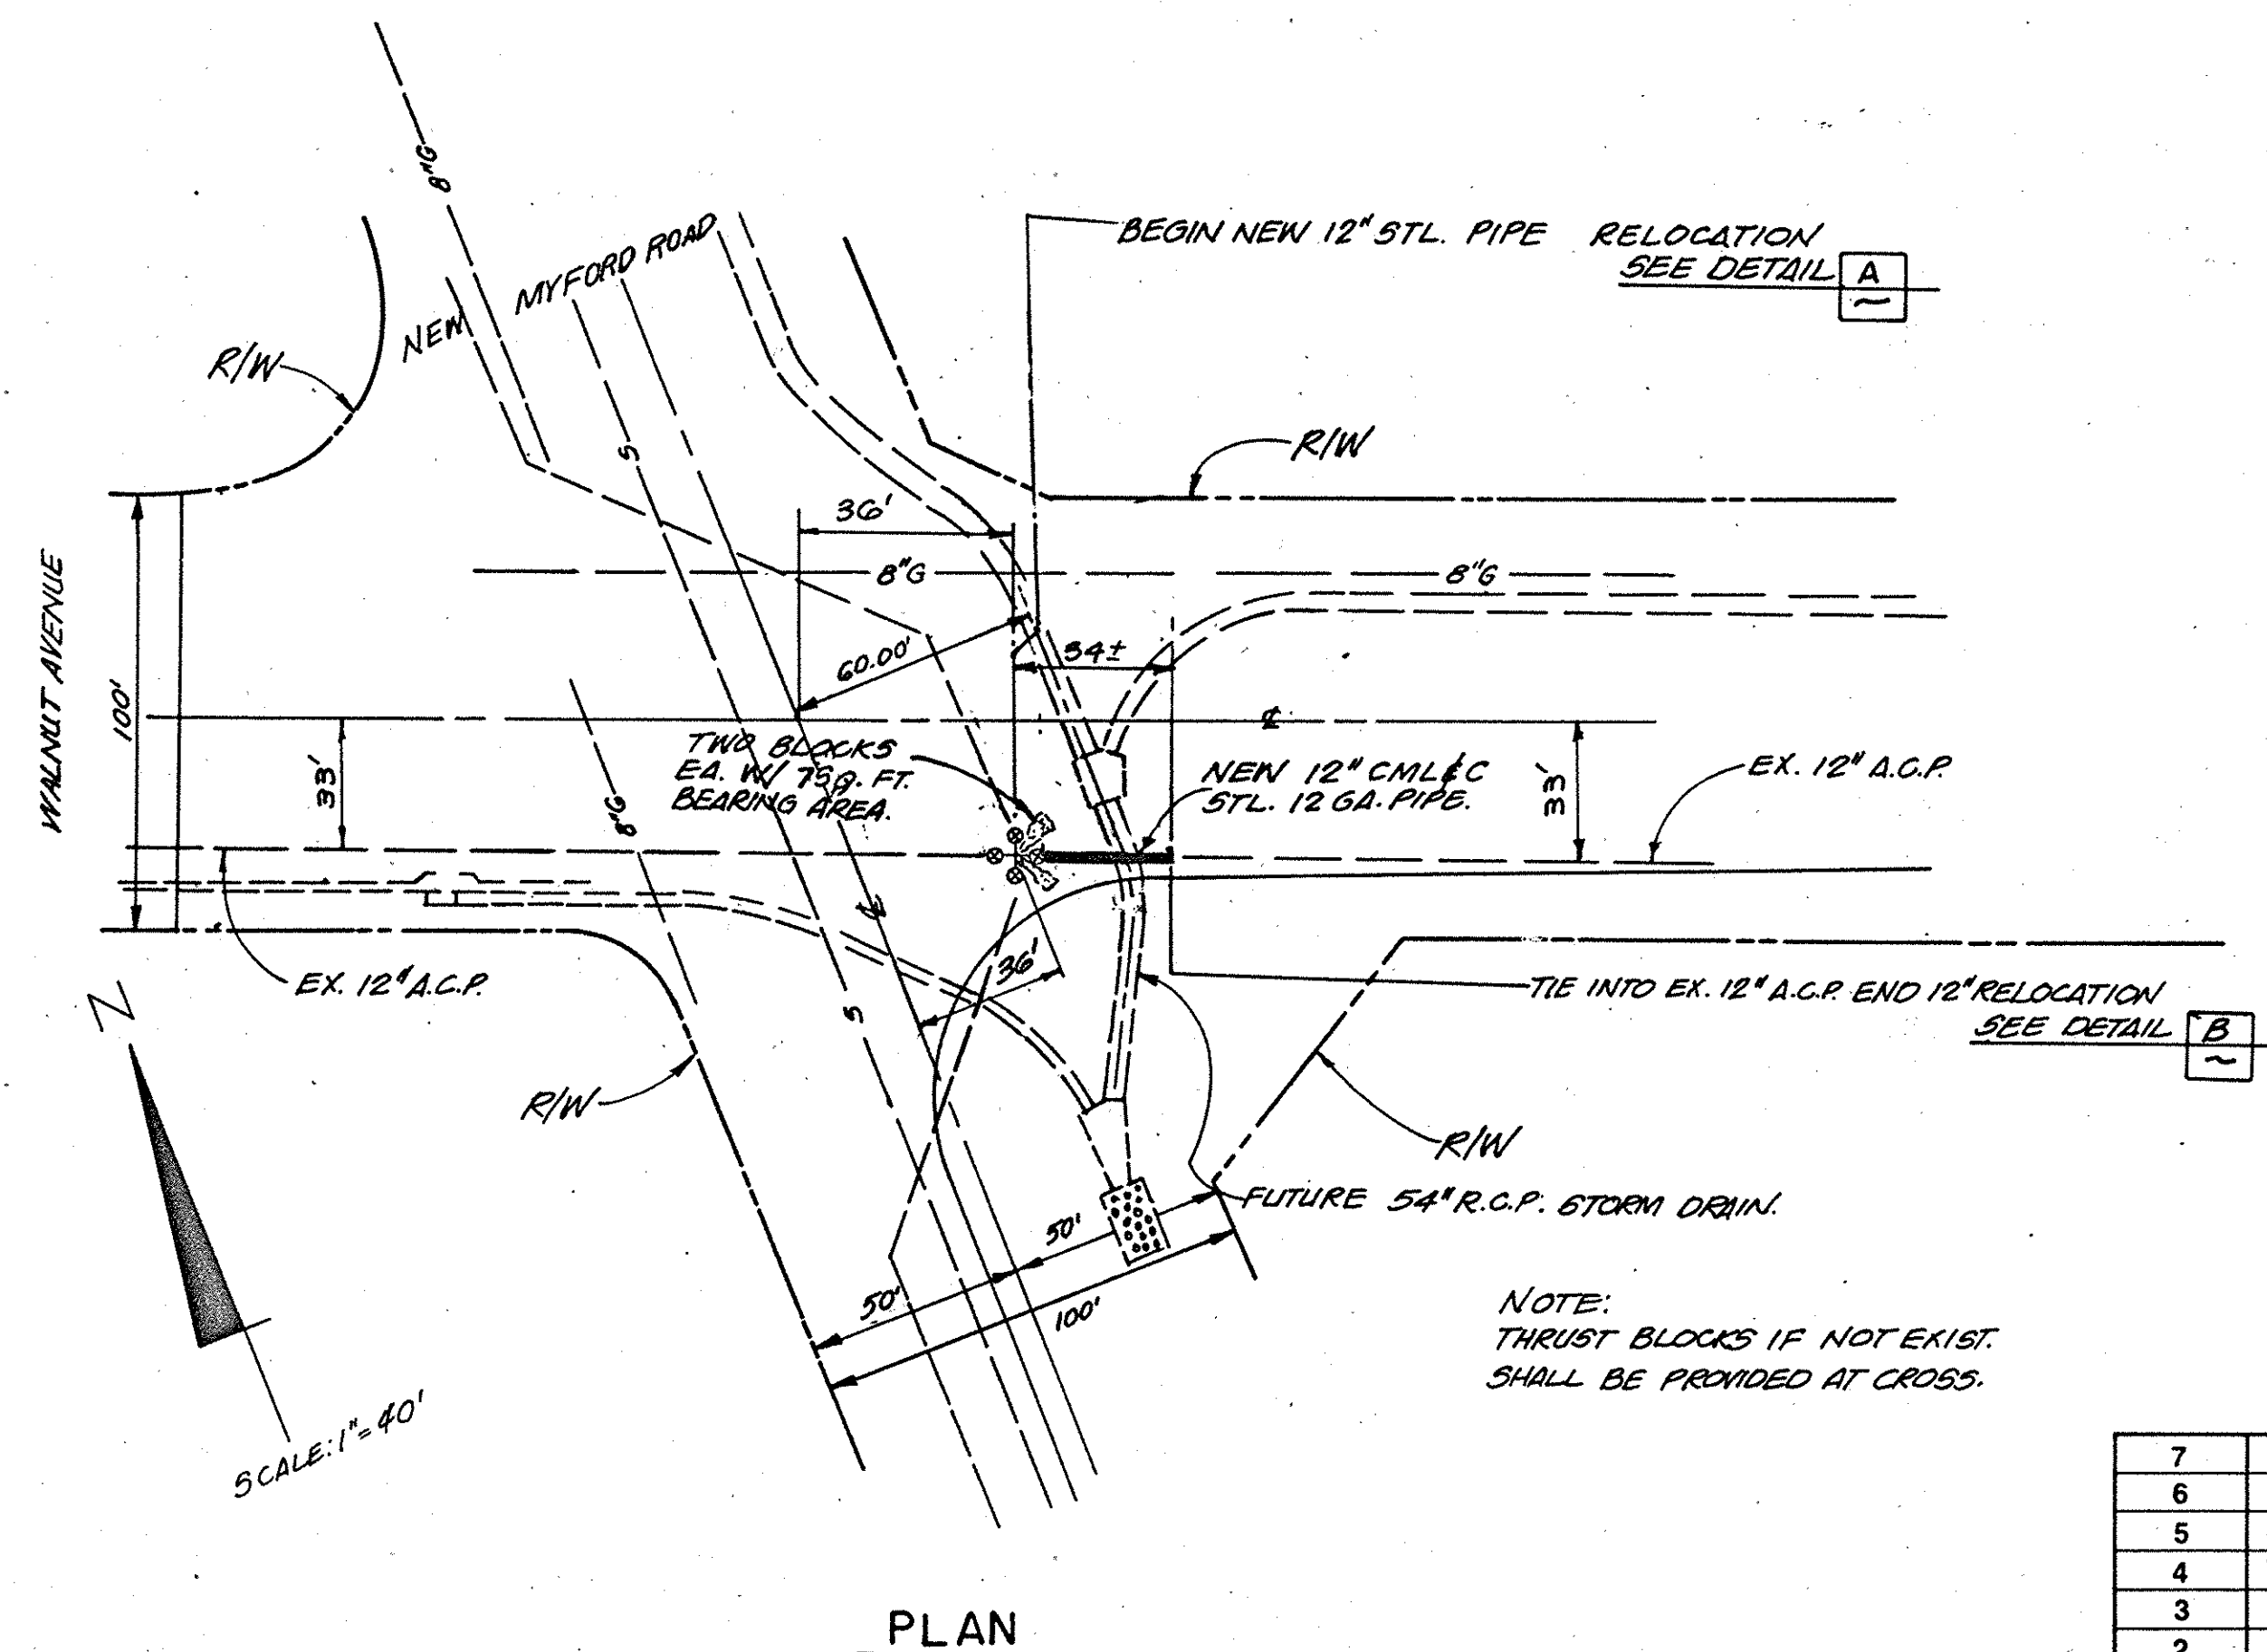
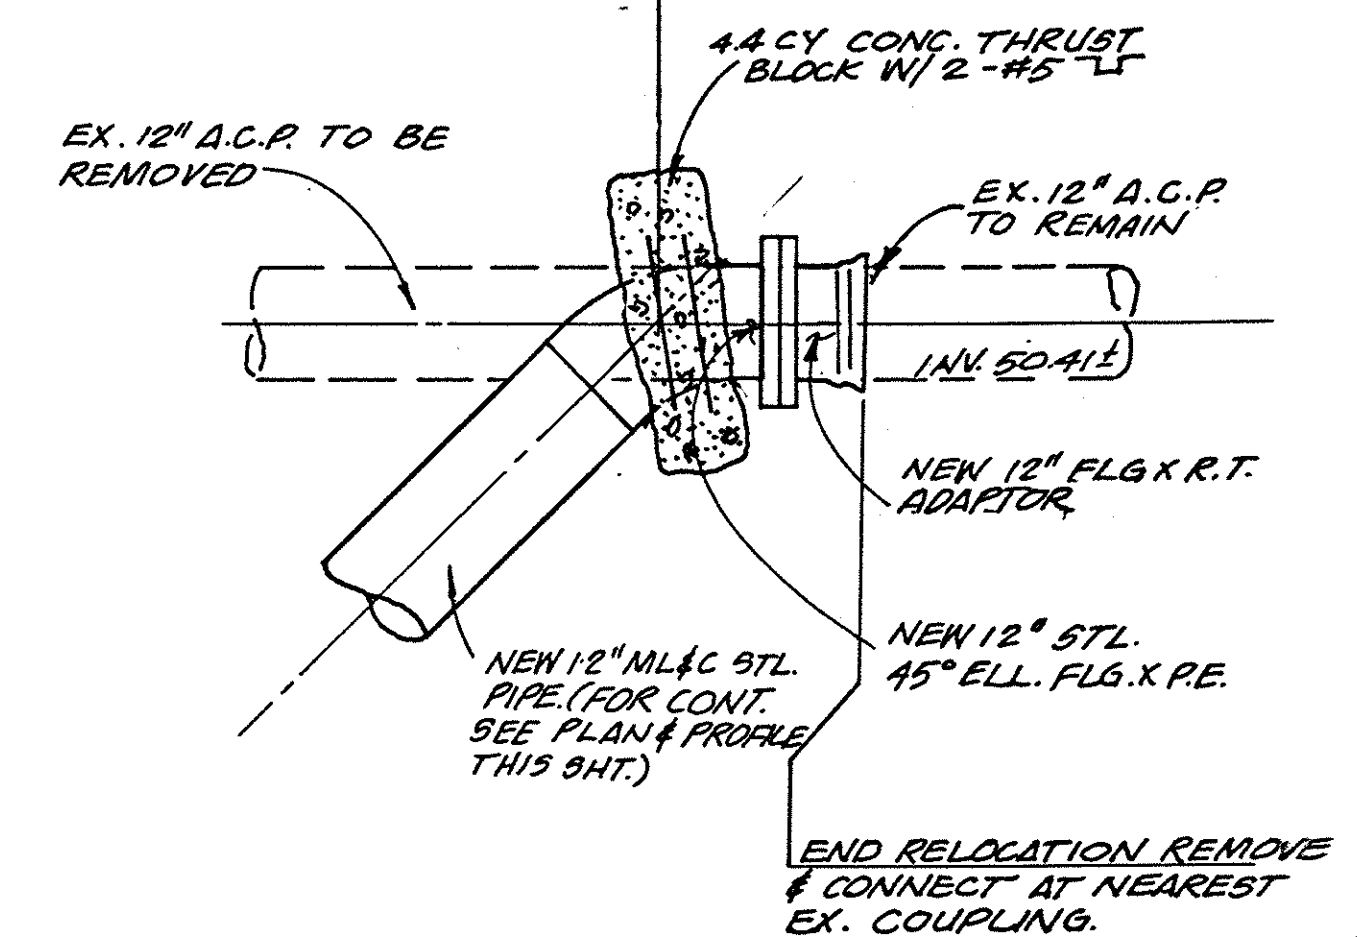
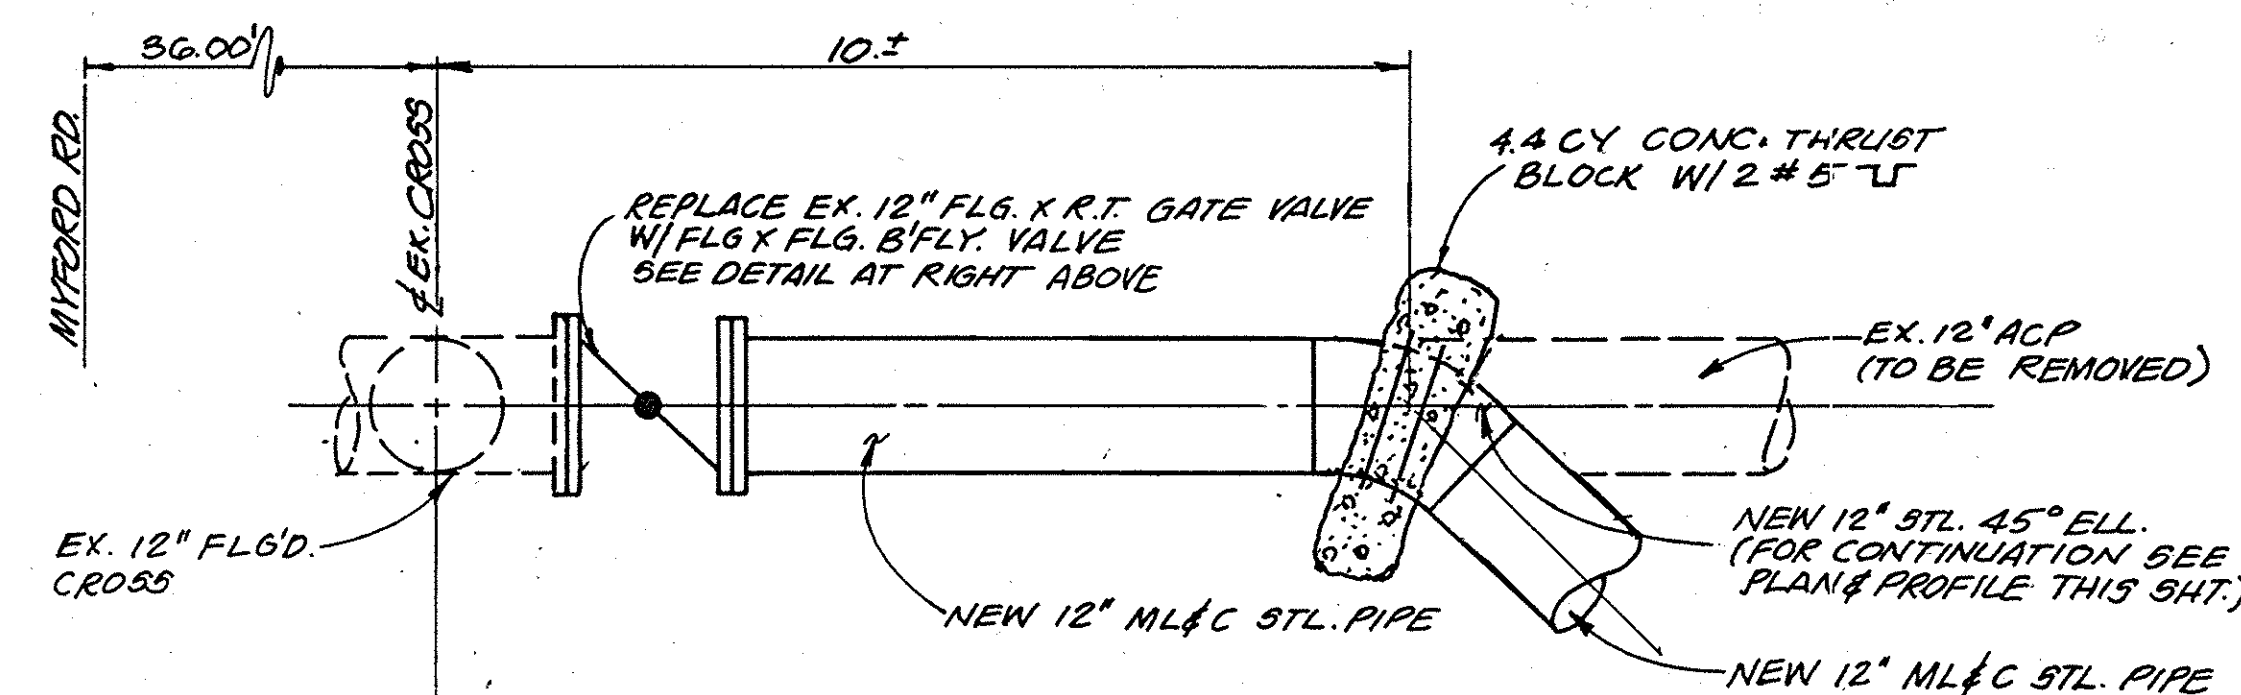
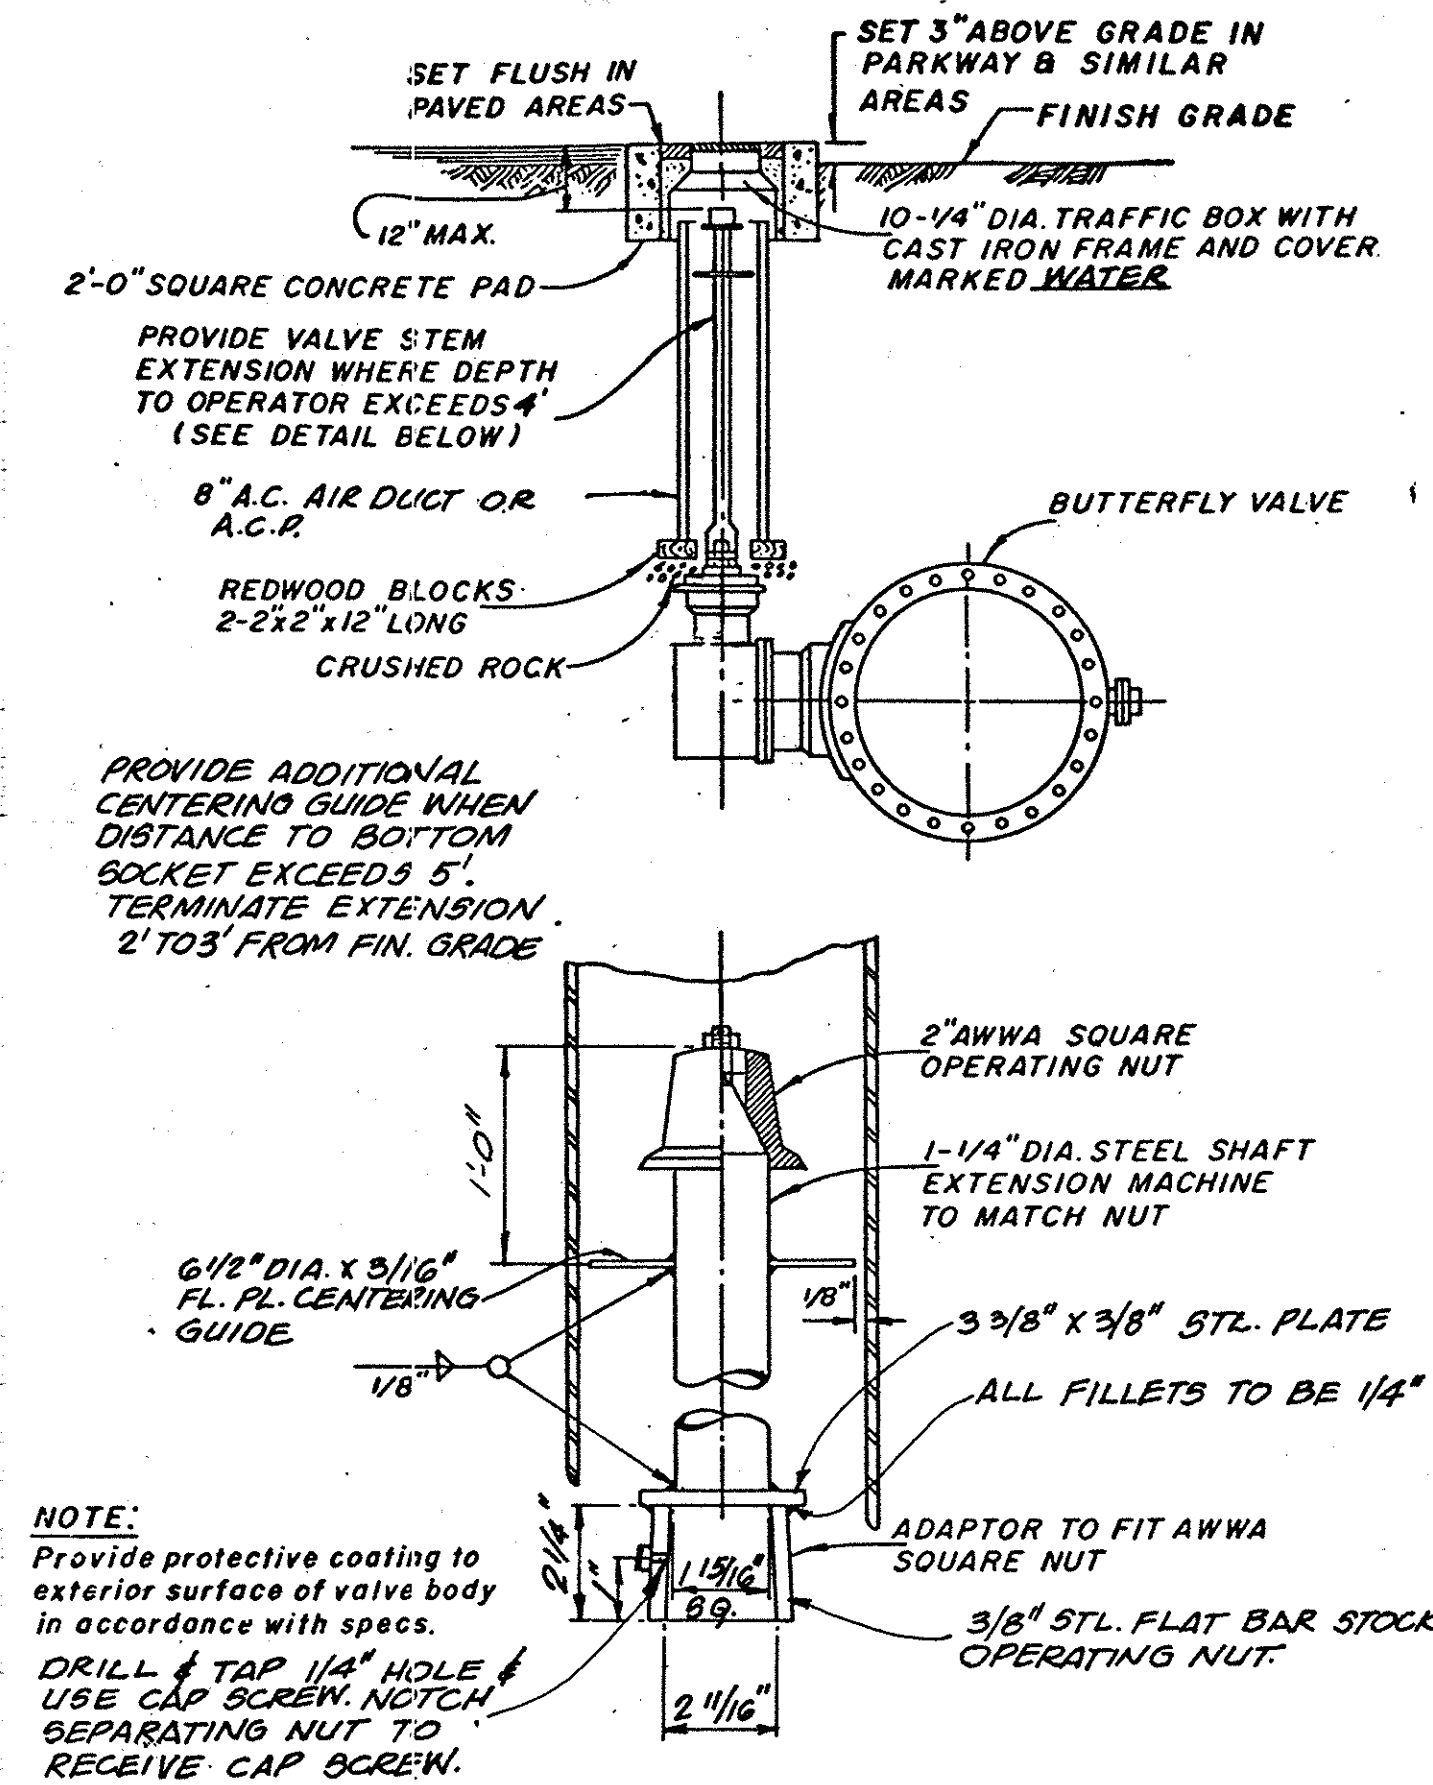


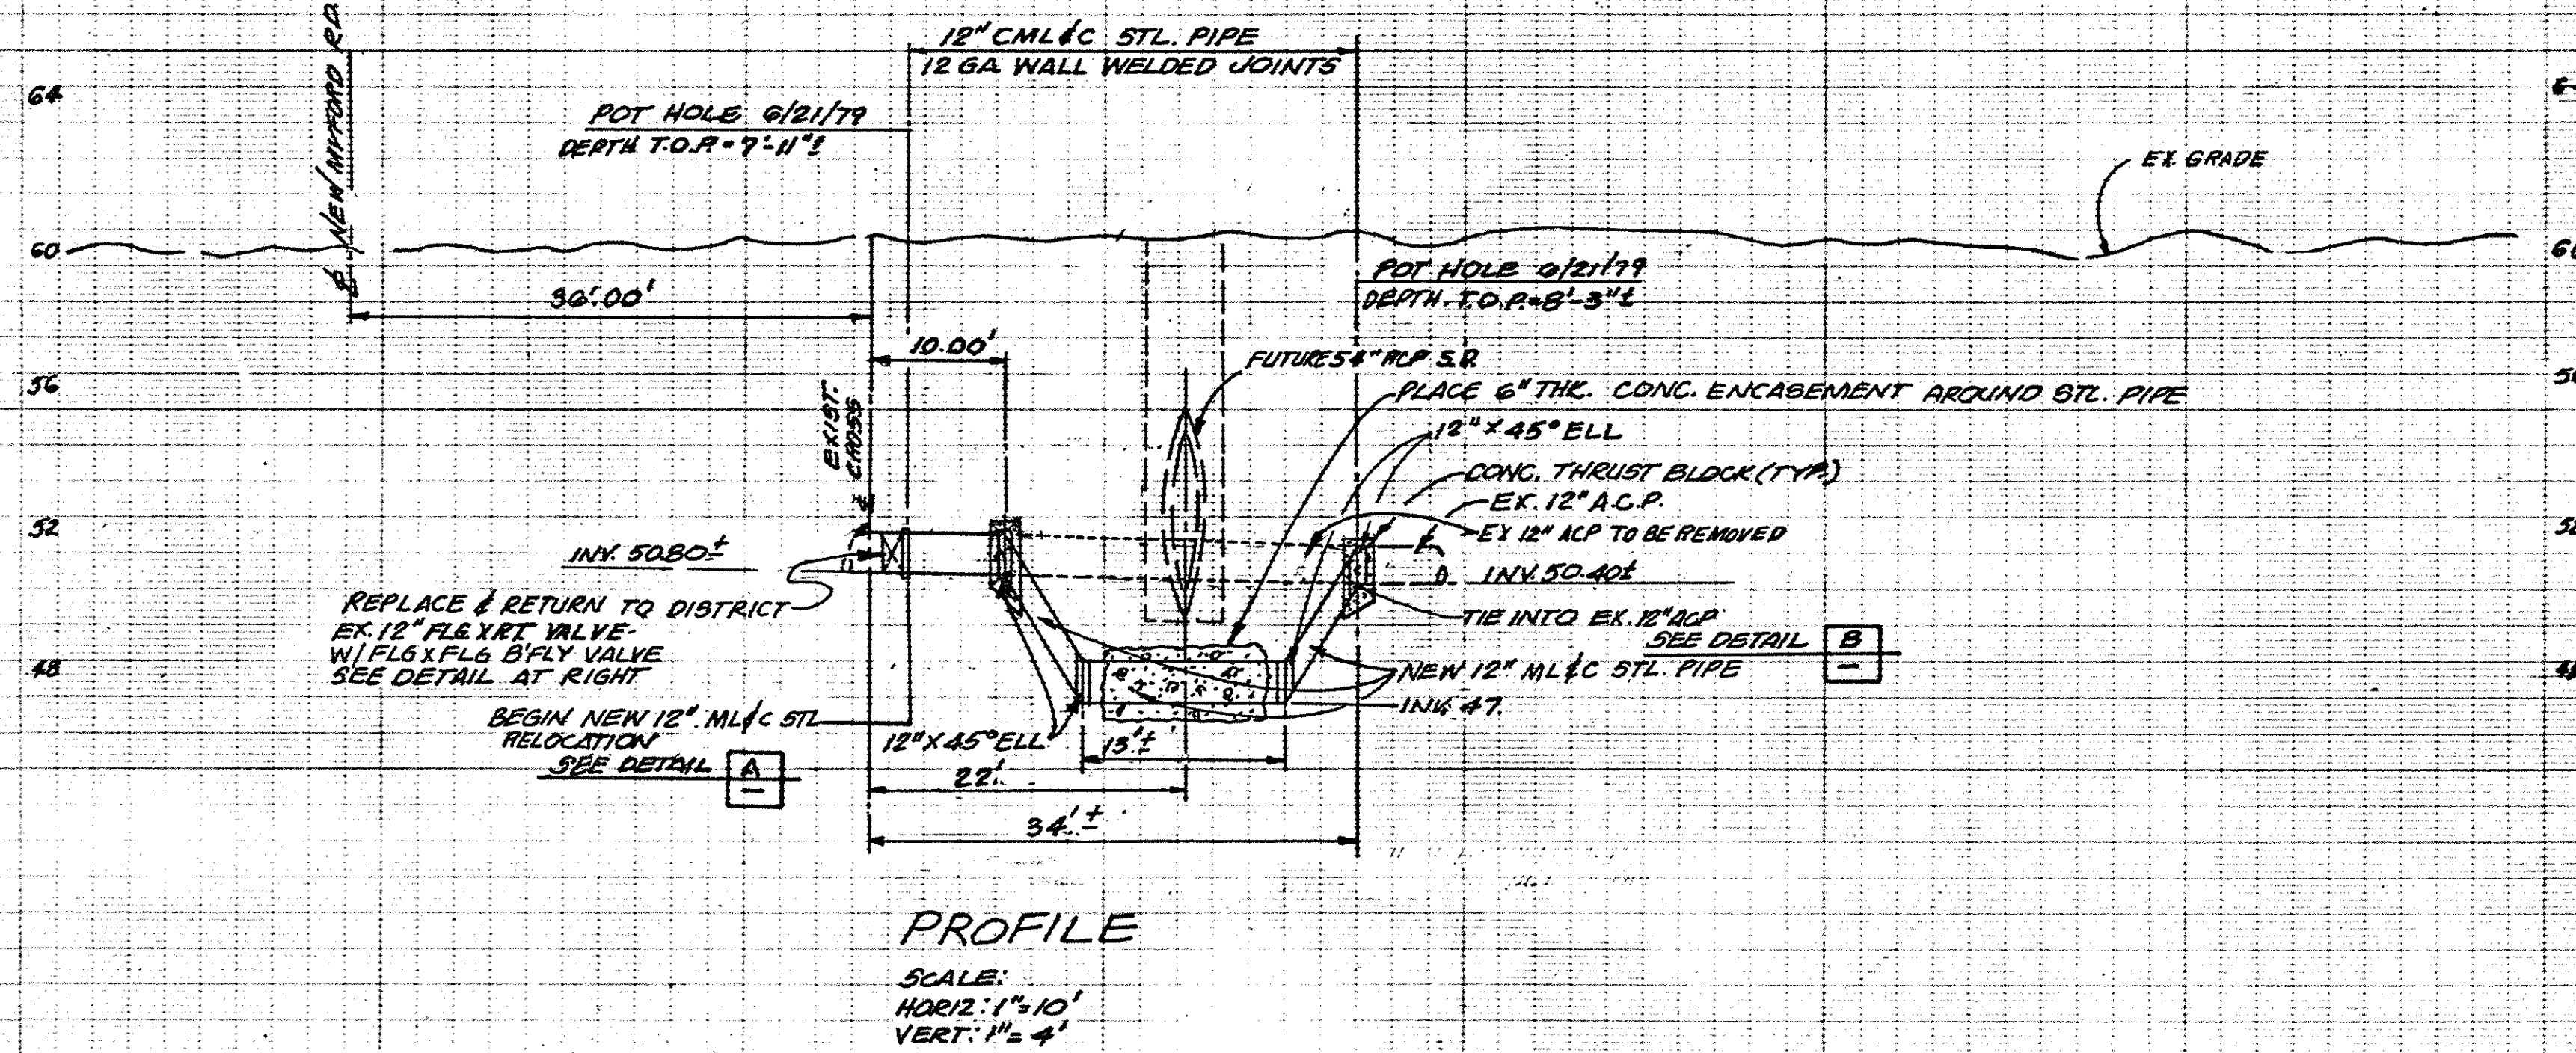

"AS BUILT"

NO.	DATE	REVISIONS
7		
6		
5		
4		
3		
2		
1		

APPROVED:	DATE:	PLANS PREPARED BY:
<i>[Signature]</i>	7/19/79	JAMES M. MONTGOMERY
IRVINE RANCH WATER DISTRICT		CONSULTING ENGINEERS, INC.
		17802 SKYPARK CIR. SUITE 201, IRVINE, CA.
DRAWN BY:	DATE:	SUBMITTED:
FS/TH		David A. Cousins 22935 7-19-79
DESIGNED BY:	DATE:	PROJECT ENGINEER
DC/TH		R.C.E. NO. DATE
CHECKED BY:	DATE:	RECOMMENDED:
SD	7/19/79	David A. Cousins 22935 7/19/79
		R.C.E. NO. DATE

WALNUT AVE. WATERMAIN RELOCATIONS
PLAN & PROFILE AT MYFORD ROAD

CITY OF IRVINE
COMMUNITY DEVELOPMENT DEPARTMENT

PROJECT NO.
CIP 608-42
SHEET W-3
OF 4