


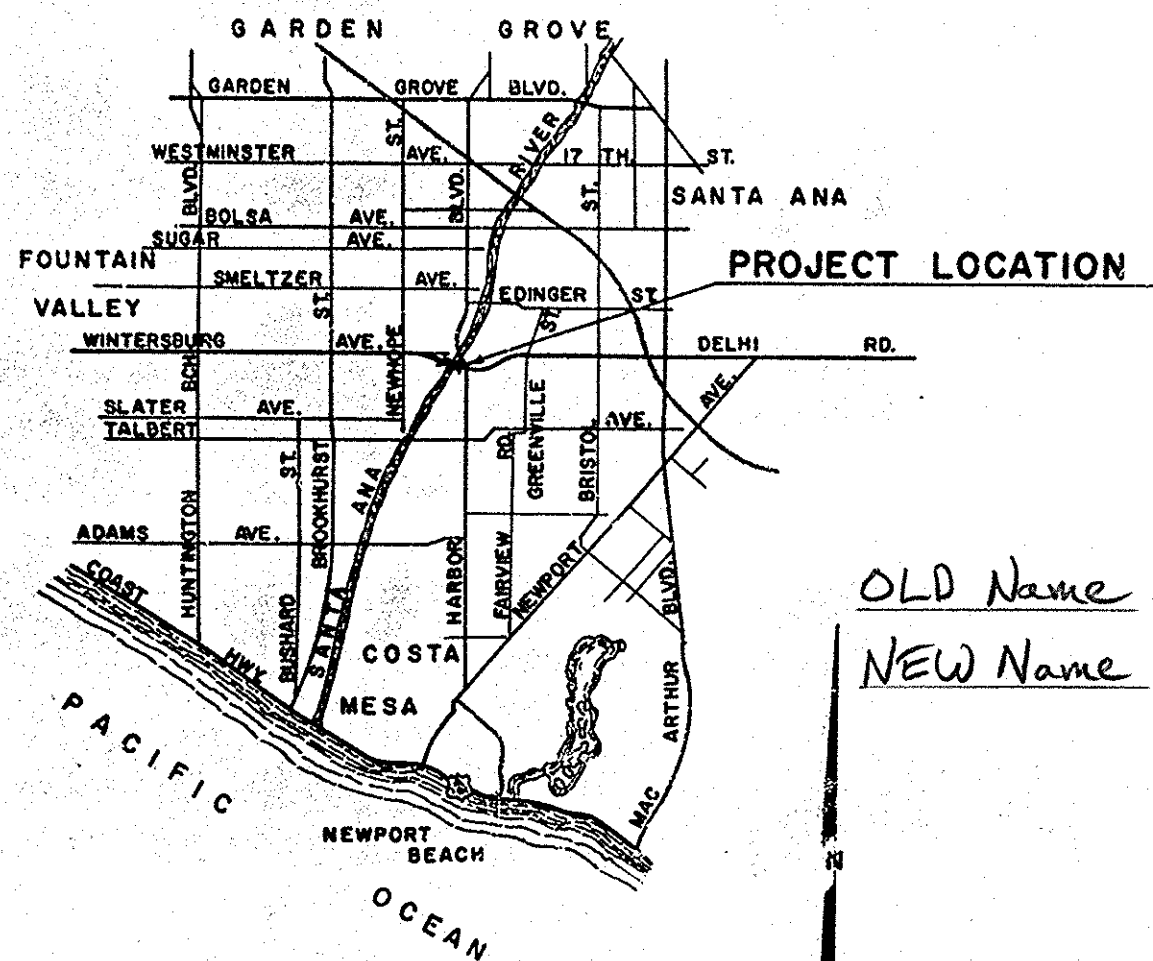

LOCATION MAP


ORANGE COUNTY HIGHWAY DEPARTMENT STATE OF CALIFORNIA

PLAN AND PROFILE


OLD Name $\Rightarrow$ **WINTERSBURG AVENUE BRIDGE**
 NEW Name $\Rightarrow$ **WARNER**

ACROSS SANTA ANA RIVER (CHANNEL E1) SA-30
 FROM STATION 31+05.11 TO STATION 33+59.21
 TOTAL LENGTH .048 MILES

INDEX OF SHEETS		
SHEET	NO	TITLE SHEET
"	2	GENERAL PLAN
"	3	FOUNDATION PLAN
"	4	ABUTMENT DETAIL
"	5	PIER DETAIL
"	6	SUPERSTRUCTURE AND REINFORCEMENT
"	7	TYPICAL SECTION
"	8	HINGE DETAILS
"	9	MISCELLANEOUS DETAILS
"	10	RAIL DETAILS
"	11	STRUCTURE EXCAVATION AND BACKFILL
"	12	LOG OF TEST BORINGS
"	13	PILE DETAILS

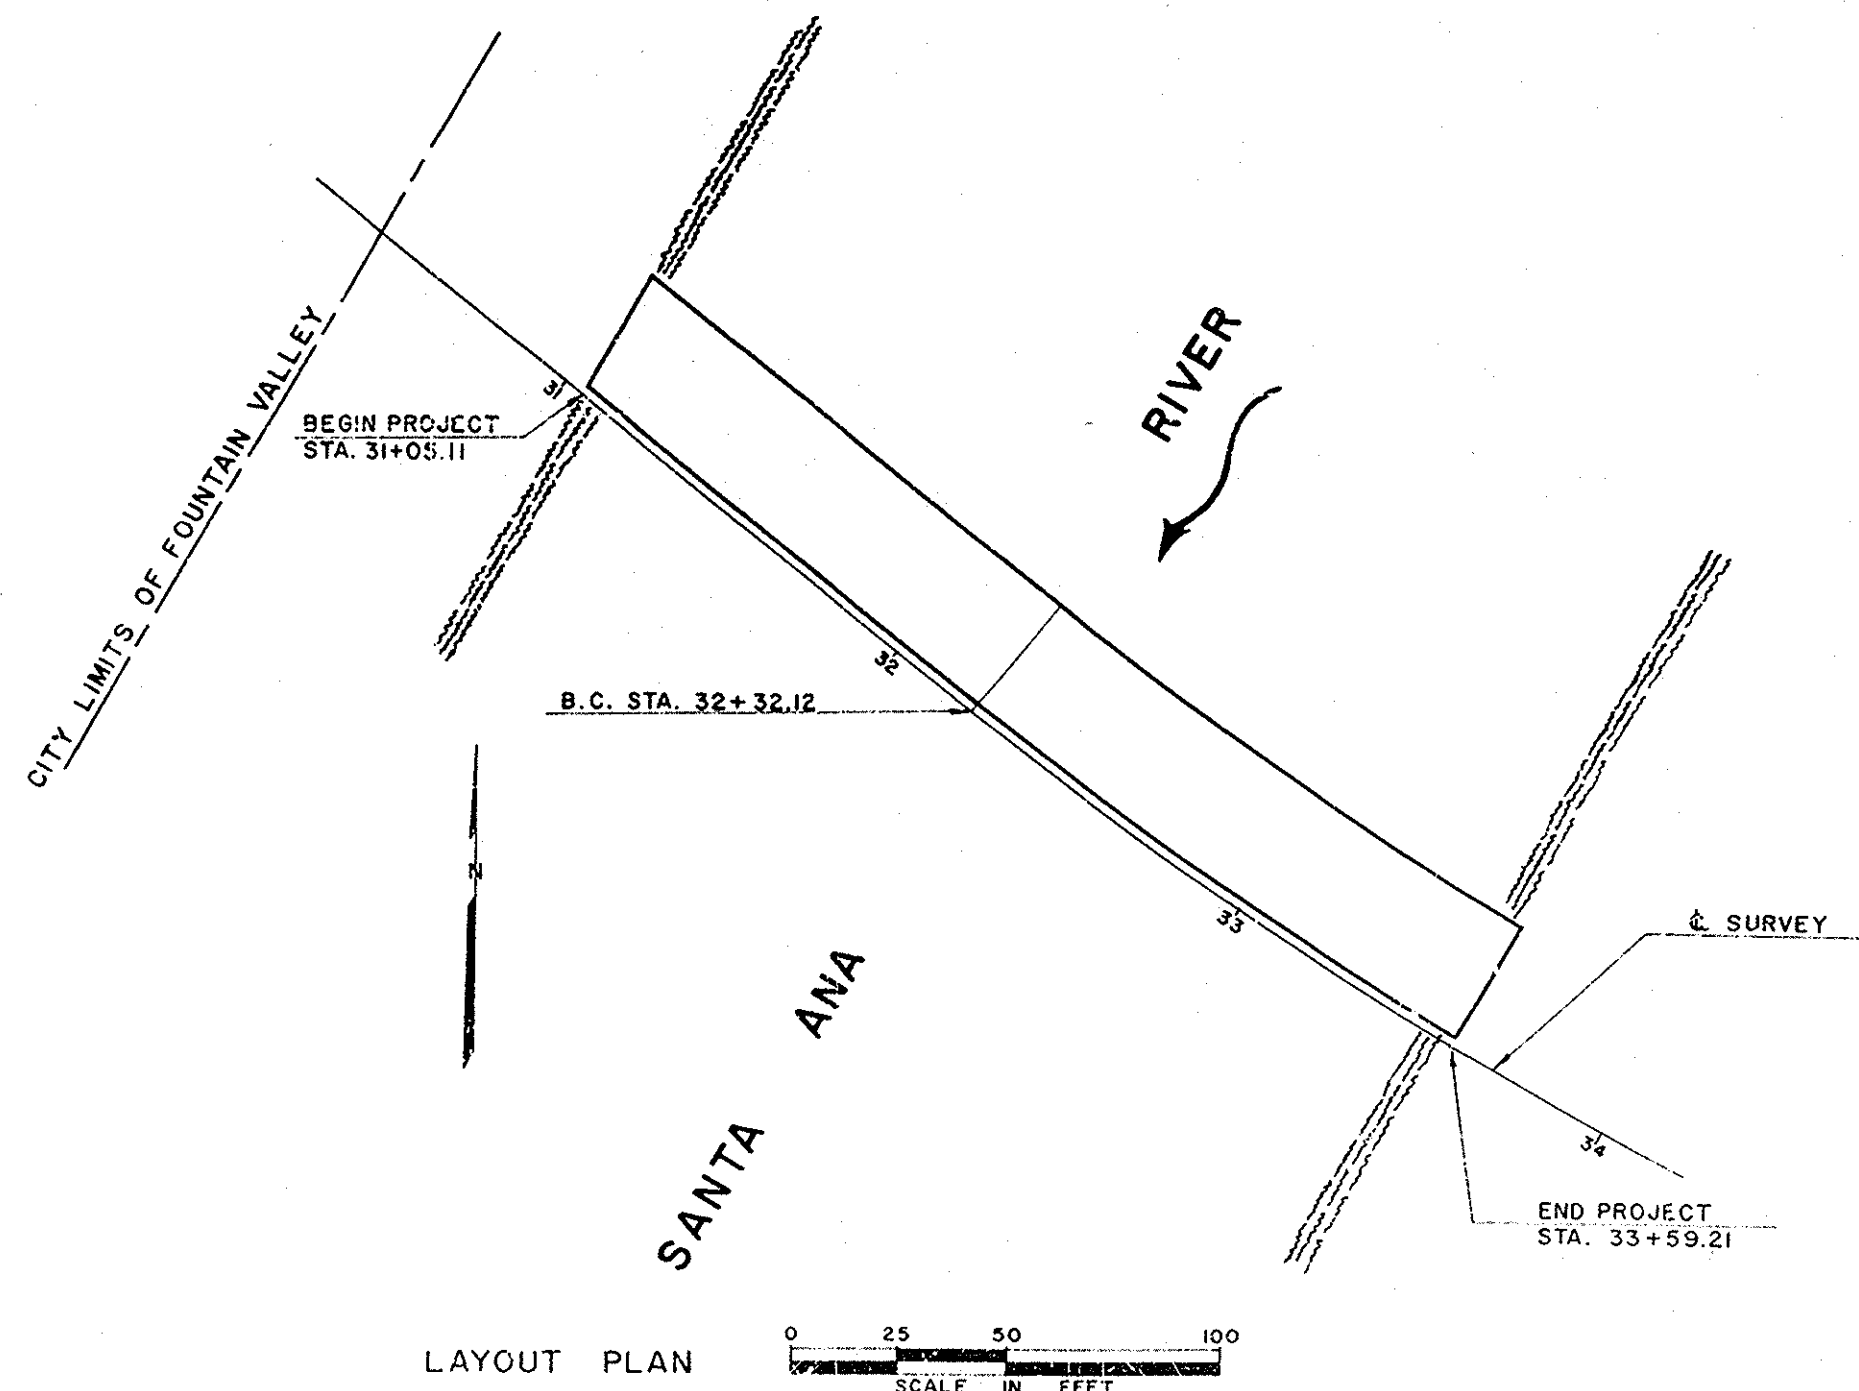

LAYOUT PLAN

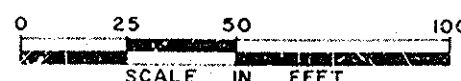

COUNTY OF ORANGE
 ROAD COMMISSIONER
 CIVIL ENGINEER LICENSE NO. 7872
 FLOOD CONTROL ENGINEER
 CIVIL ENGINEER LICENSE NO. 7188

SA 30, Warner Ave
 Station 31+05.11 to 33+59.21
 Scale: Graphic
 Date: 9-11-60

SA-30 #14693 1961
WARNER AVE BRIDGE
 SA-30
 SSC-0148
 Thos. : 828-37