
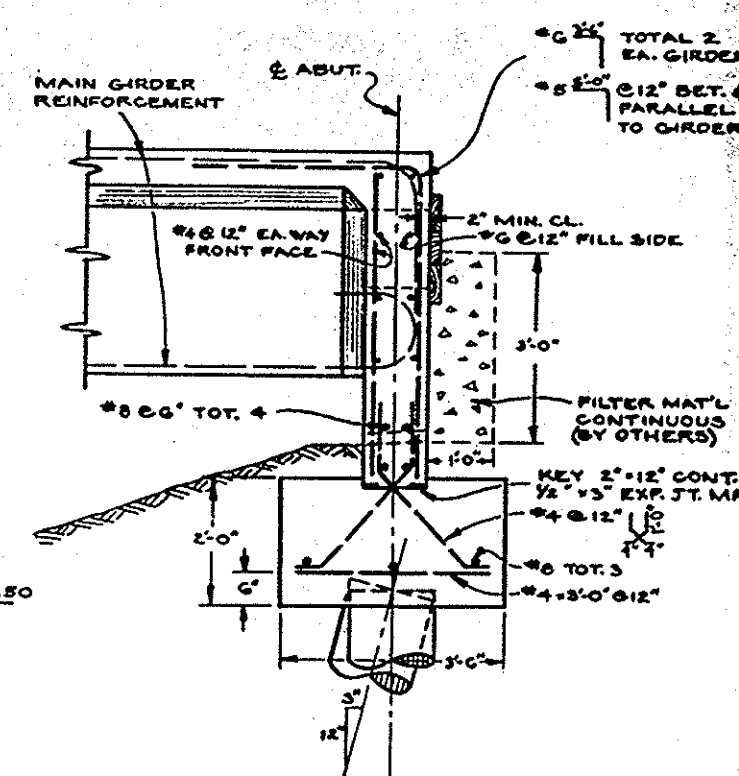
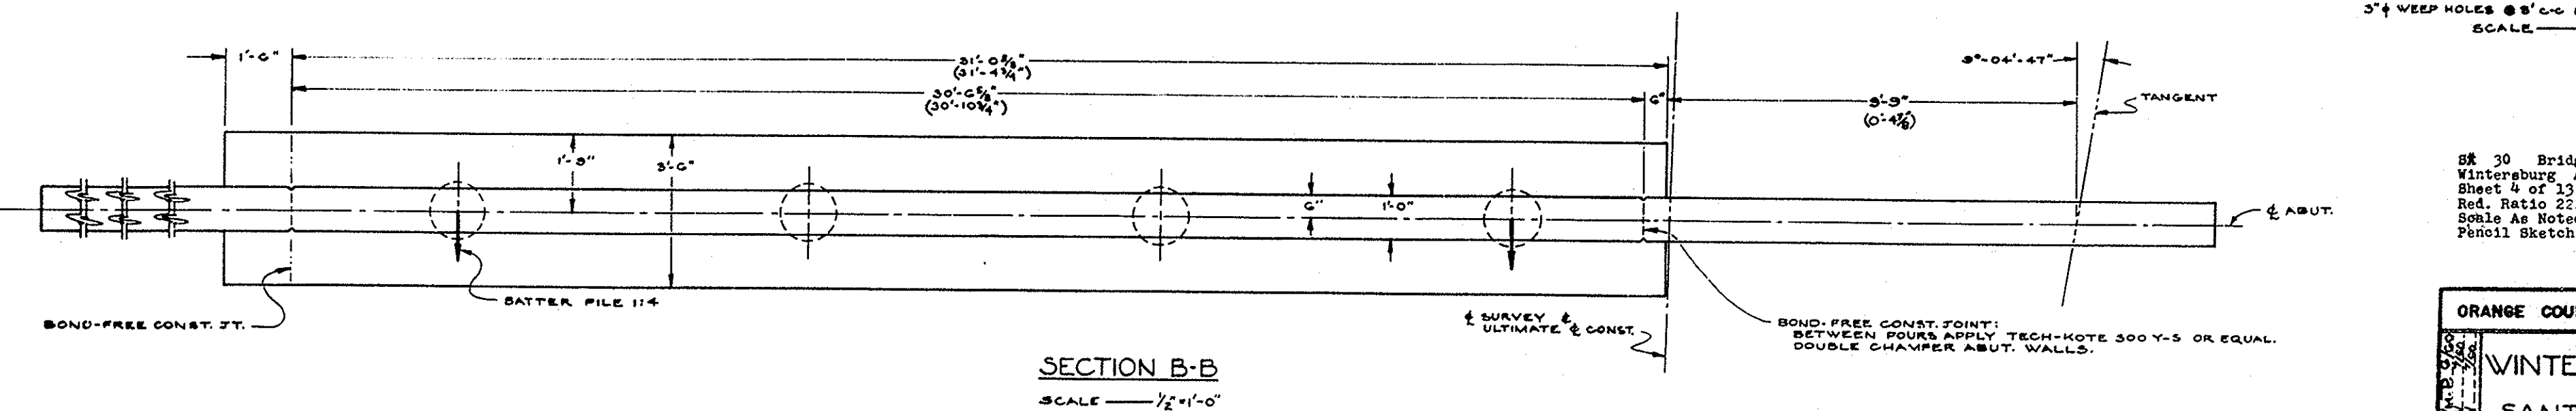
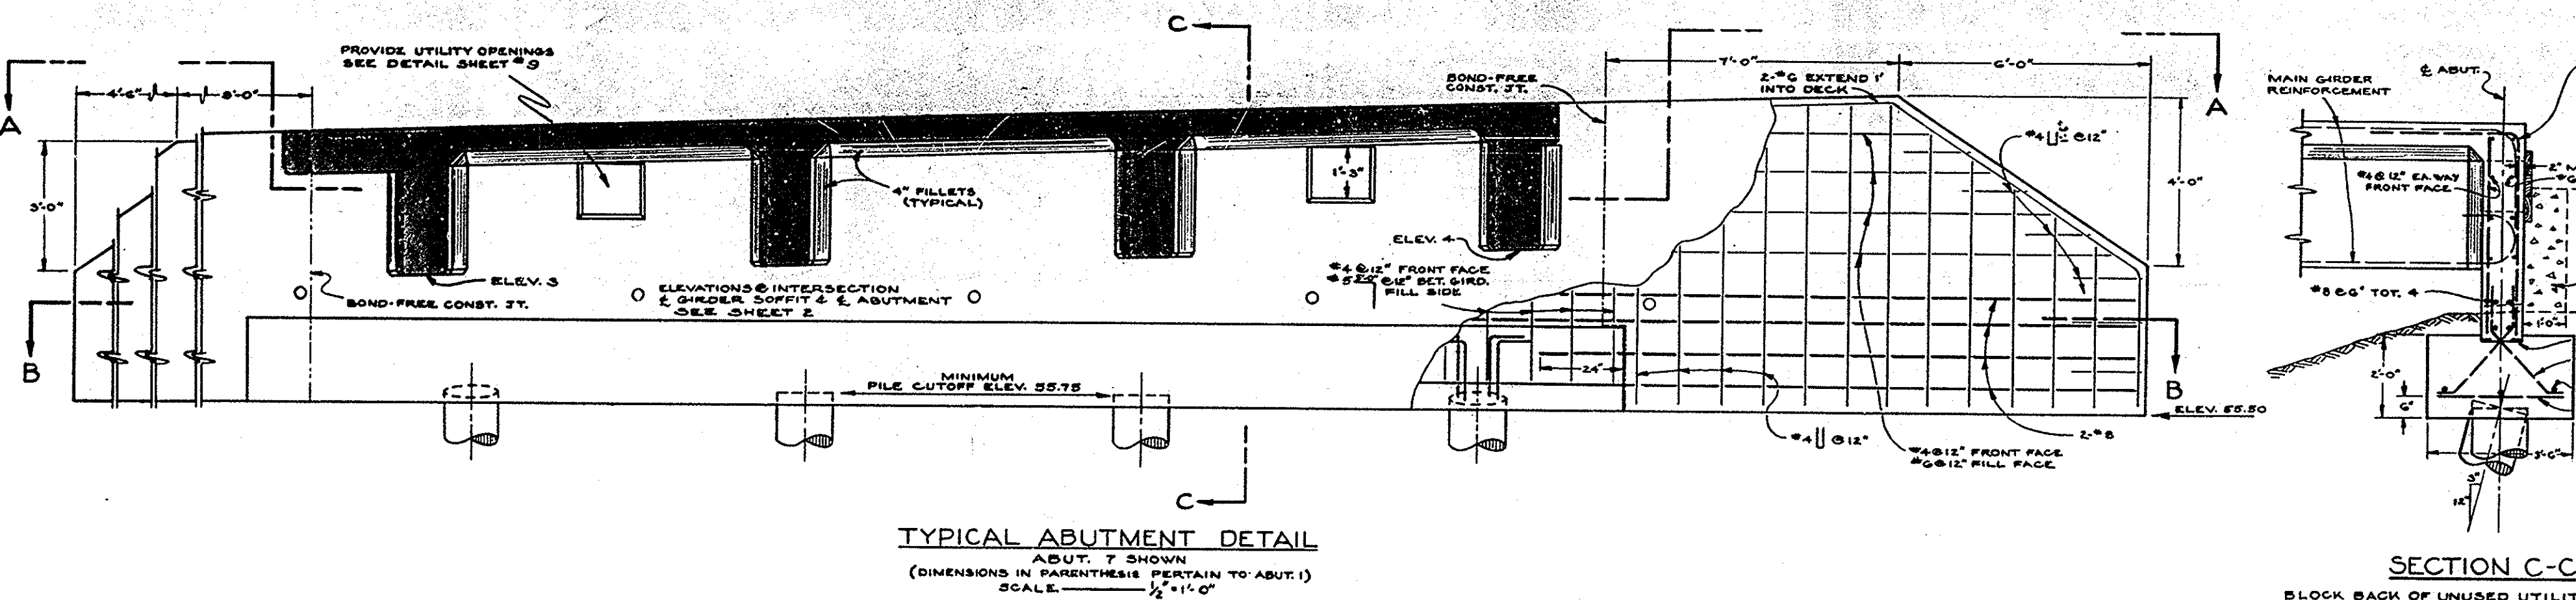


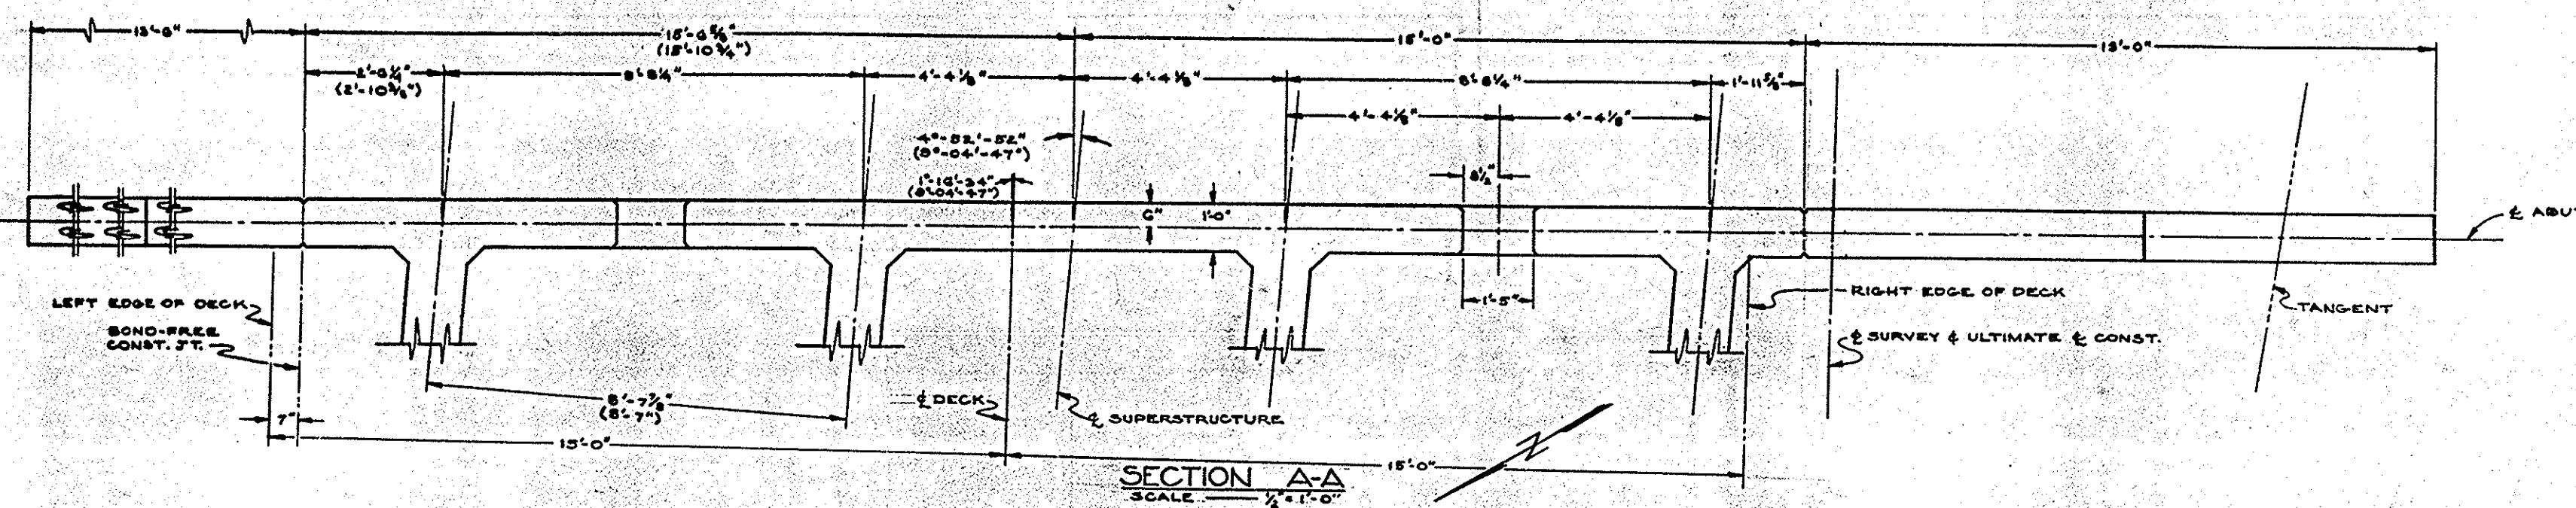

30 Bridge
 Wintersburg Ave.
 Sheet 4 of 13
 Red. Ratio 22.5;1
 Scale As Noted
 Pencil Sketch

ORANGE COUNTY HIGHWAY DEPARTMENT	
WINTERSBURG BRIDGE ACROSS SANTA ANA RIVER	
ABUTMENT DETAIL	
SCALE: NOTED	SHEET 4 OF 13

MICROFILMED
JUN 18 1962
