
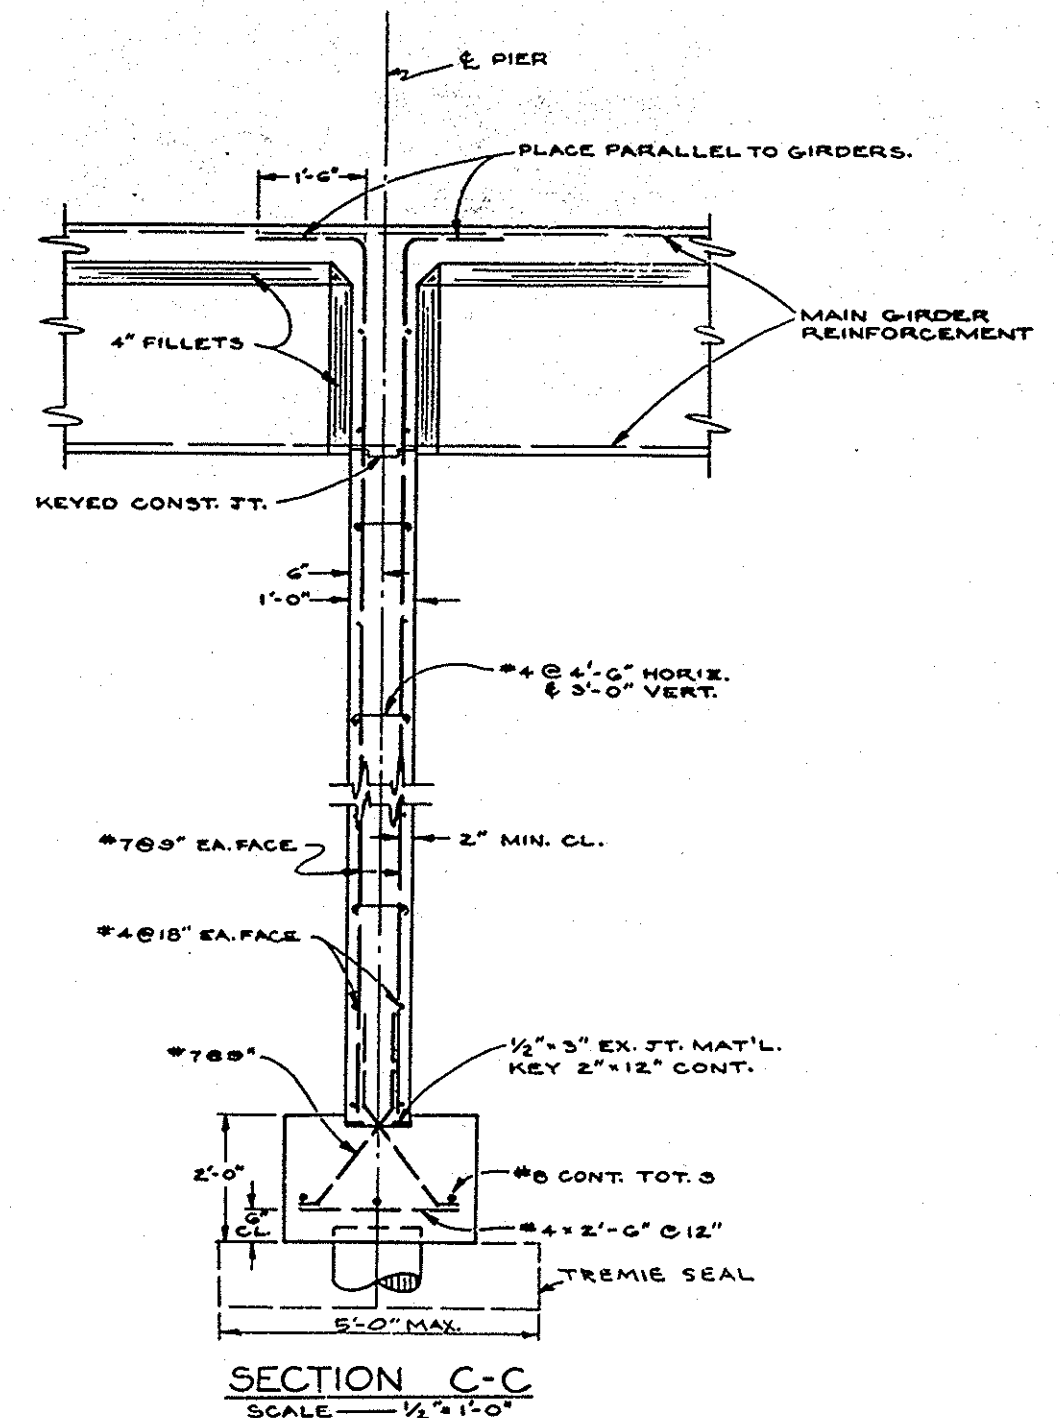
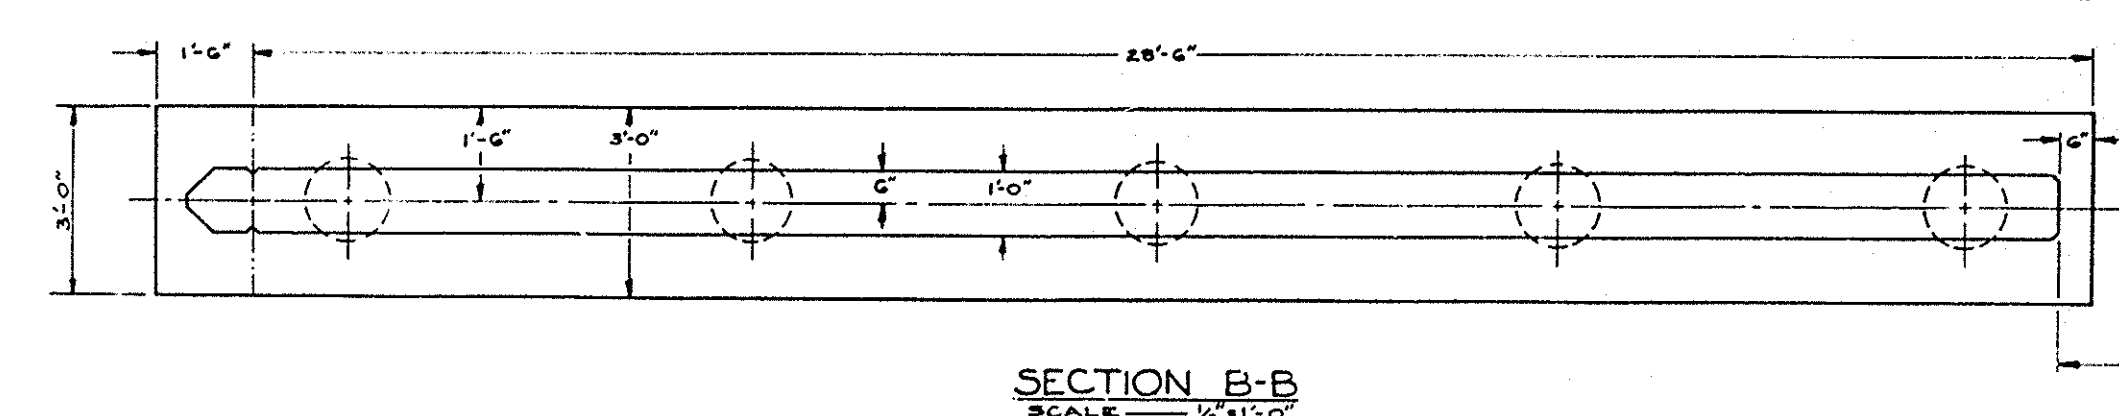
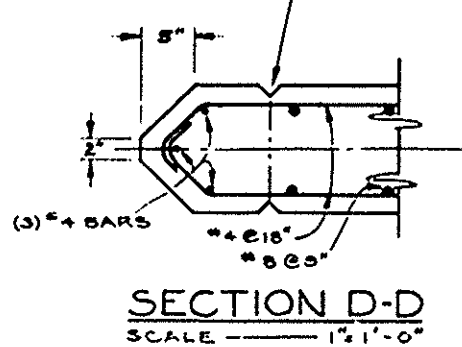
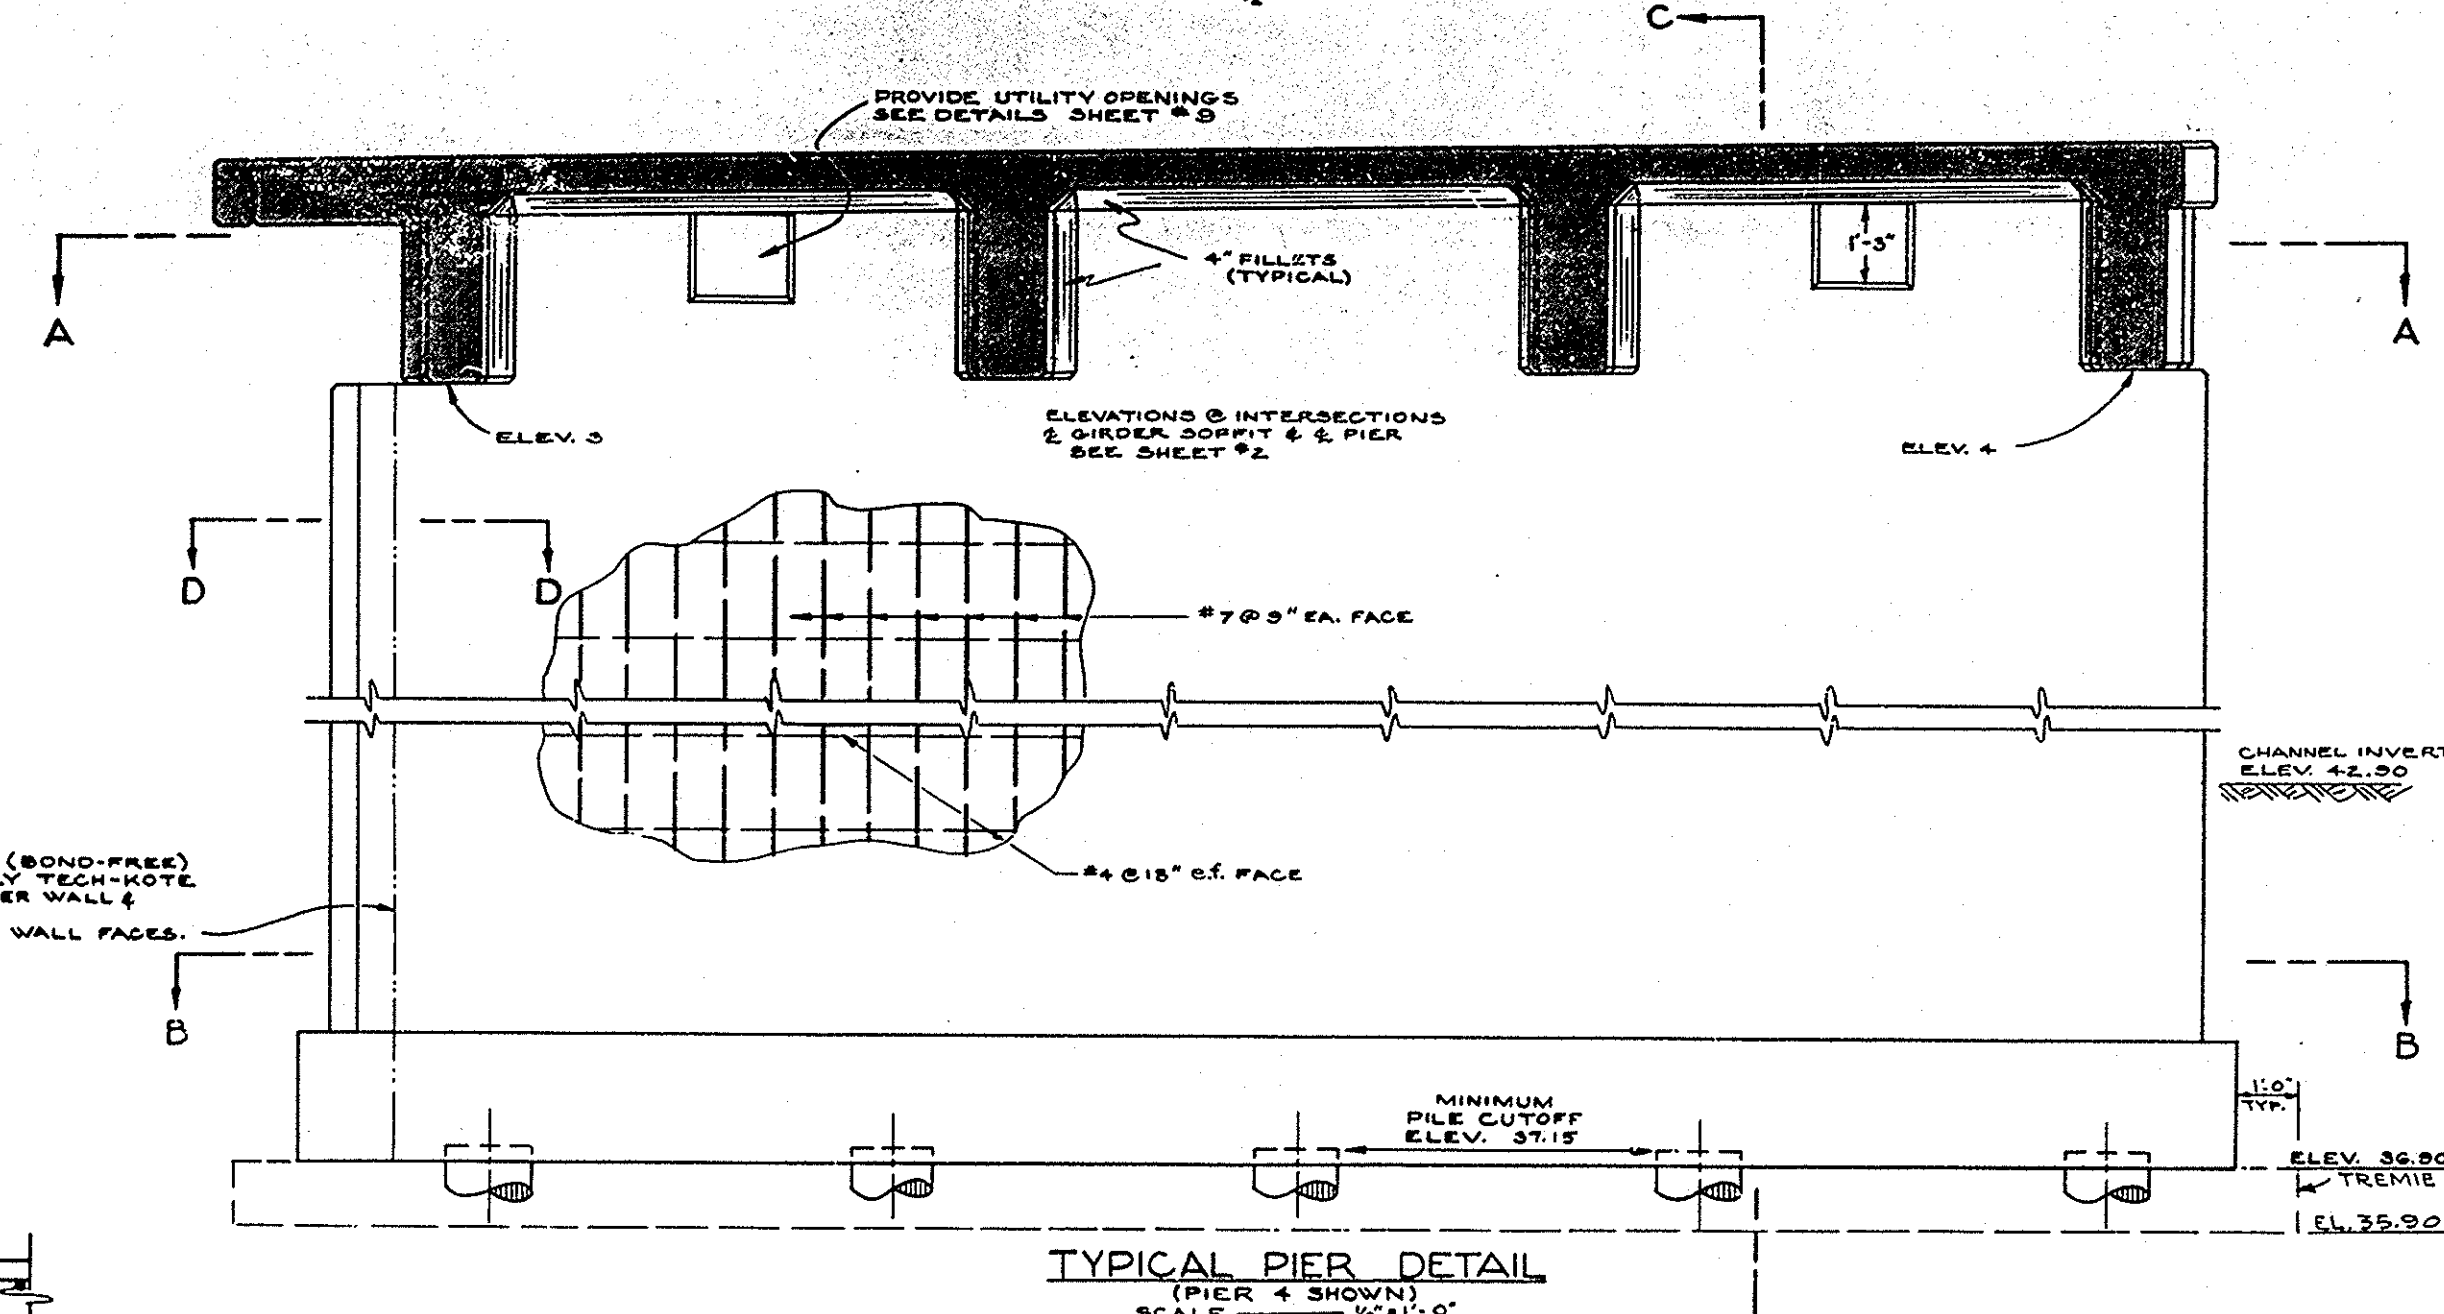


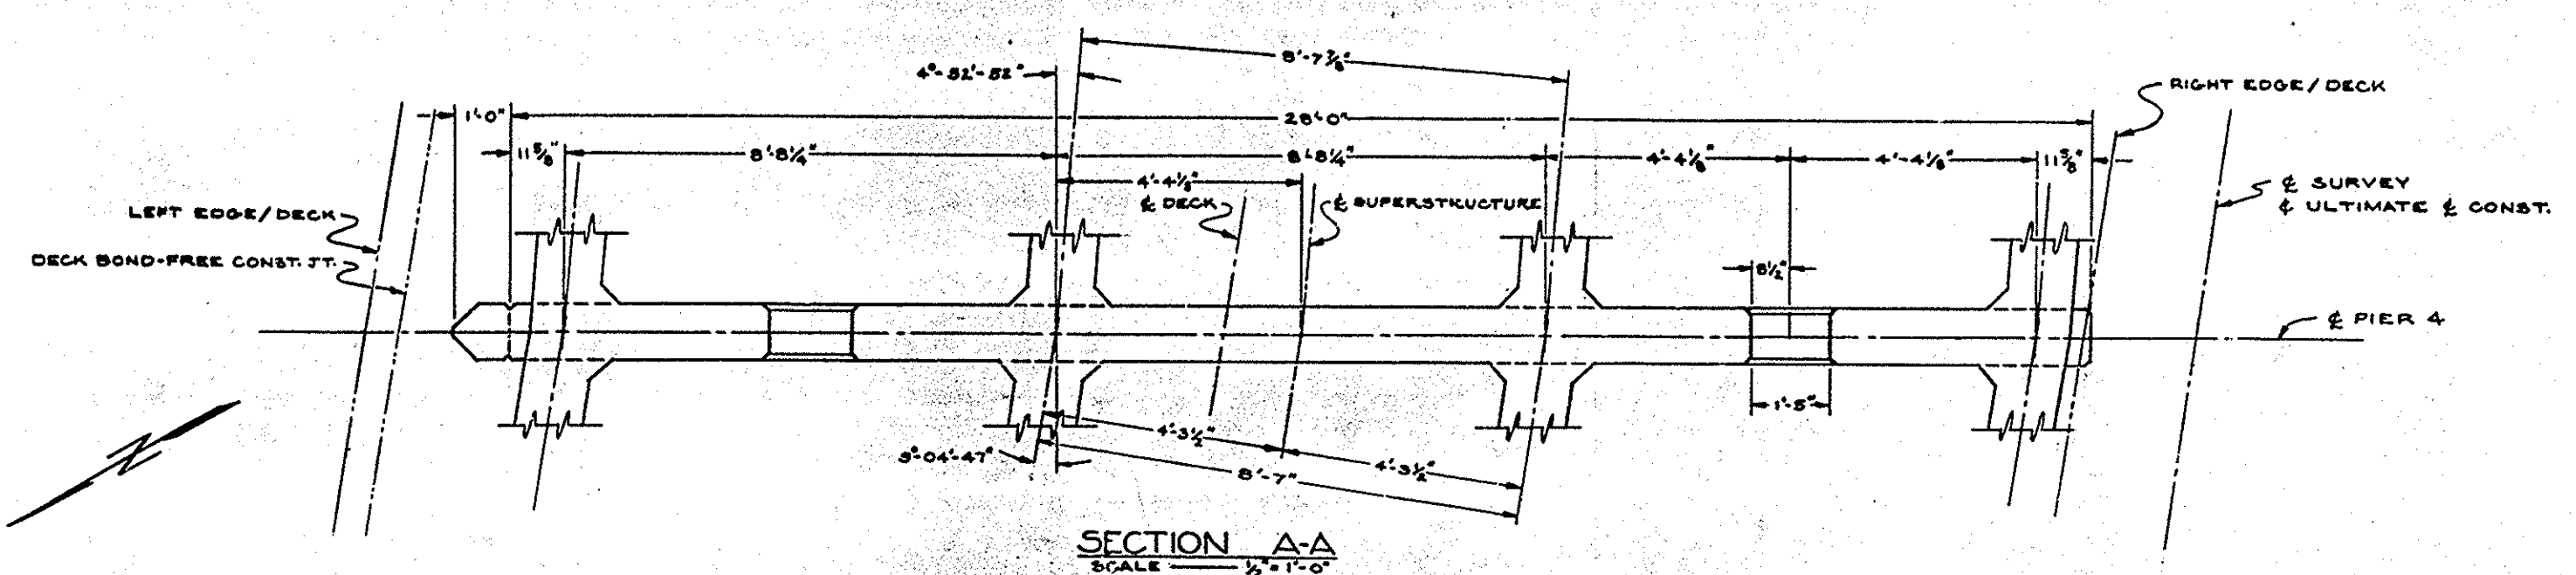

SA 30 Bridge
Wintersburg Ave.
Sheet 5 of 13
Red. Ratio 22.5:1
Scale As Noted
Pencil Sketch

ORANGE COUNTY HIGHWAY DEPARTMENT	
WINTERSBURG BRIDGE	
ACROSS	
SANTA ANA RIVER	
PIER DETAIL	
SCALE: NOTED	SHEET 5 OF 13

MICROFILMED
JUN 18 1962