
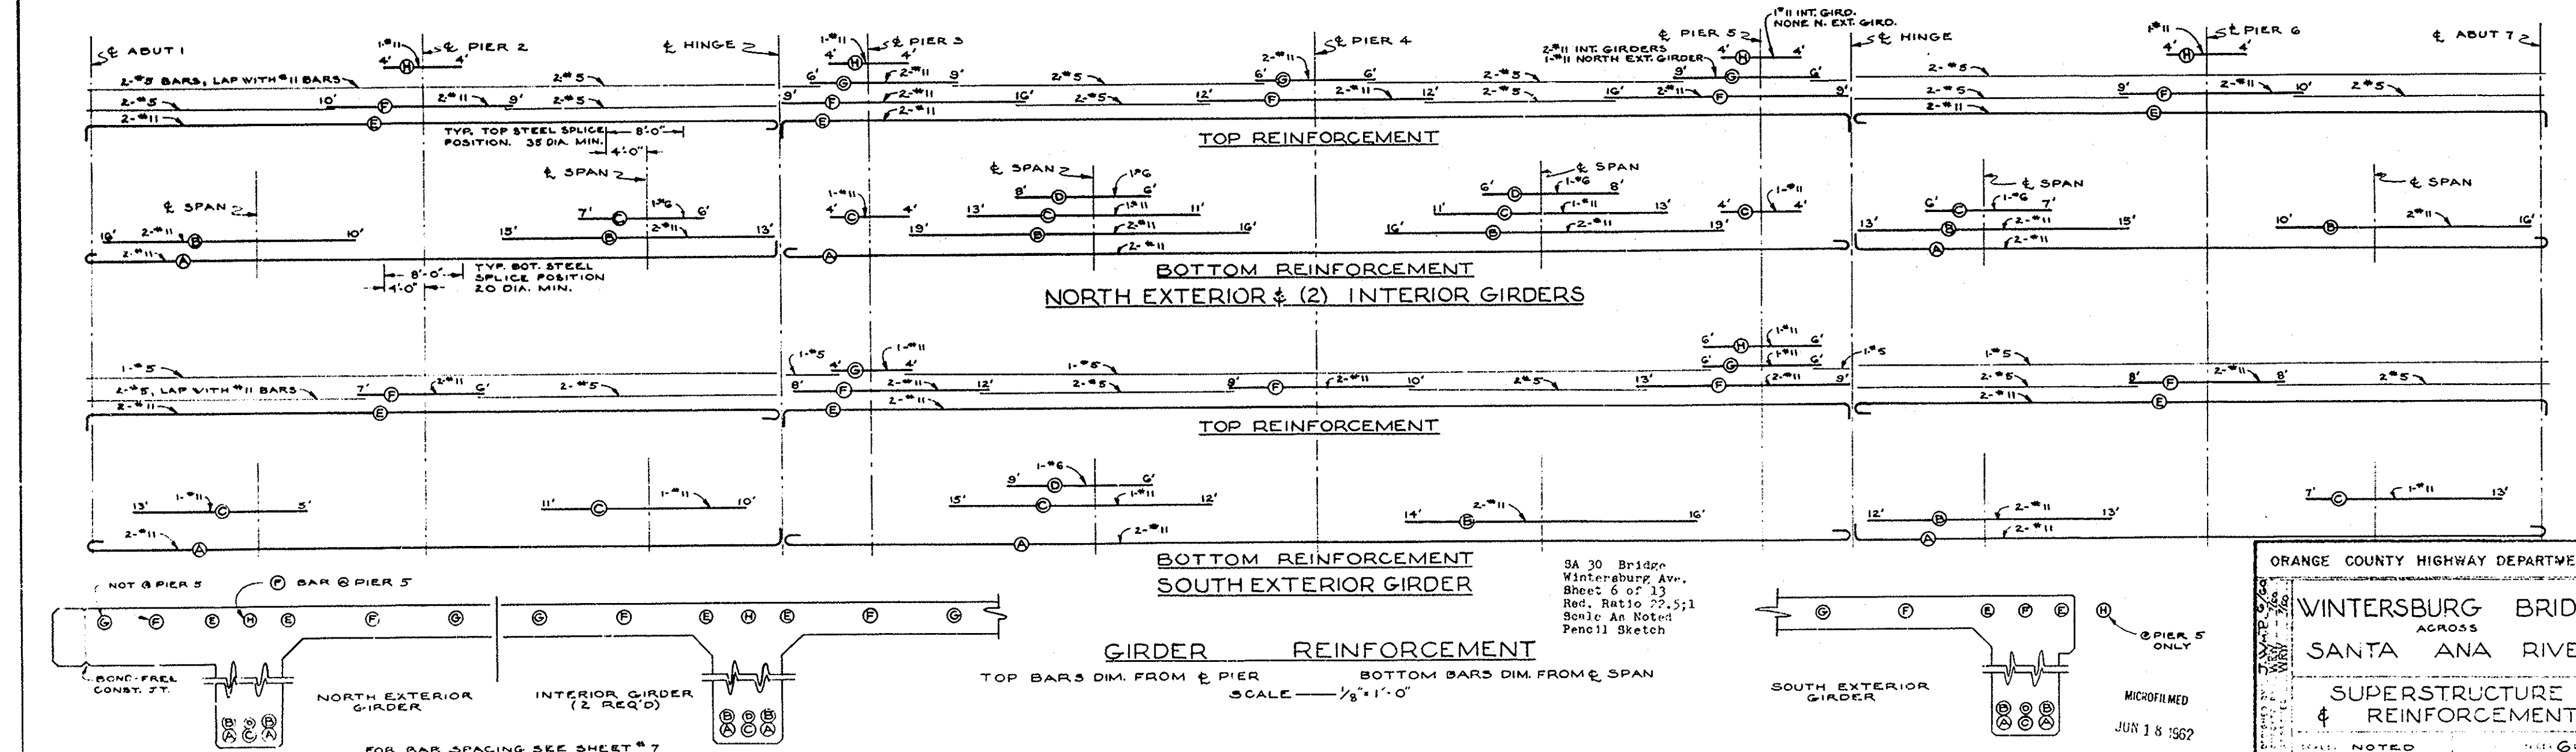
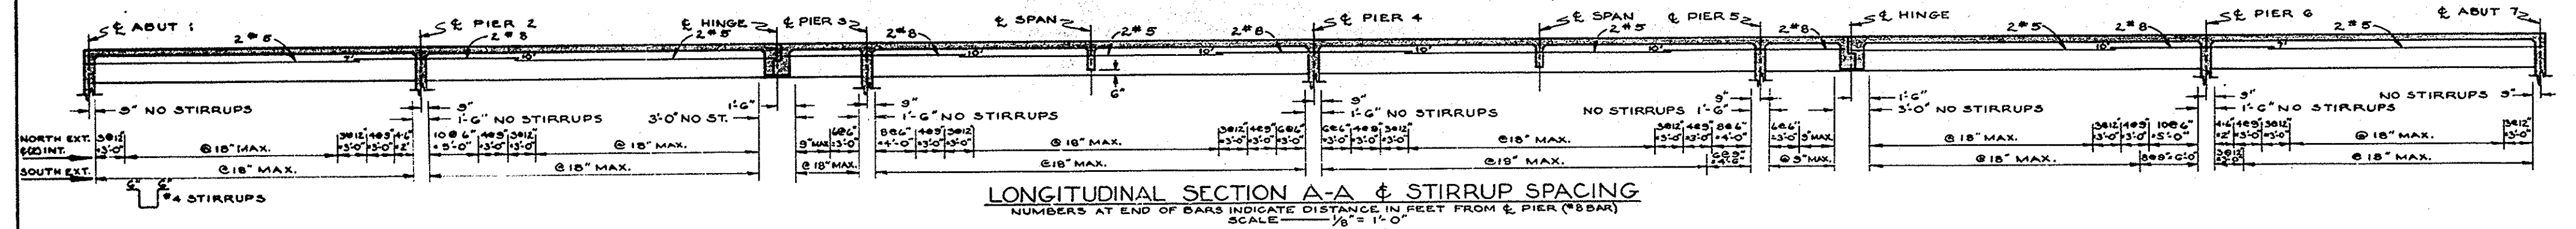


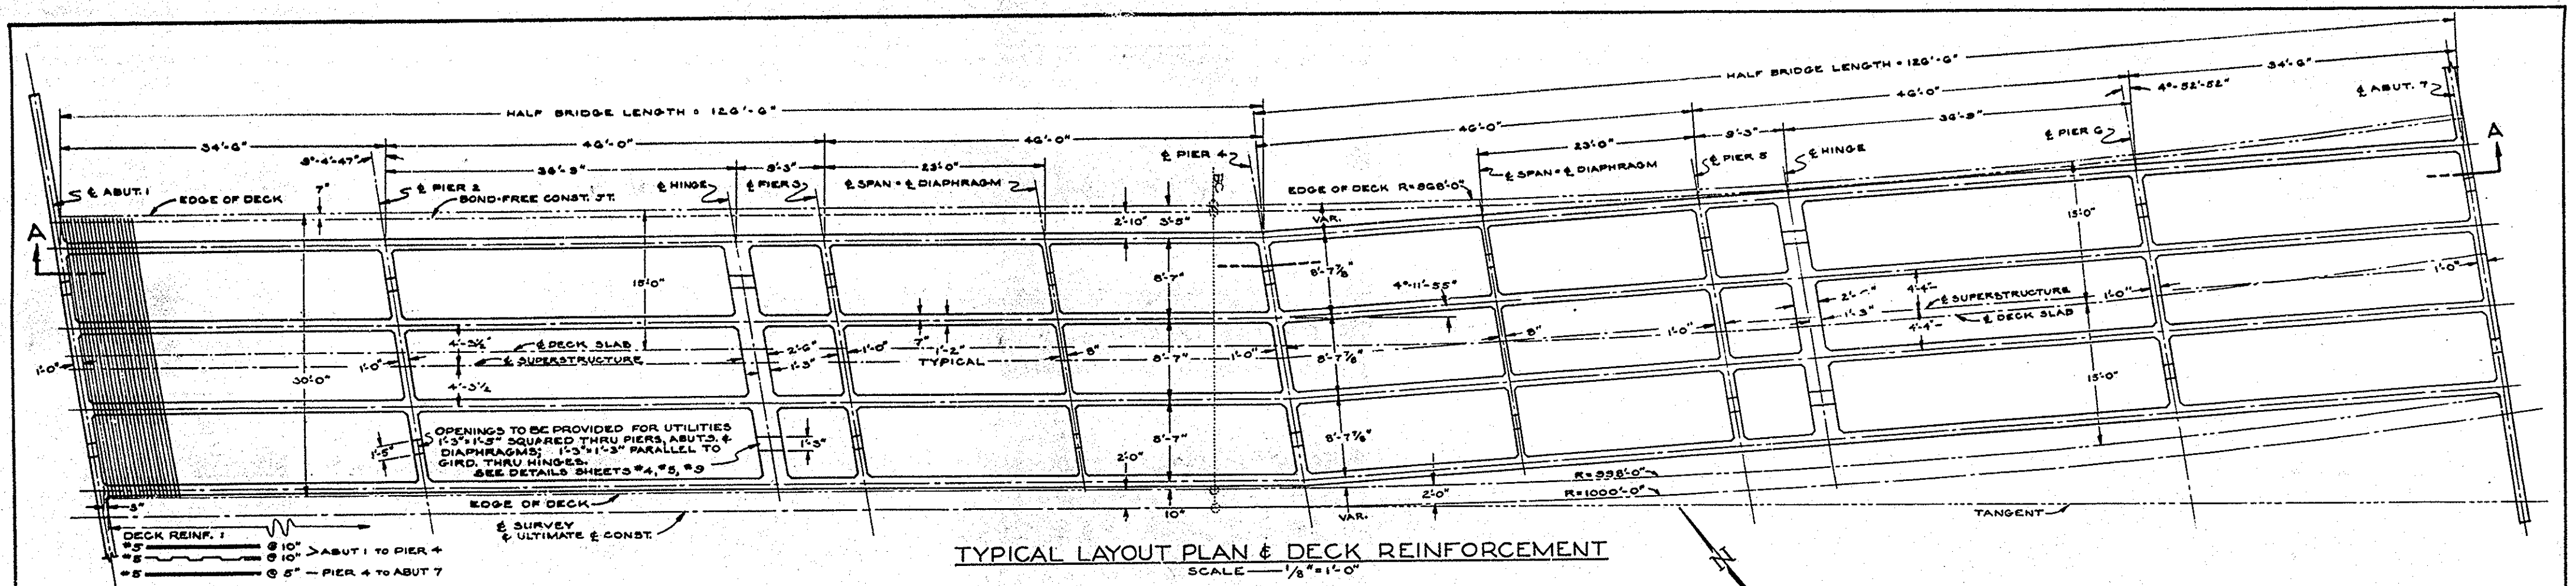

SHEET 6 of 13

SA 30