









Notes:
1. For exact location and direction of openings see other sheets. SEE SHT. #G
2. Location and size of utility openings may be modified as directed by the Engineer, provided minimum dimensions are maintained.
3. Girders not shown, see other sheets.
4. Seal around utilities at abutments to be of sufficient strength to withstand earth pressure.
5. All reinforcement detailed to be placed in addition to reinforcement shown on other sheets.
6. Stirrups are same size as adjacent stirrups shown on other sheets.
7. Main reinforcement to clear opening as detailed on other sheets.

DESIGNED BY: [Signature]
CHECKED BY: [Signature]
APPROVED BY: [Signature]

SCALE: NONE

SHEET 9 of 13

SA - 30

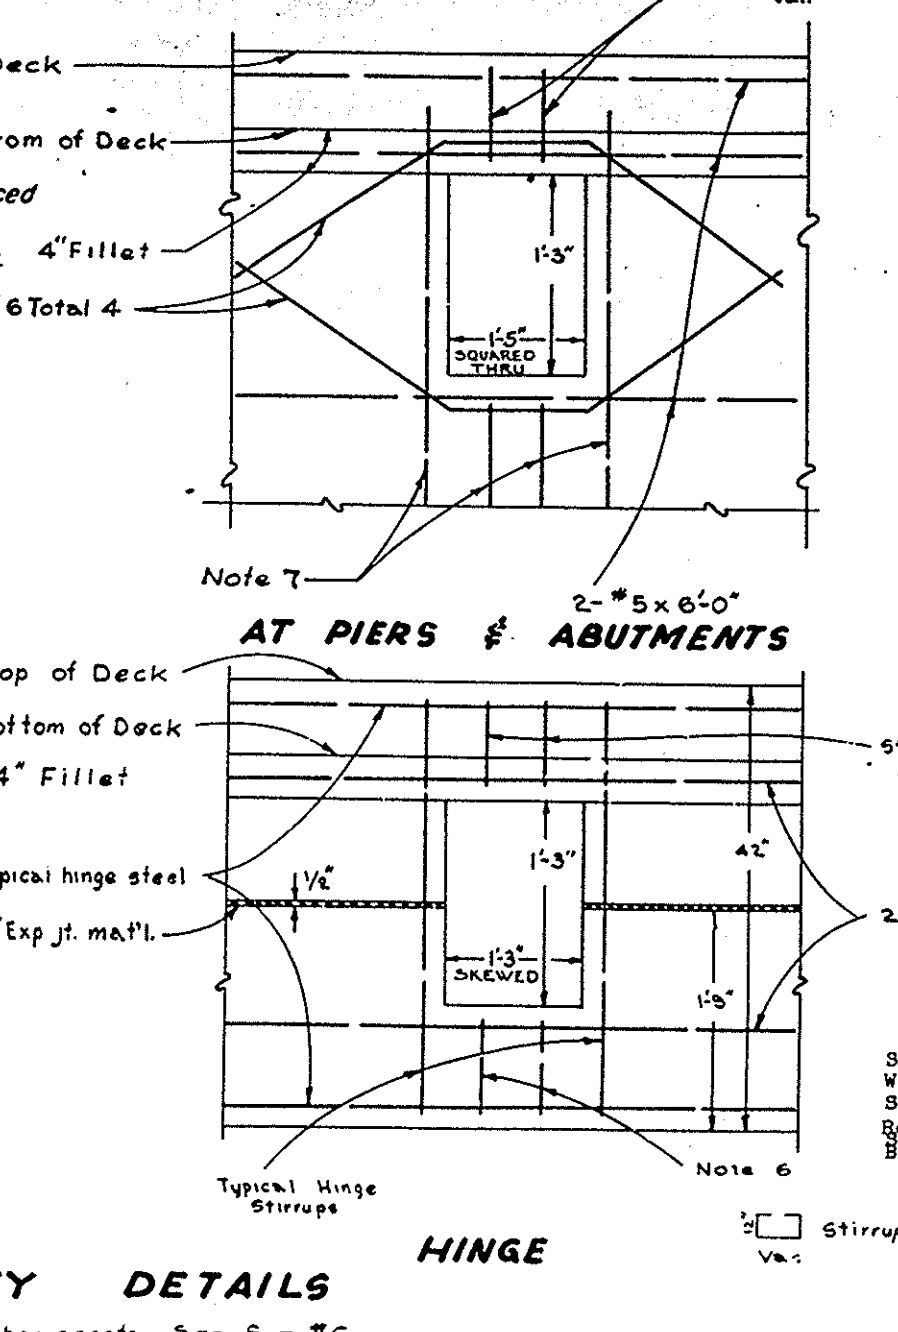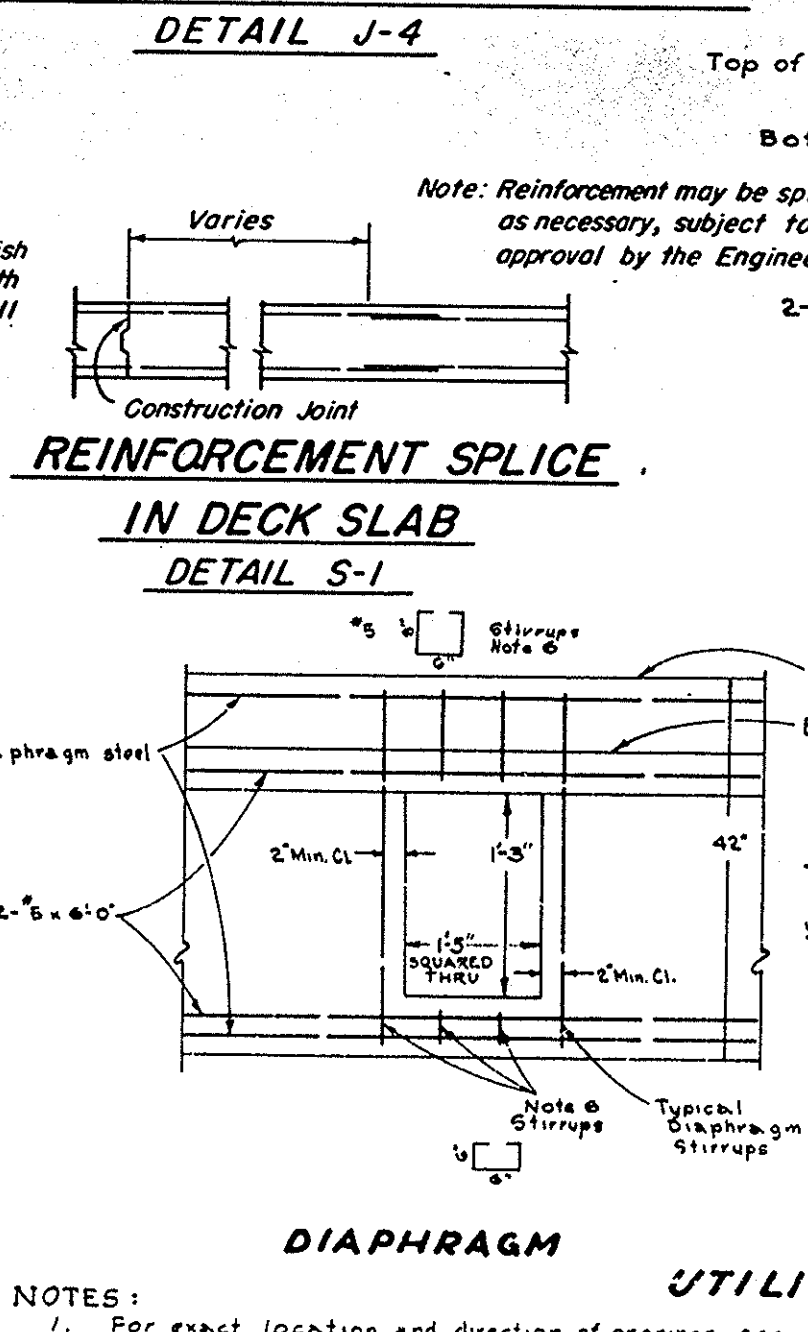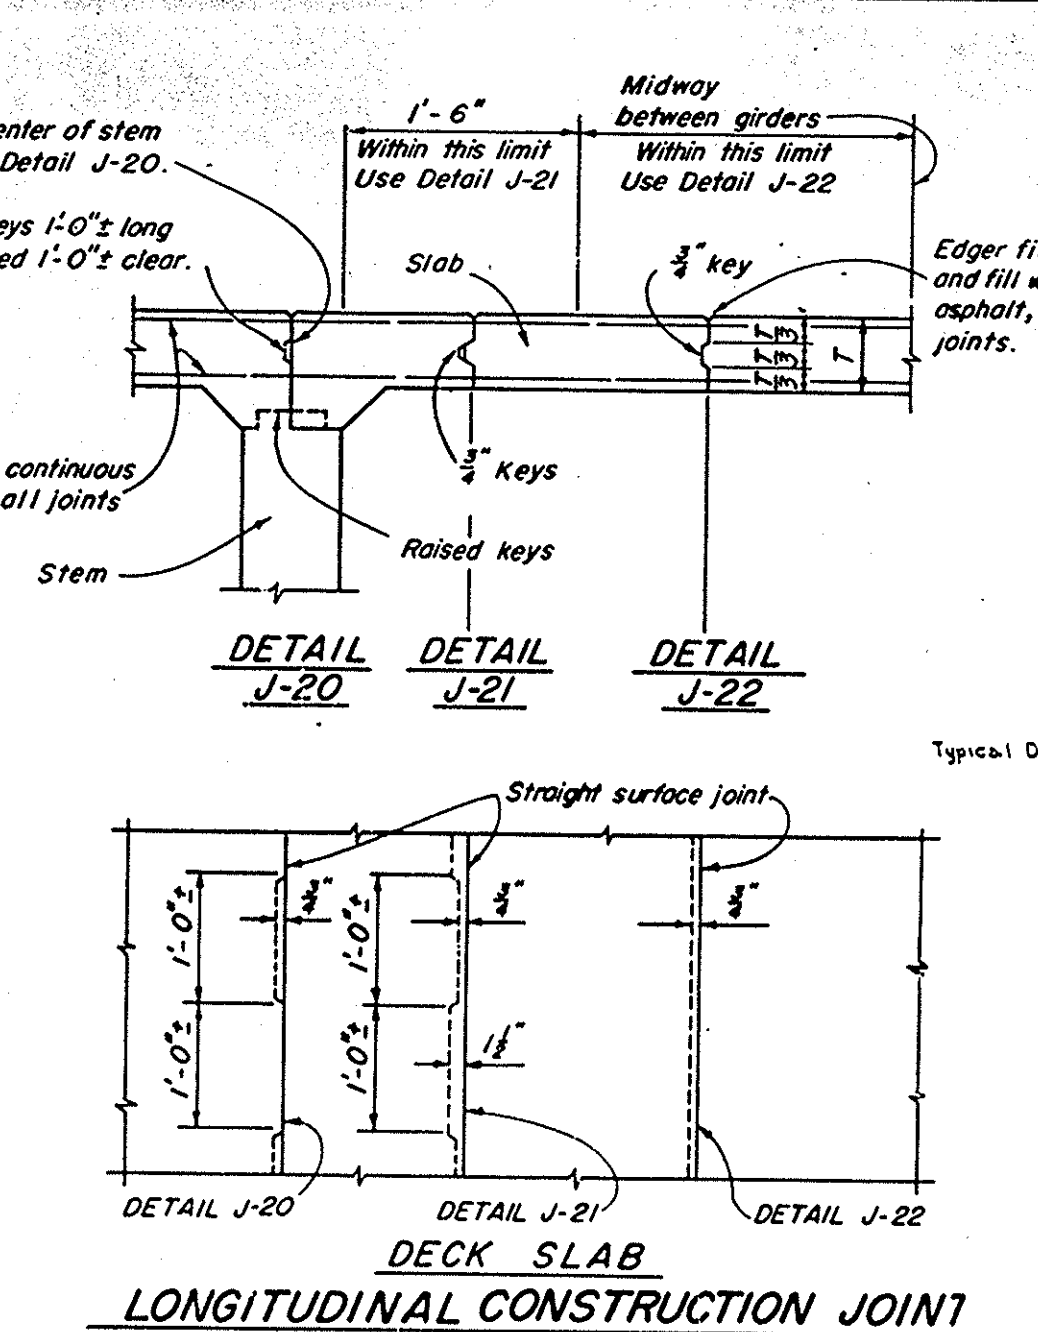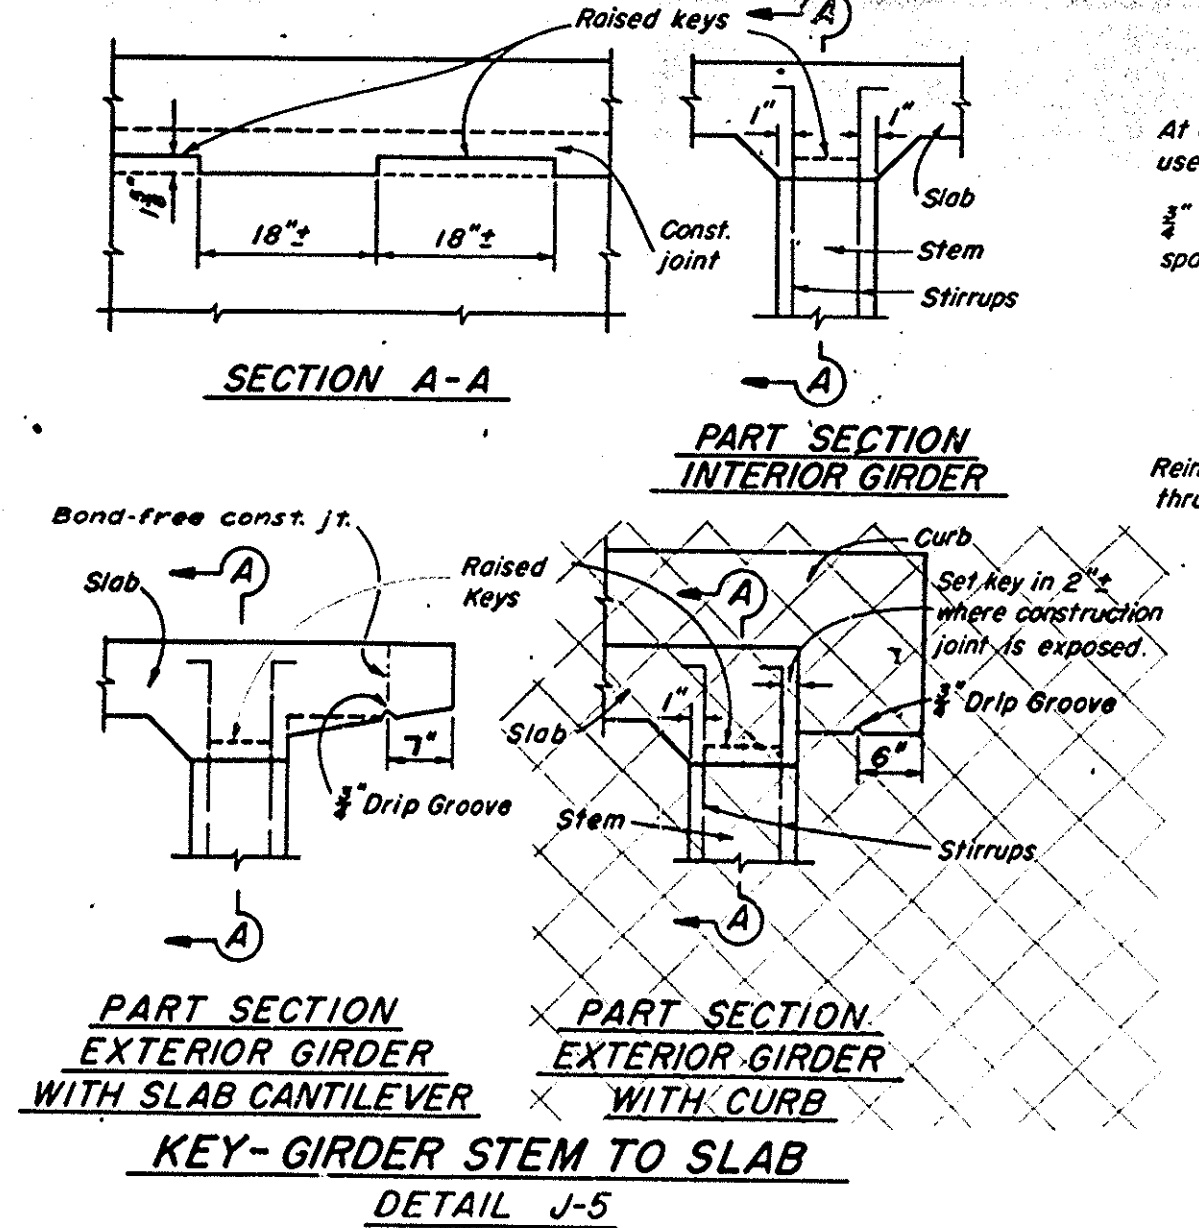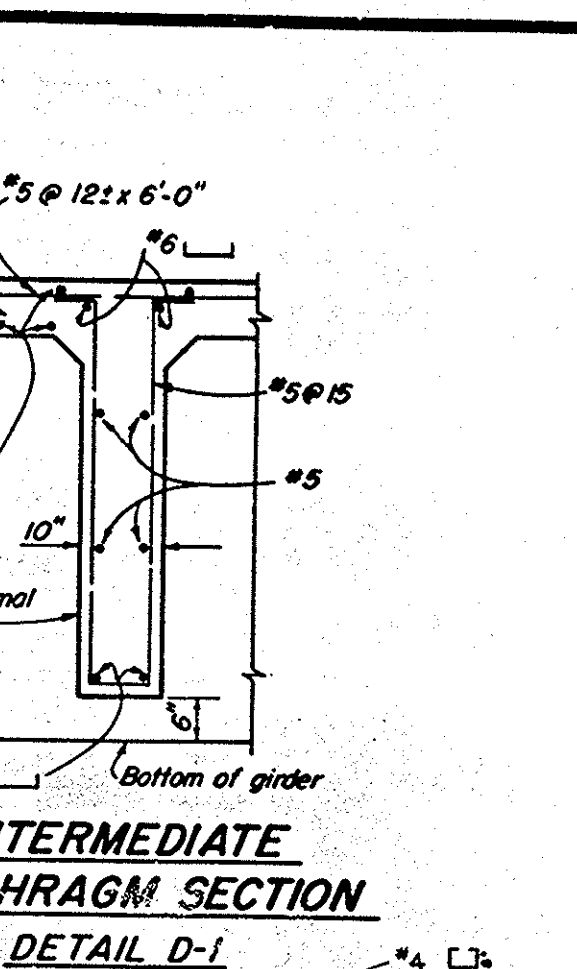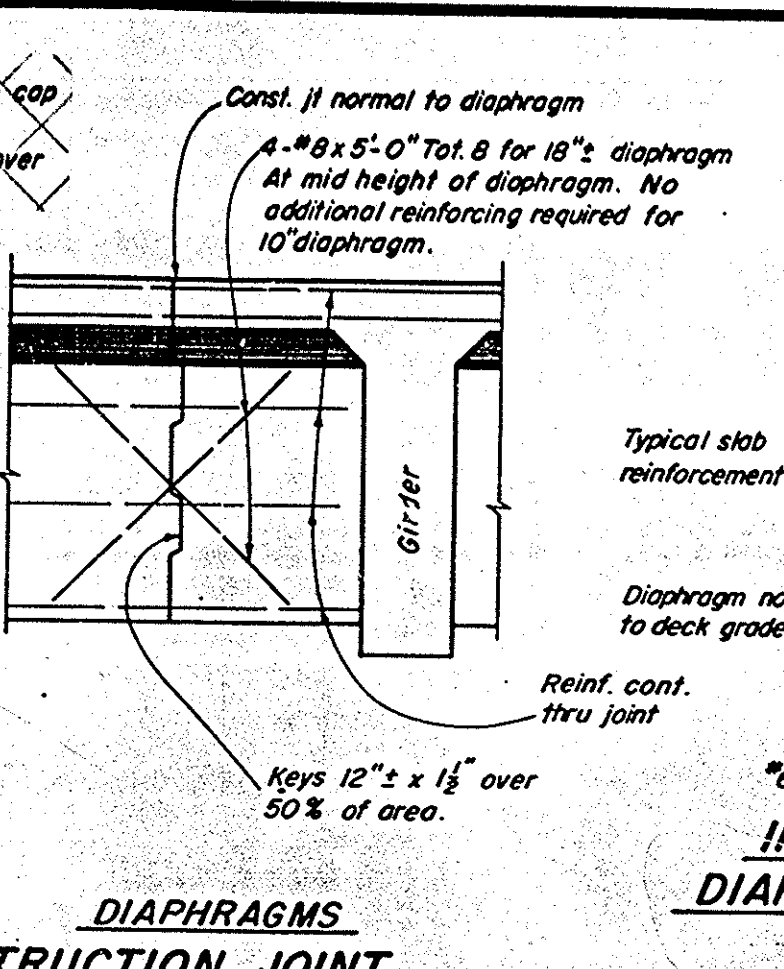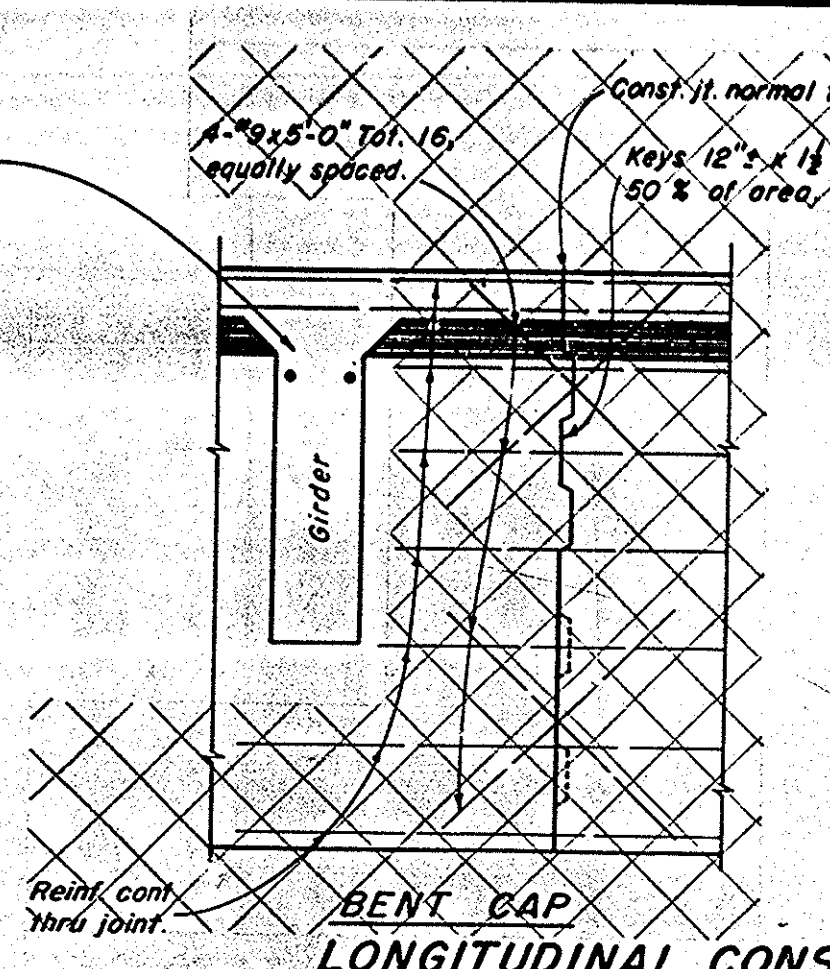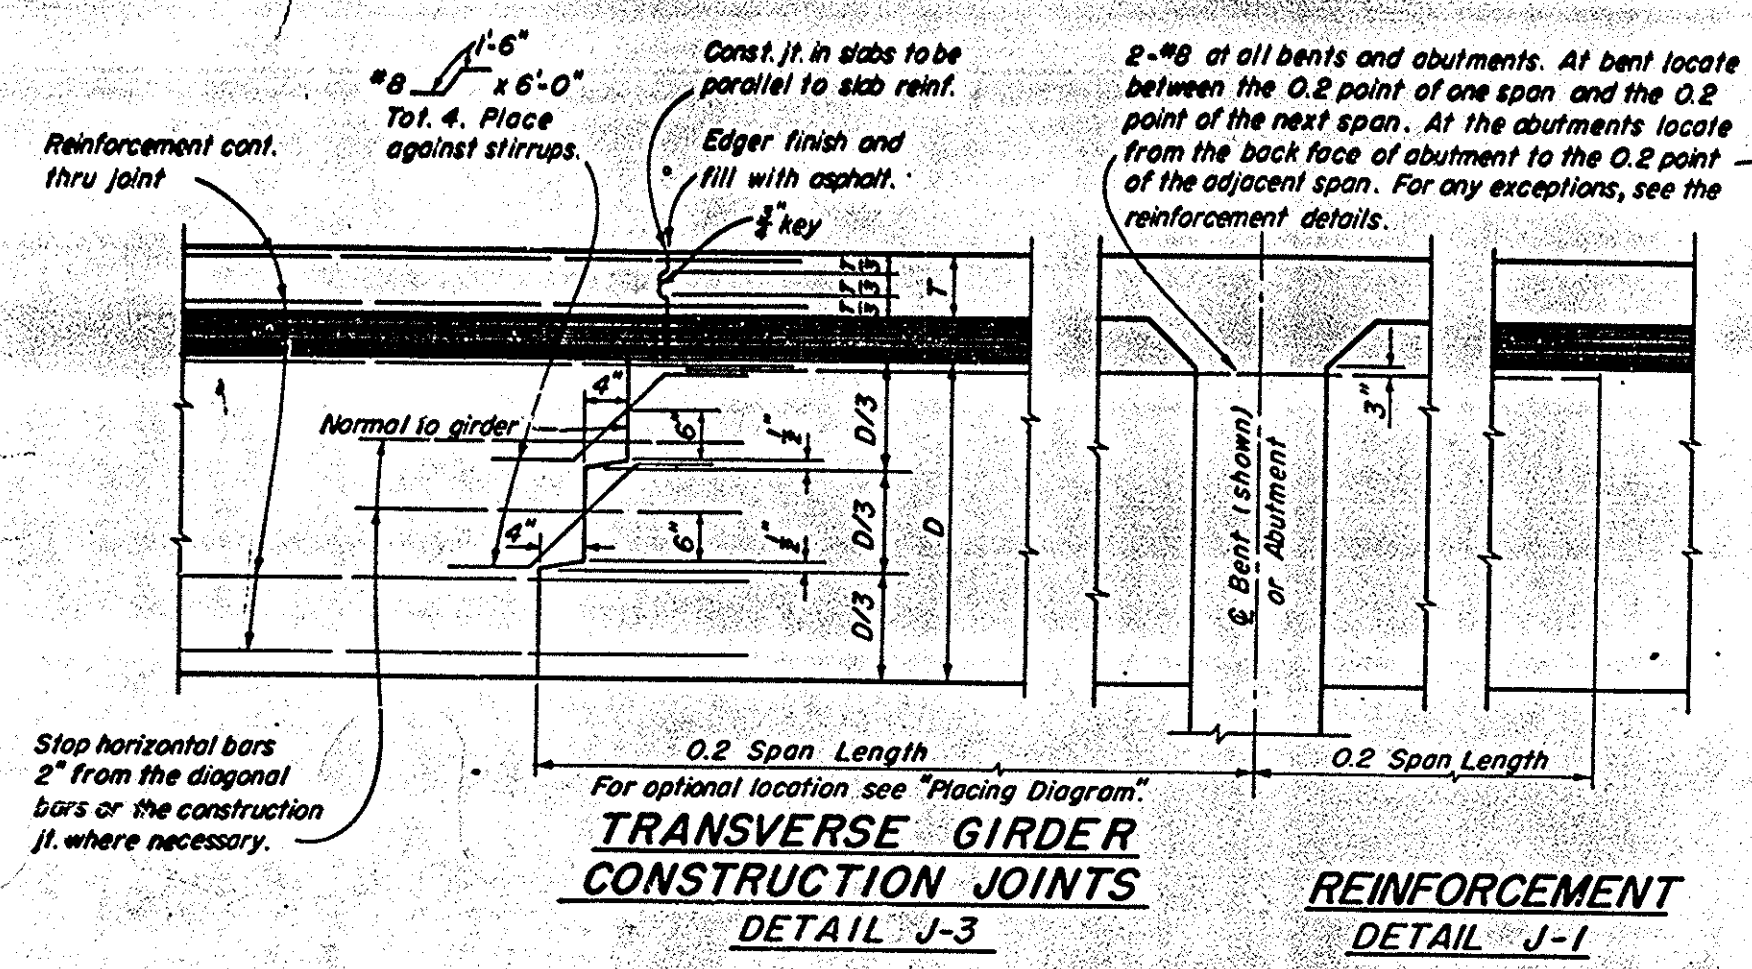

- NOTES:
- For exact location and direction of openings see other sheets. SEE SHT. #G
 - Location and size of utility openings may be modified as directed by the Engineer, provided minimum dimensions are maintained.
 - Girders not shown, see other sheets.
 - Seal around utilities at abutments to be of sufficient strength to withstand earth pressure.
 - All reinforcement detailed to be placed in addition to reinforcement shown on other sheets.
 - Stirrups are same size as adjacent stirrups shown on other sheets.
 - Main reinforcement to clear opening as detailed on other sheets.
- MICROFILMED
JUN 18 1962

ORANGE COUNTY HIGHWAY DEPARTMENT	
WINTERSBURG BRIDGE	
ACROSS	
SANTA ANA RIVER	
MISCELLANEOUS DETAILS	
SCALE: NONE	SHEET 9 OF 13