
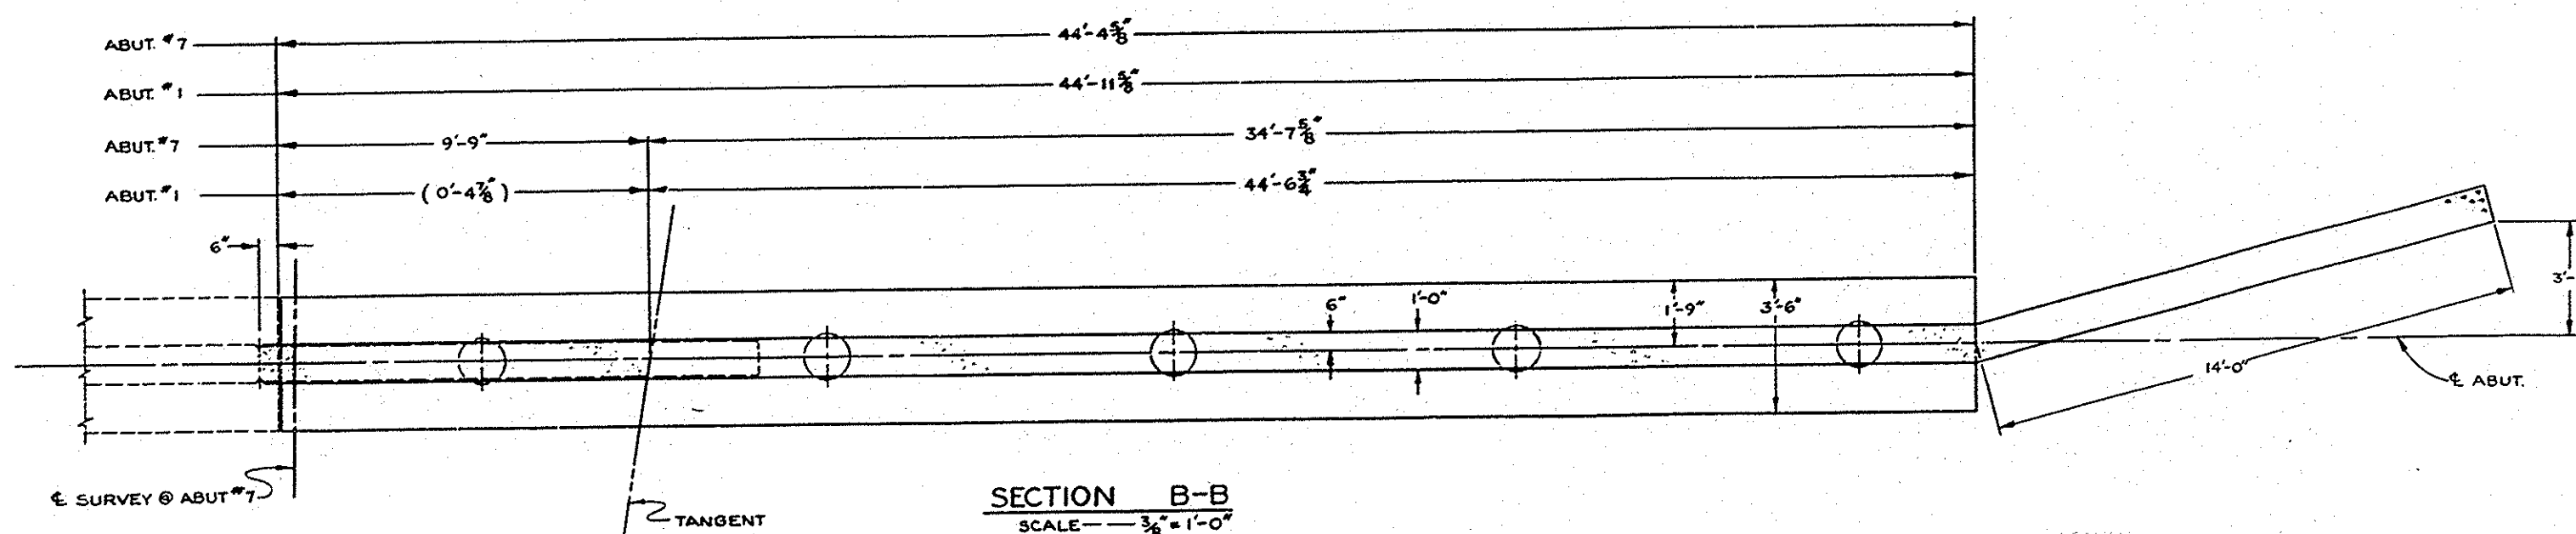
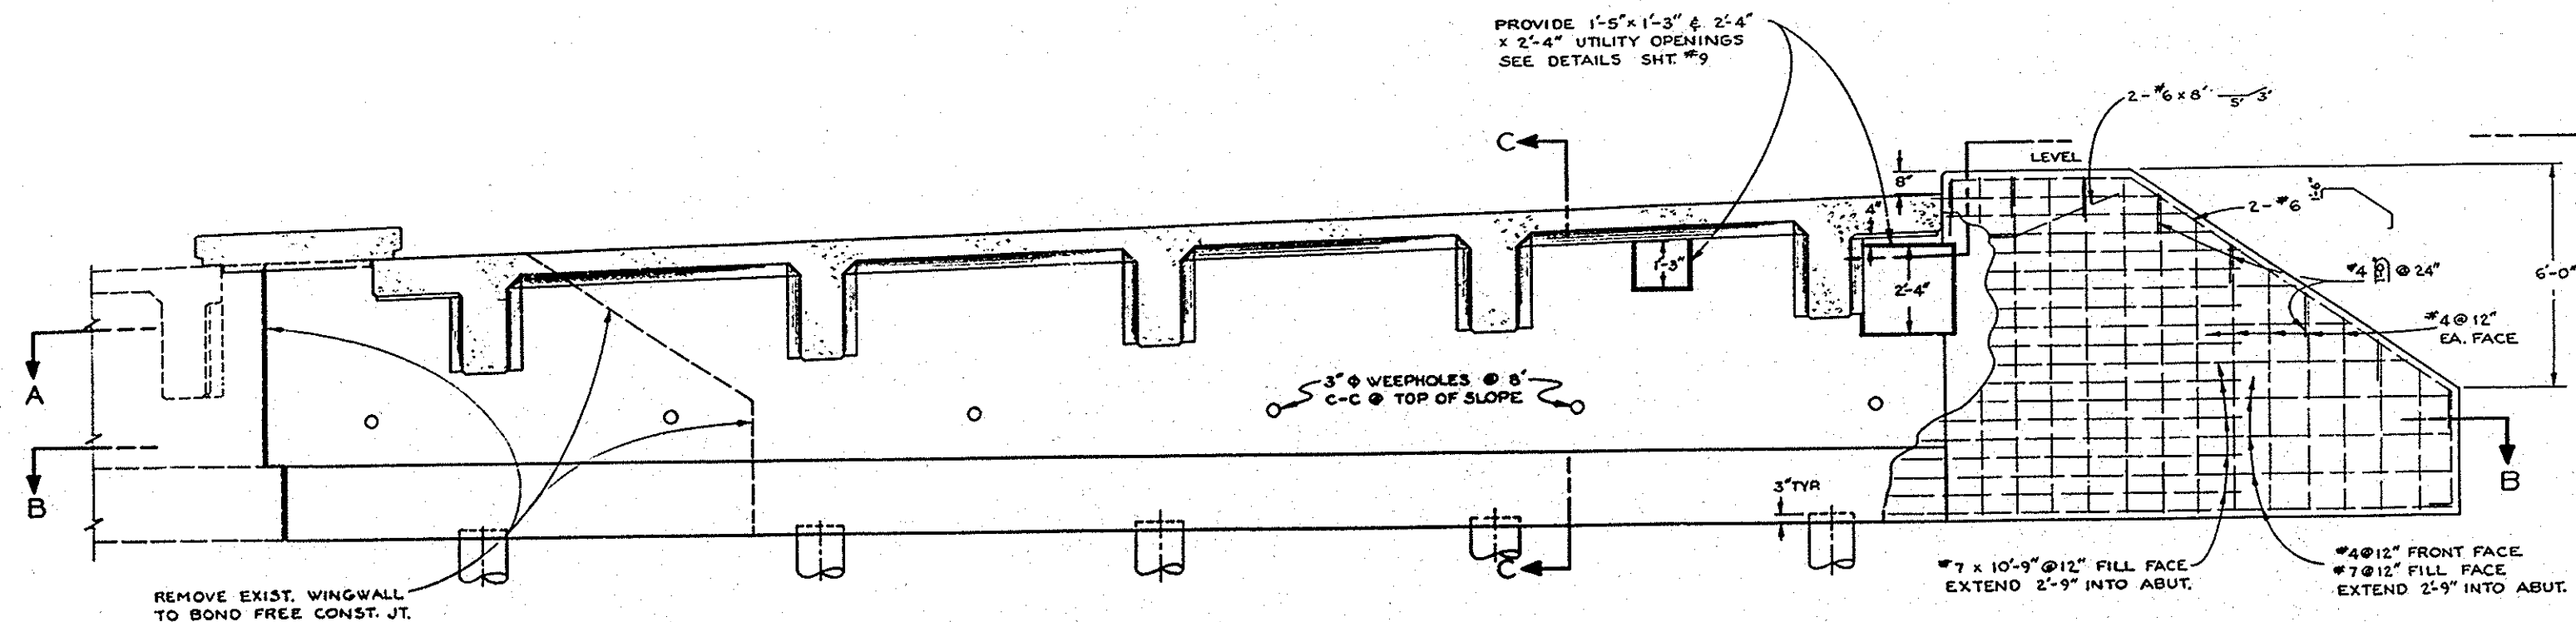
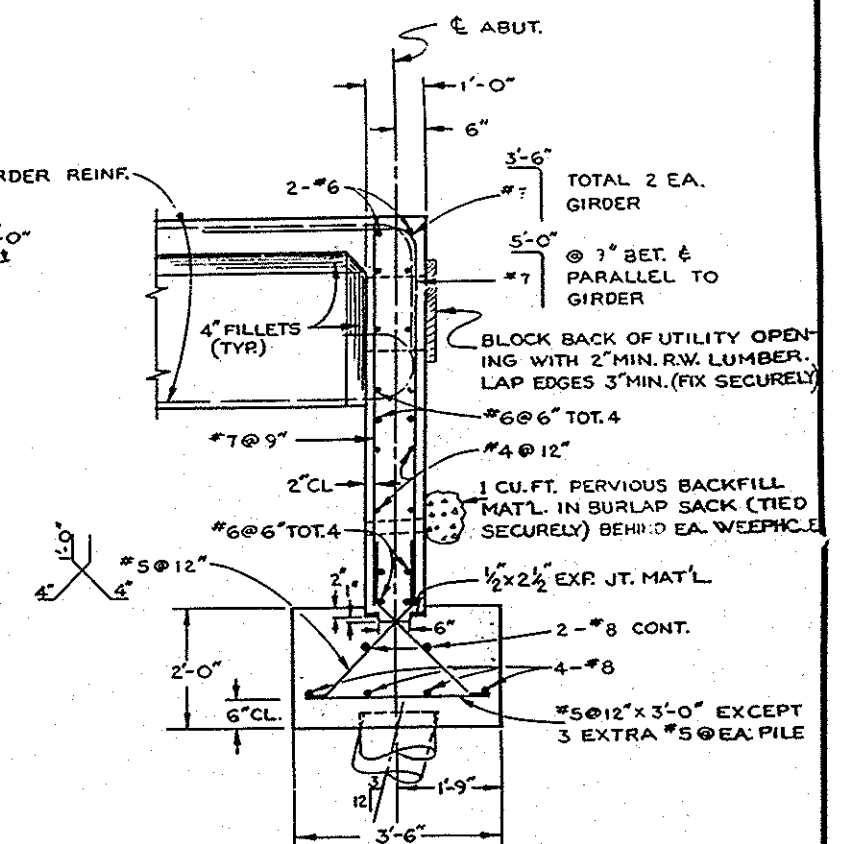


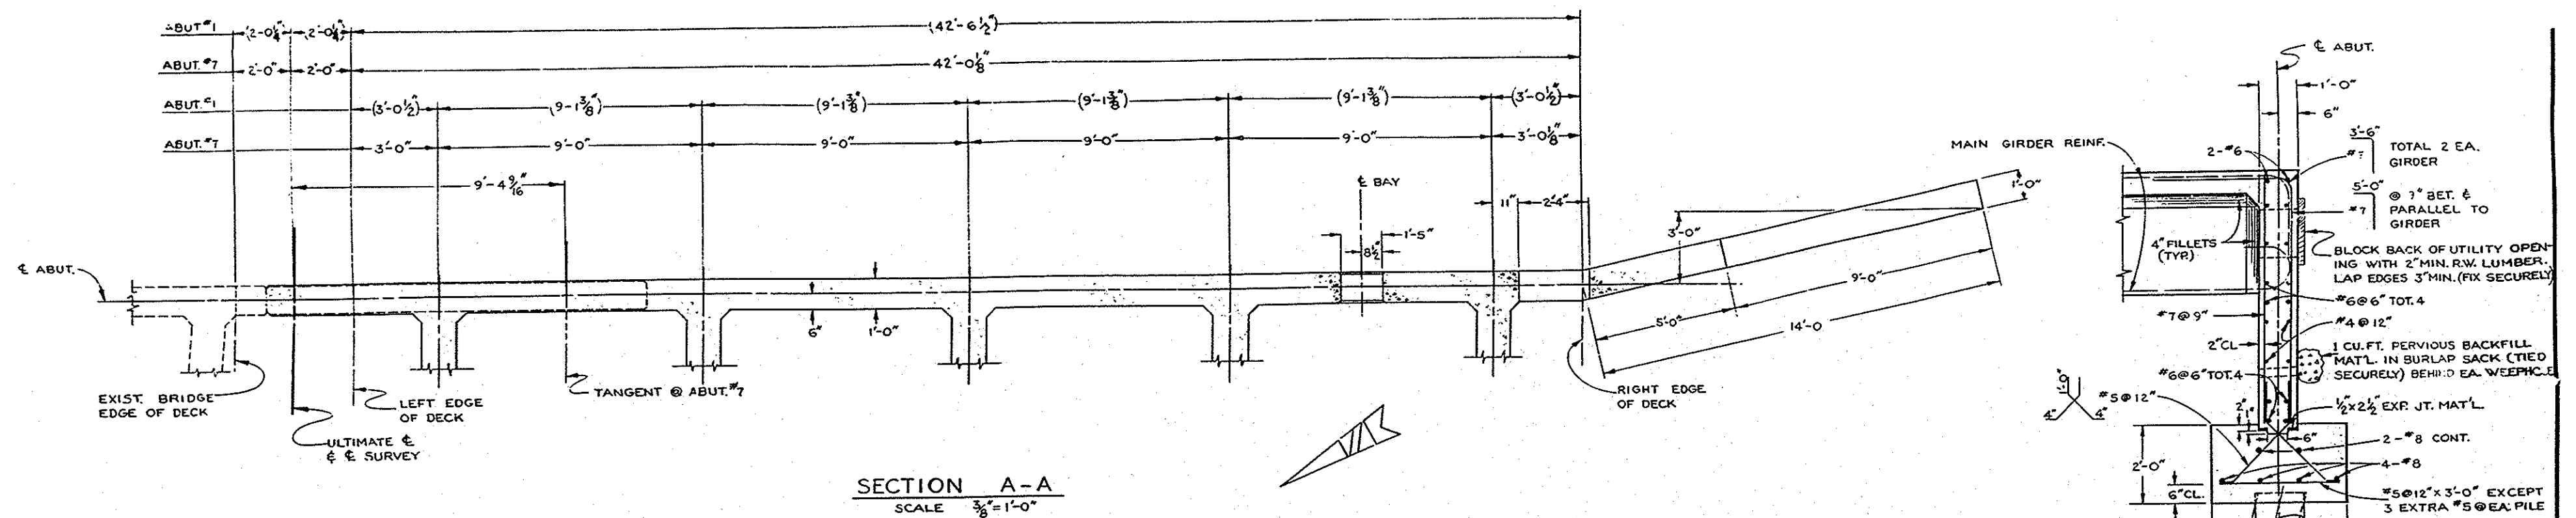

Plan #0007
Warner Ave. Bridge
Span: 40' 11"
Scale: as shown
Set: 22.51
Vallum

WARNER AVE BRIDGE
WIDENING SA-30A
ACROSS
SANTA ANA RIVER
ABUTMENT DETAILS