



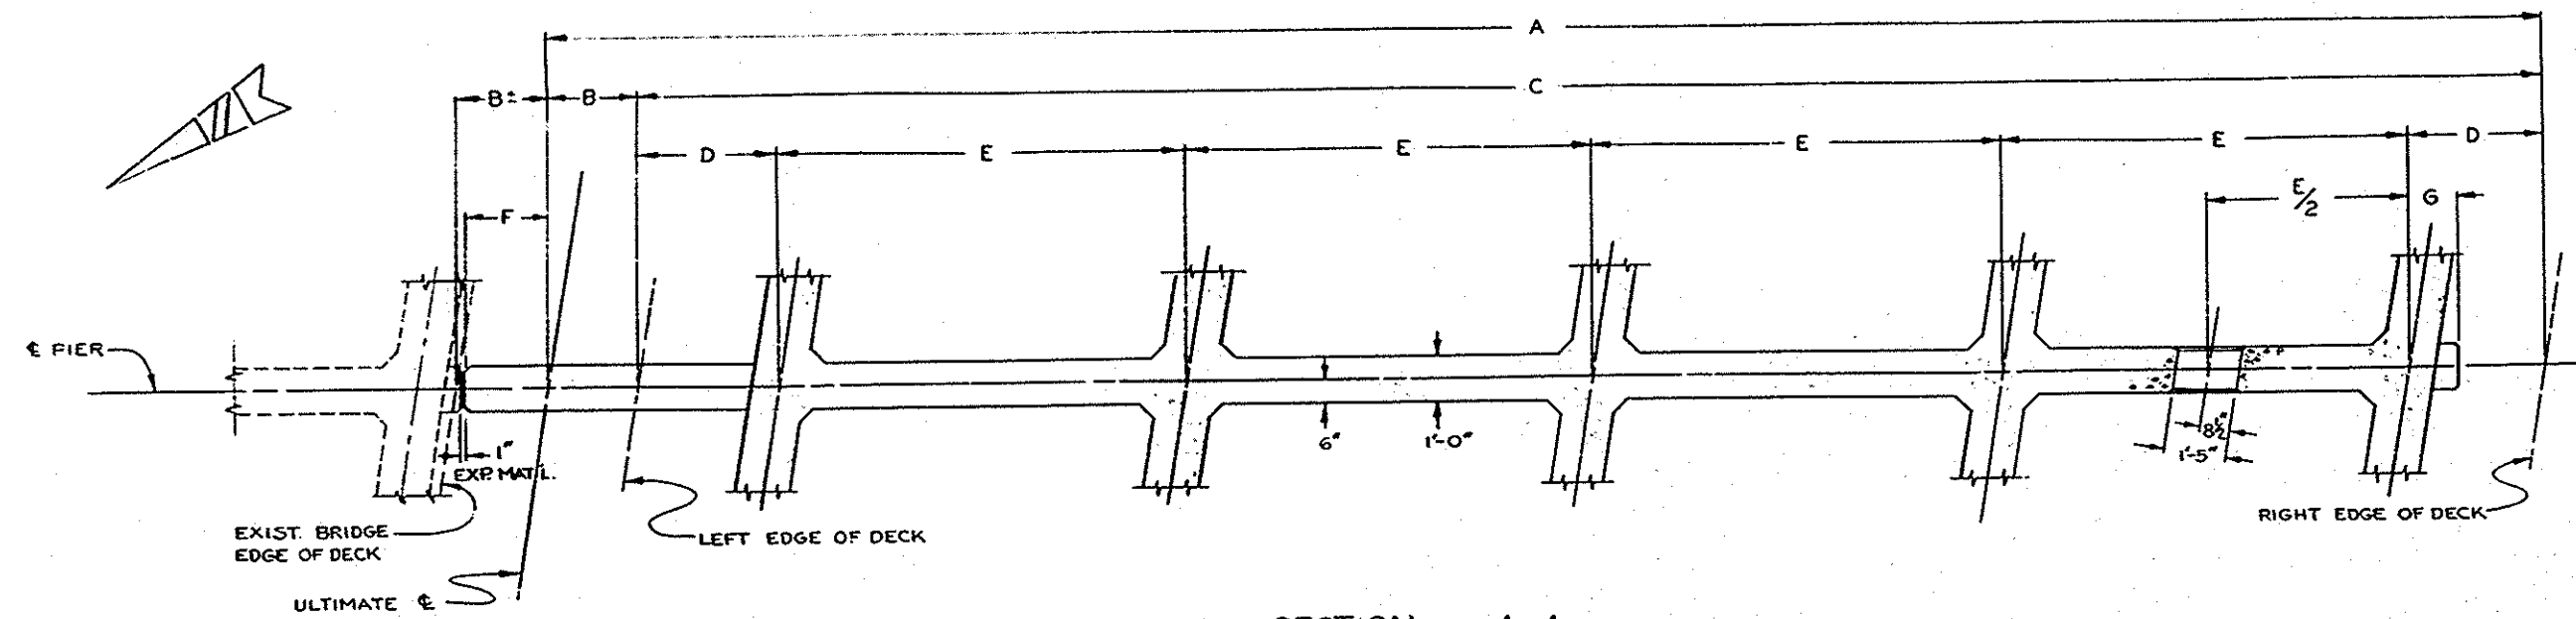


SECTION A-A
SCALE — $\frac{3}{8}$ " = 1'-0"


TABLE OF DIMENSIONS										
PIER NO.	A	B	C	D	E	F	G	H	J	K
2, 3	44'-6 $\frac{3}{4}$ "	2'-0 $\frac{1}{2}$ "	42'-6 $\frac{1}{2}$ "	3'-0 $\frac{1}{2}$ "	9'-1 $\frac{3}{8}$ "	1'-9 $\frac{3}{4}$ "	1'-1 $\frac{1}{8}$ "	44'-5 $\frac{1}{8}$ "	42'-7 $\frac{3}{8}$ "	1'-9 $\frac{3}{4}$ "
4	44'-5 $\frac{5}{8}$ "	2'-0 $\frac{1}{2}$ "	42'-5 $\frac{5}{8}$ "	3'-0 $\frac{1}{2}$ "	9'-1 $\frac{1}{8}$ "	1'-9 $\frac{1}{4}$ "	1'-1 $\frac{1}{8}$ "	44'-3 $\frac{5}{8}$ "	42'-5 $\frac{5}{8}$ "	1'-9 $\frac{3}{4}$ "
5	44'-2 $\frac{3}{8}$ "	2'-0 $\frac{1}{2}$ "	42'-2 $\frac{3}{8}$ "	3'-0 $\frac{1}{2}$ "	9'-0 $\frac{1}{2}$ "	3'-7 $\frac{3}{8}$ "	1'-1"	45'-11 $\frac{1}{8}$ "	40'-8 $\frac{3}{8}$ "	5'-2 $\frac{3}{8}$ "
6	44'-0 $\frac{3}{4}$ "	2'-0"	42'-0 $\frac{3}{4}$ "	3'-0"	9'-0 $\frac{3}{4}$ "	3'-4 $\frac{3}{4}$ "	1'-1"	45'-6 $\frac{3}{4}$ "	36'-10 $\frac{3}{4}$ "	8'-7 $\frac{3}{8}$ "

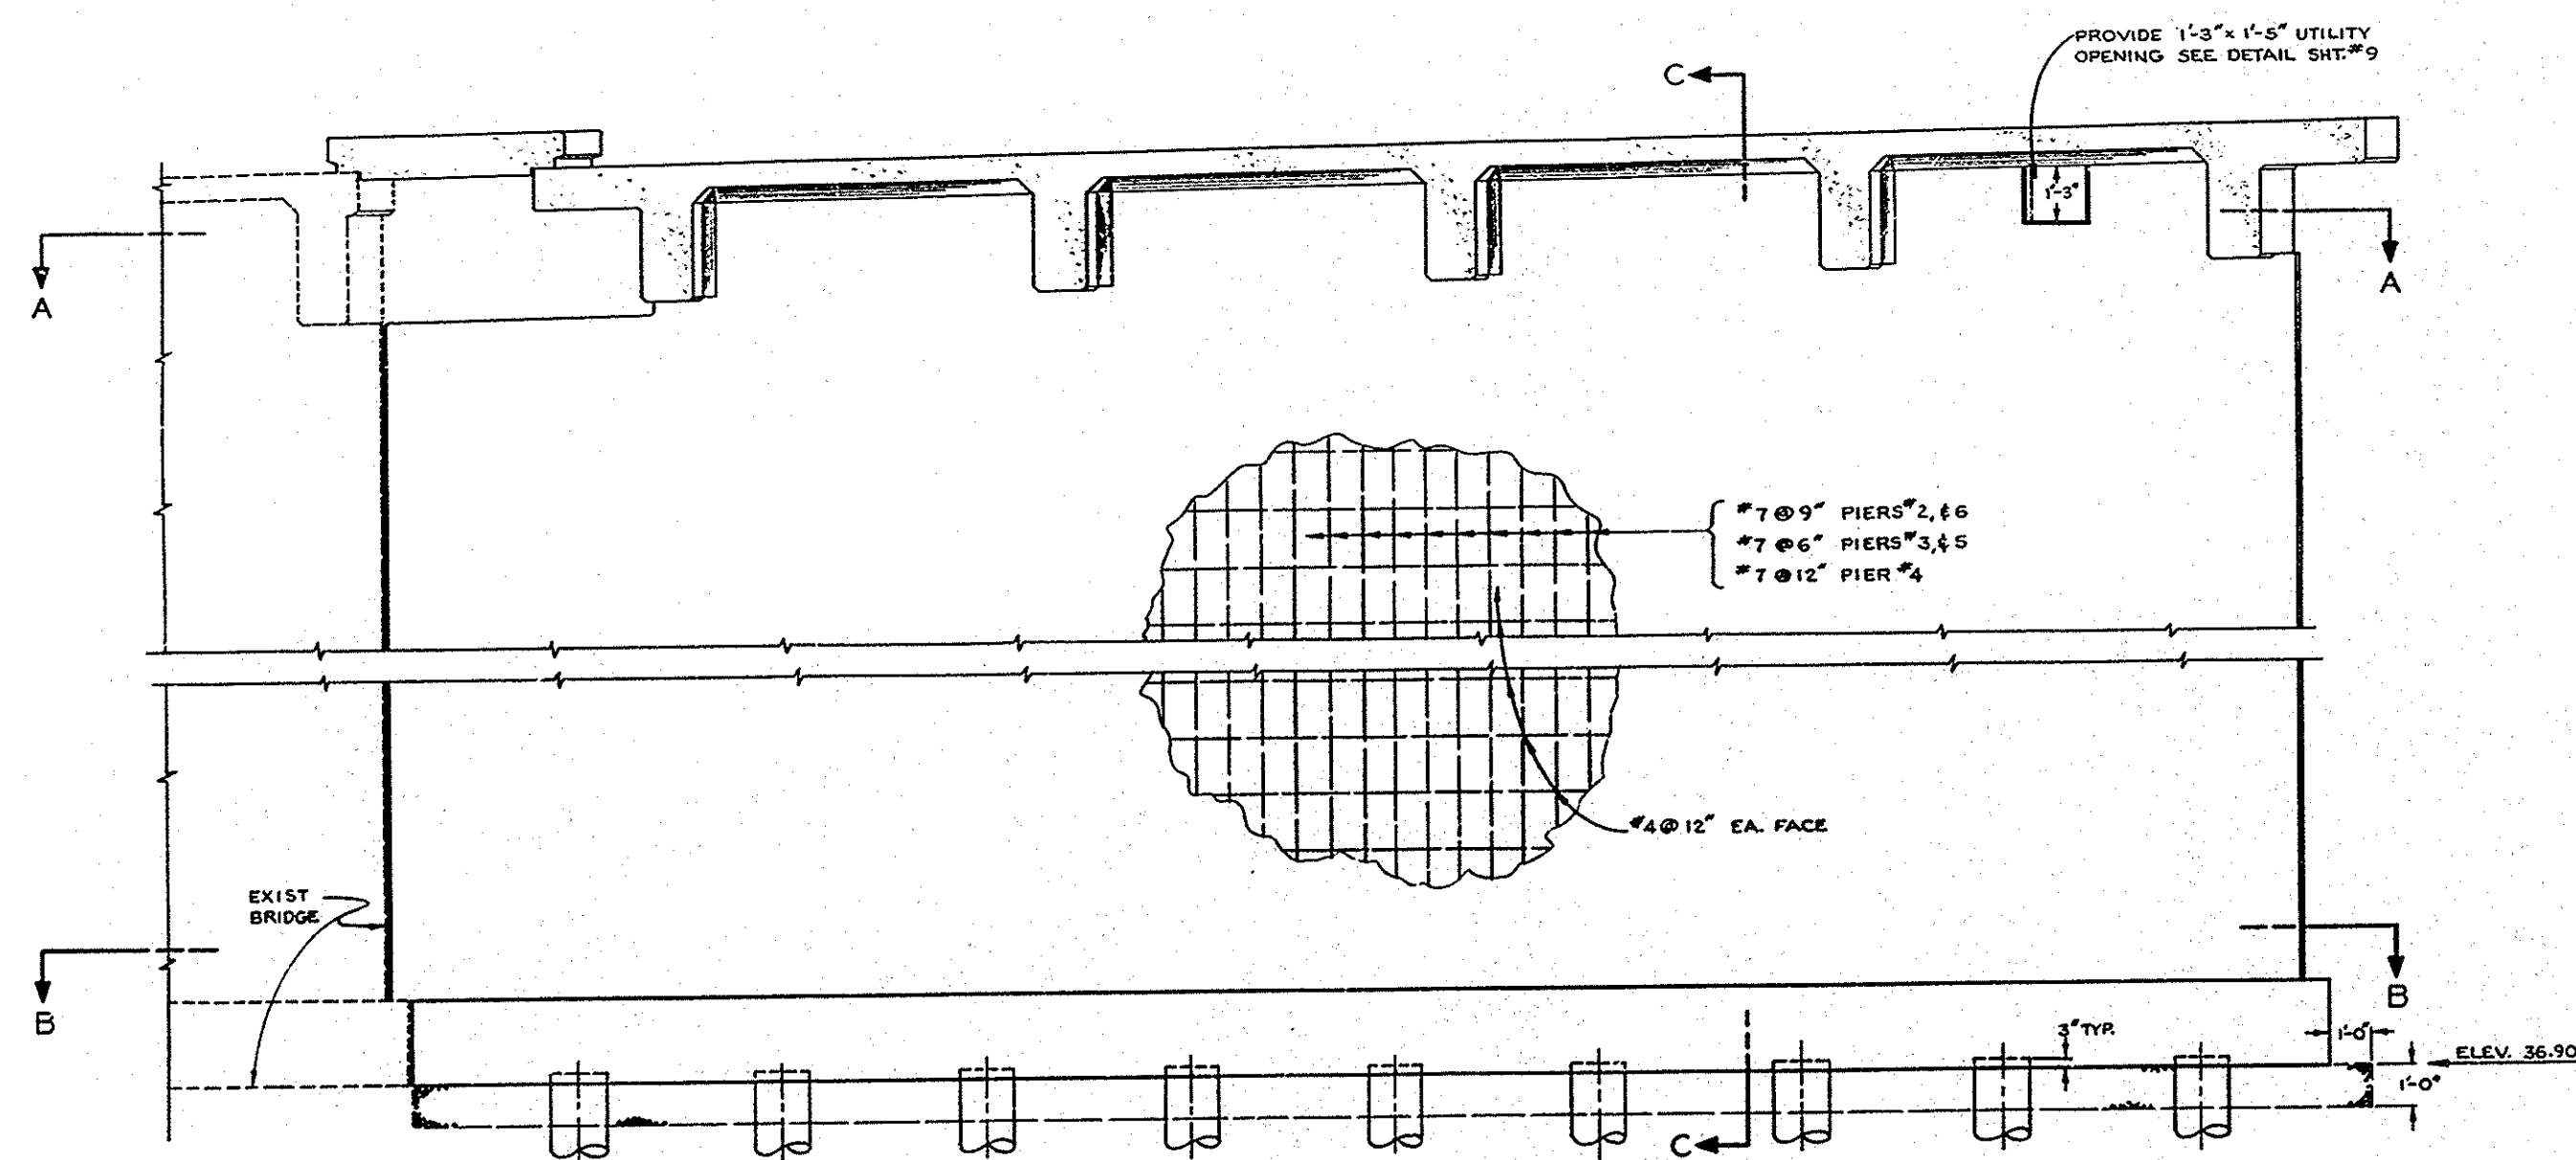

TYPICAL PIER DETAIL
(PIER #4 SHOWN)
SCALE — $\frac{3}{8}$ " = 1'-0"

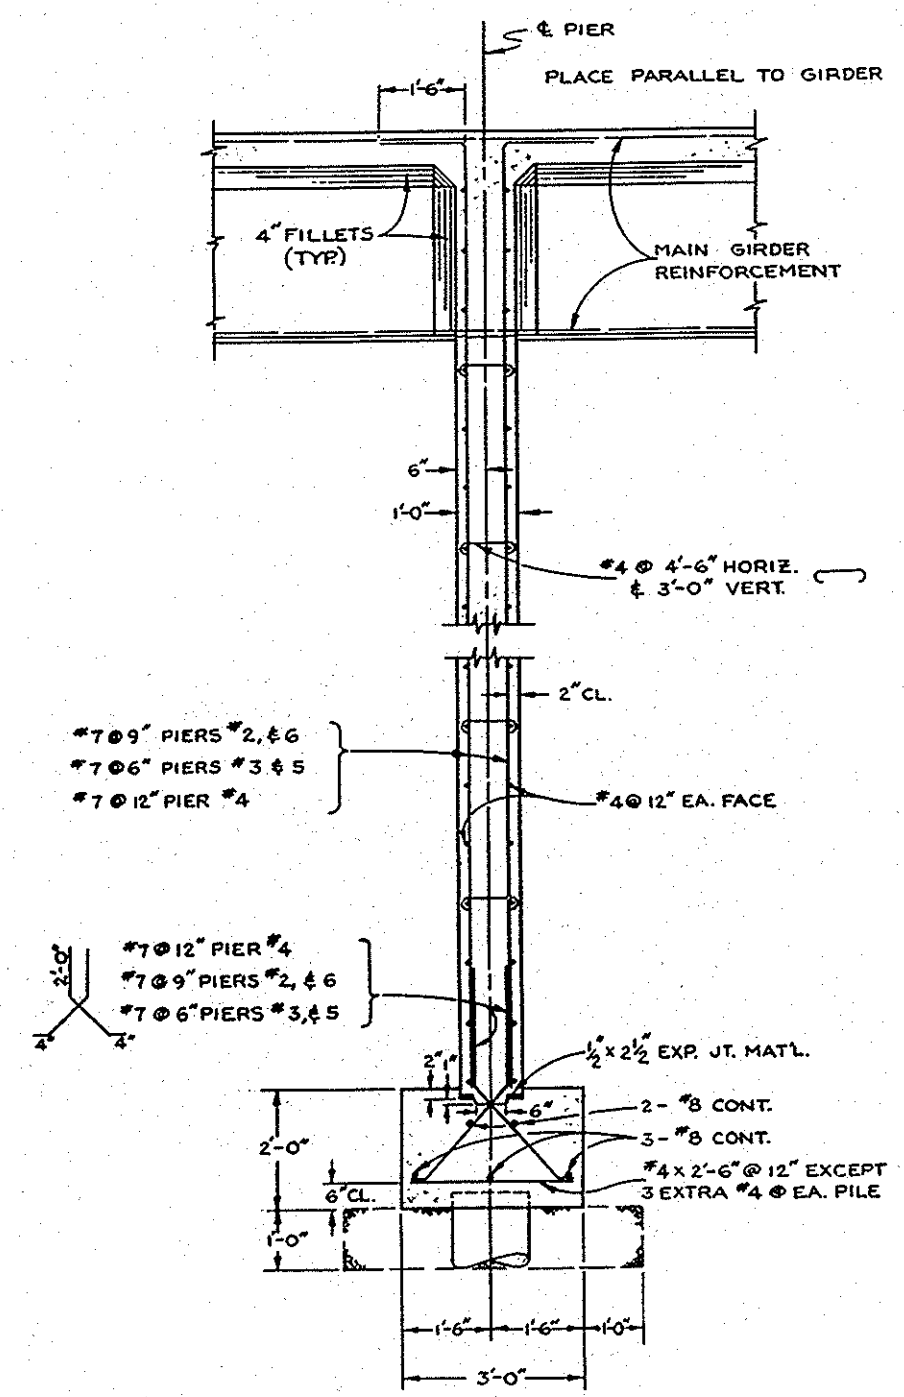

SECTION C-C
SCALE — $\frac{1}{2}$ " = 1'-0"

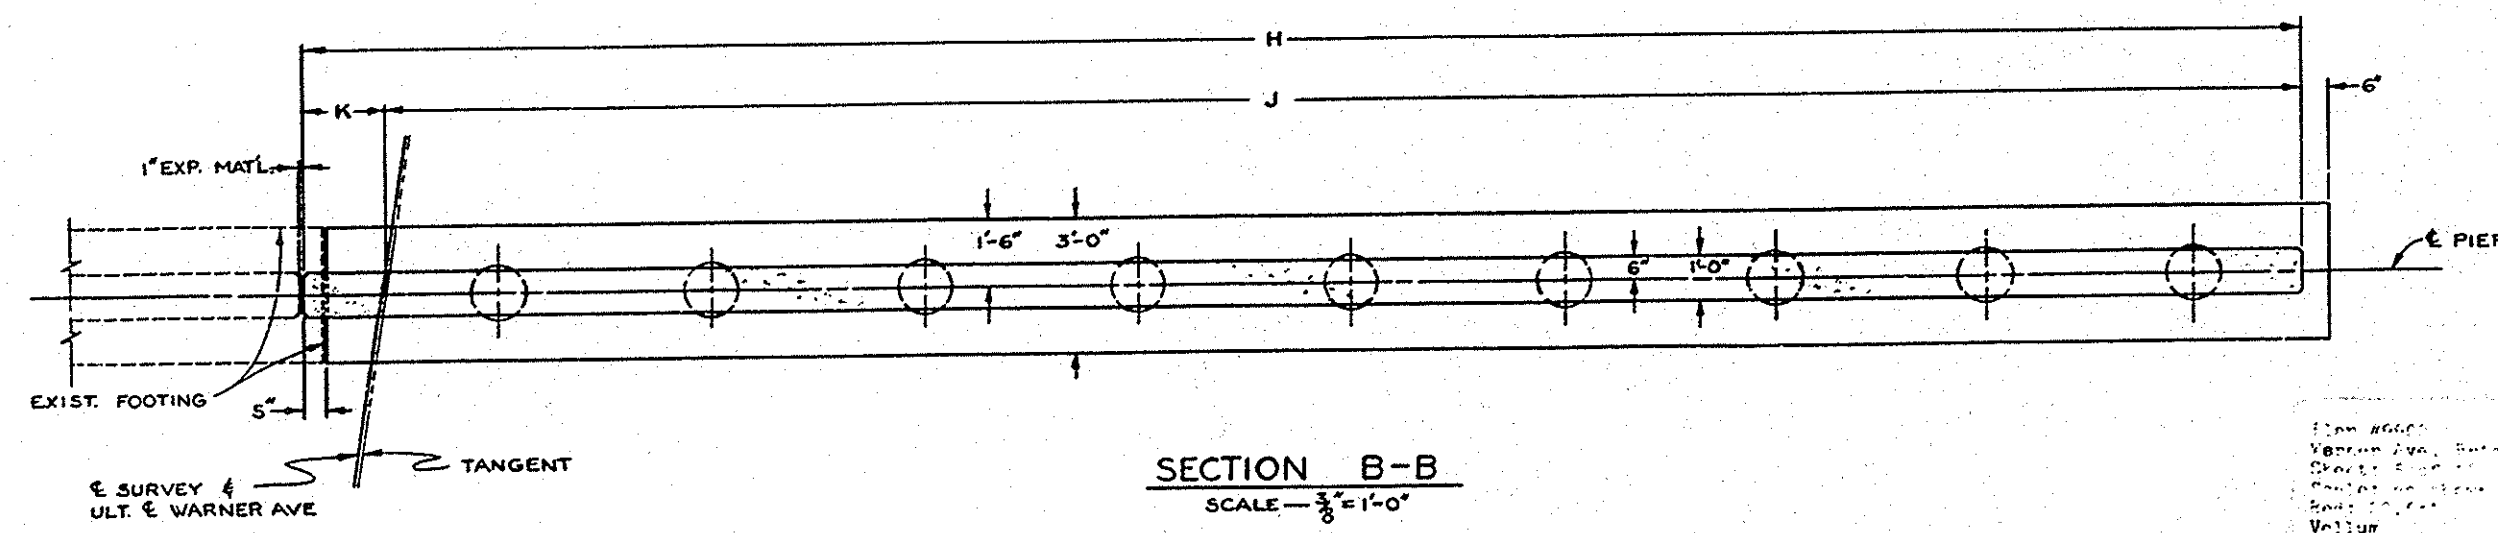

SECTION B-B
SCALE — $\frac{3}{8}$ " = 1'-0"

Drawn by: [illegible]
Checked by: [illegible]
Reviewed by: [illegible]
Date: [illegible]
Scale: [illegible]
Notes: [illegible]

WARNER AVE BRIDGE
WIDENING SA-30A
ACROSS
SANTA ANA RIVER
PIER DETAILS