
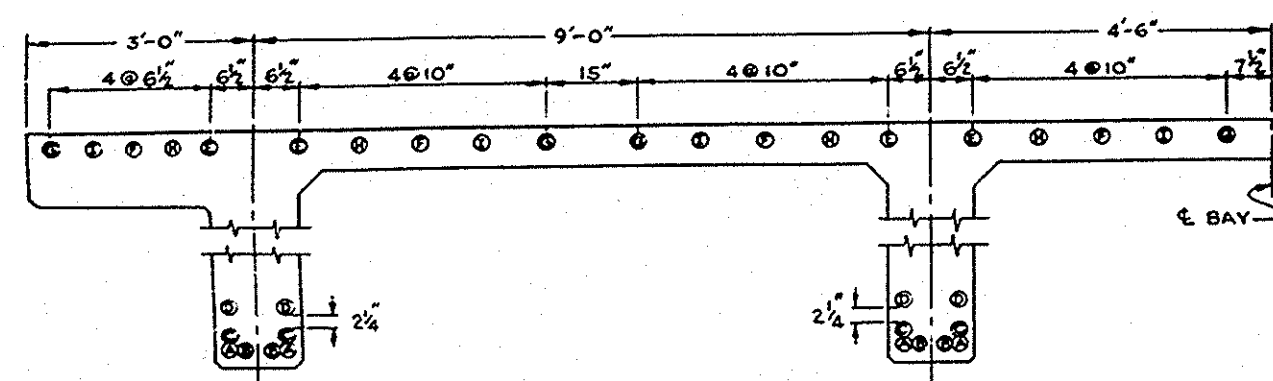
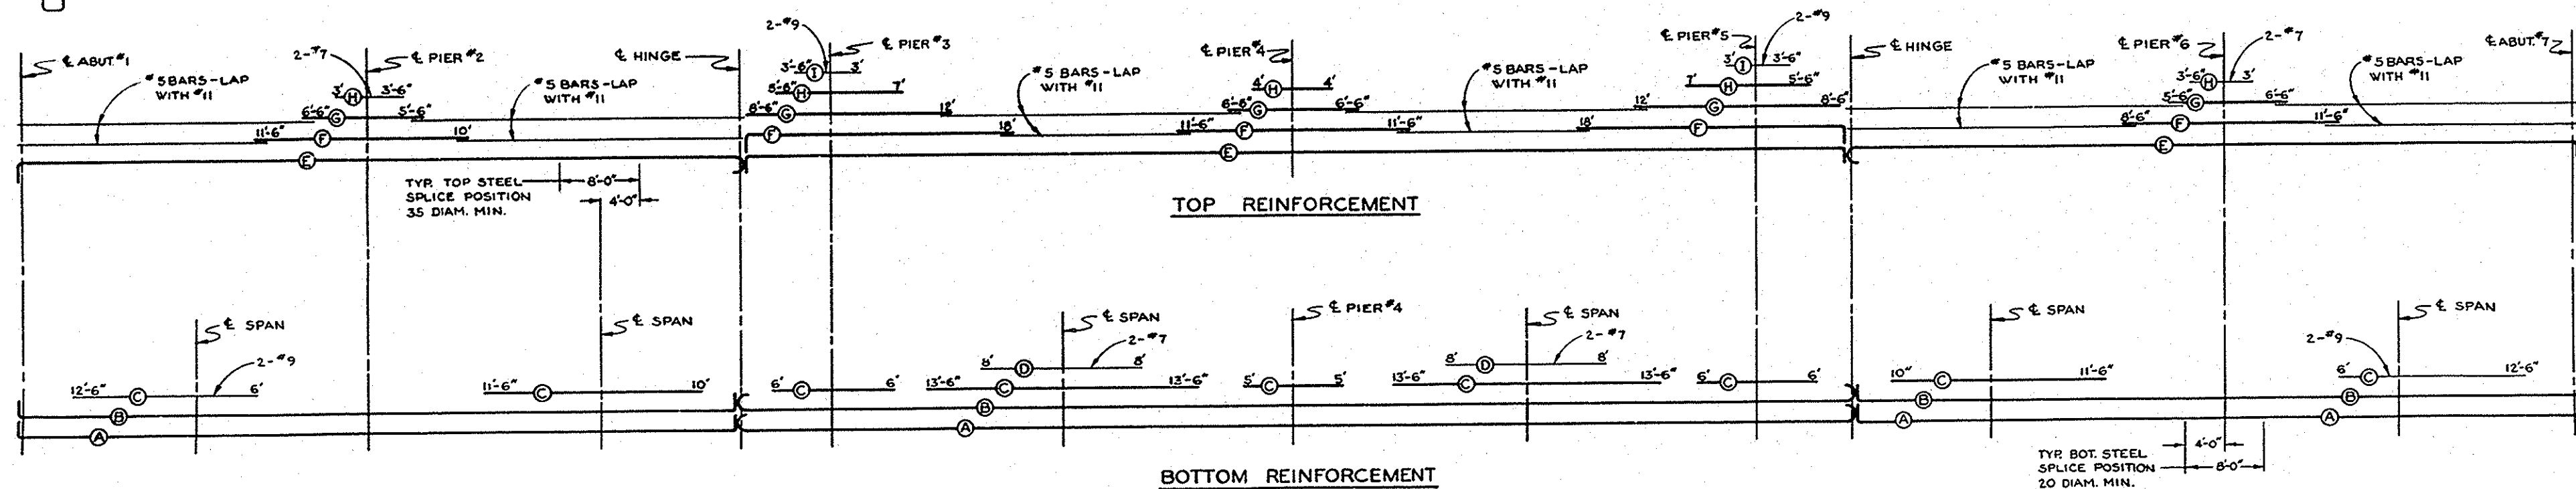
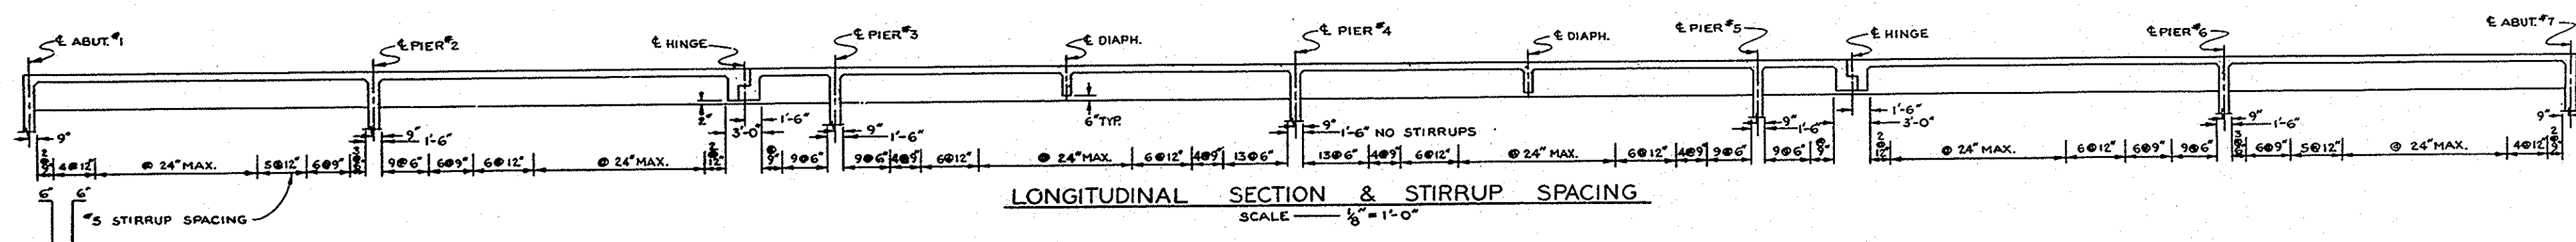


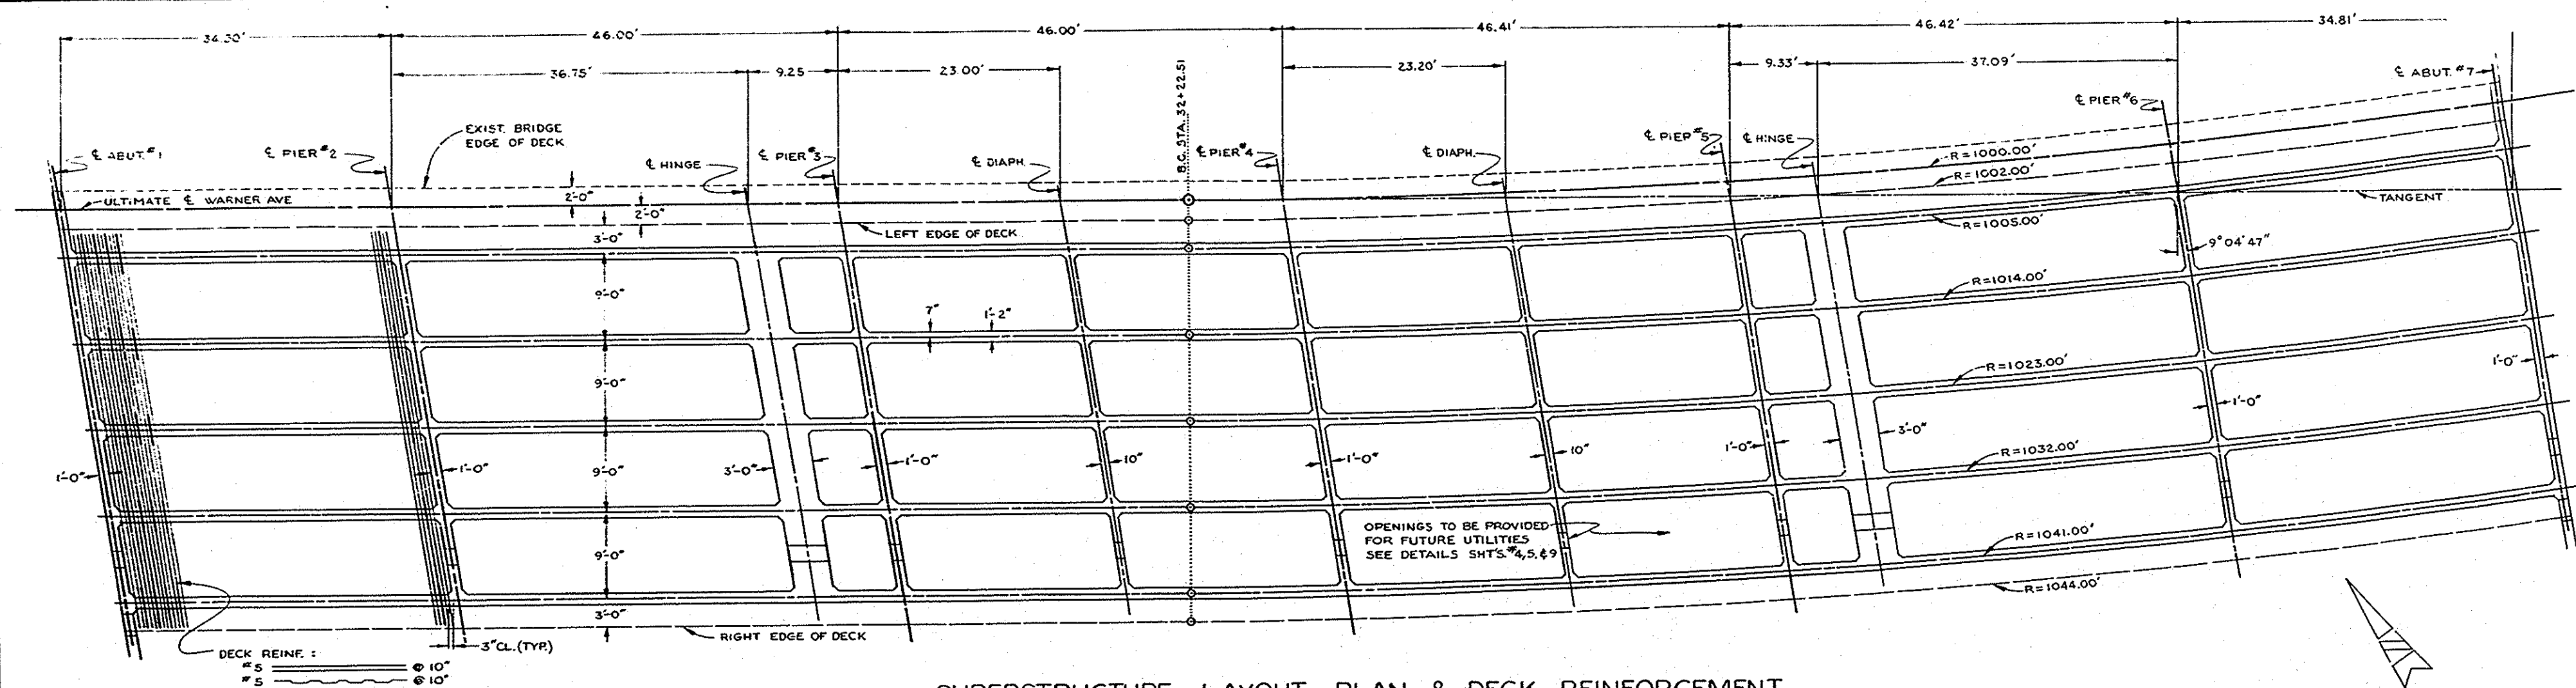

NOTE:
ALL STEEL #11 BARS EXCEPT AS NOTED.
TOP BARS DIM. FROM C & PIER.
BOTTOM BARS DIM. FROM C & SPAN.

File- 59602
Nashua Ave., Bridge
Sheet: 4 of 12
Scale: as shown.
Date: 12.6.63
Vol: 137

WARNER AVE BRIDGE
WIDENING SA-30A
ACROSS
SANTA ANA RIVER
SUPERSTRUCTURE LAYOUT
& REINFORCEMENT

NOTED	6 12
-------	------