



THESE PLANS WERE PREPARED UNDER THE SUPERVISION OF:

McLEAN & SCHULTZ
REGISTERED CIVIL ENGINEER (State)
2000 EAST CHAPMAN AVE.
FULLERTON, CALIFORNIA 92631

PROFESSIONAL ENGINEER
JOHN R. ARIAS
No. 21498
Exp. 9/30/93
CIVIL
DATE OF

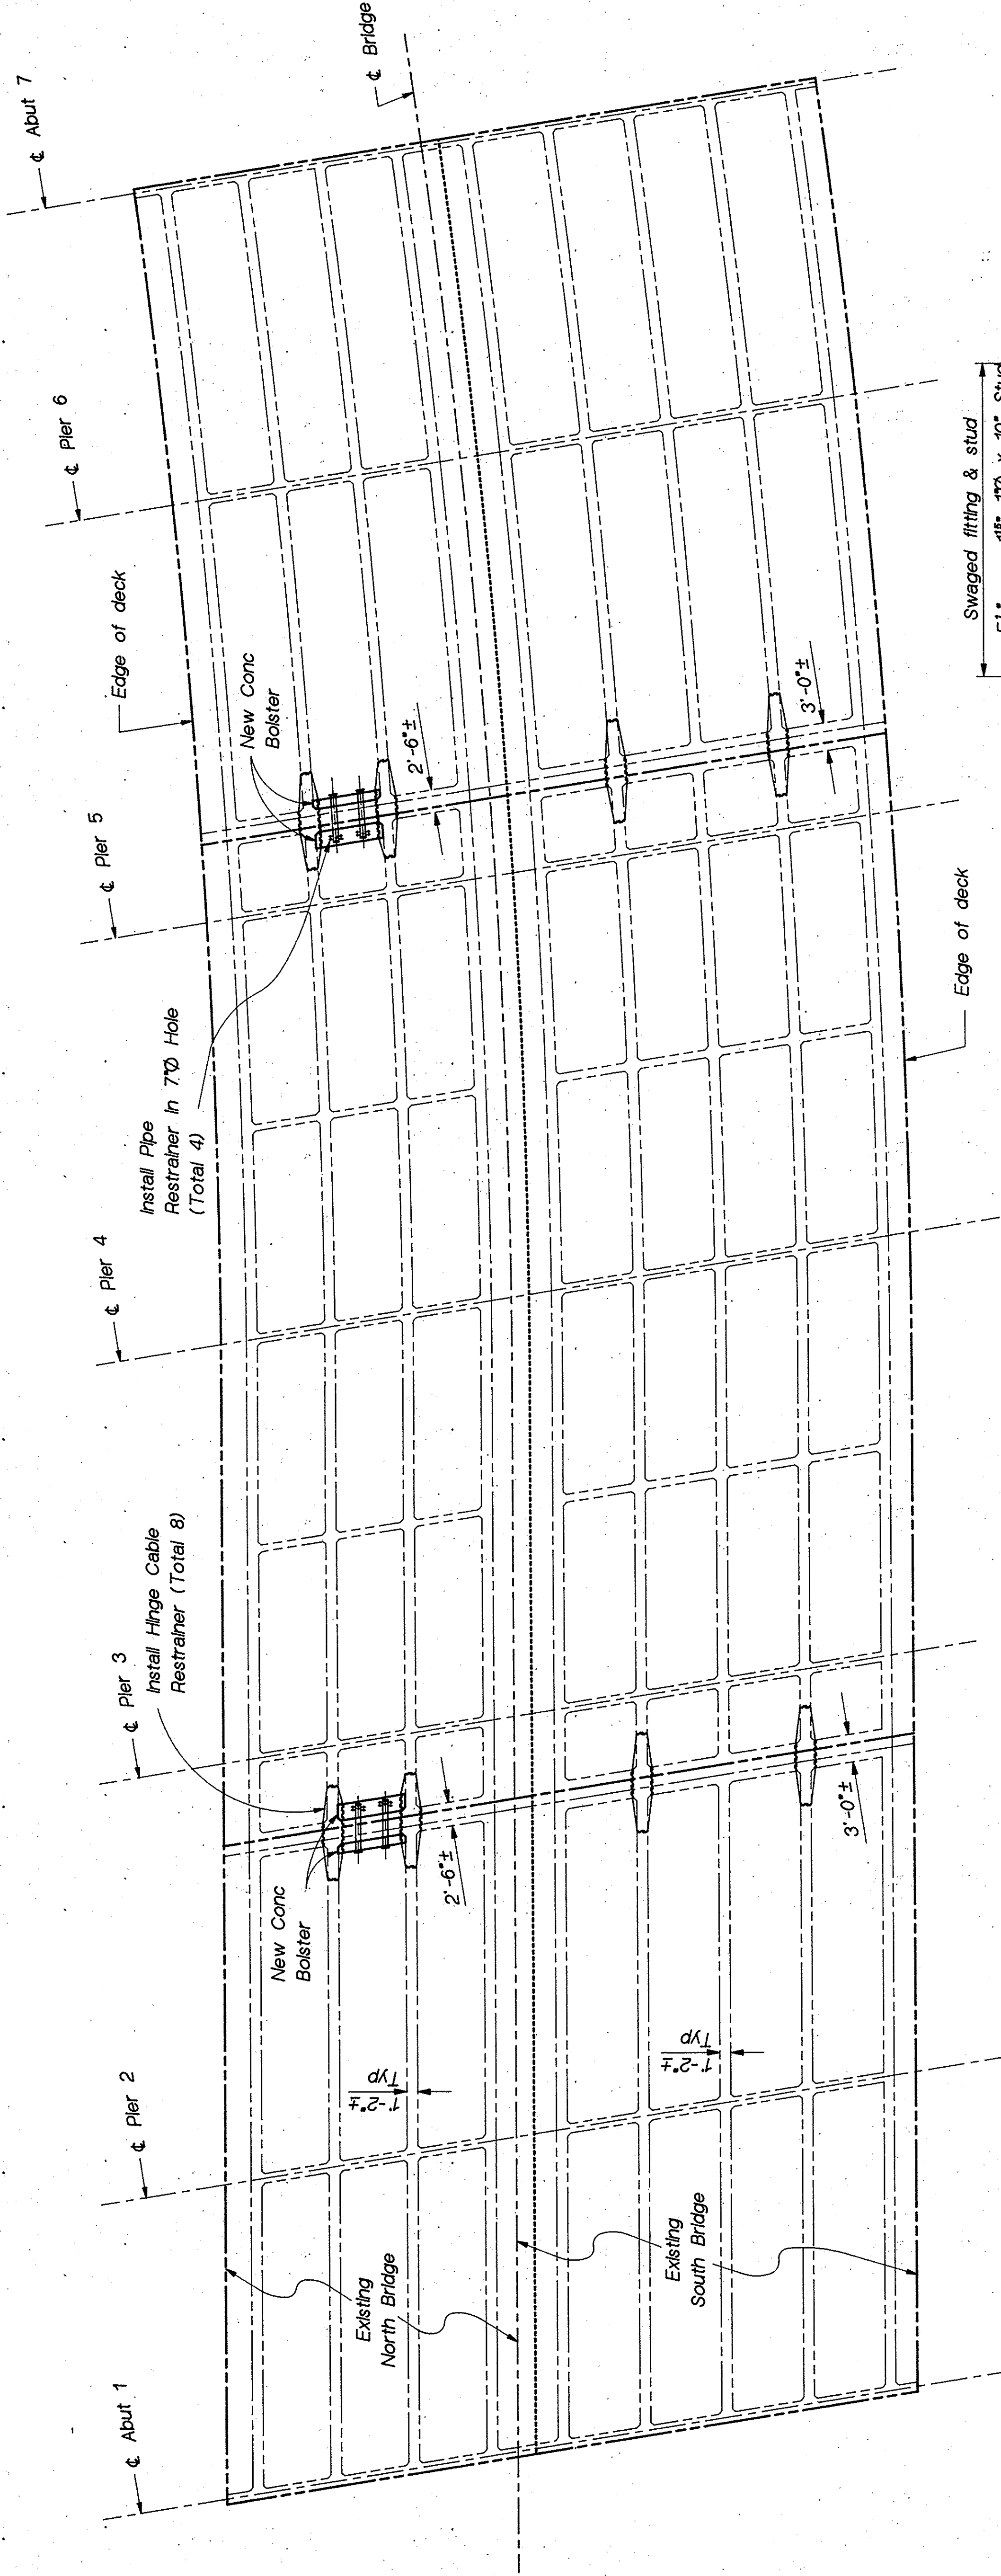


GIRDER PLAN
SCALE: 1" = 10'-0"

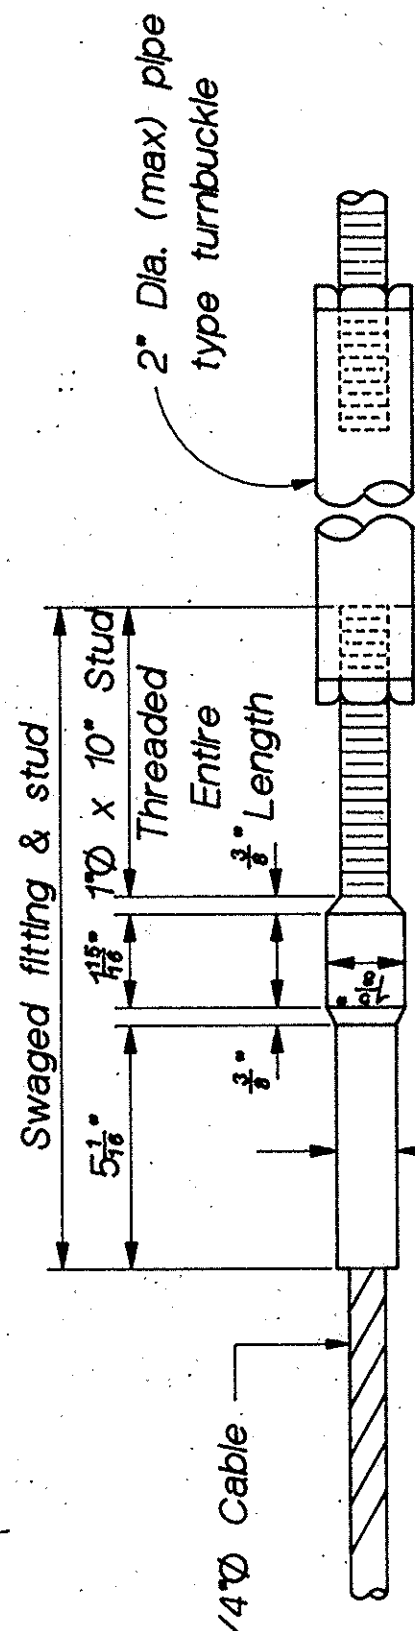

Ambient Temperature (°F)	No. Of Turns*
50°	0
80°	1
110°	2

* Interpolate no. of turns for intermediate temperatures.


TURNBUCKLE DETAIL
SCALE: 3" = 1'-0"

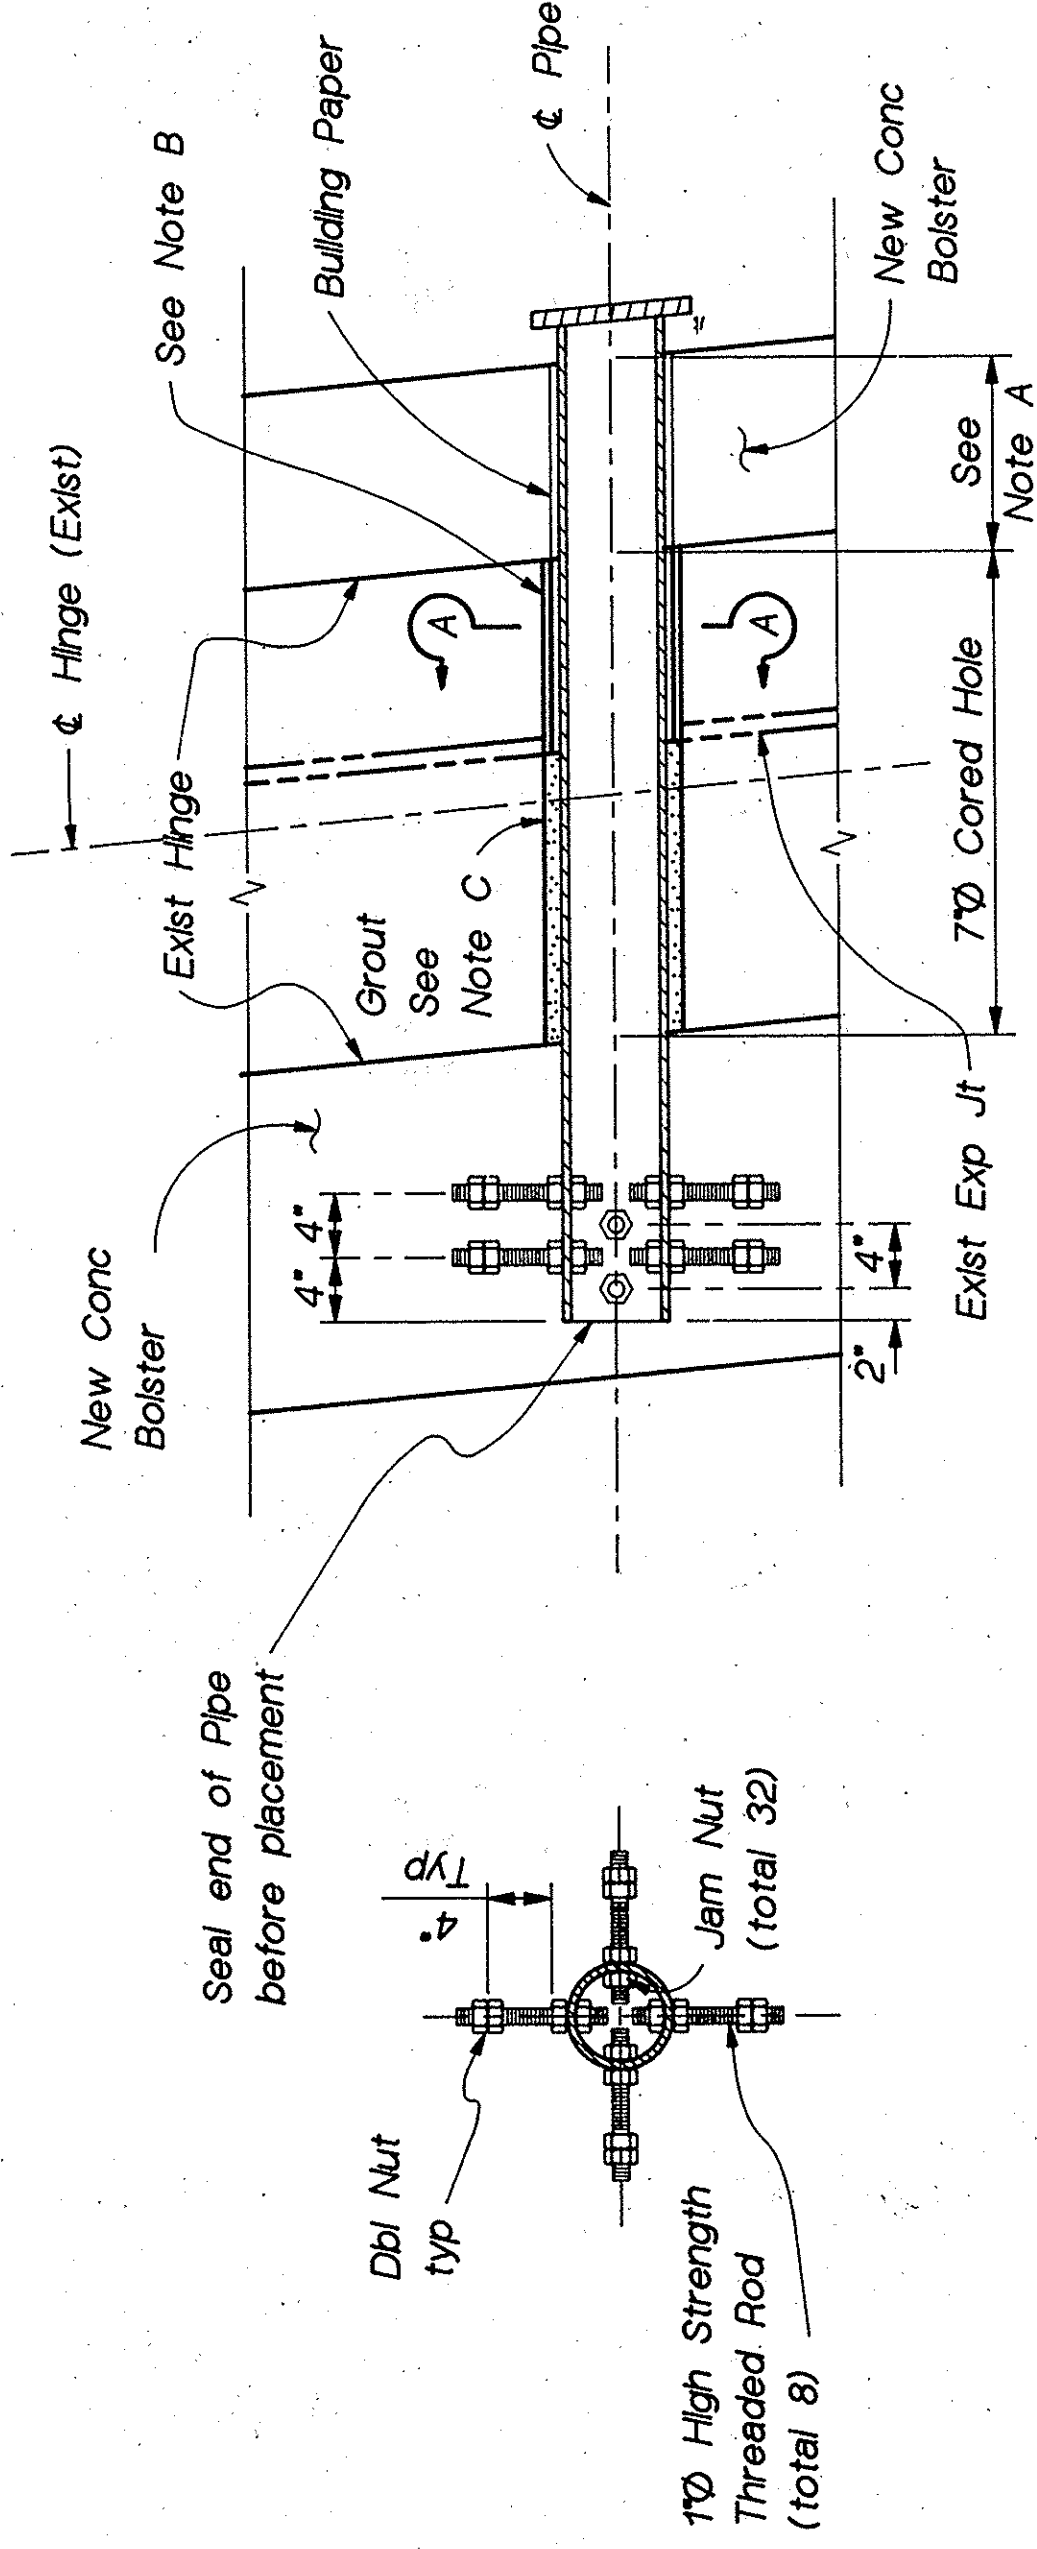


PIPE RESTRAINER DETAIL - PLAN
SCALE: 1" = 1'-0"

Notes:


- Tightly wrap pipe with two layers of 15 LB Building Paper.
- Temporary Filler Material (to be removed after grouting)
- Pipe unit to be placed against top of hole and grouted on "cantilever span" side only

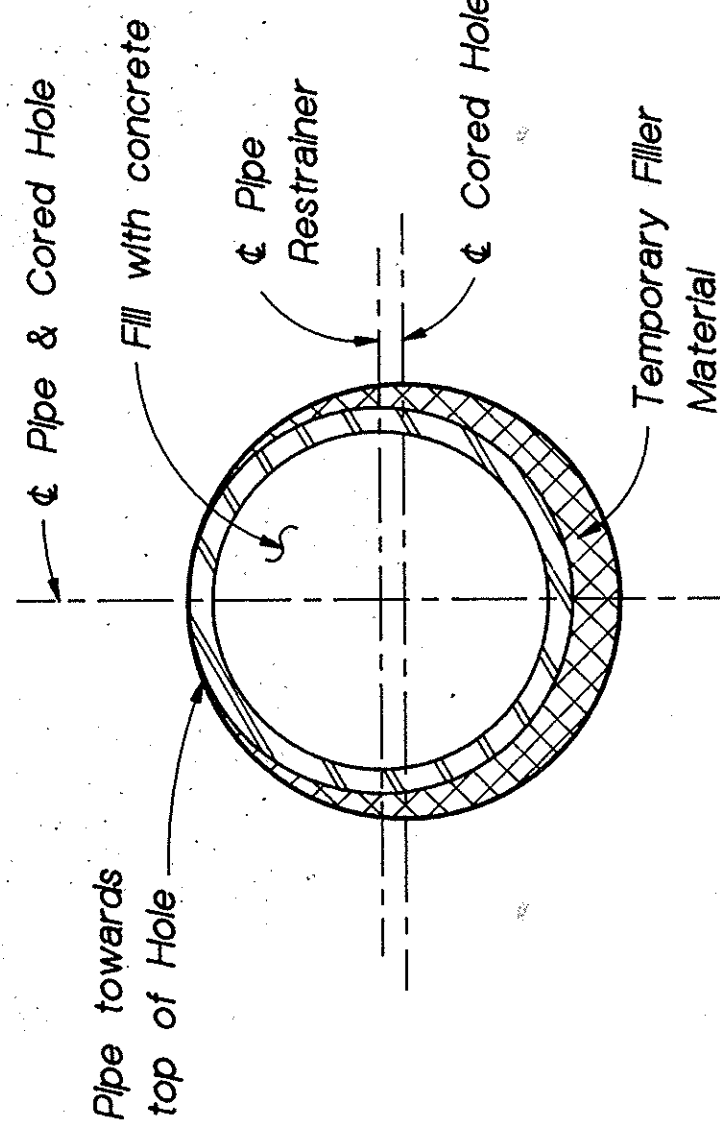


SECTION A-A
NO SCALE

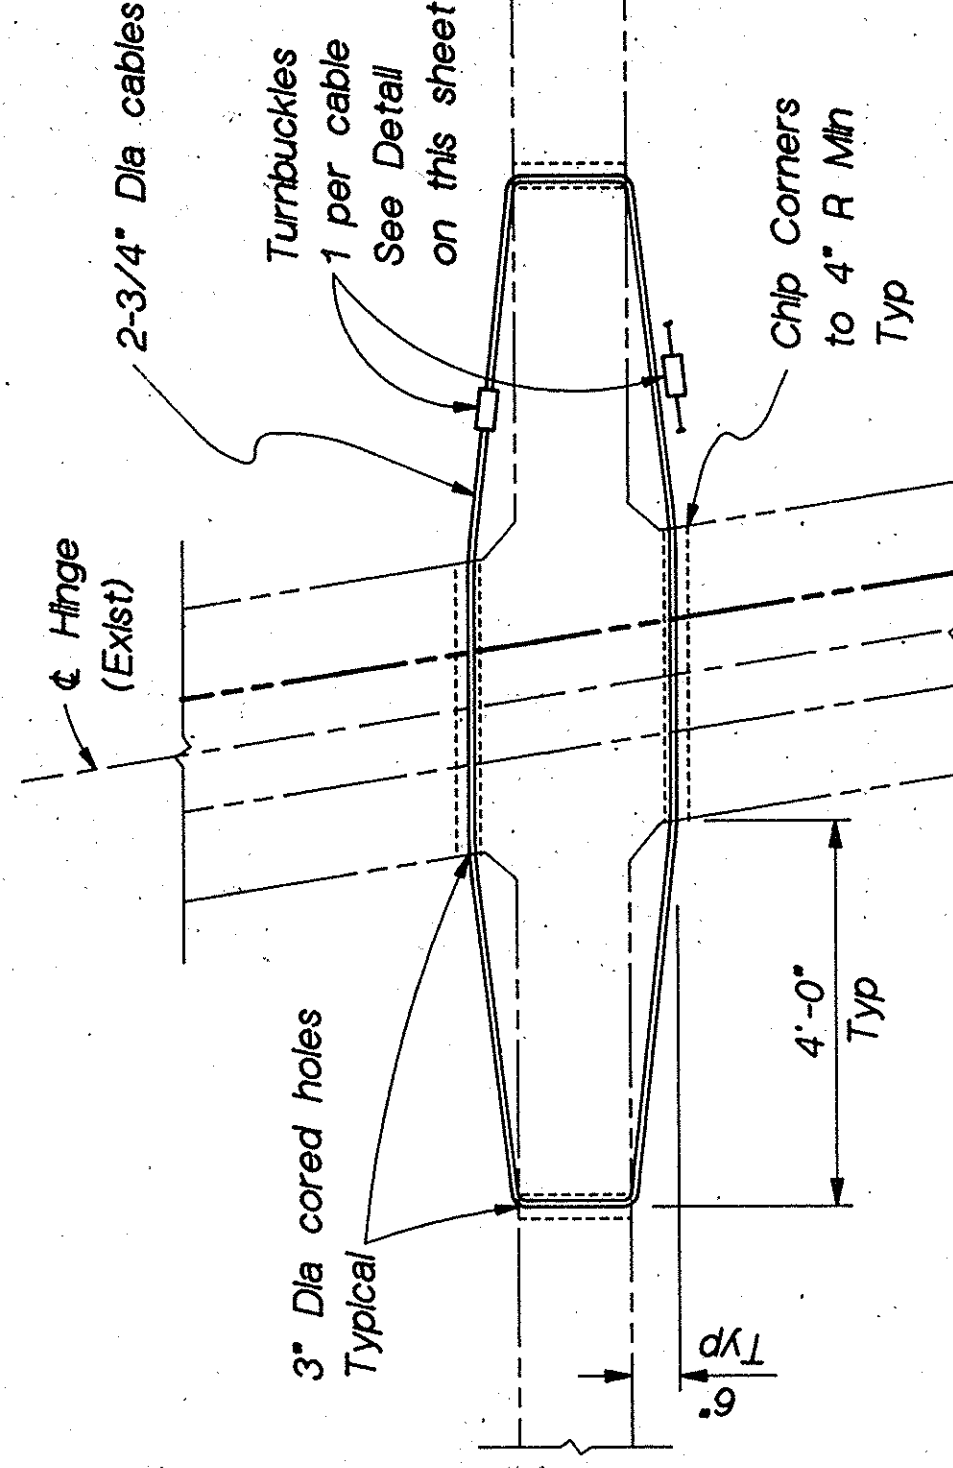

CABLE RESTRAINER - PLAN
SCALE: 1/2" = 1'-0"

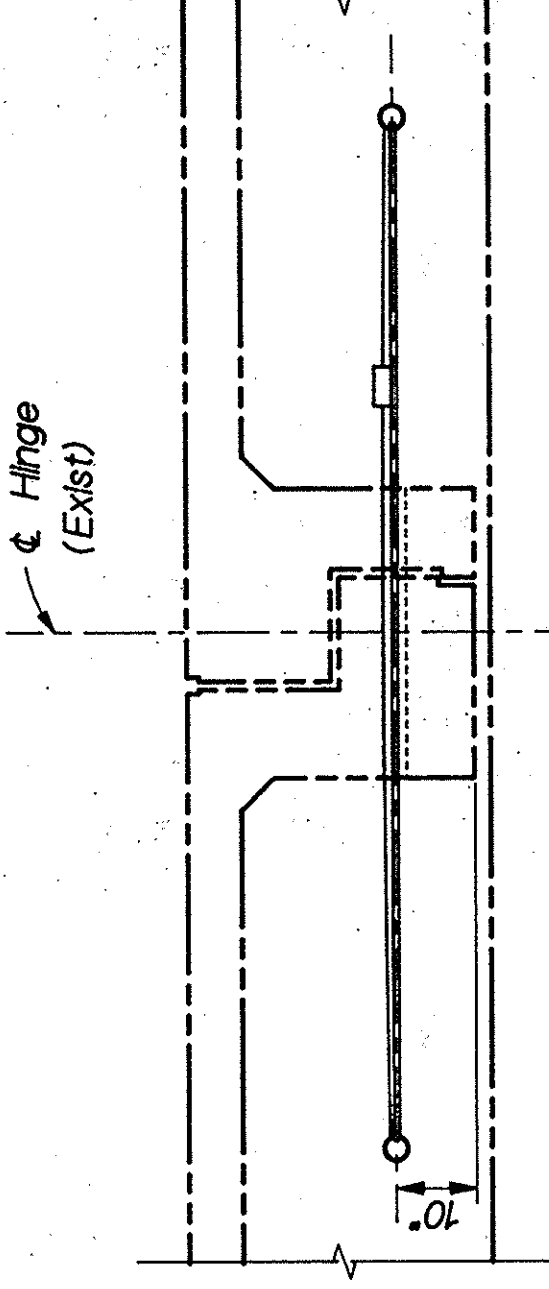

CABLE RESTRAINER - ELEV
SCALE: 1/2" = 1'-0"

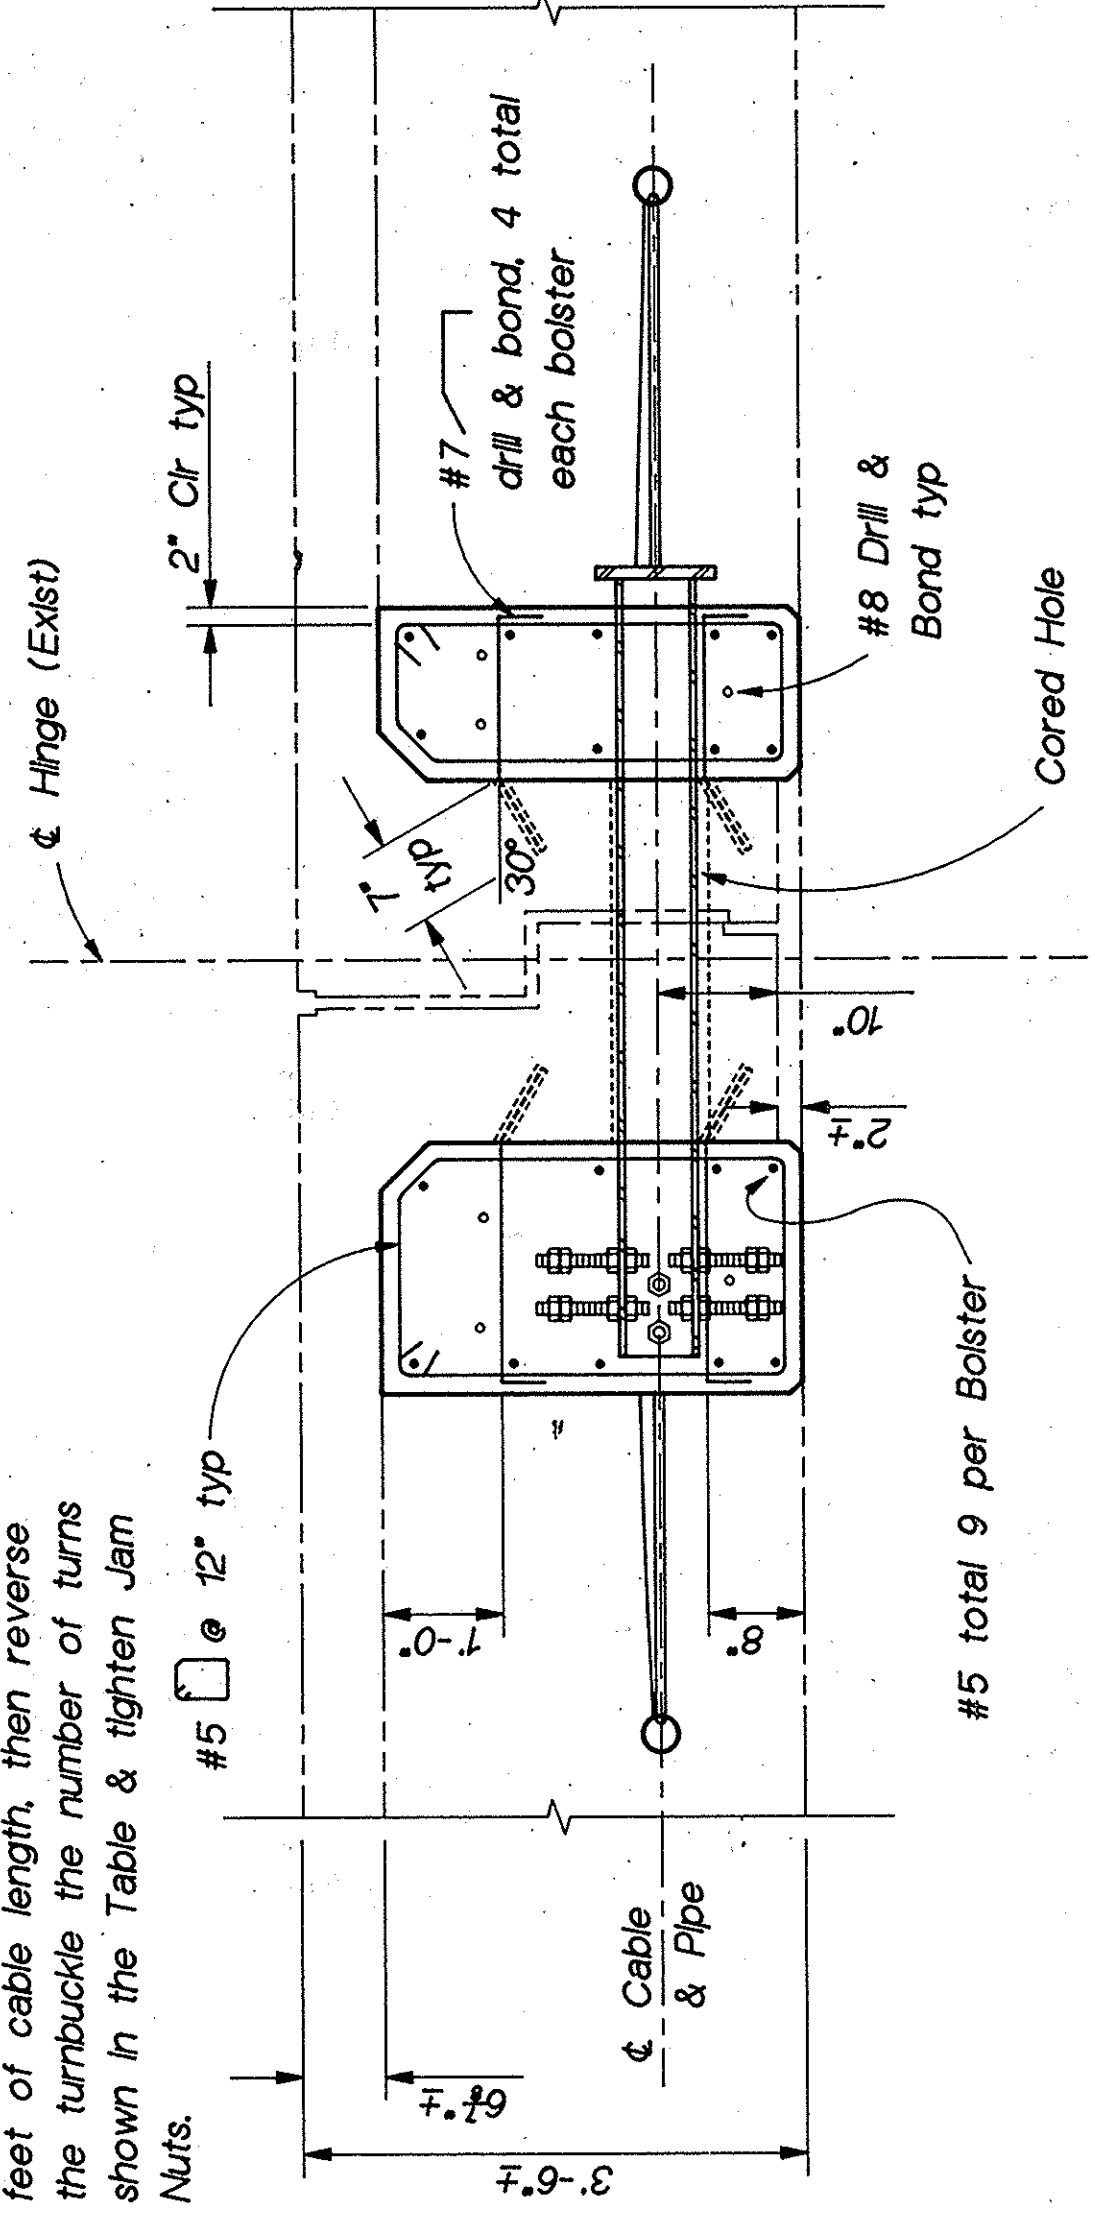

SECTION THRU BOLSTER
SCALE: 3/4" = 1'-0"

SYMBOL	DESCRIPTIONS	DATE	APPROVAL
REVISIONS			
U.S. ARMY ENGINEER DISTRICT LOS ANGELES CORPS OF ENGINEERS			
DESIGNED BY: V. BROWN DRAWN BY: N. TAAL CHECKED BY: K. MIYA			
2000 EAST CHAPMAN AVE. FULLERTON, CALIFORNIA 92631			
SANTA ANA RIVER WATERSHED INCLUDING SANTIAGO CREEK, CALIFORNIA LOWER SANTA ANA RIVER CHANNEL (SAN DIEGO FREEWAY TO RIVER VIEW GOLF COURSE) WARNER AVENUE BRIDGE			
HINGE DETAILS			
SUBMITTED BY:		DATE:	SPEC. NO. DACW09-
APPROVED:			DISTRICT FILE NO.
SHEET		R-15	OF
R-16		SHEETS	

Computer
Aided
Design
Drafting
STANDARD

PIPE RESTRAINER - PLAN
SCALE: 1/2" = 1'-0"