
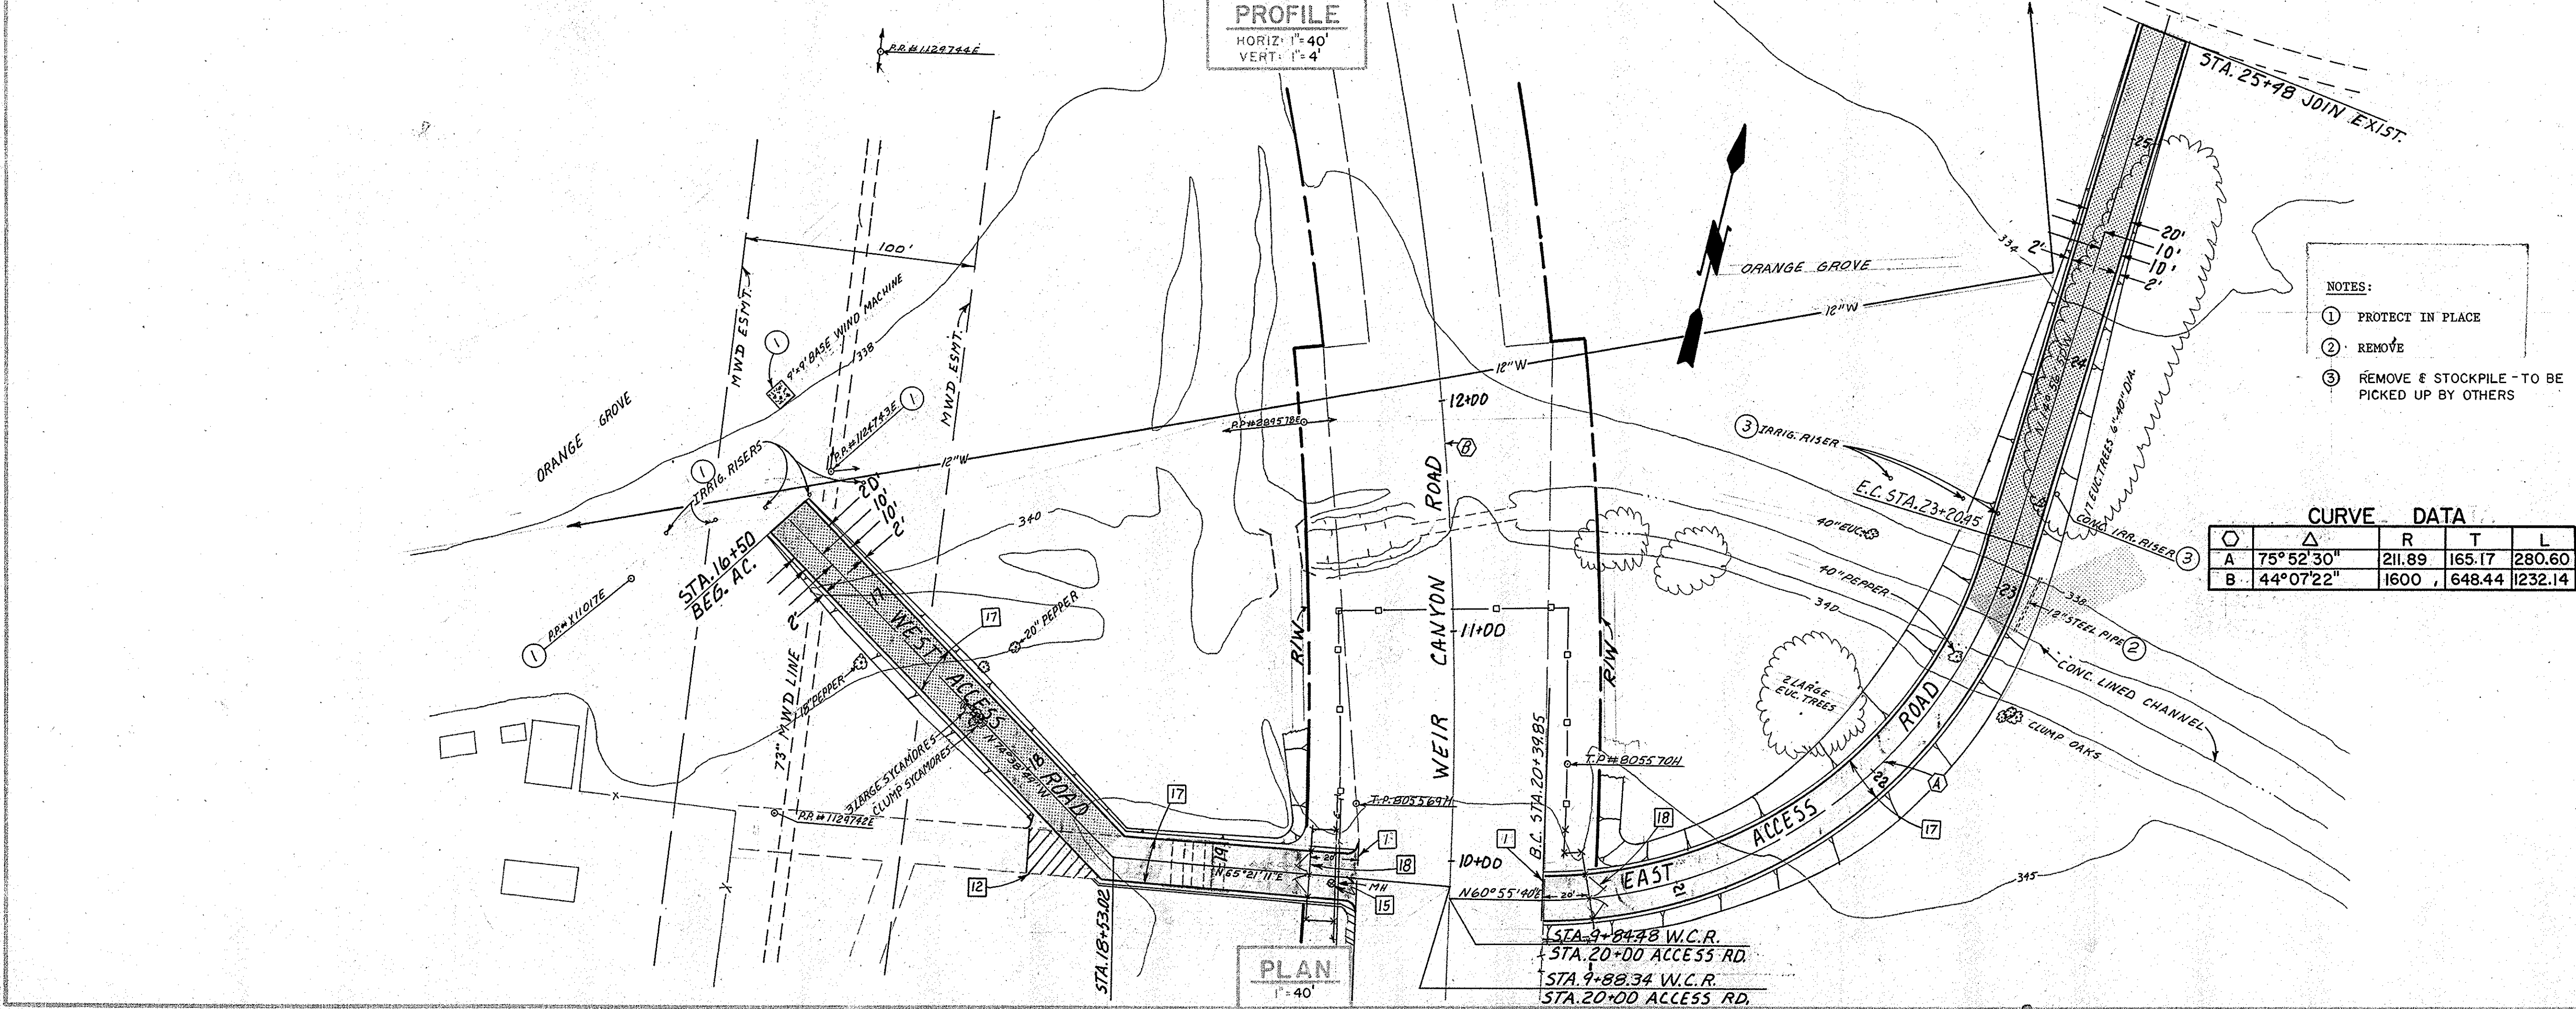


CONSTRUCTION NOTES

- 17 CONSTRUCT 2" A.C. OVER COMPACTED FILL.
- 12 CONSTRUCT A.C. OVERLAY.
- 15 ADJUST MANHOLE TO GRADE
- 7 REMOVE EXISTING A.C. AND A.B.
- 18 INSTALL 2-10' C.L. DOUBLE FRAME GATES PER OCMA STD. PLAN 412
- 1 JOIN EXISTING PAVEMENT AND FEATHER TO THE SATISFACTION OF THE ENGINEER

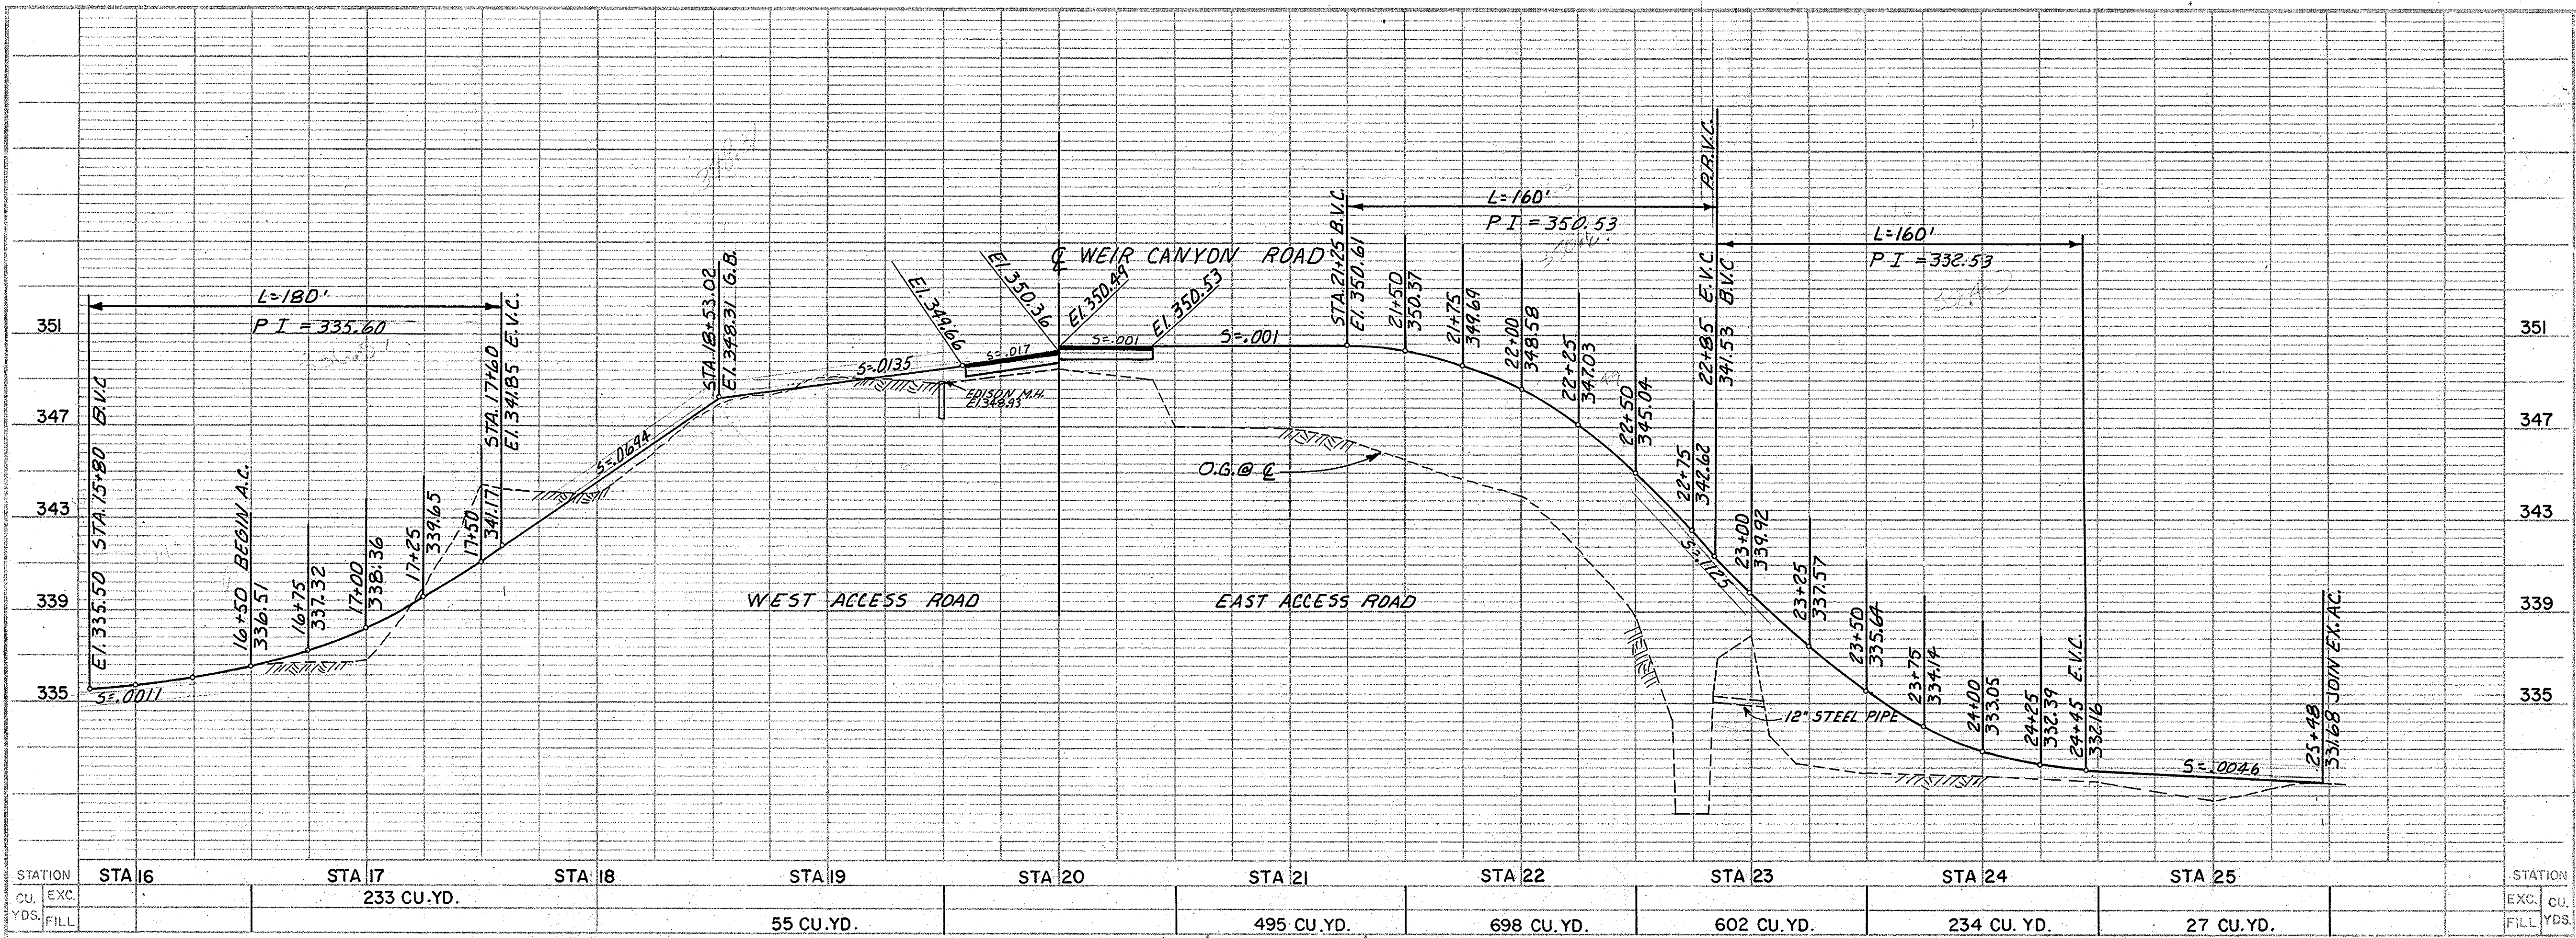

- NOTES:
- 1 PROTECT IN PLACE
 - 2 REMOVE
 - 3 REMOVE & STOCKPILE - TO BE PICKED UP BY OTHERS

1 1/2 0 2
3 inches on original drawing

ORANGE COUNTY
ENVIRONMENTAL MANAGEMENT AGENCY

WEIR CANYON ROAD
TEMP. ACCESS ROADS
PLAN & PROFILE

DATE	DESCRIPTION	PREPARED UNDER SUPERVISION OF	DATE	SHEET
DESIGNED	L.A.	SCALE	DATE	OWE NO.
DRAWN	CE, D.W.	CHECKED	AS SHOWN	AUG. '82

Robert Young

R3