



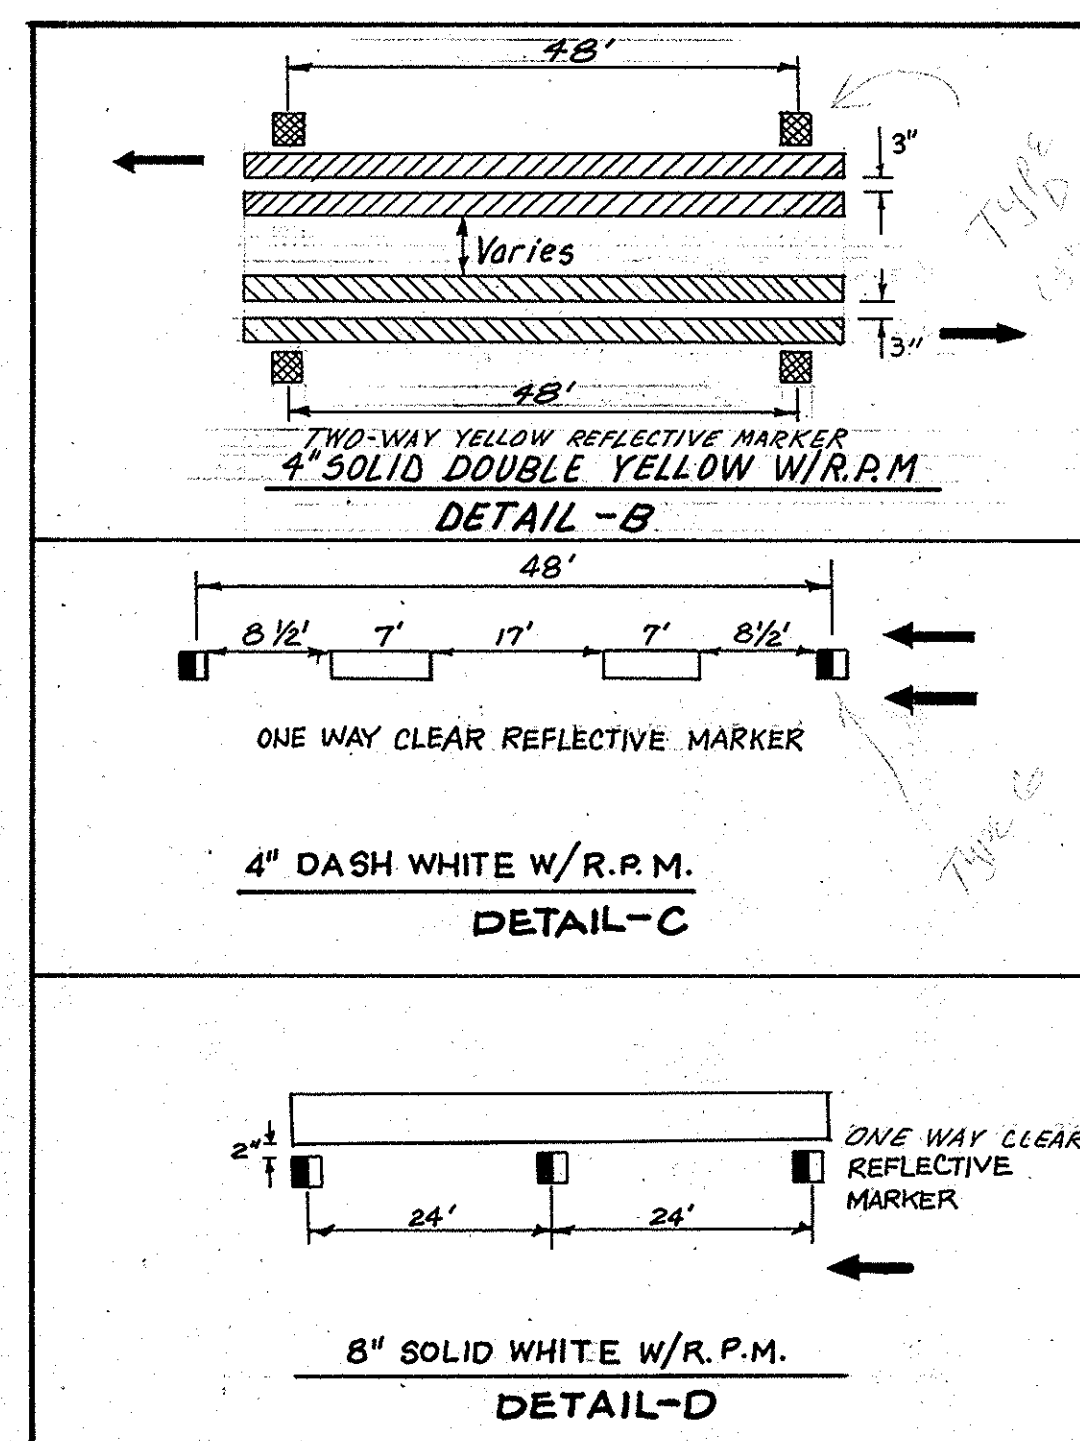

13 Install (2) timber barricades per O.C.E.M.A. Std. Plan 404.

14 Install metal beam guard rail per O.C.E.M.A. Std. Plan 403.

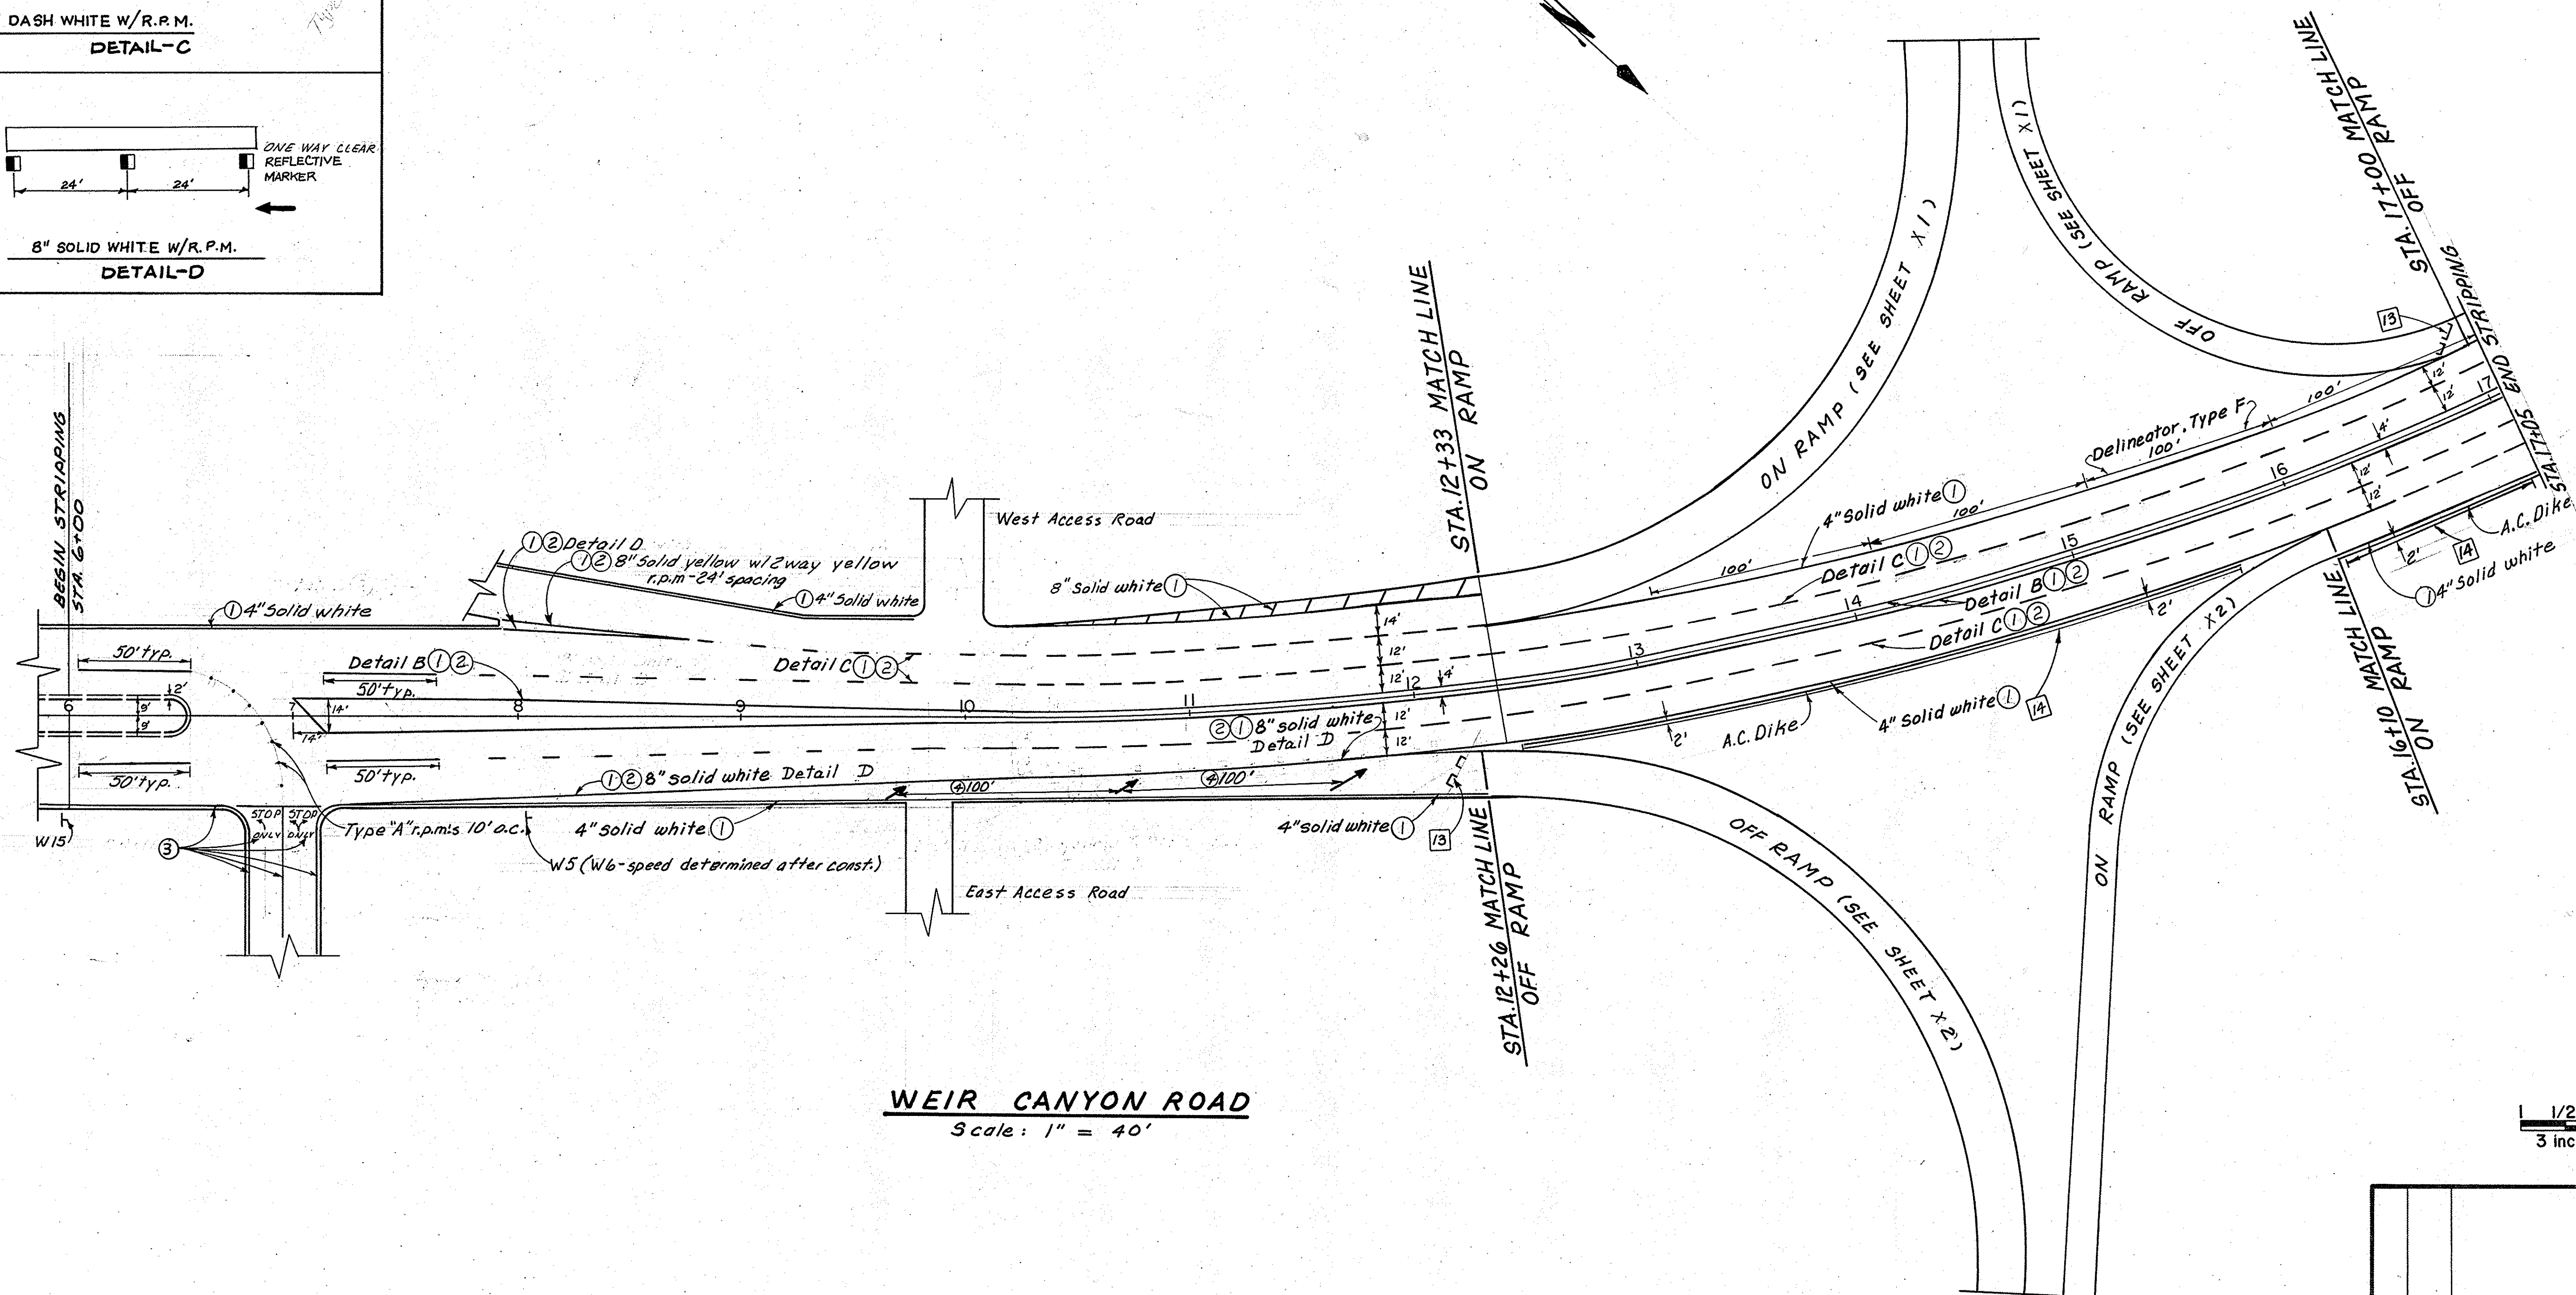

WEIR CANYON ROAD
Scale: 1" = 40'



			ORANGE COUNTY ENVIRONMENTAL MANAGEMENT AGENCY	
			<u>WEIR</u> <u>CANYON</u> <u>ROAD</u> SIGNING & STRIPING	
MARK	DATE	DESCRIPTION	PREPARED UNDER SUPERVISION OF	SHEET
REVISIONS DESIGNED <u>L. A.</u> DRAWN <u>R.W.</u> CHECKED _____			<i>Robert Young</i> DATE _____	R4
			SCALE _____ DATE _____ AS SHOWN AUG. '82	