


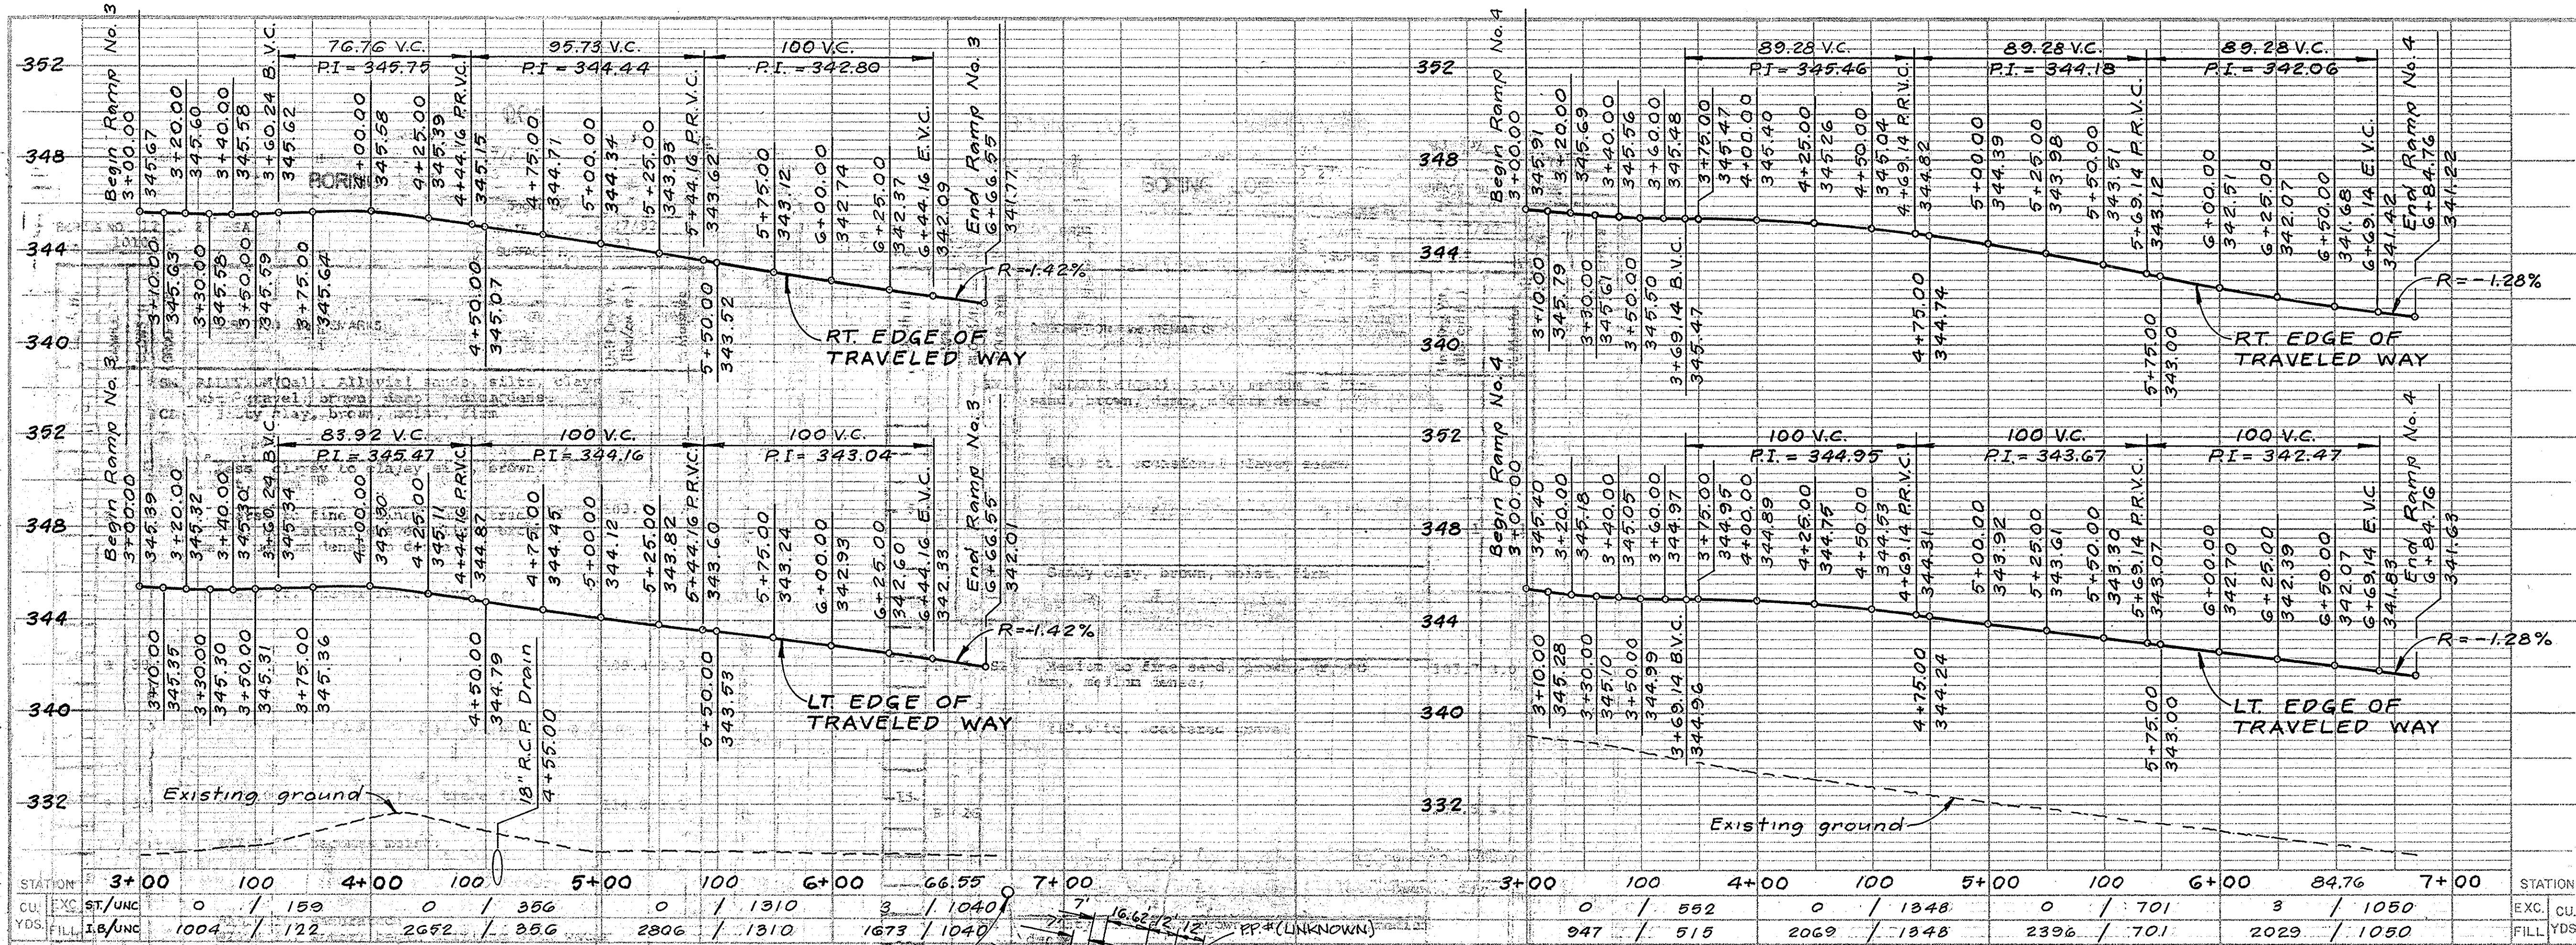

- ### CONSTRUCTION NOTES
- Construct Type "A-2" curb per O.C.E.M.A. Std. Plan # 201.
 - Slope curbs and 4' shoulder to match cross slope of traveled way. Apply phenemine prior to placement of 4' wide shoulder and curb.
 - Construct 3" A.C. with seal coat over 5" A.B. (Ramp No. 3) and 7" A.B. (Ramp No. 4). (These thicknesses are estimated and subject to change pending results of soil tests of in-place roadway embankments).
 - Construct 18" (min.) V-ditch per typical section on sht. X-1.
 - Construct 3" thick air-placed concrete for slope protection. 6x6-1.4 x 1.4 welded wire fabric at mid-thickness throughout.
 - Construct down drain per O.C.E.M.A. Std. Plan # 321 and details on sht. X-1.
 - Construct 8" A.C. dike per O.C.E.M.A. Std. Plan # 201.
 - Construct 18" R.C.P. (Type 2000D) drain pipe with bedding per O.C.E.M.A. Std. Plan # 319. L = 91'±
 - Reinforced concrete sewer encasement along the Orange Co. Sanitation District's Interceptor Sewer, see sheets L1 thru L5 for encasement details.

- ### NOTES
- Protect in place.
 - To be relocated by others (S.C.E.).

BENCH MARK: EL. 345.709
 0.15 MI. N.W. ON WEIR CANYON RD. FROM THE RIVERSIDE FWY. TO A CONC. HDWL. ON THE WEST SIDE, 95' W. OF THE CENTERLINE OF WEIR CANYON RD., 114' S. OF THE S.A.V.I. CANAL, SET IN THE TOP OF THE CONC. HDWL. - O.C.S. 1976 ADJ. 3KK-20-71

1/2 0 1 2
 3 inches on original drawing

CURVE DATA

RAMP No. 3	RAMP No. 2
LEFT EDGE OF TRAVELED WAY	LEFT EDGE OF TRAVELED WAY
$\Delta = 67^{\circ}49'55''$	$\Delta = 98^{\circ}25'01''$
$R = 164'$	$R = 224'$
$T = 110.27'$	$T = 259.52'$
$L = 194.16'$	$L = 384.76'$

ORANGE COUNTY ENVIRONMENTAL MANAGEMENT AGENCY		SHEET	
WEIR CANYON ROAD		X-3	
EAST RAMPS		PLAN	
MARK DATE	DESCRIPTION	PREPARED UNDER SUPERVISION OF	DATE
DESIGNED	B.A.B.	SCALE	DATE
DRAWN	W.H.W.	CHECKED	J.W.P.
AS SHOWN		AUG. 82	

