

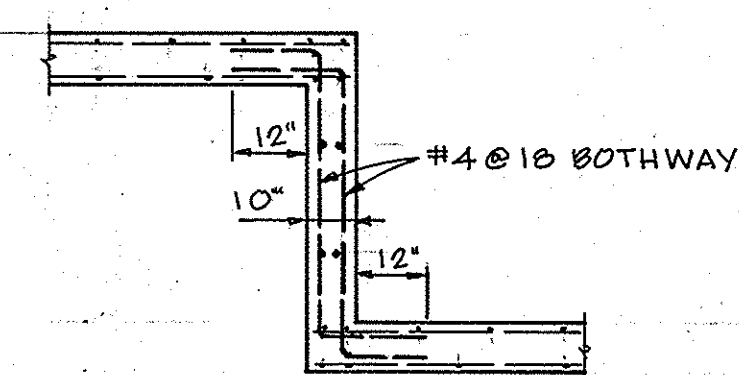
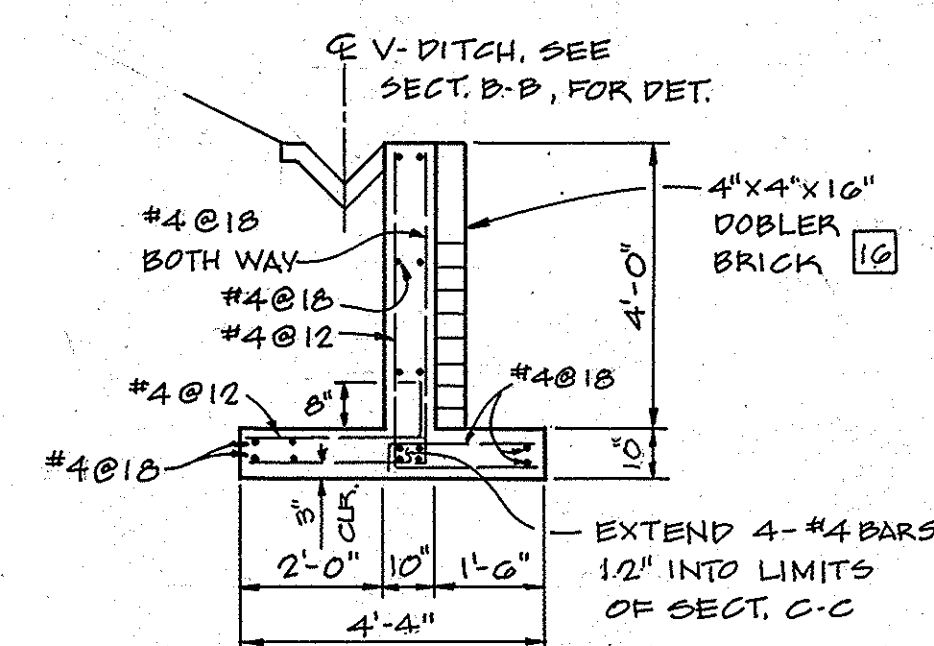
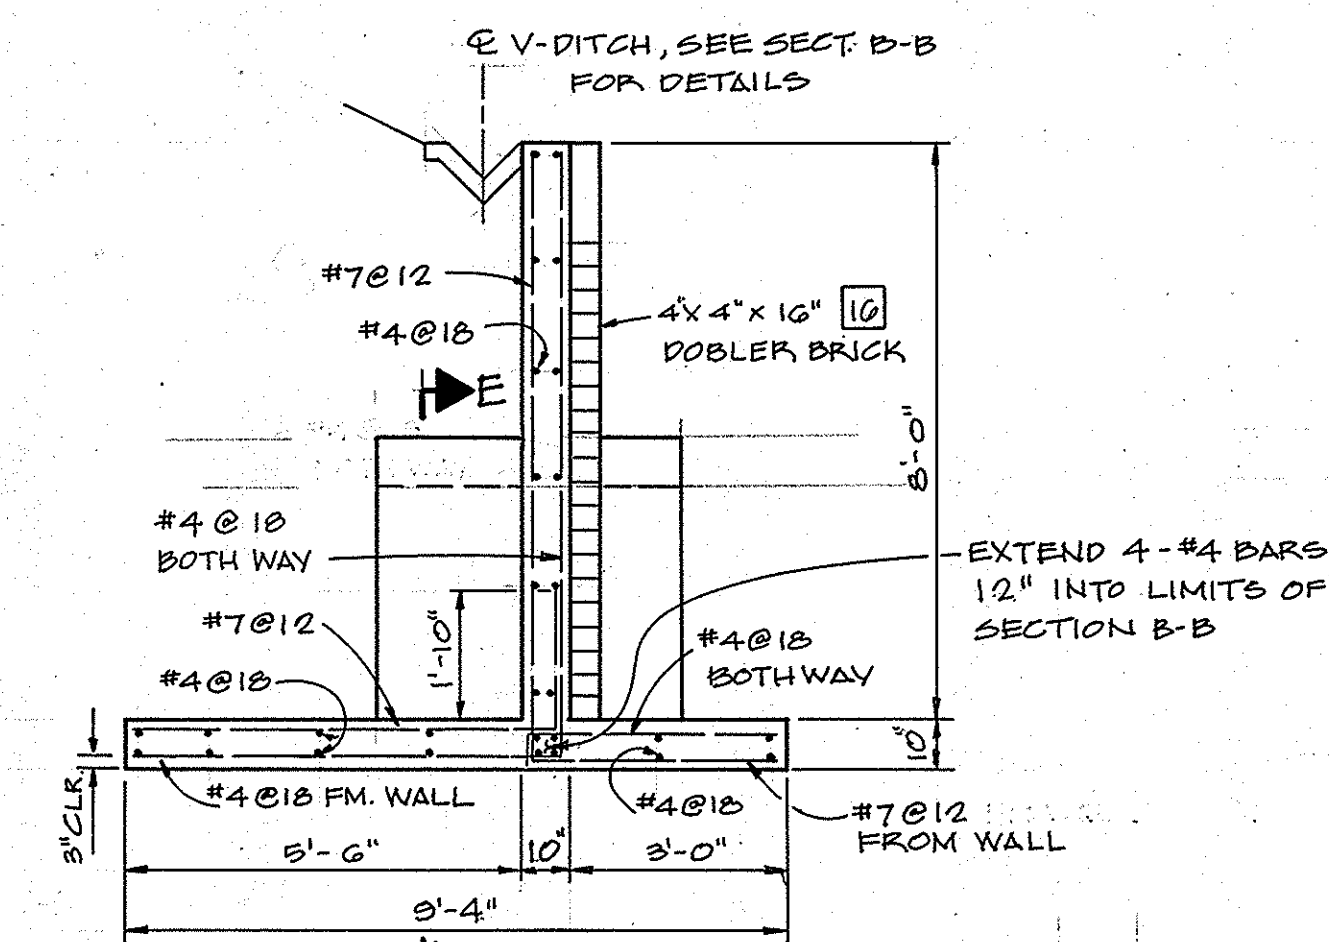
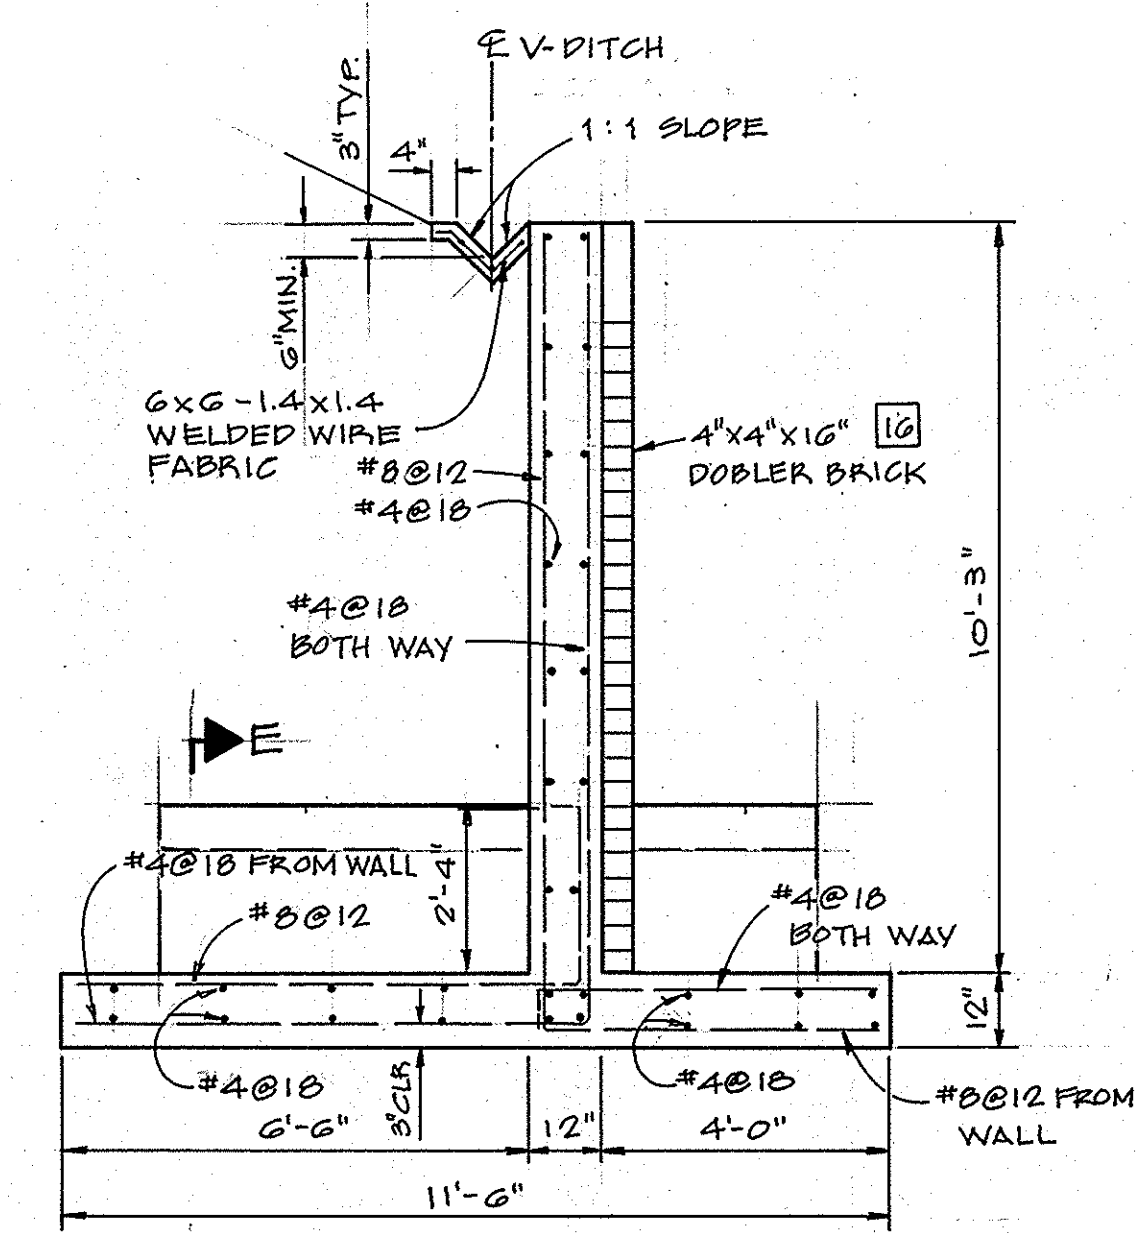
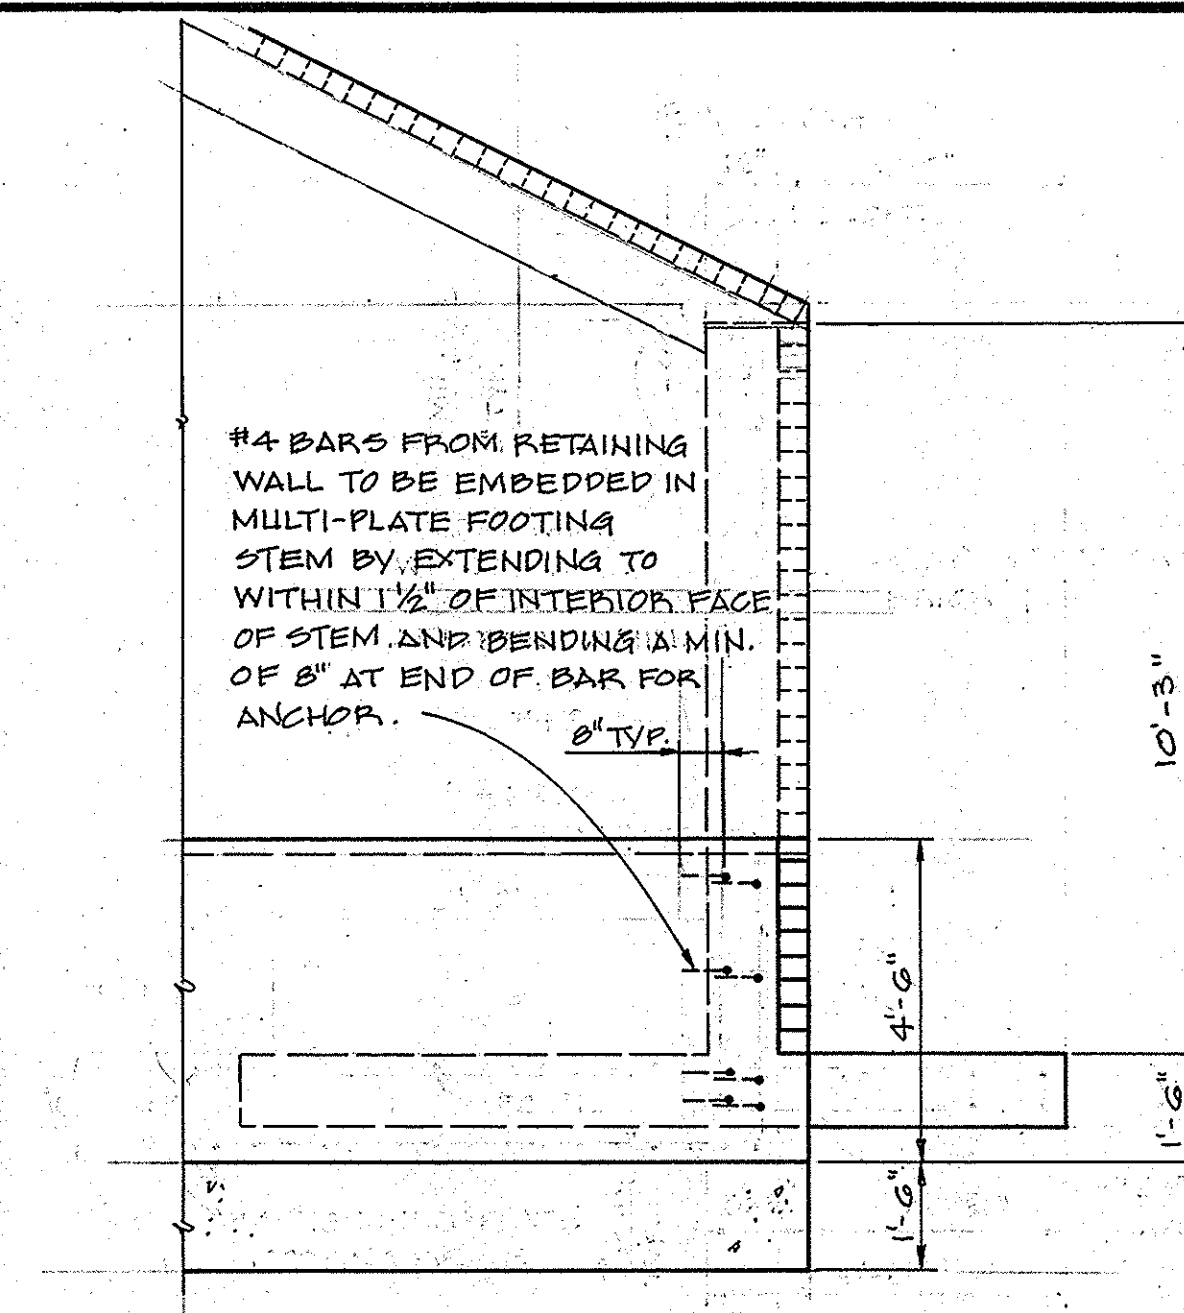
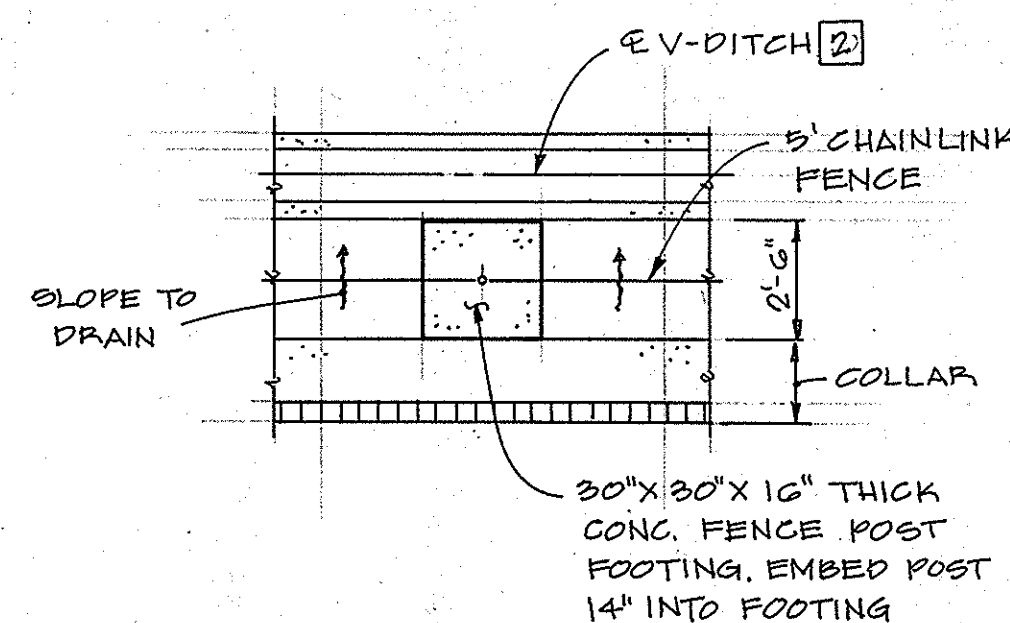


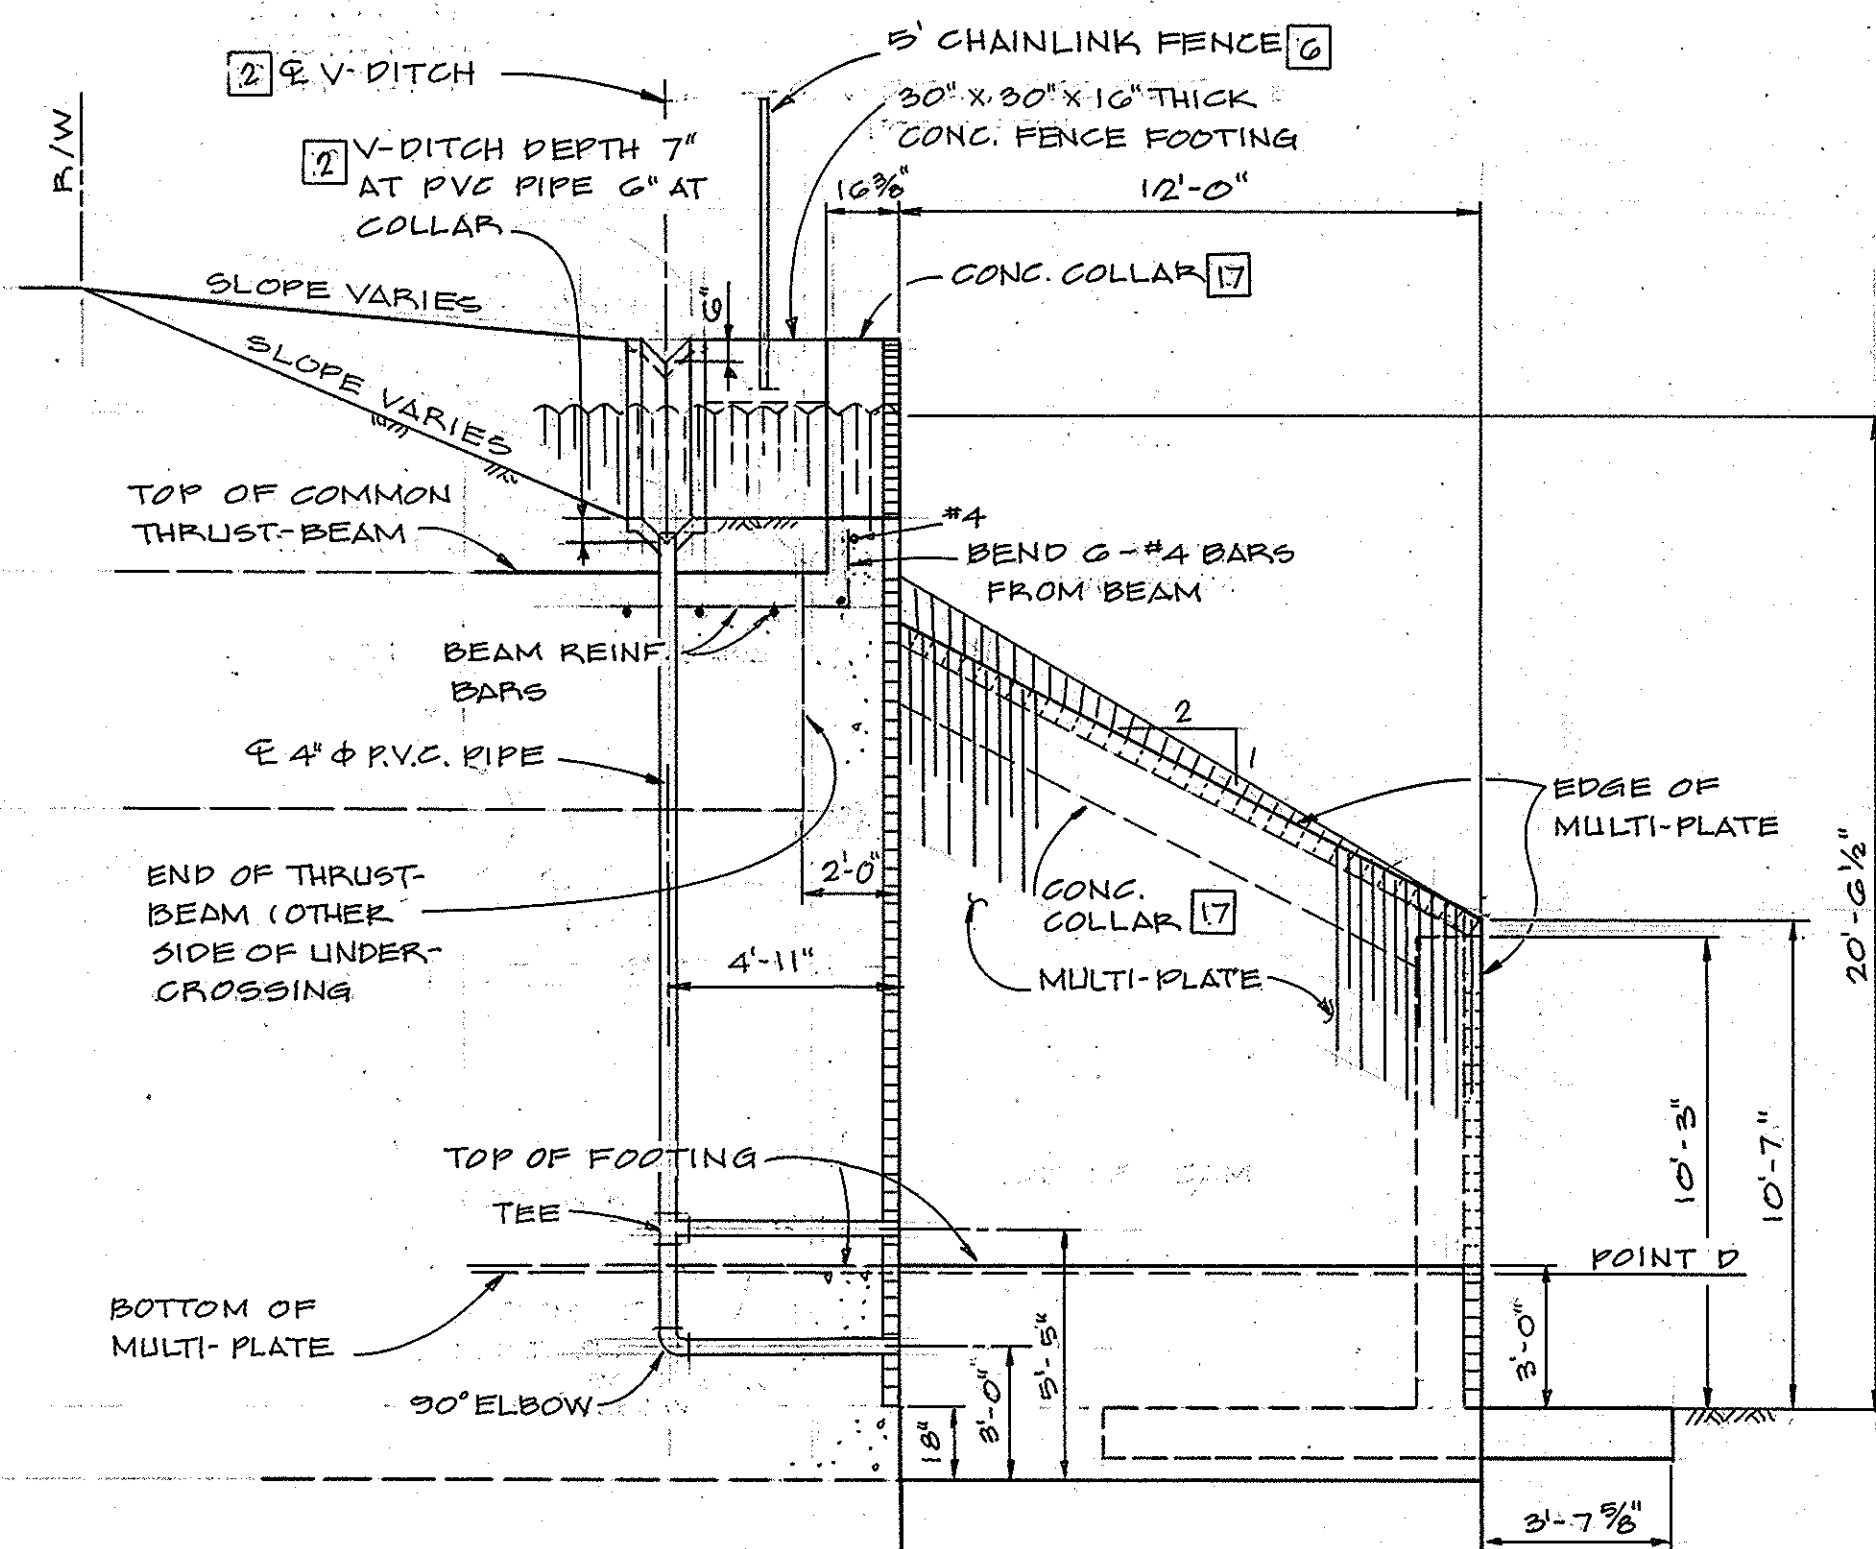

CONSTRUCTION NOTES

- 16 DOUBLER BRICKS TO BE SECURED TO RETAINING WALL BY DOVE TAIL TYPE ANCHOR OR OTHER SUITABLE FASTENER.
- 18 DIMENSIONS FROM FACE OF CONCRETE TO STEEL SHALL BE 1 1/2" CLEAR UNLESS OTHERWISE SHOWN.
- 17 CONSTRUCT CONCRETE COLLAR PER DETAIL ON SHEET U-4.
- 6 INSTALL 5' CHAINLINK FENCE PER O.G.E.M.A. STD. PLAN 412.
- 7 CONSTRUCT V-DITCH PER DETAIL ON SHT. U-1.

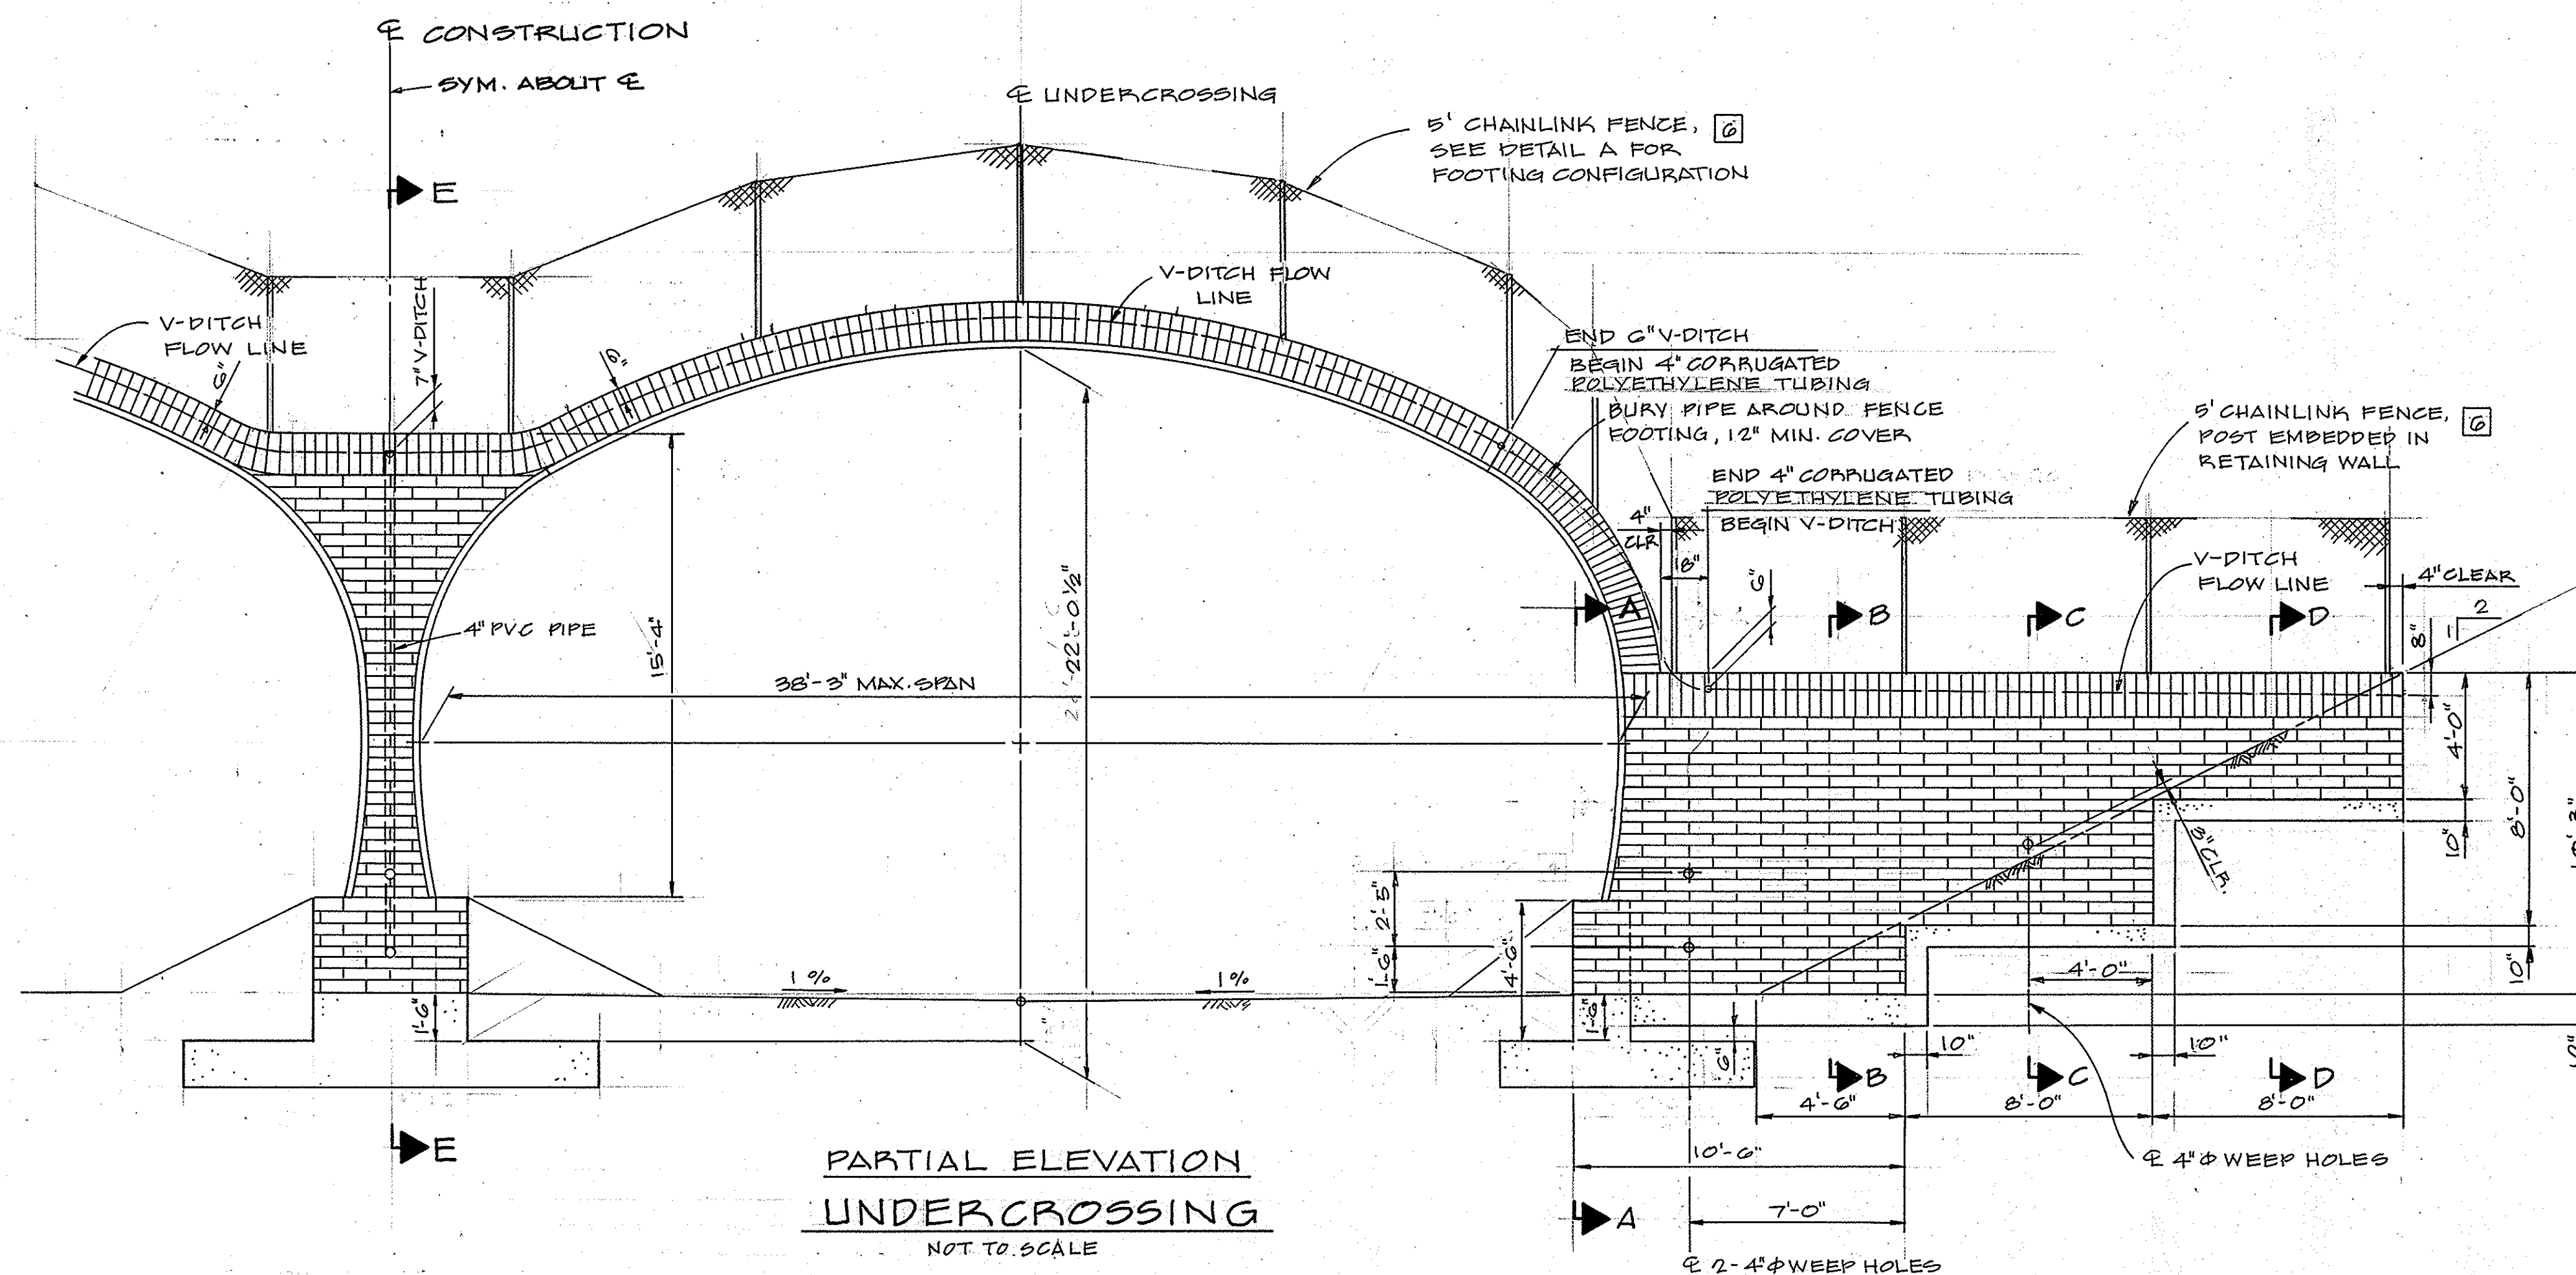

			ORANGE COUNTY ENVIRONMENTAL MANAGEMENT AGENCY	
			WEIR CANYON ROAD UNDERCROSSING PARTIAL ELEVATION AND RETAINING WALL	
MARK	DATE	DESCRIPTION	PREPARED UNDER/ SUPERVISION OF <i>John W. Pether</i>	
REVISIONS			DATE	
DESIGNED	B. A. B.		SCALE	DATE
DRAWN	B.Y.I.	CHECKED J.W.P.	AS SHOWN	11/16 '82
			DWG. NO.	U-2