



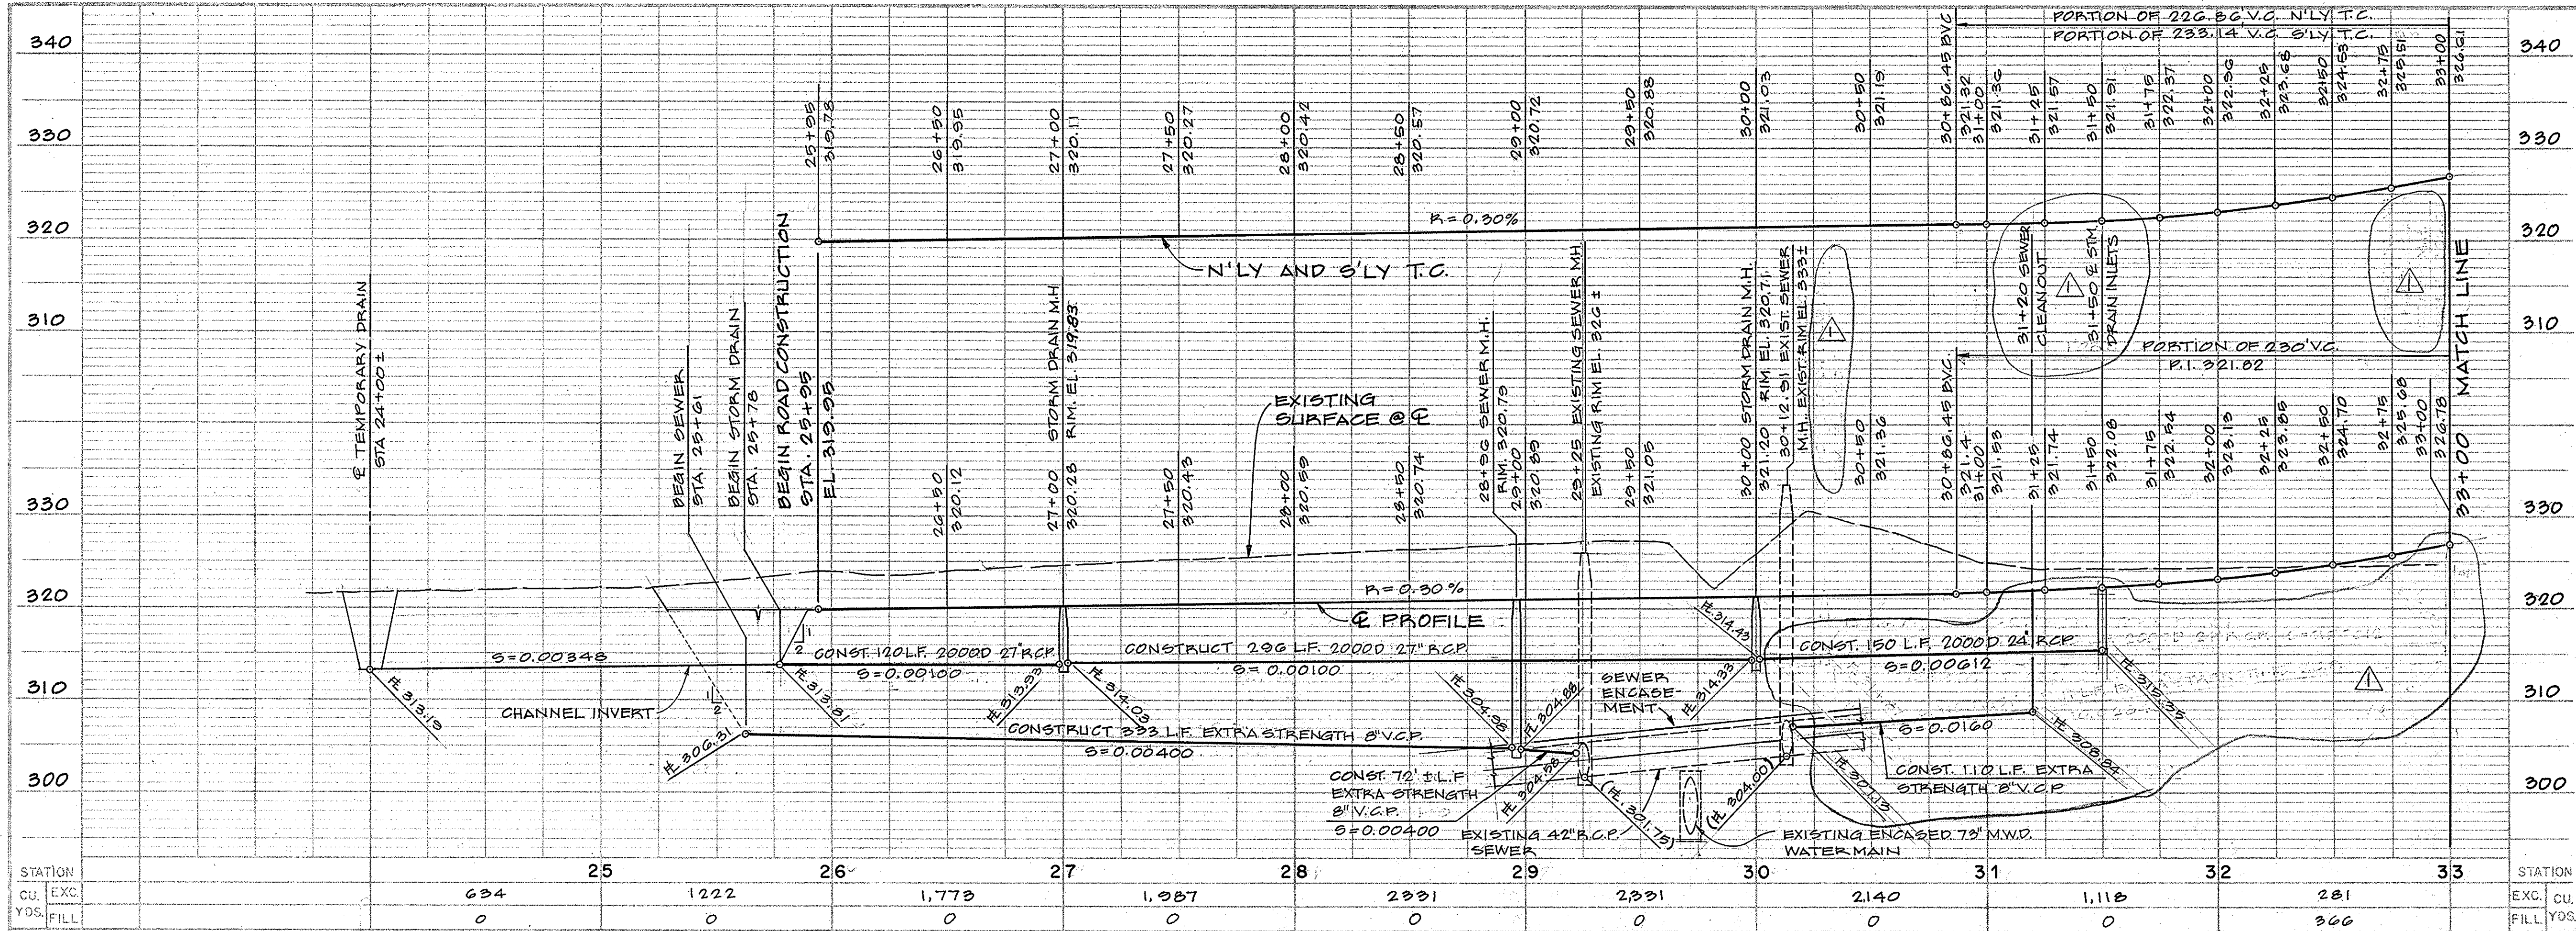

BENCH MARK: EL. 345.697
0.15 MI. N.W. ON WEIR CANYON ROAD FROM THE RIVERSIDE F.V.W. TO A CONC. HEADWALL ON THE WEST SIDE 35' W. OF THE CENTERLINE OF WEIR CANYON ROAD 114' S. OF THE S.A.V.I. CANAL, SET IN THE TOP OF THE CONC. HEADWALL - O.C.S. 1976 ADJ. 3KK-20-71

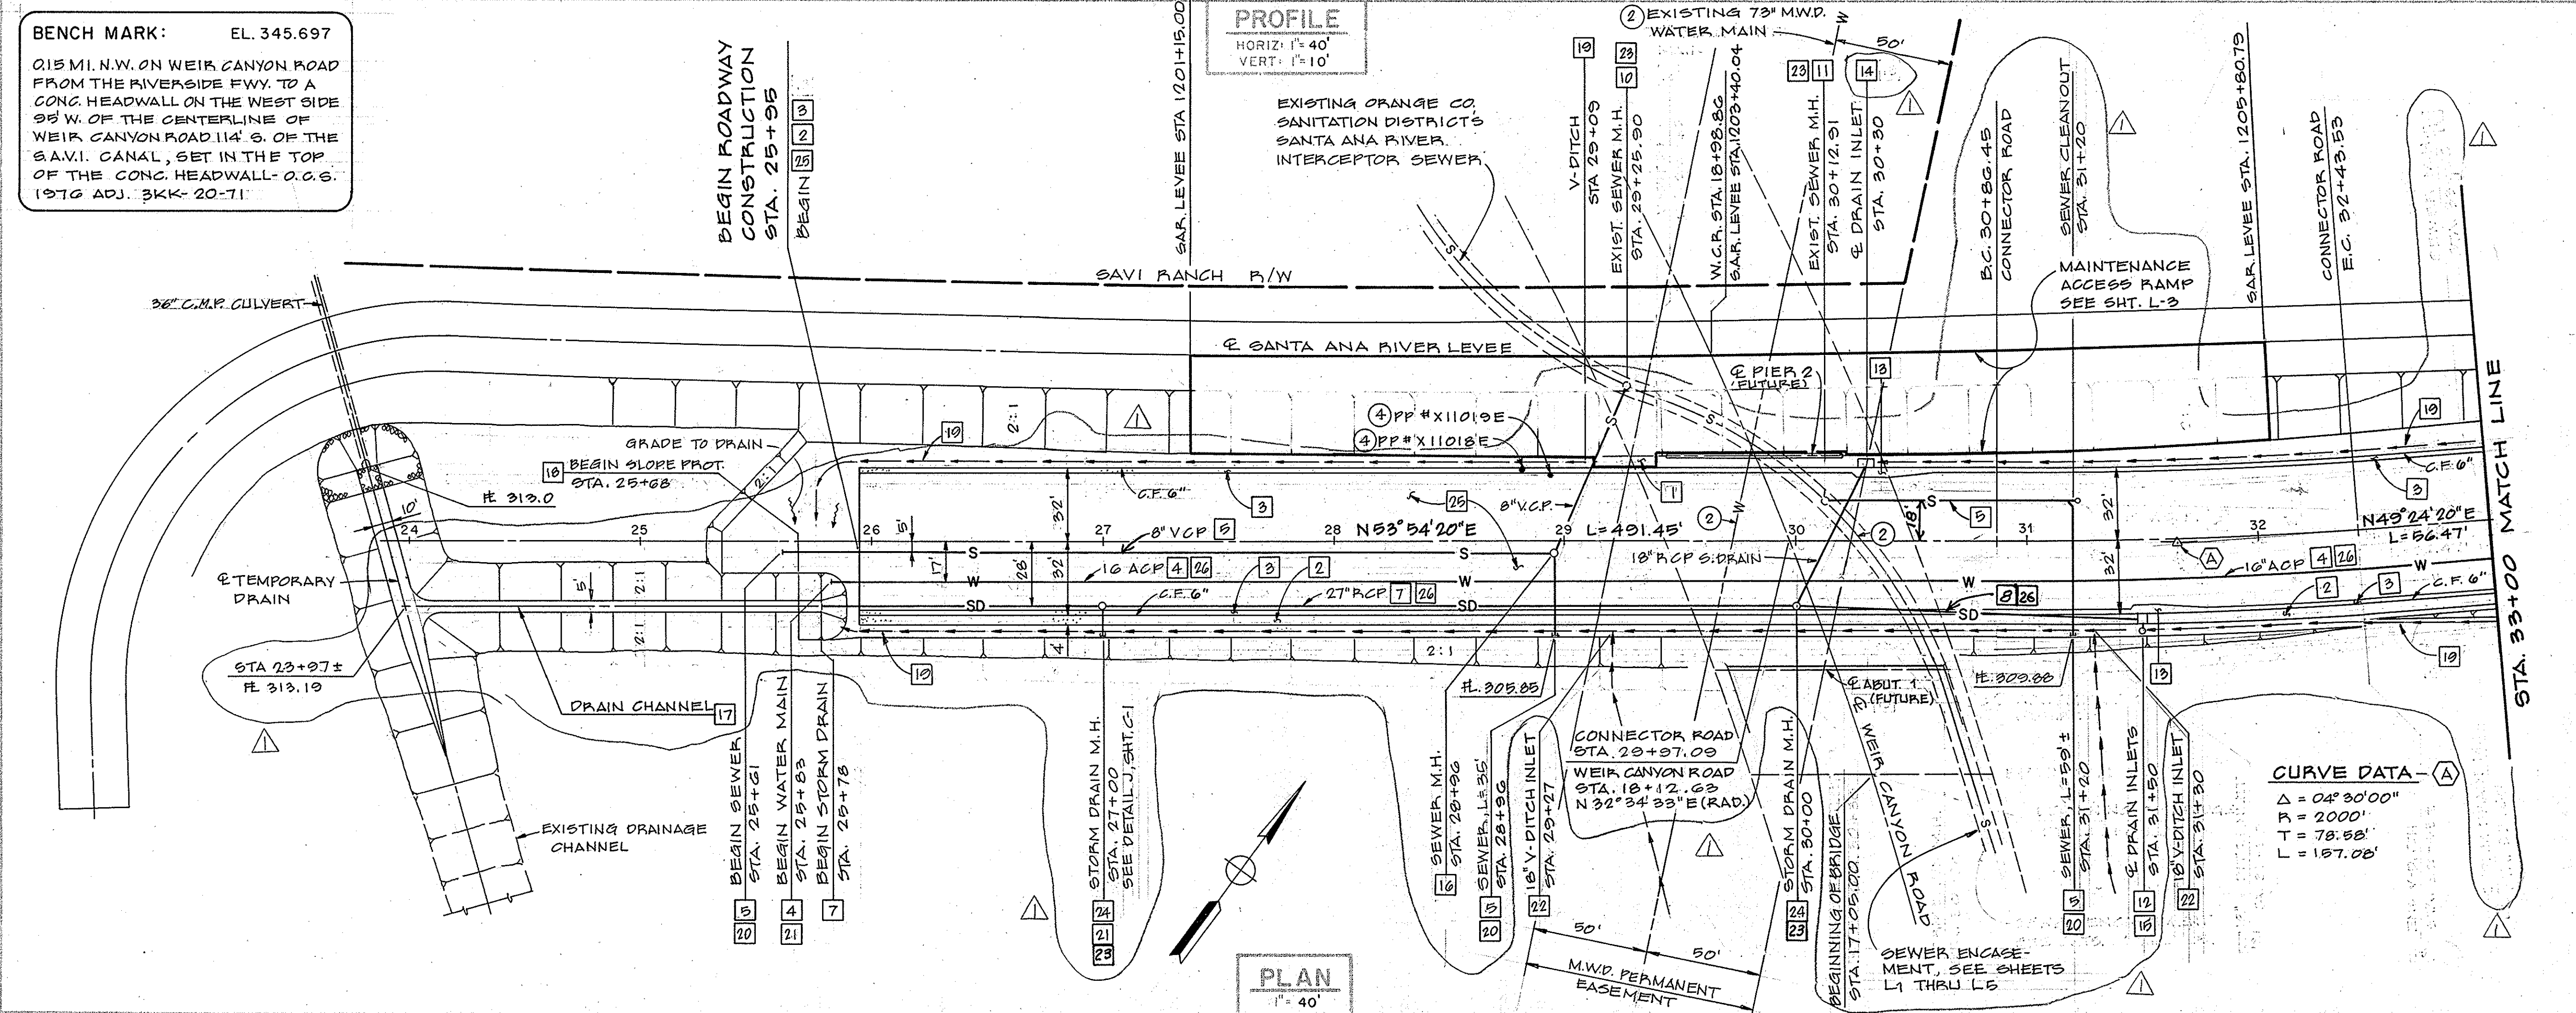

CONSTRUCTION NOTES

1. CONSTRUCT DRIVEWAY PER SHEETS L1 AND L3.
2. CONSTRUCT 4" P.C.C. SIDEWALK PER O.C.E.M.A. STANDARD PLAN 205.
3. CONSTRUCT TYPE D CURB AND GUTTER PER O.C.E.M.A. STD. PLAN 201. APPLY PHENEMINE PRIOR TO PLACEMENT OF CURBS.
4. CONSTRUCT 16" ACP WATER MAIN WITH MIN. 30" OF COVER OVER TOP OF PIPE.
5. CONSTRUCT 8" V.C.P. SEWER.
6. CONSTRUCT 16" V.C.P. SEWER.
7. CONSTRUCT 27" R.C.P. STORM DRAIN.
8. CONSTRUCT 24" R.C.P. STORM DRAIN.
9. CONSTRUCT STORM DRAIN M.H. USING JUNCTION STRUCTURE TYPE 1 WITHOUT SIDE INLET PER O.C.E.M.A. STANDARD PLAN 310.
10. EXISTING O.C.S.D. MANHOLE ADJUST TO FINISHED GRADE OF LEVEE PER SPECIFICATIONS.
11. EXISTING O.C.S.D. MANHOLE ADJUST TOP OF M.H. TO FINISHED GRADE PER SPECIFICATIONS.
12. CONSTRUCT INLET TYPE I PER O.C.E.M.A. STD. PLAN 301 AND PER DETAILS G & H, SHT. C-1.
13. CONSTRUCT LOCAL DEPRESSION PER O.C.E.M.A. STD. PLAN 305.
14. CONSTRUCT INLET TYPE II PER O.C.E.M.A. STD. PLAN 302 AND PER DETAILS G & H, SHT. C-1.
15. CONSTRUCT INLET TYPE V PER O.C.E.M.A. STD. PLAN 303 AND PER DETAILS G & H, SHT. C-1.
16. CONSTRUCT 48" SEWER M.H. WITH ECCENTRIC CONE PER O.C.S.D. DWG. 8-33-1 WITH 8" SERVICE LATERAL.
17. CONSTRUCT DRAIN CHANNEL WITH 5' BOTTOM WIDTH AND SIDE SLOPES OF 2:1.
18. CONST. 6" THICK TYPE II FILTER MATERIAL.
19. CONSTRUCT 1' DEEP V-DITCH PER TYPICAL SECTIONS SHT. C-1.
20. PLUG OR CAP THE END OF PIPE WITH NEOPRENE OR V.C. STOPPER.
21. PLUG OR CAP END OF PIPE WITH PLYWOOD BULKHEAD.
22. CONSTRUCT 18" V-DITCH PER RAMP DRAWING: SHTS. X-1, X-2 AND X-3.
23. CONSTRUCT INLET CONNECTIONS TO MATCH CROWNS WITH THE EXISTING MAIN LINE PER SPECIFICATIONS.
24. CONSTRUCT STORM DRAIN M.H. USING JUNCTION STRUCTURE TYPE I PER O.C.E.M.A. STD. PLAN 310.
25. CONSTRUCT 3" AC WITH SEAL COAT OVER 8" AB PER TYPICAL SECTIONS, SHT. C-1. (THESE THICKNESSES ARE ESTIMATED AND ARE SUBJECT TO CHANGE PENDING RESULTS OF SOILS TESTS OF IN PLACE ROADWAY EMBANKMENTS).
26. ROADWAY EMBANKMENT SHALL BE CONSTRUCTED TO FINISH SUBGRADE OR 3.5' ABOVE THE TOP OF THE PIPE, WHICH EVER IS LOWER, PRIOR TO EXCAVATION OF TRENCH AND PLACEMENT OF PIPE.

LEGEND

- 2. PROTECT
- 4. TO BE RELOCATED BY OTHERS (S.C.E.)

1/2 0 1 2
3 inches on original drawing

REVISOR'S NOTES, ROAD LOCATION, SECTION 8, 85' LENGTH AND UTILITIES UTILITY PROFILES.		ORANGE COUNTY ENVIRONMENTAL MANAGEMENT AGENCY	
WEIR CANYON ROAD CONNECTOR ROAD PLAN AND PROFILE STA. 25+95 TO STA. 33+00		SHEET C-2	
MARK	DATE	DESCRIPTION	PREPARED UNDER SUPERVISION OF
DESIGNED	M.H.M.	SCALE	DATE
DRAWN	B.Y.L.	CHECKED	J.W.P.