
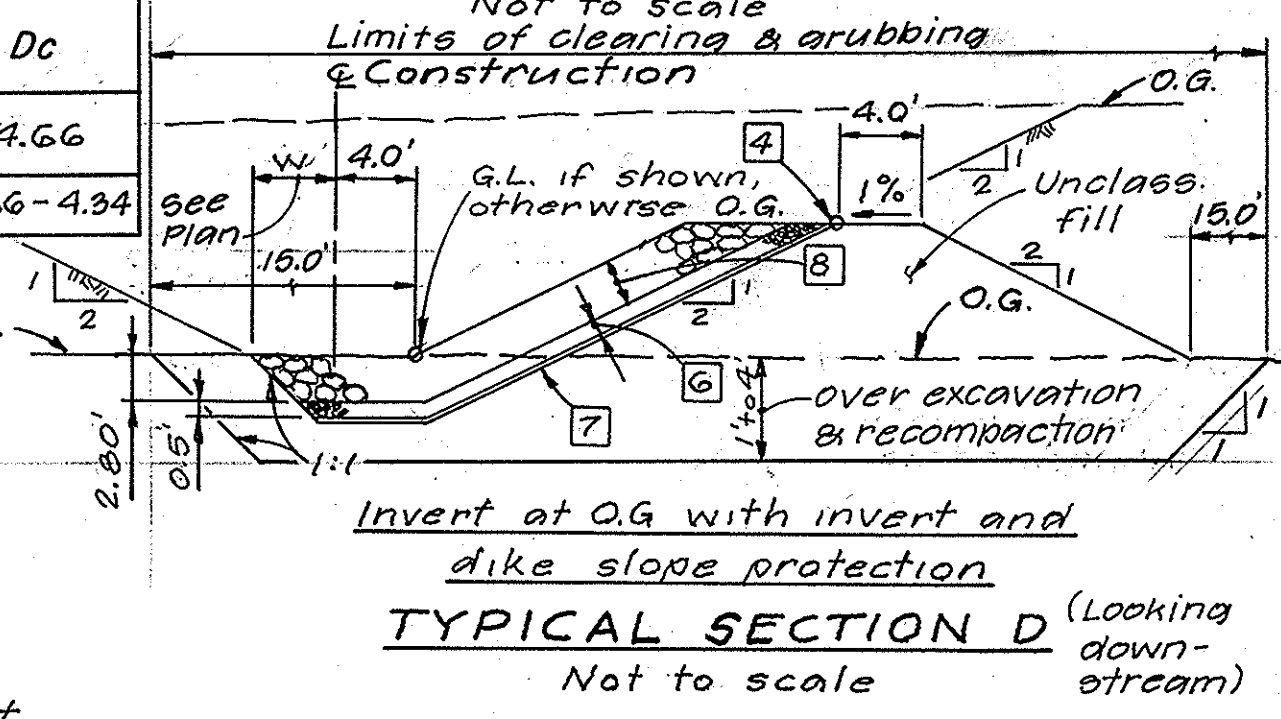
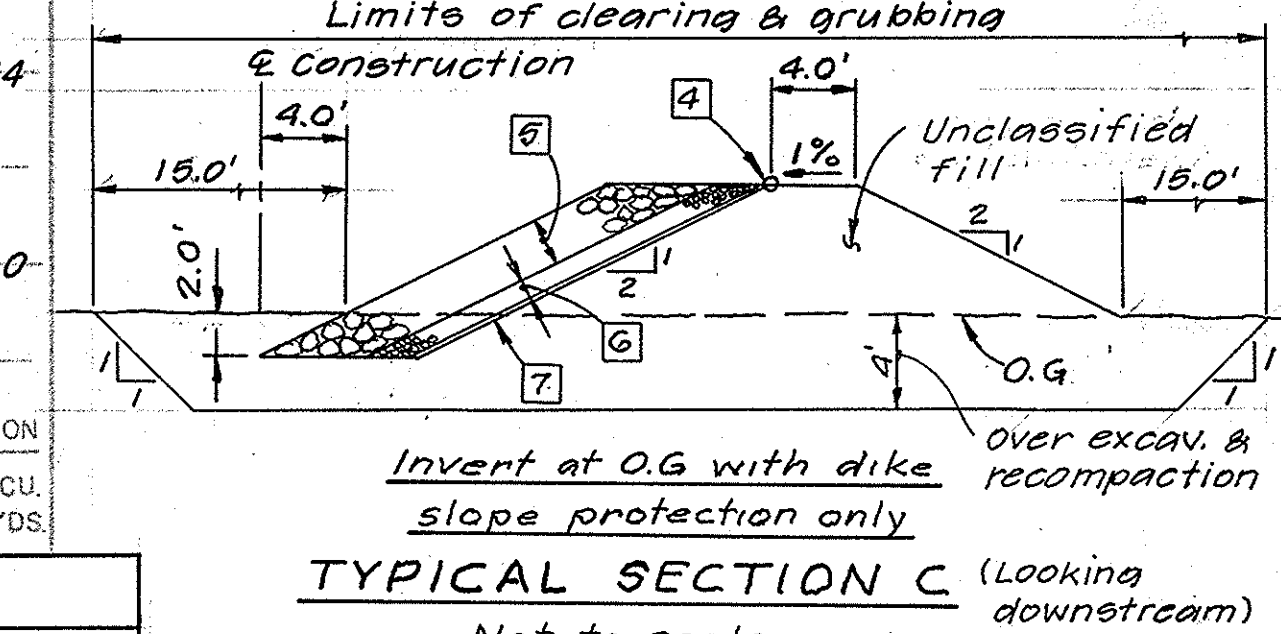
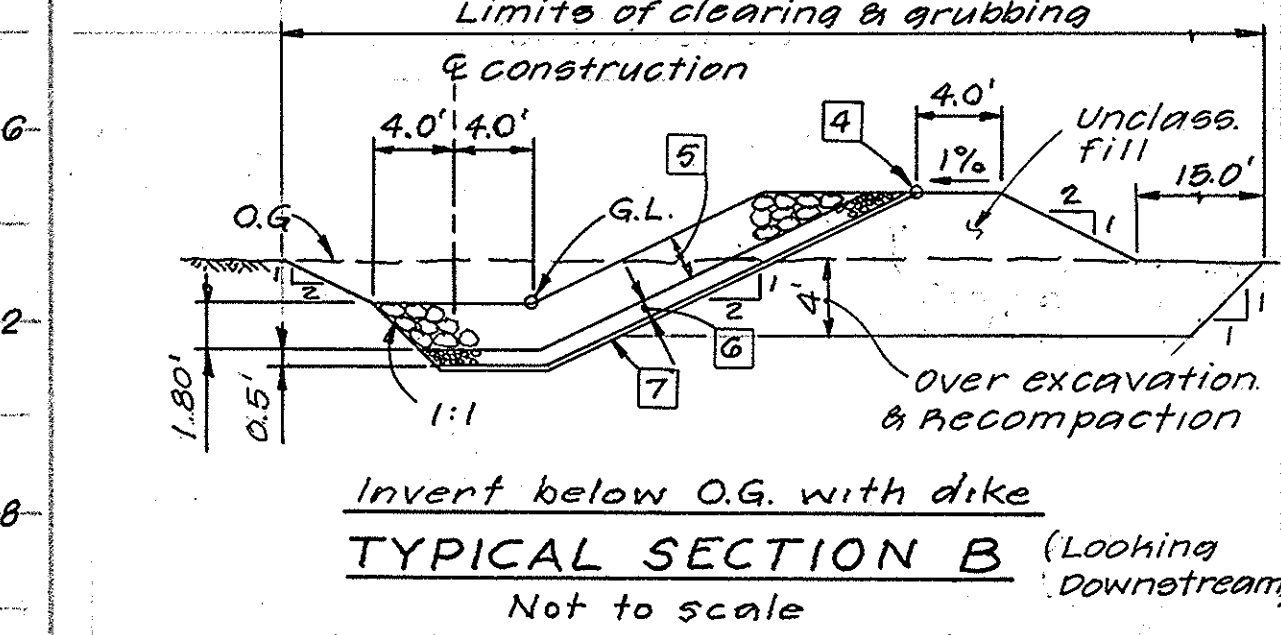
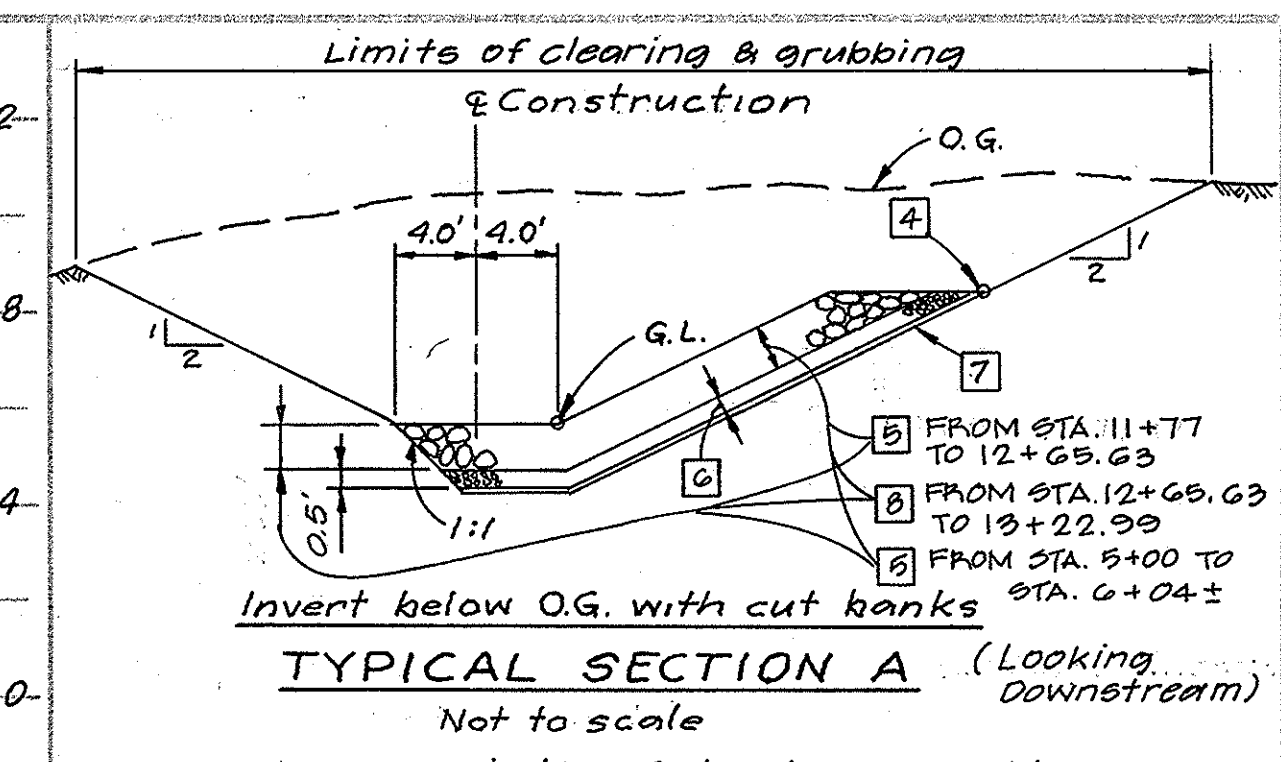
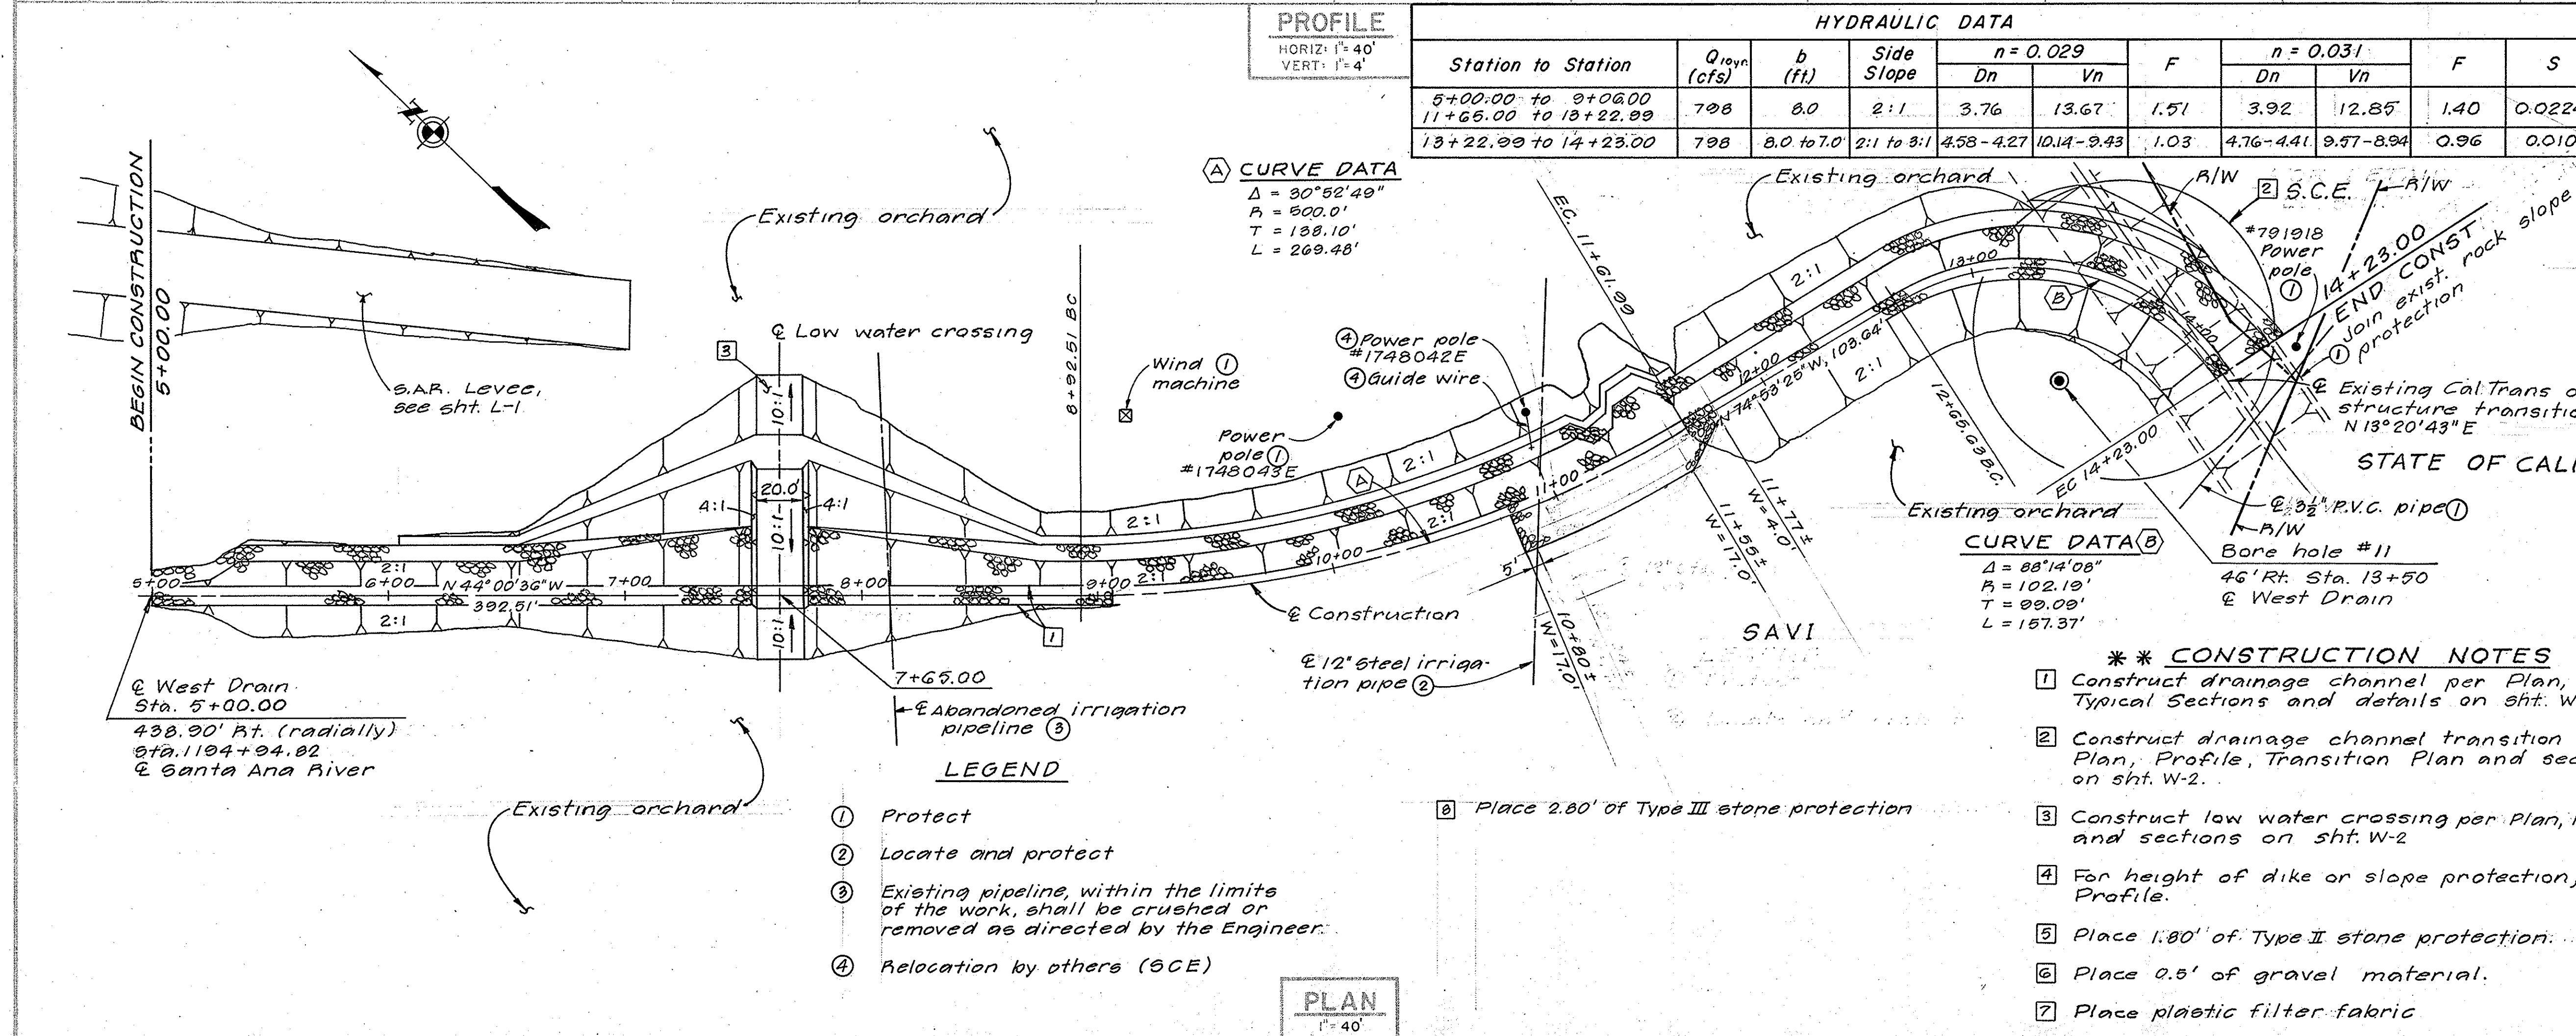


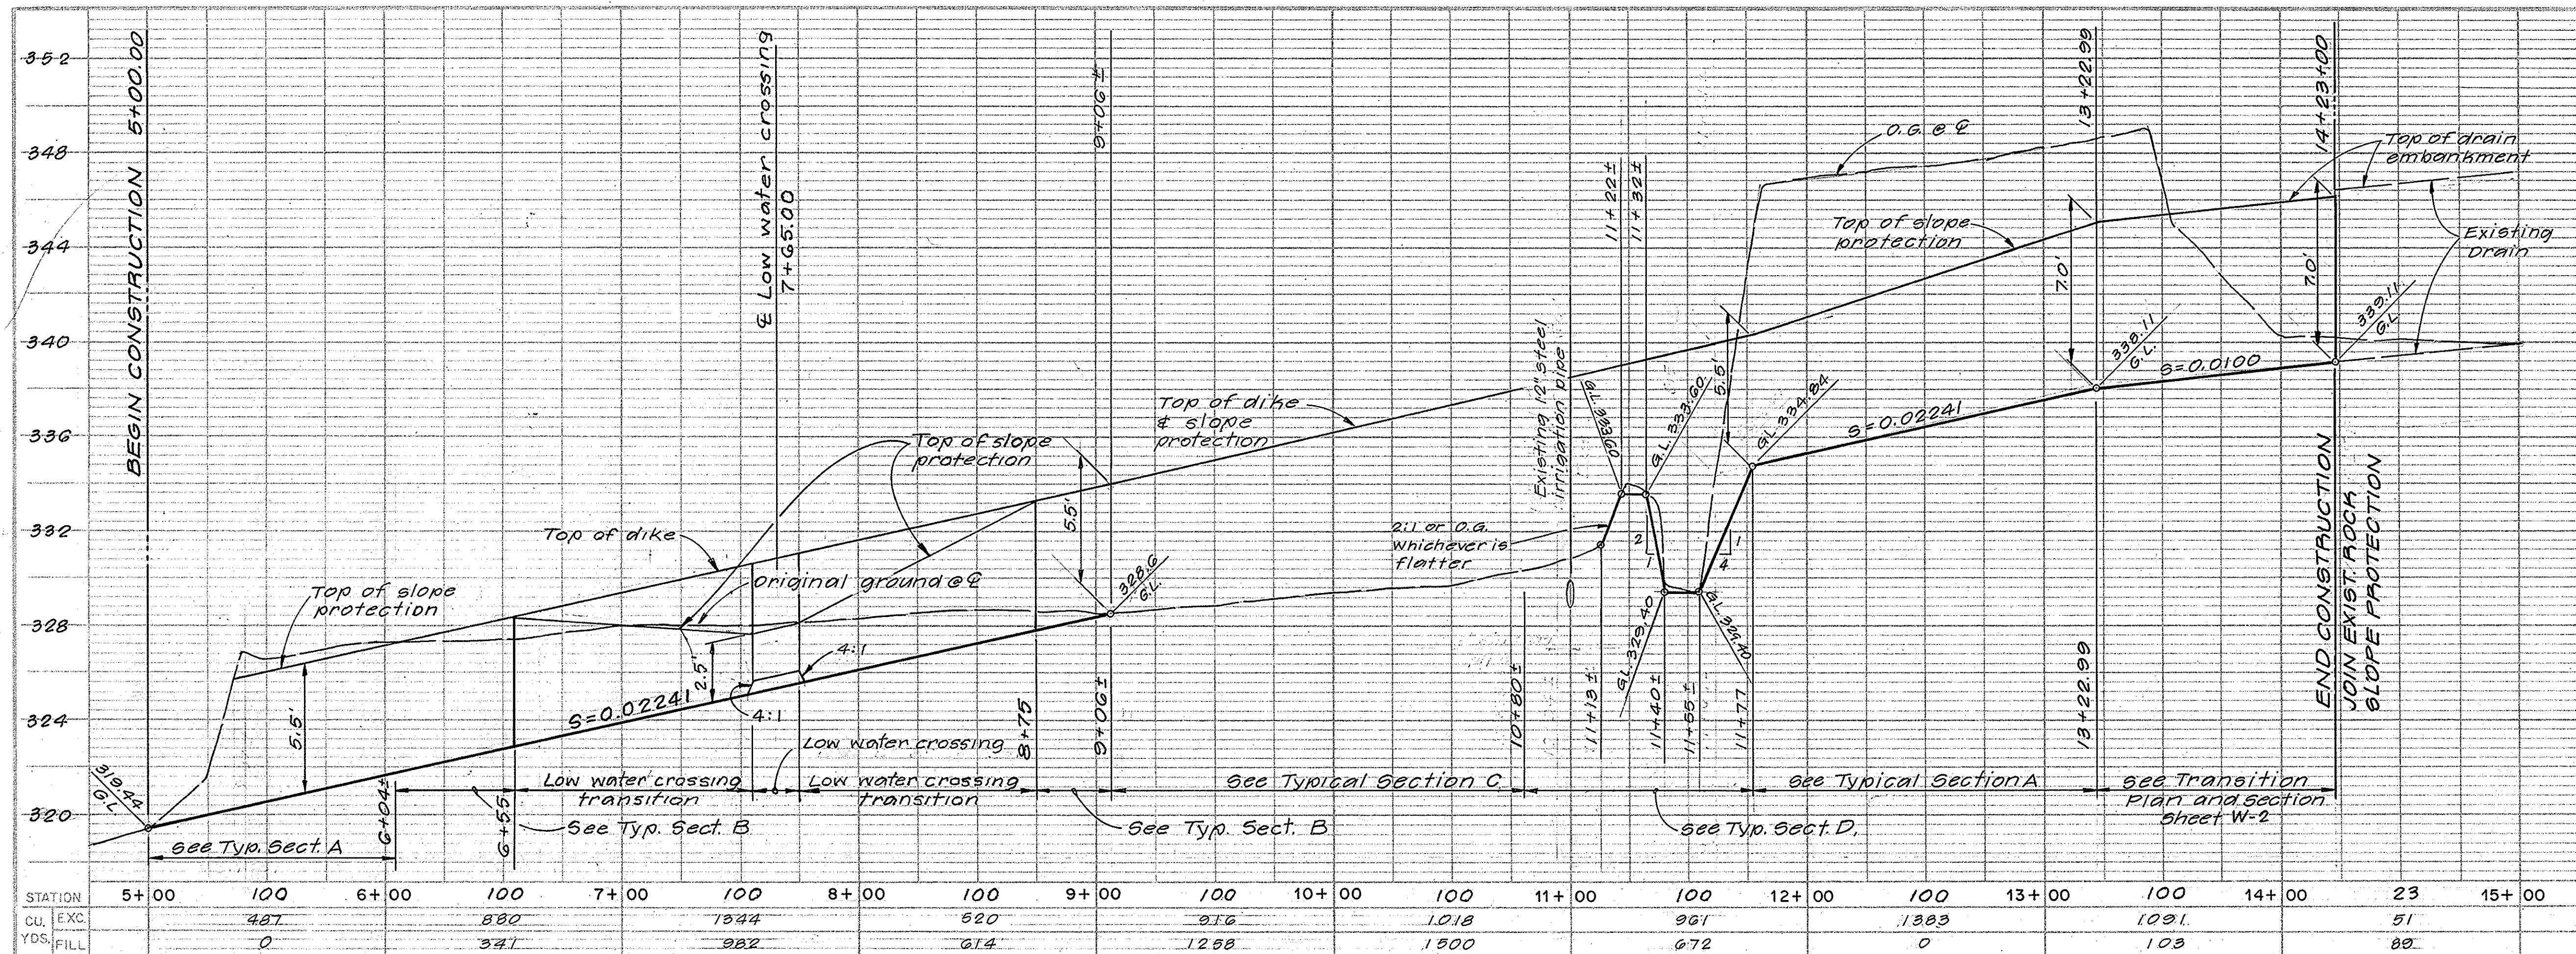

BENCH MARK: EL. 345.709
0.15 MI. N.W. OF WEIR CANYON RD., FROM THE RIVERSIDE FWY. TO A CONC. HDWL. ON THE WEST SIDE, 95' W. OF THE CENTERLINE OF WEIR CANYON RD., 14.6' OF THE S.A.V.I. CANAL, SET IN THE TOP OF THE CONC. HDWL. - O.C.S. 1976 ADJ. 3KK. - 20-71

- ** CONSTRUCTION NOTES**
- Construct drainage channel per Plan, Profile, Typical Sections and details on sht. W-2.
 - Construct drainage channel transition per Plan, Profile, Transition Plan and sections on sht. W-2.
 - Construct low water crossing per Plan, Profile and sections on sht. W-2.
 - For height of dike or slope protection, see Profile.
 - Place 1.80' of Type II stone protection.
 - Place 0.5' of gravel material.
 - Place plastic filter fabric

ORANGE COUNTY ENVIRONMENTAL MANAGEMENT AGENCY
EOIP53-701-1
WEIR CANYON ROAD
WEST DRAIN
PLAN AND PROFILE
STA. 5+00 TO STA. 14+23

MARK DATE DESCRIPTION
DESIGNED: M.H.M.
DRAWN: W.H.W. BY: J.W.P. CHECKED: J.W.P.
PREPARED UNDER SUPERVISION OF: John W. Fisher
SCALE: AS SHOWN
DATE: AUG '82
DWG. NO.: EOIP53-701-1
SHEET: 2 OF 4