

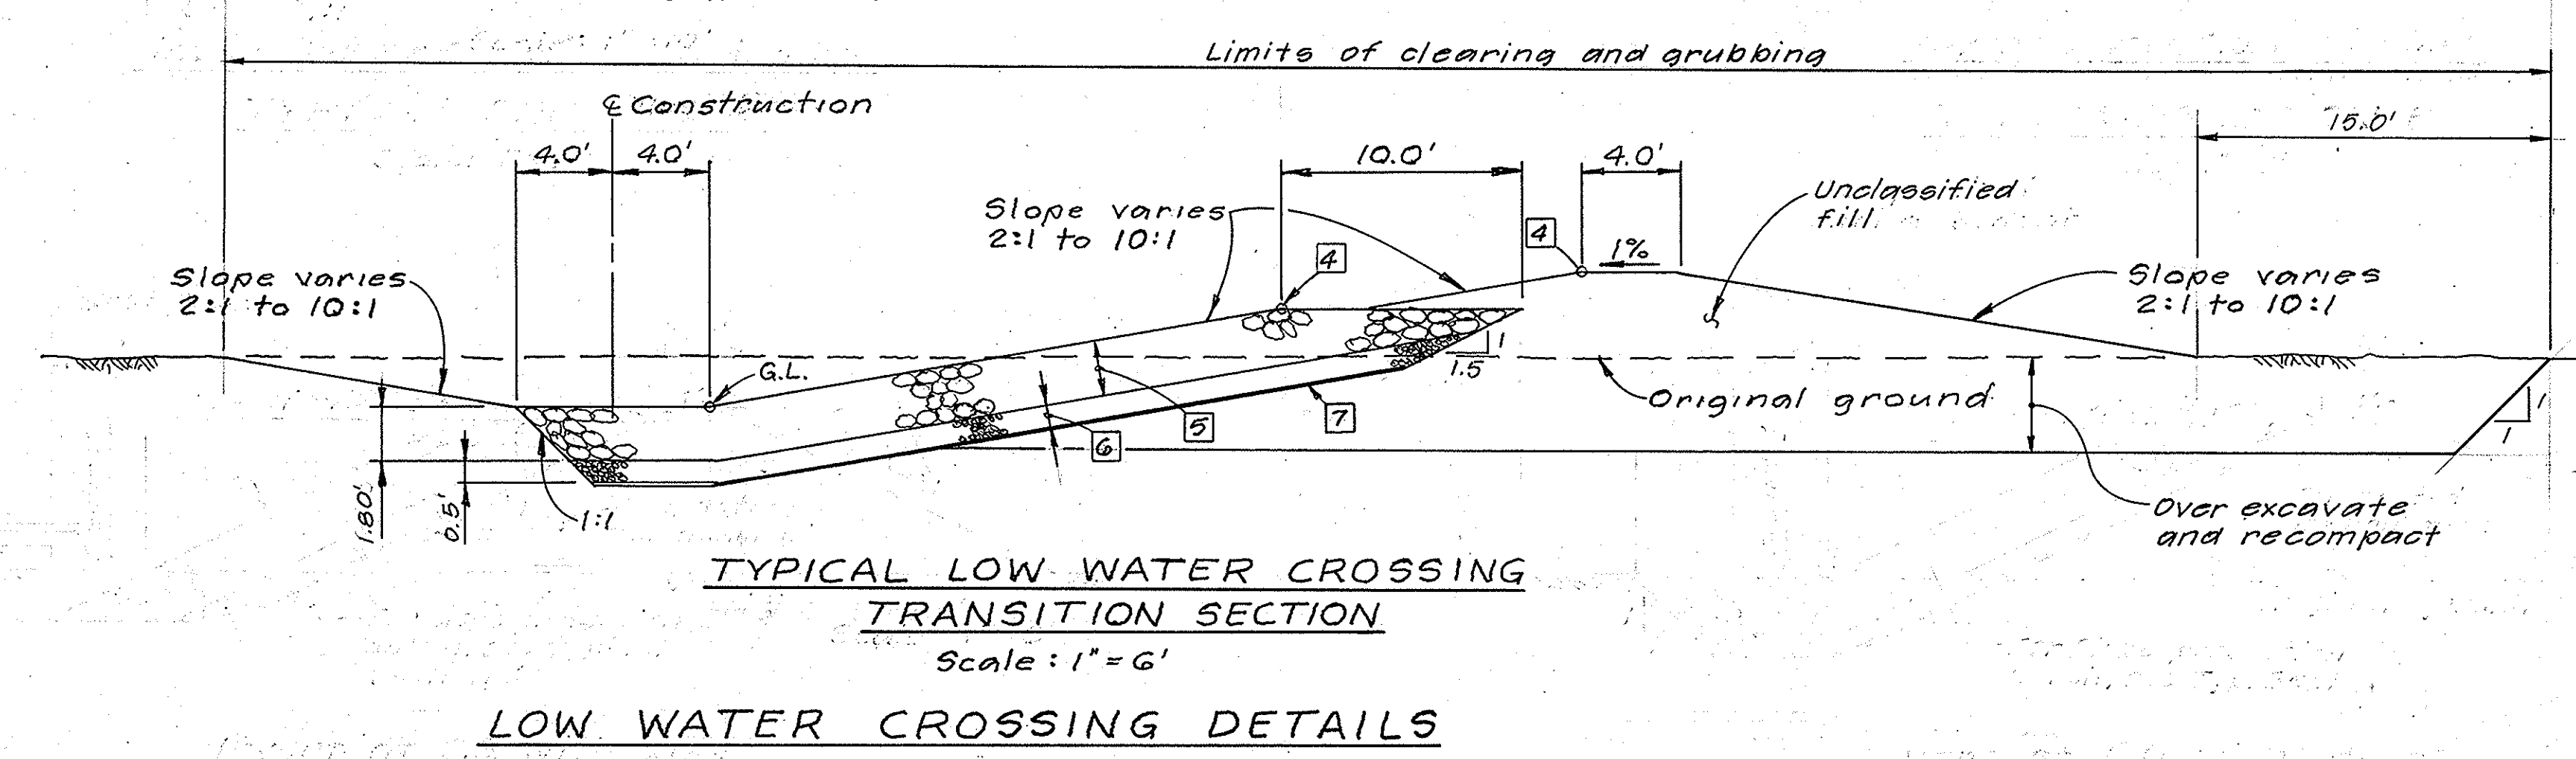
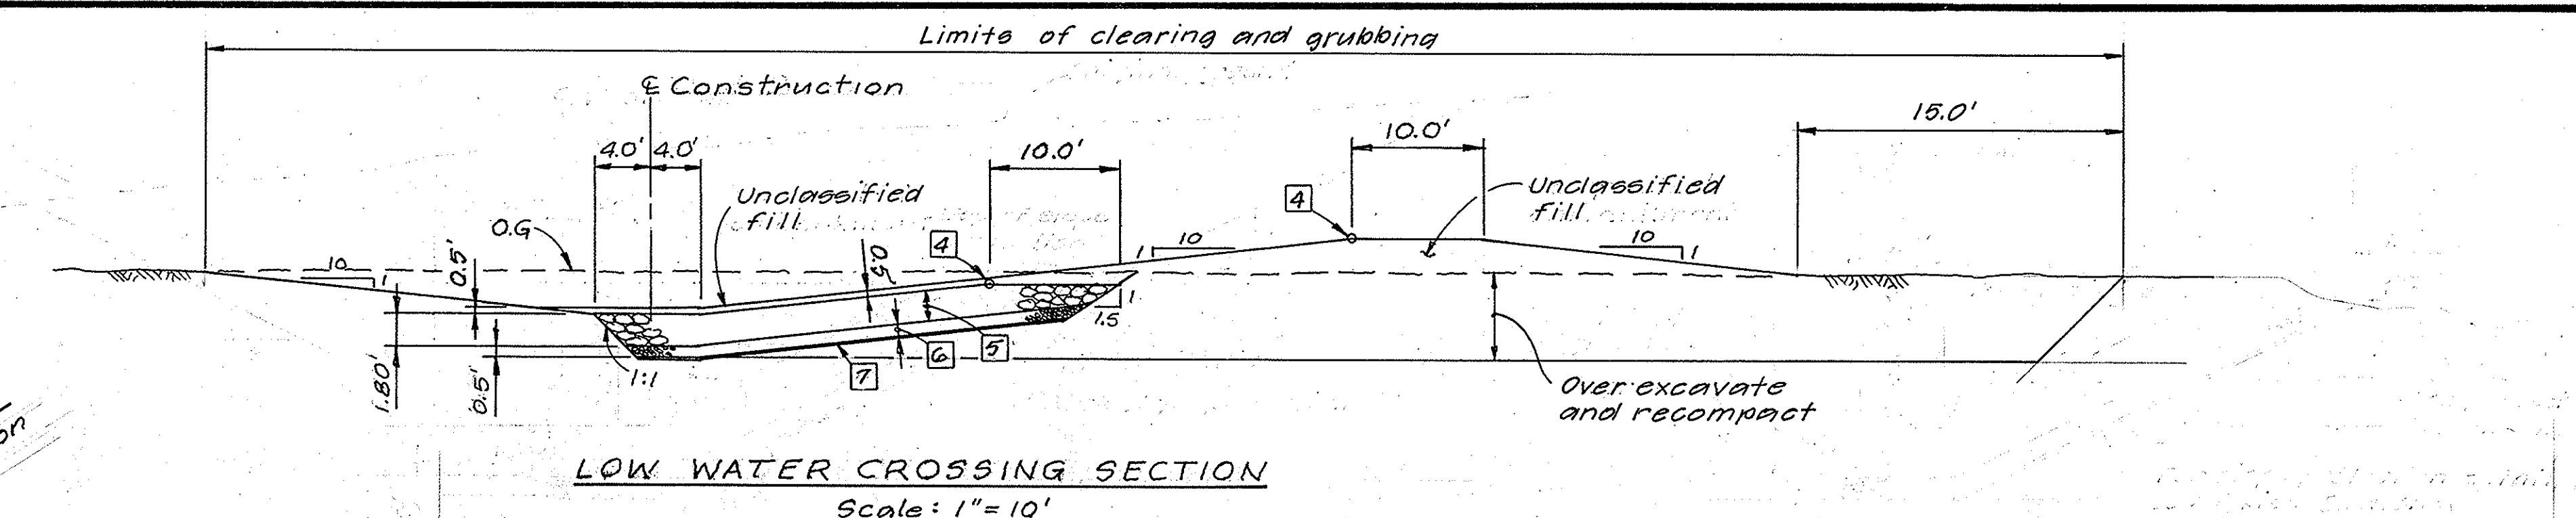
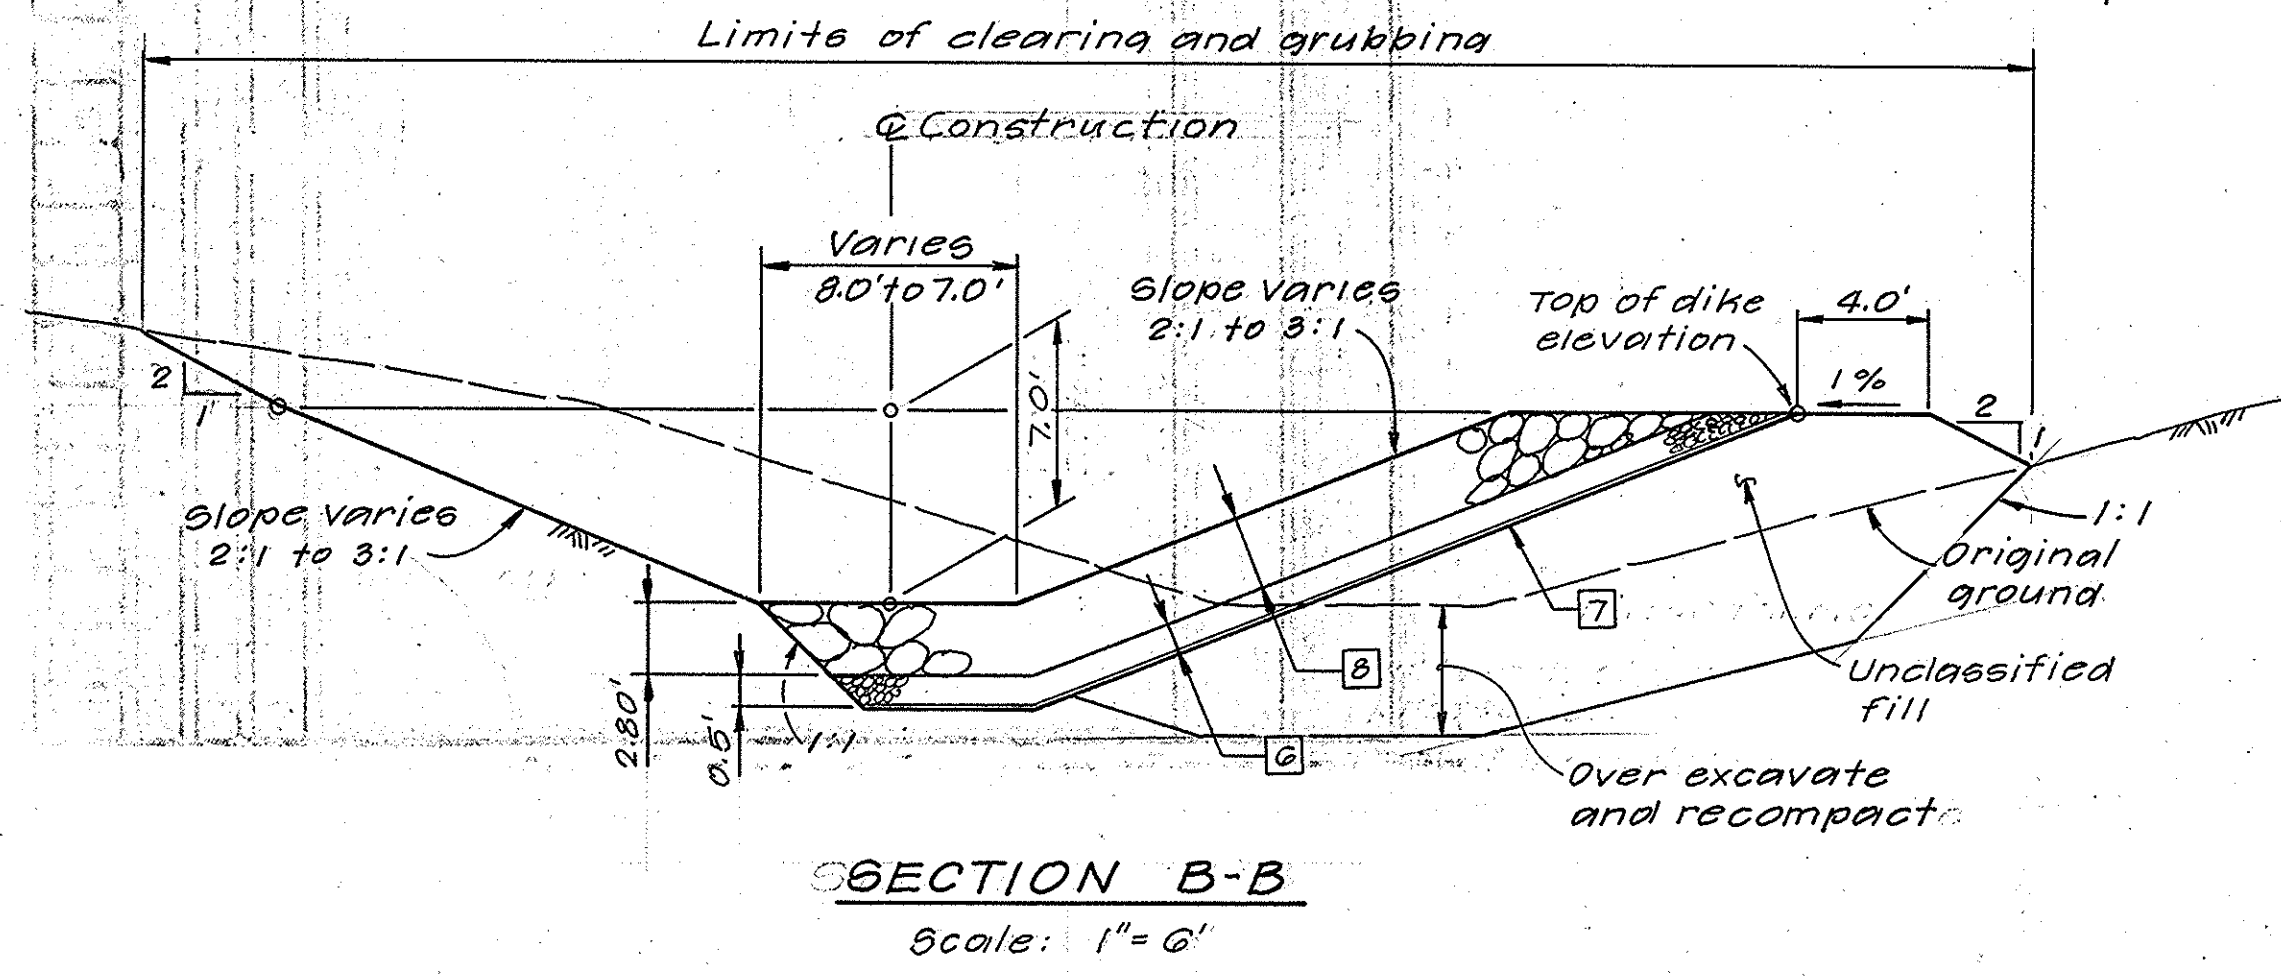
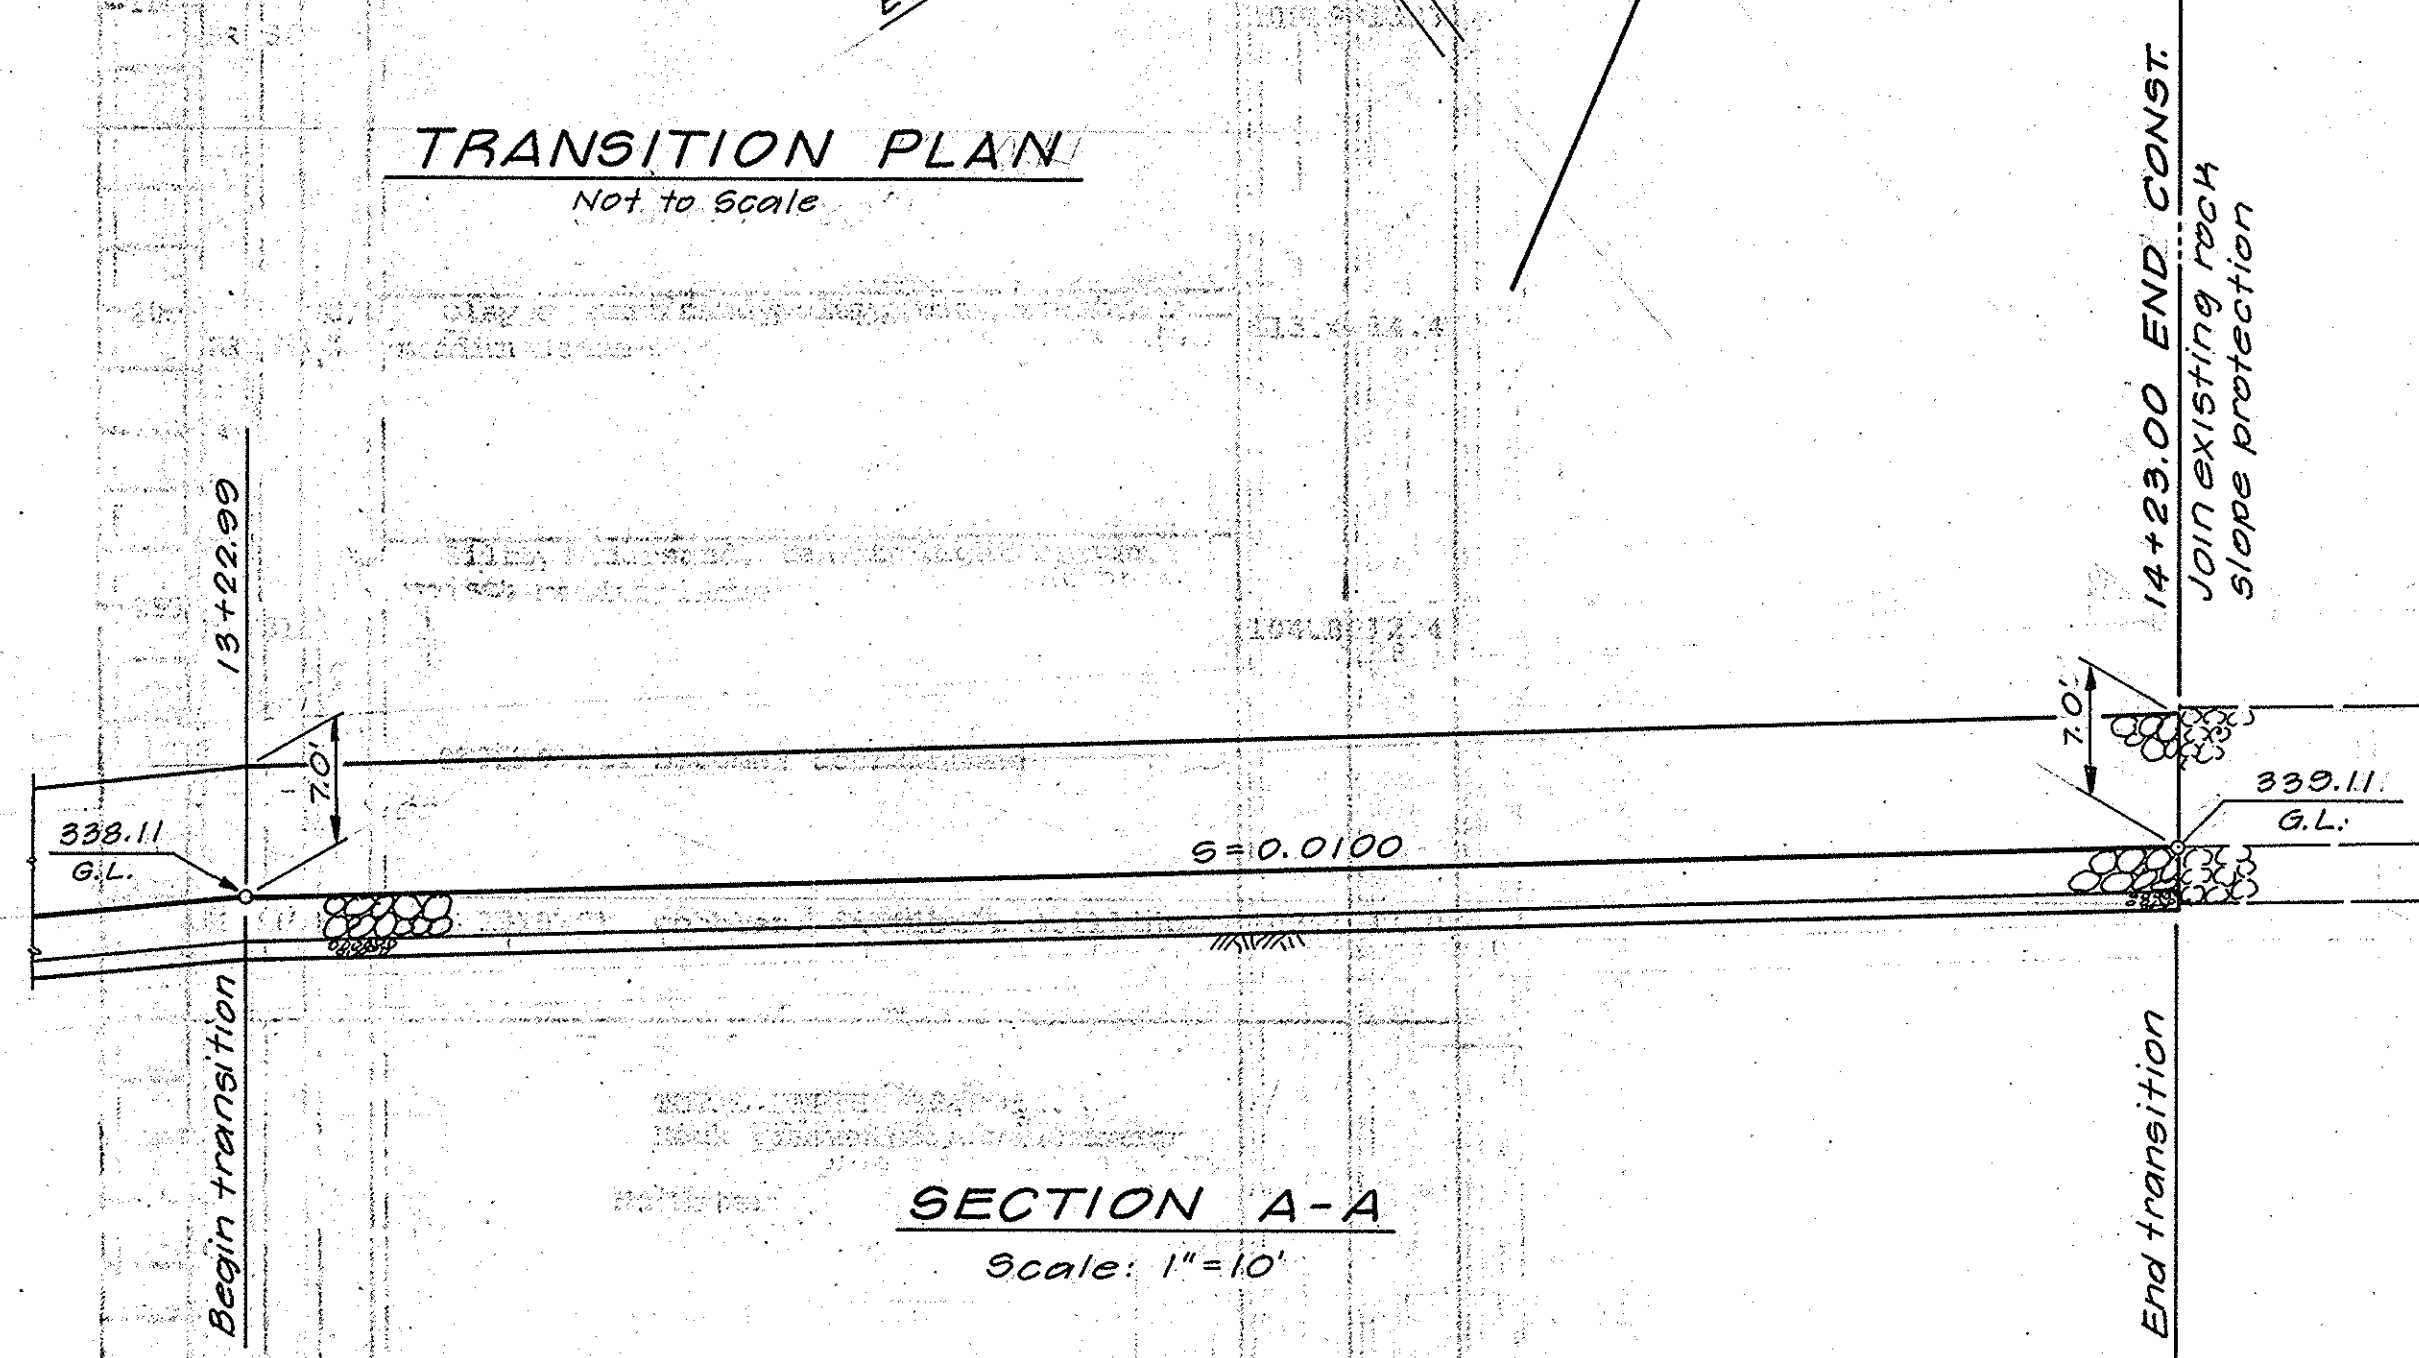


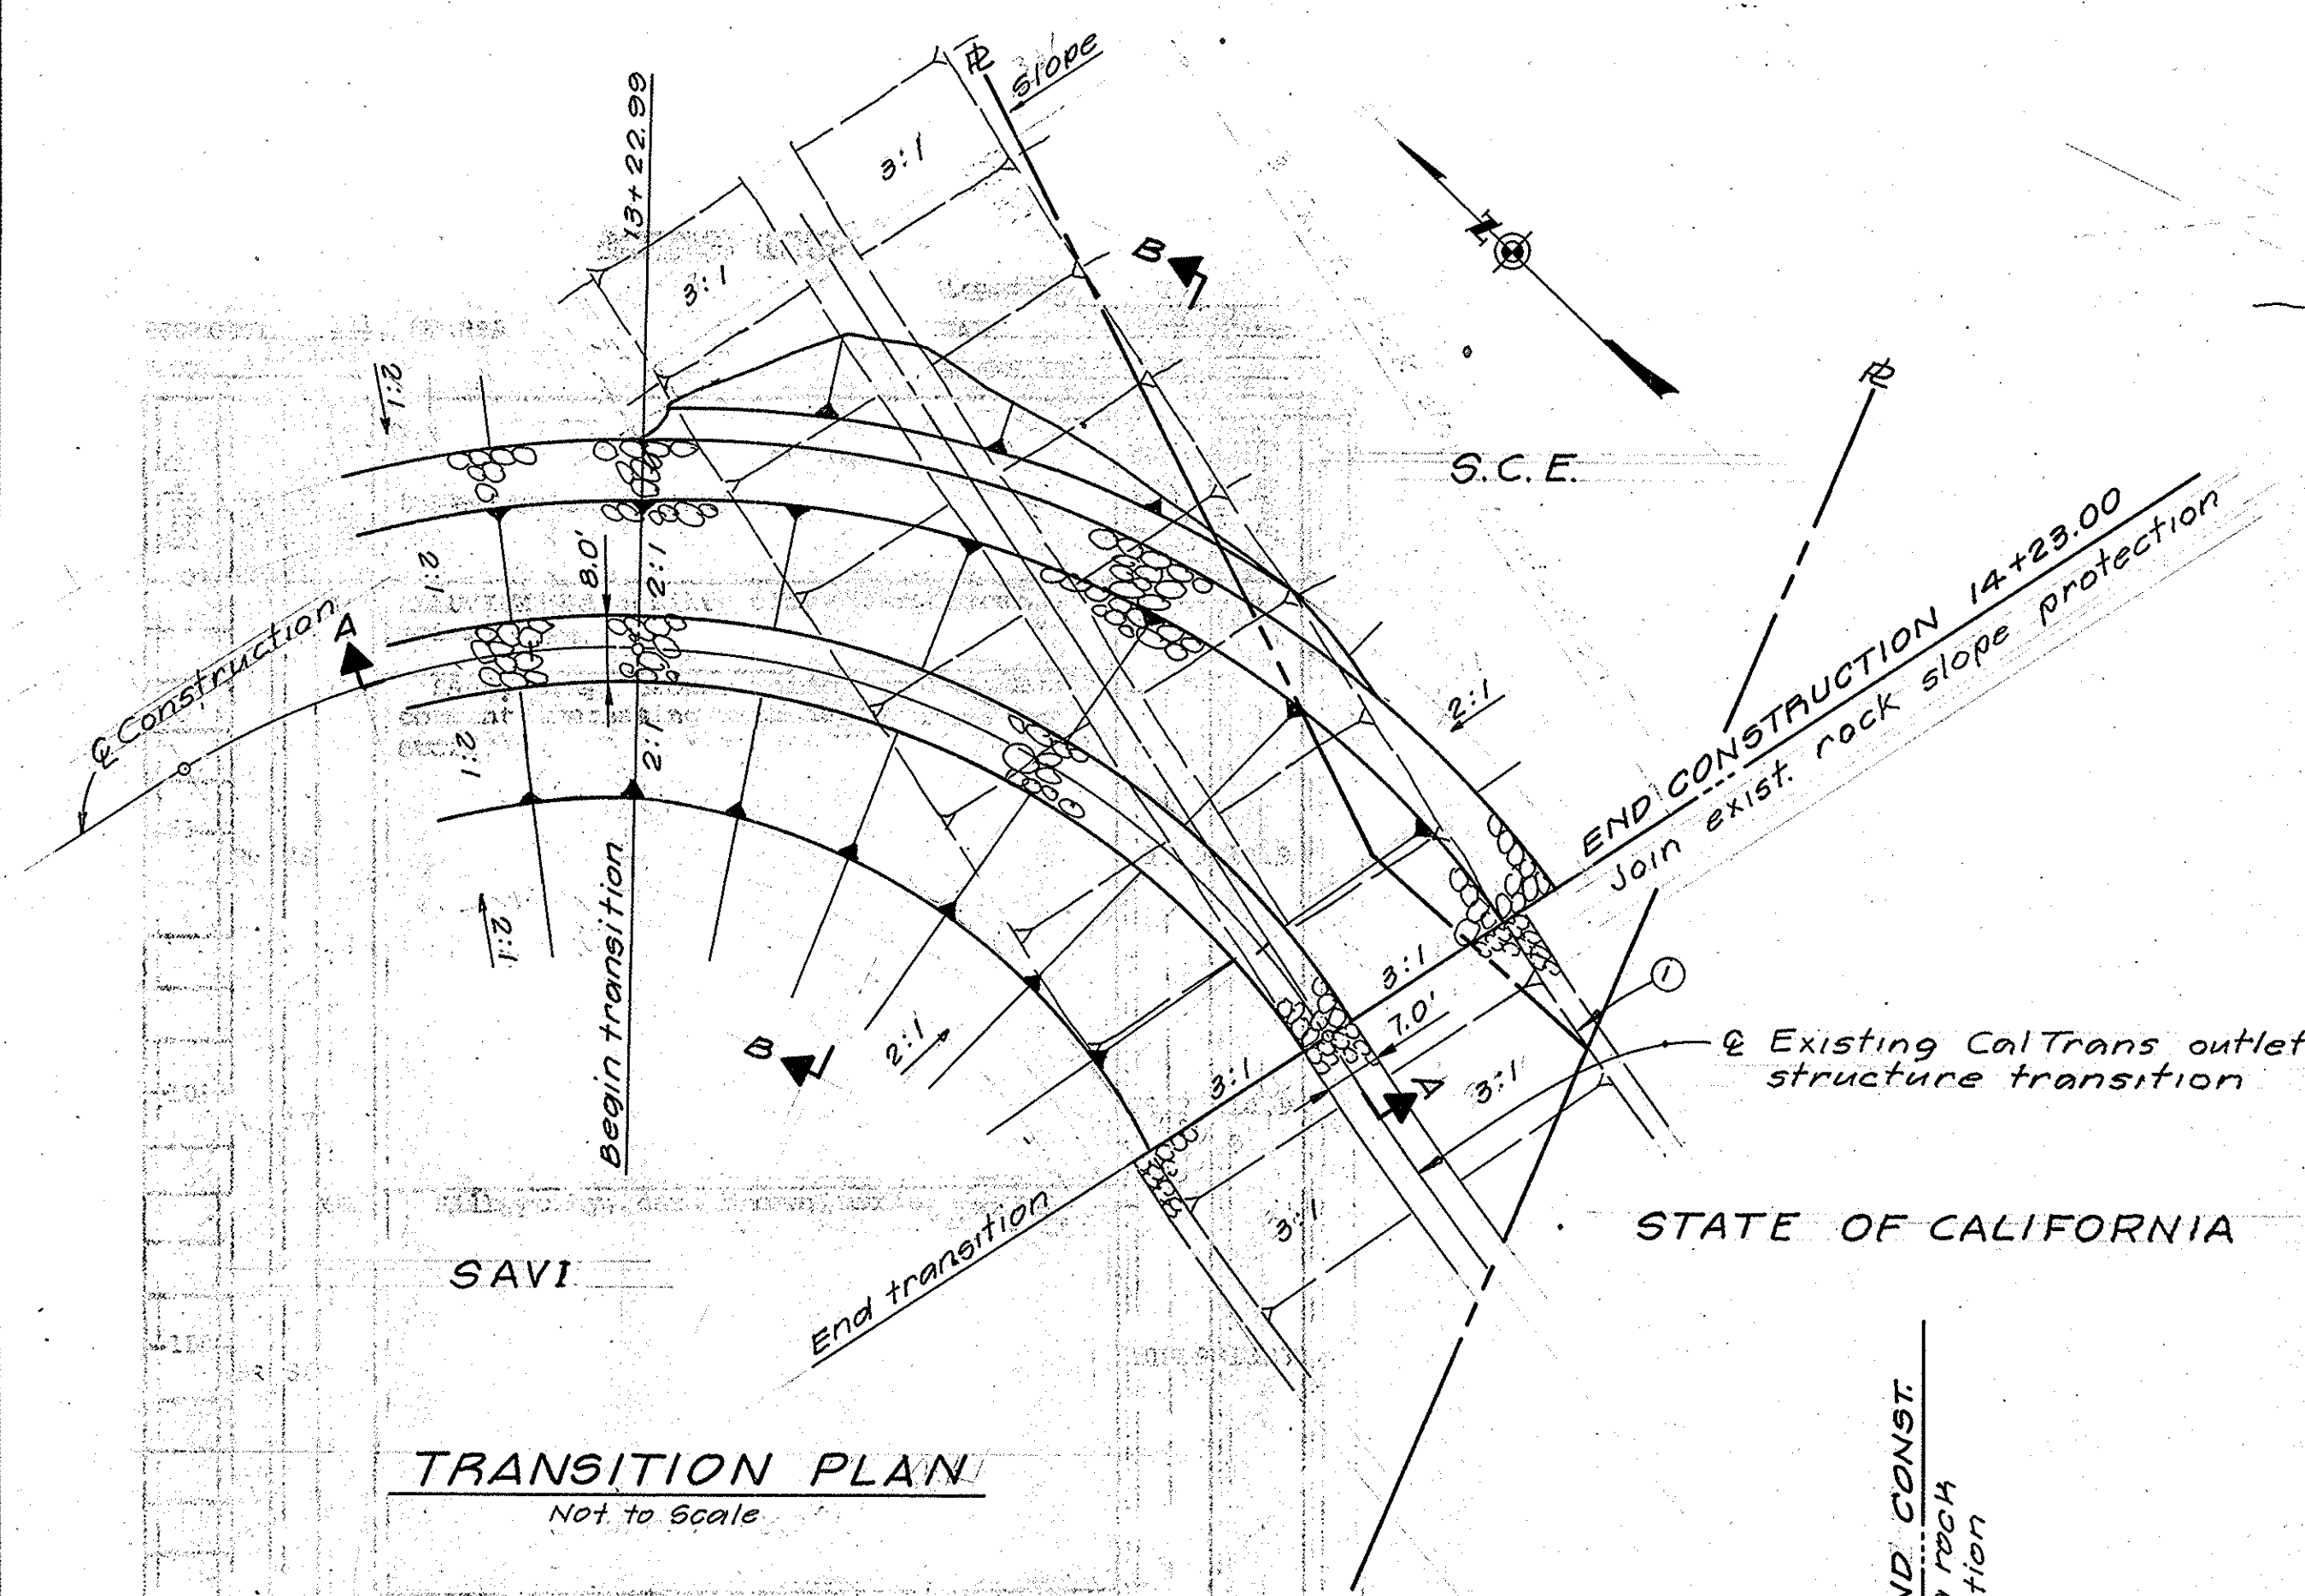

- CONSTRUCTION NOTES**
- ④ For height of dike on slope protection, see Profile, sht. W-1
 - ⑤ Place 1.80' of Type II stone protection.
 - ⑥ Place 0.5' of gravel material.
 - ⑦ Place plastic filter fabric.
 - ⑧ Place 2.80' of Type III stone protection.

- LEGEND**
- ① Protect
 - ③ Remove

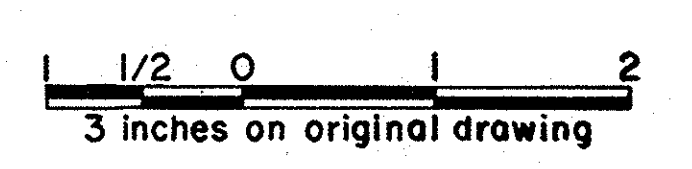

		ORANGE COUNTY ENVIRONMENTAL MANAGEMENT AGENCY	
		EOIP53-701-1	
		WEIR CANYON ROAD	
		WEST DRAIN	
		PLAN, SECTIONS AND DETAILS	
MARK	DATE	DESCRIPTION	PREPARED UNDER SUPERVISION OF <i>John W. Palmer</i>
		REVISIONS	DATE
DESIGNED	M.H.M.	SCALE	DATE
DRAWN	B.Y.I. W.G.W.	CHECKED	J.W.P.
		AS SHOWN	AUG. '82
		DWG. NO.	EOIP53-701-1
		SHEET	3
		OF	7