




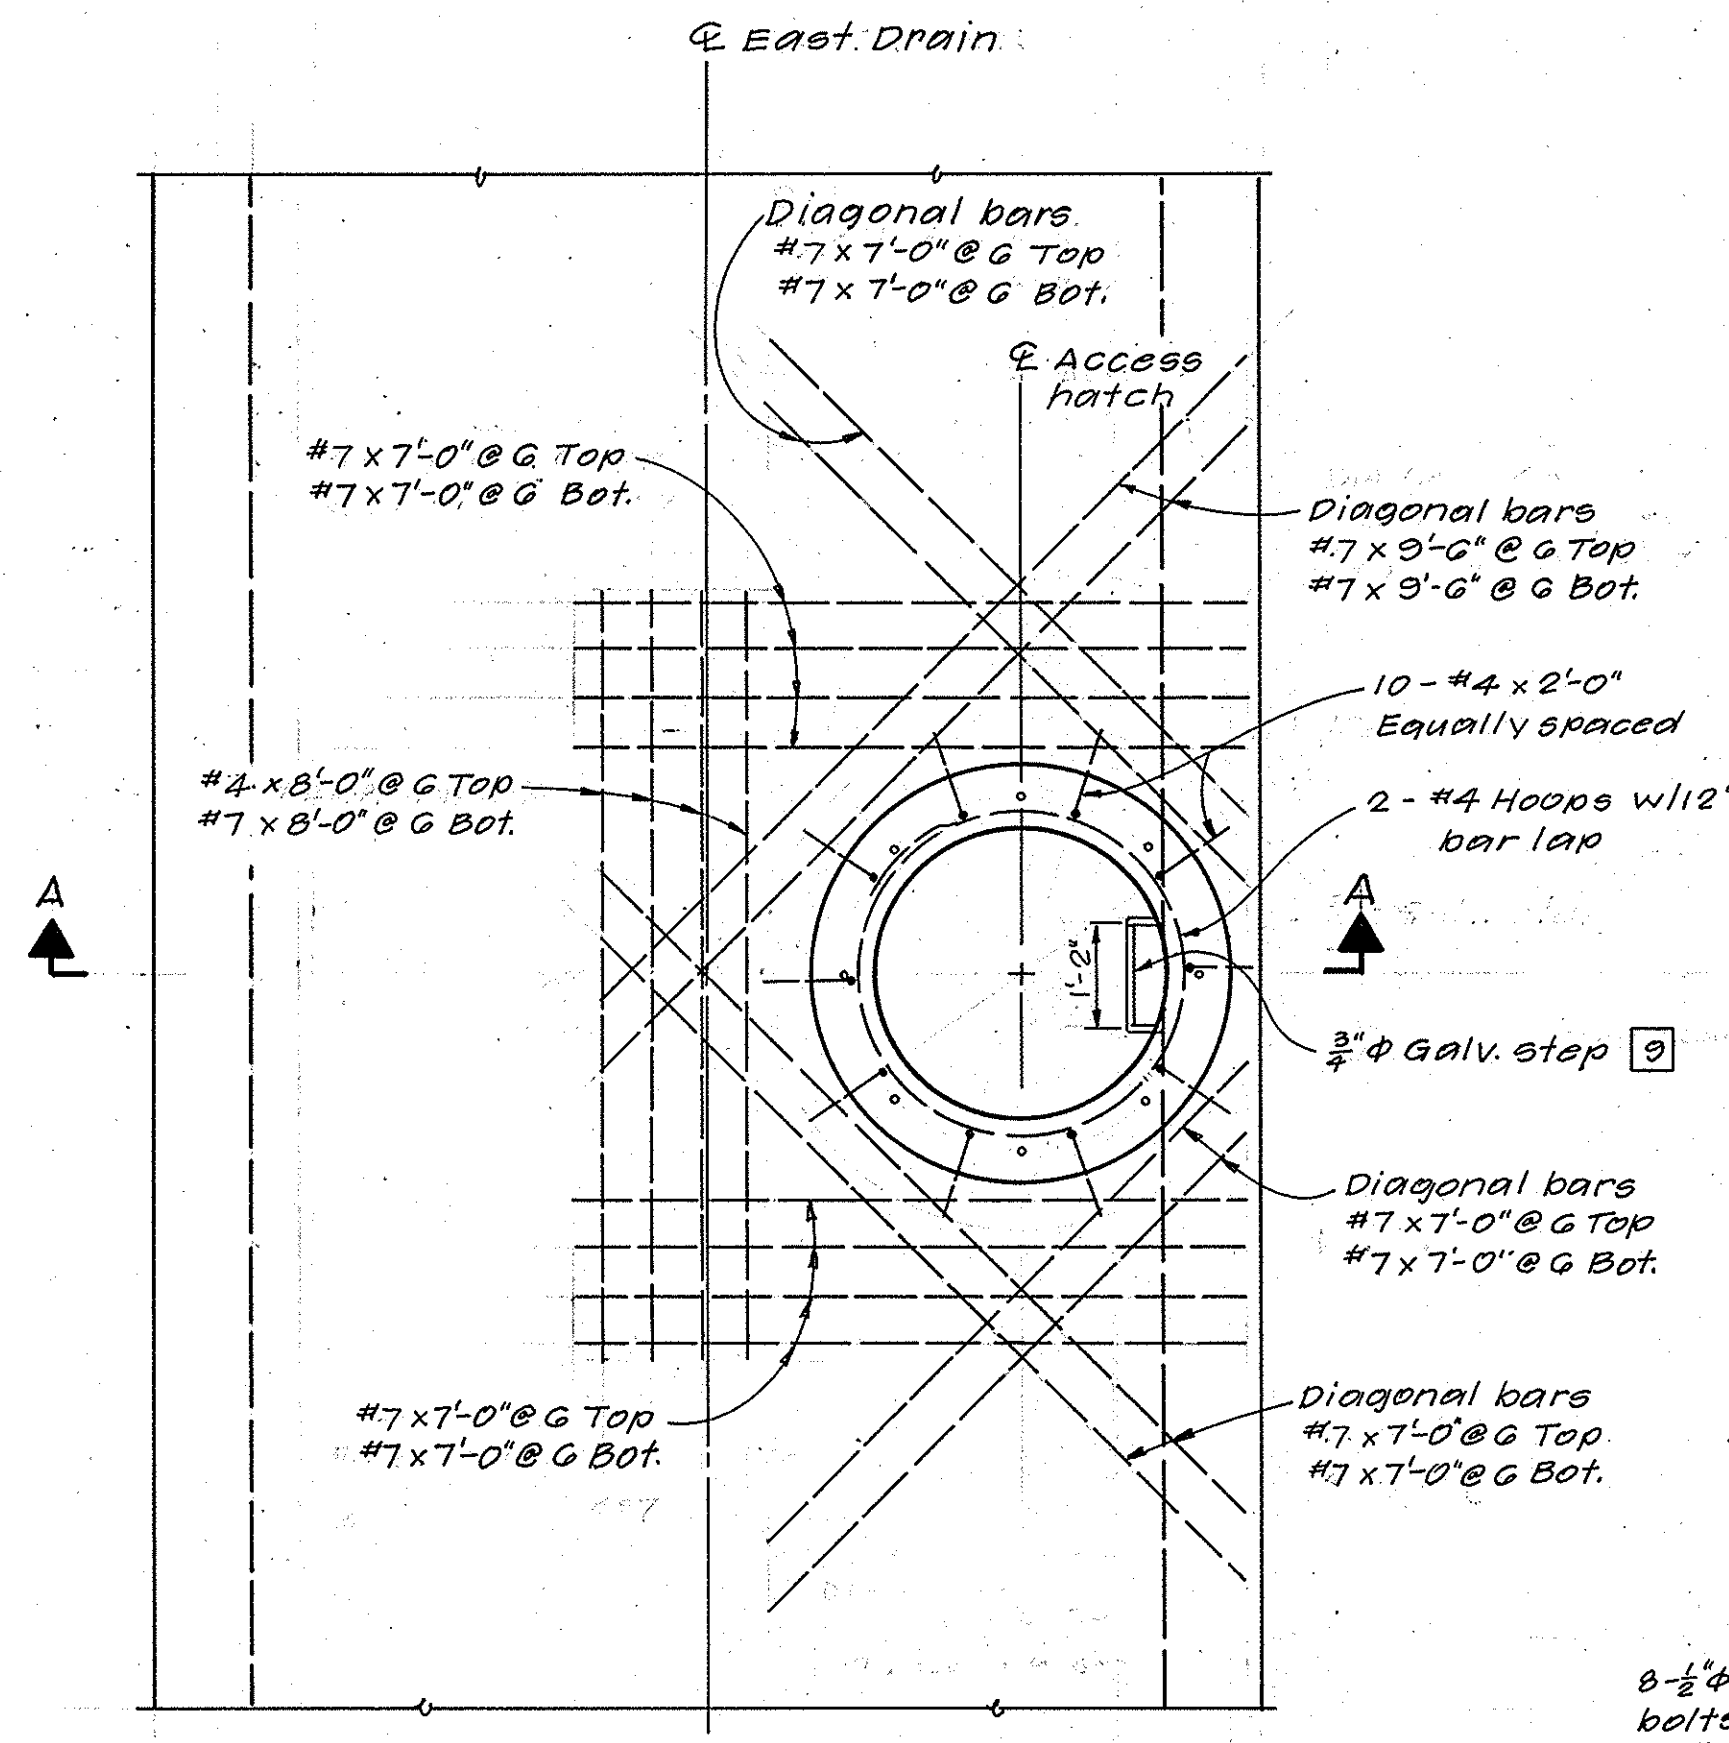


PLAN
Scale: $\frac{1}{2}'' = 1'-0''$

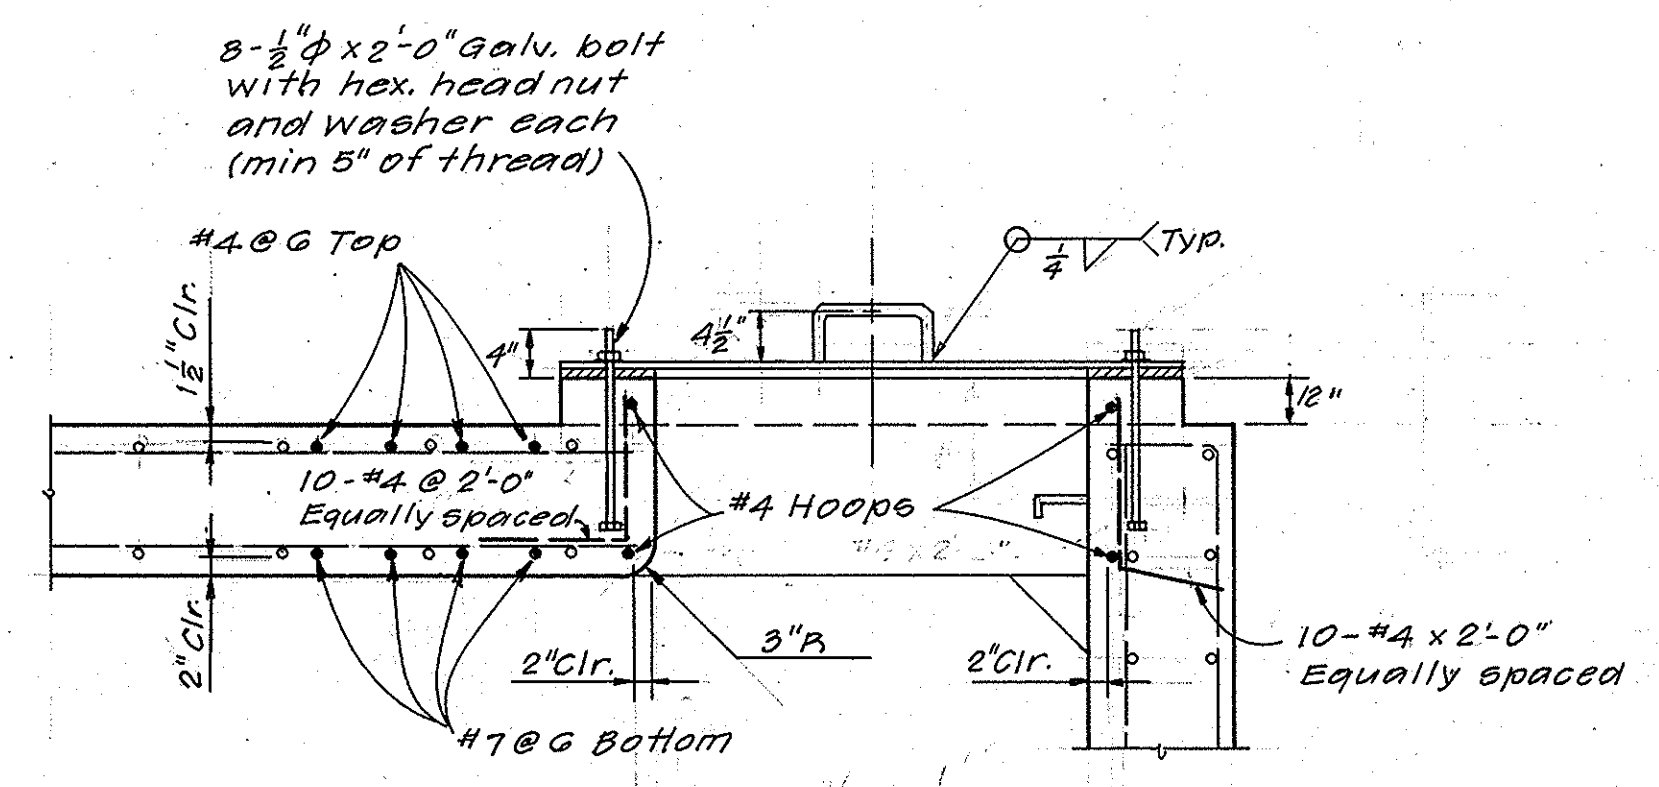


DETAIL T
Scale: $\frac{3}{4}'' = 1'-0''$

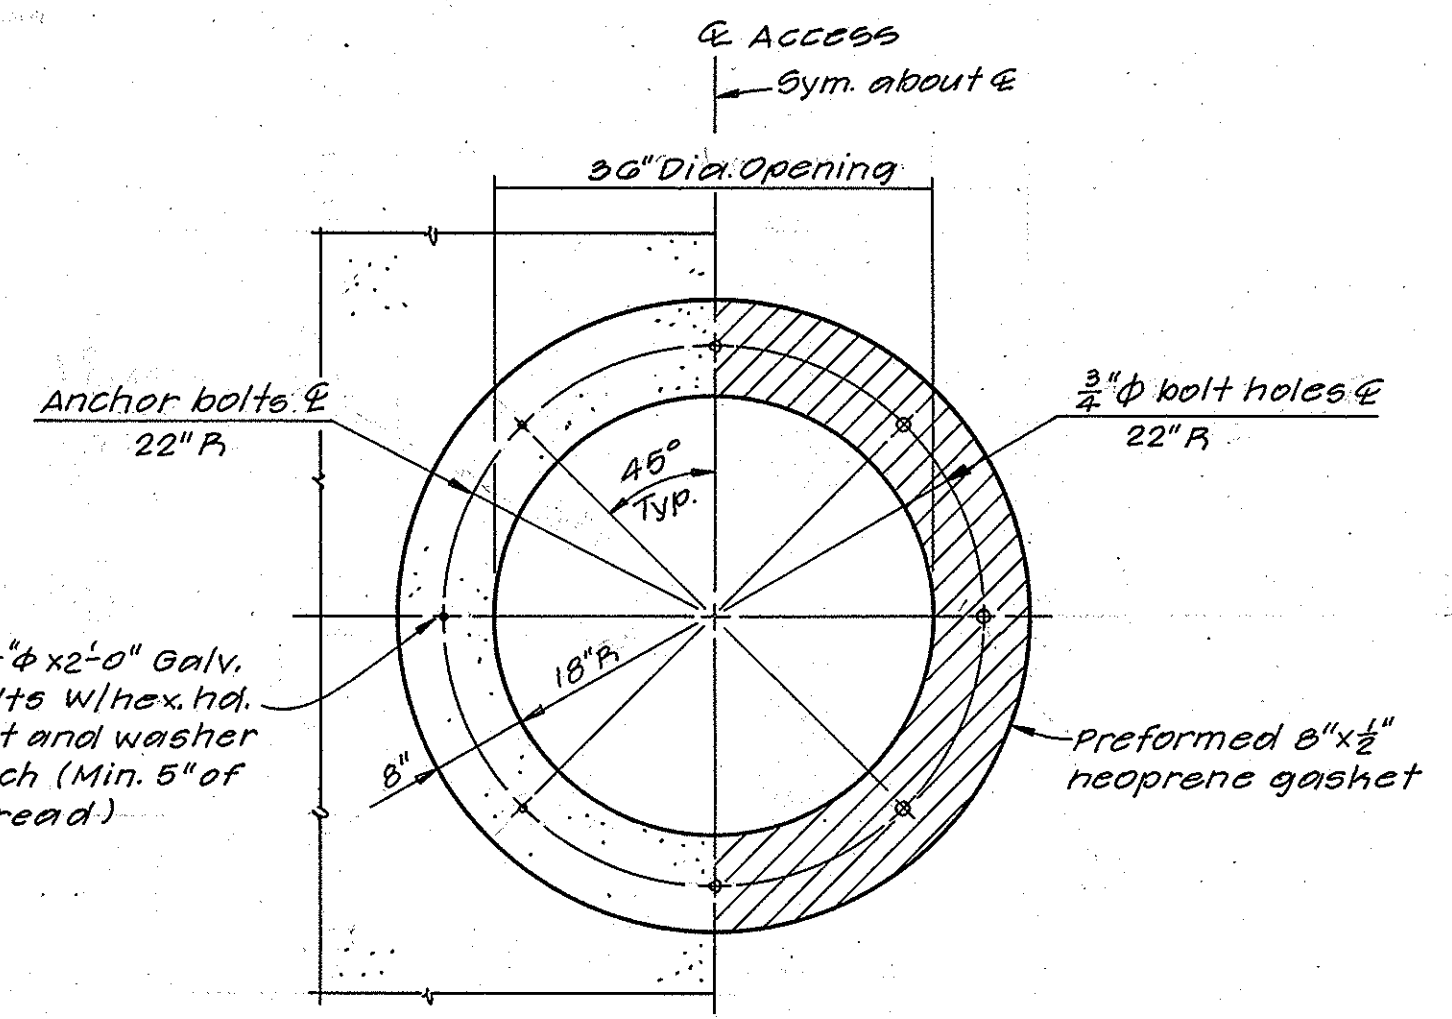

ACCESS AND GASKET PLAN
Scale: $\frac{3}{4}'' = 1'-0''$

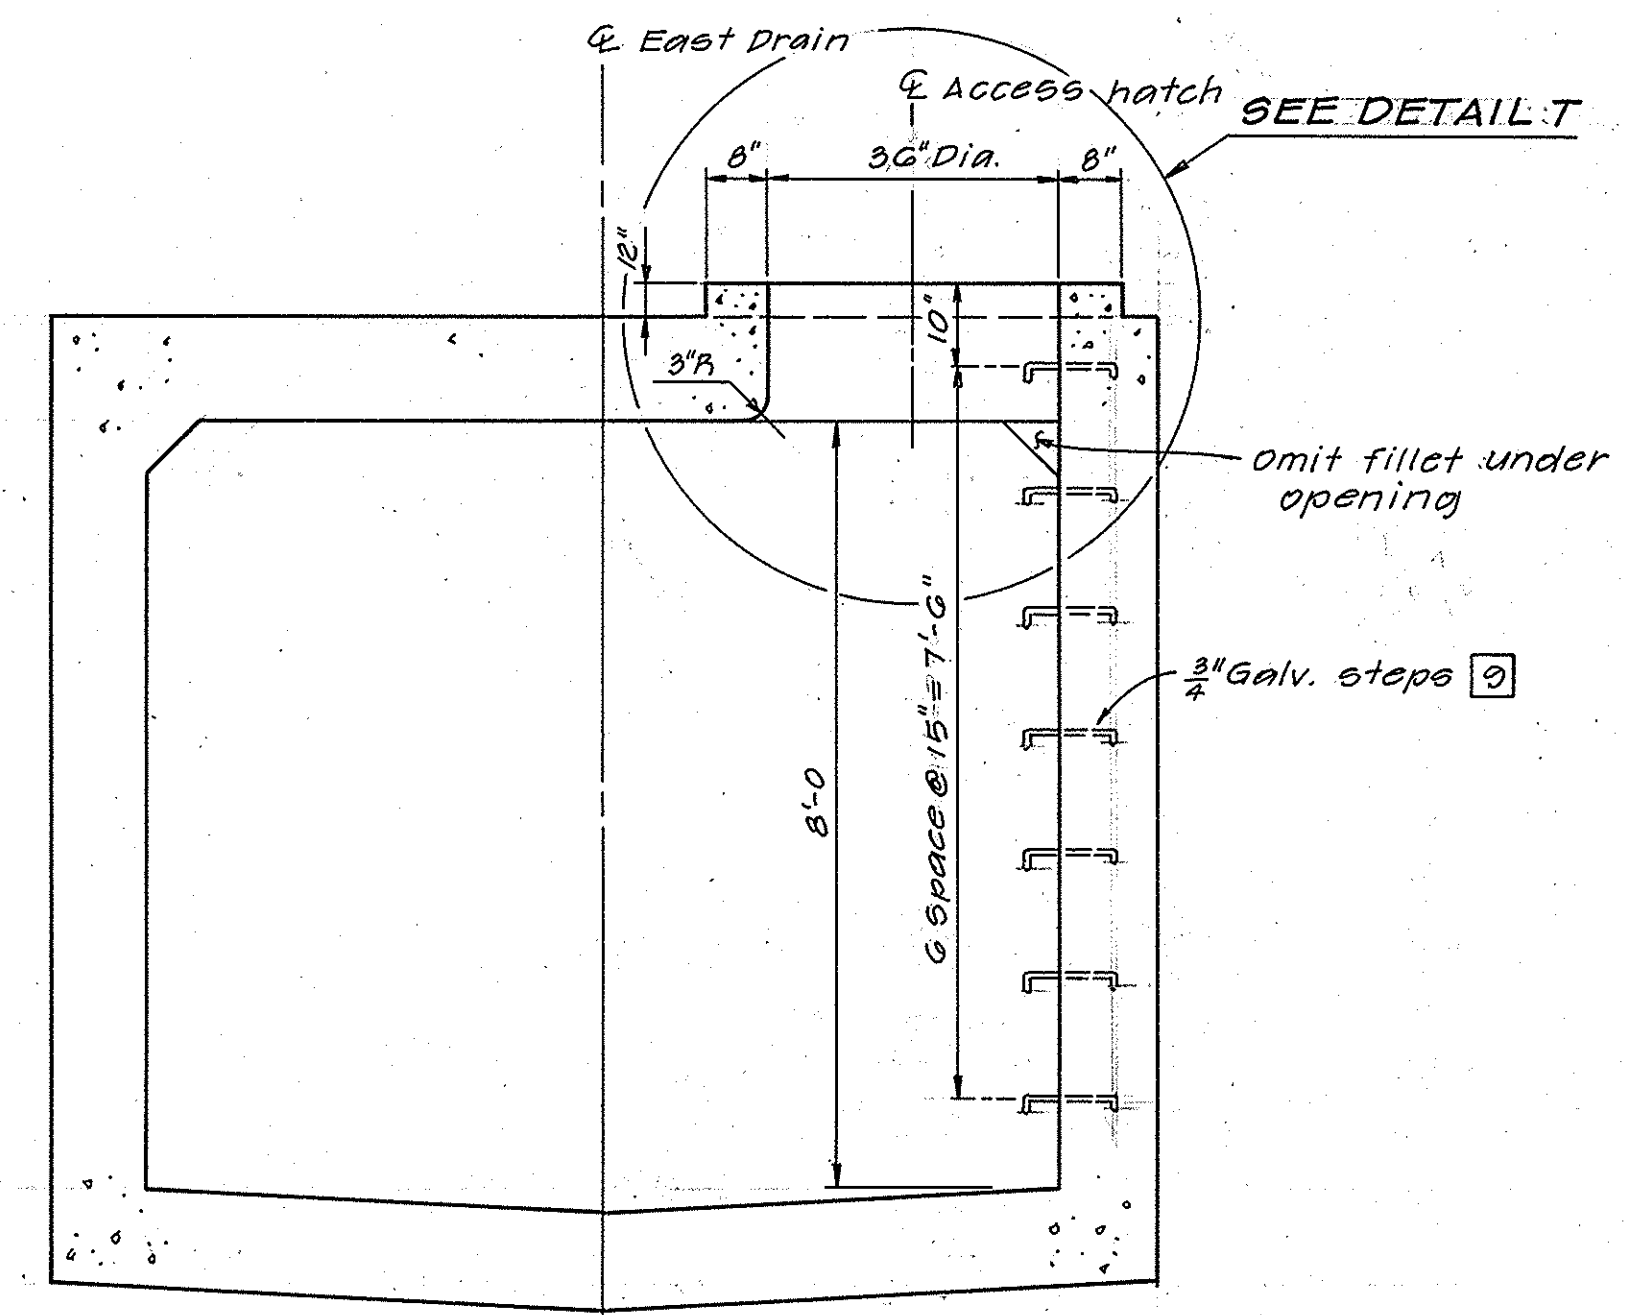


SECTION A-A
Scale: $\frac{1}{2}'' = 1'-0''$

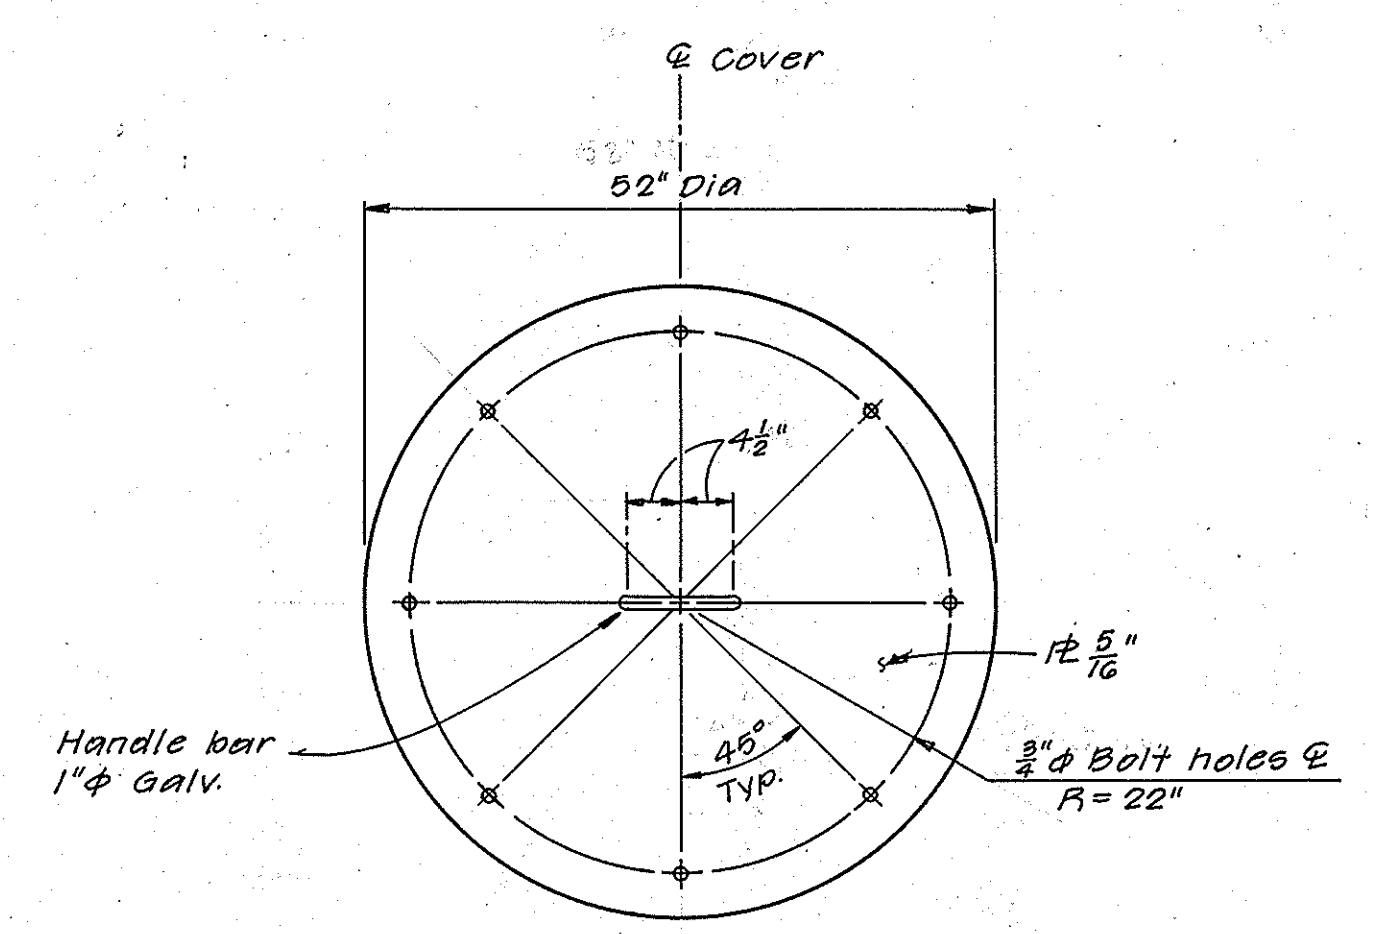


COVER DETAIL
Scale: $\frac{3}{4}'' = 1'-0''$

ACCESS HATCH


Note: Normal P.C.B. reinforcement not shown in Plan or Section A-A, see sheet

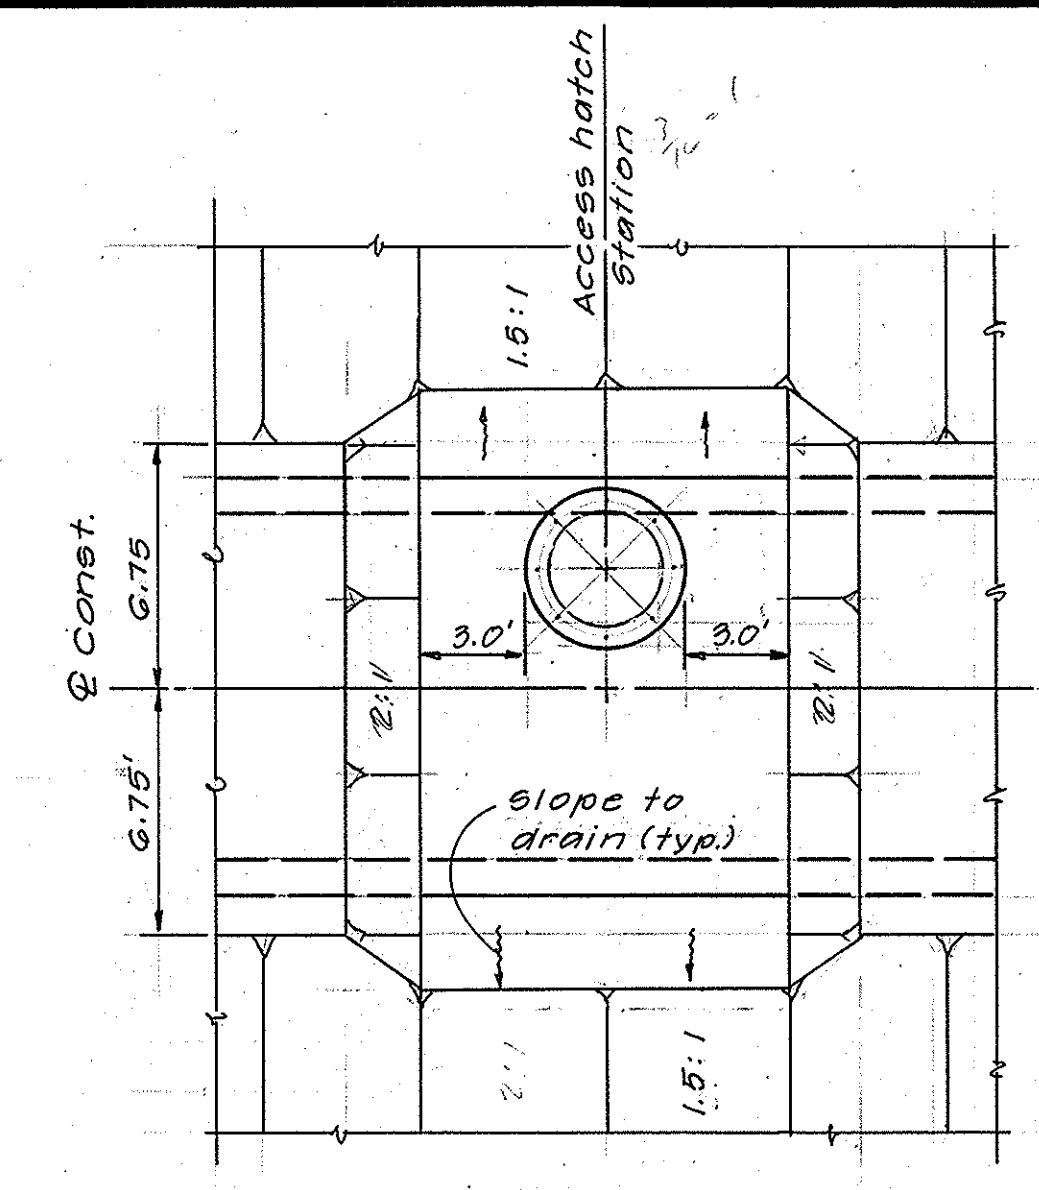

STA. 8+00
STA. 13+85

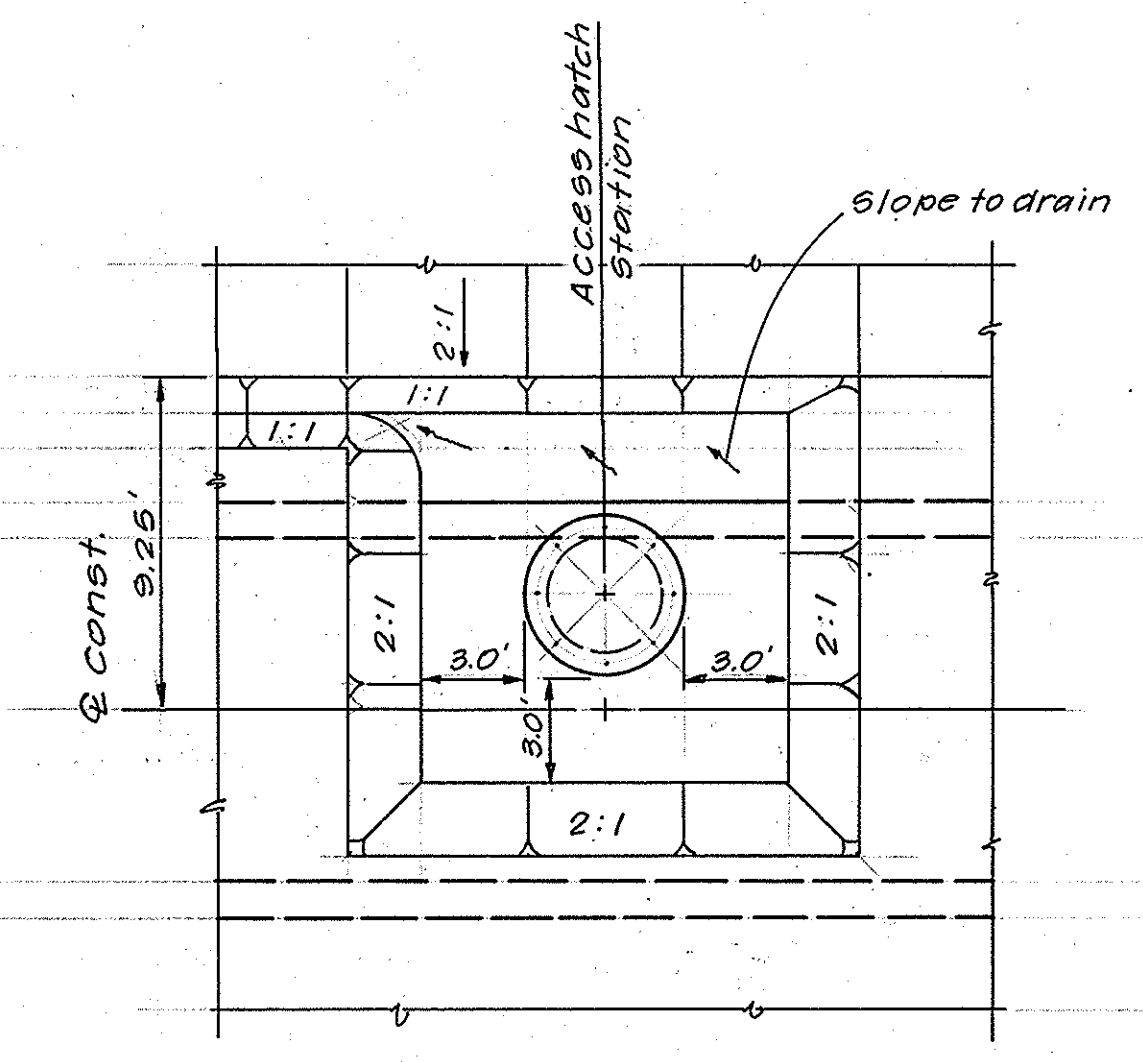

STA. 20+00

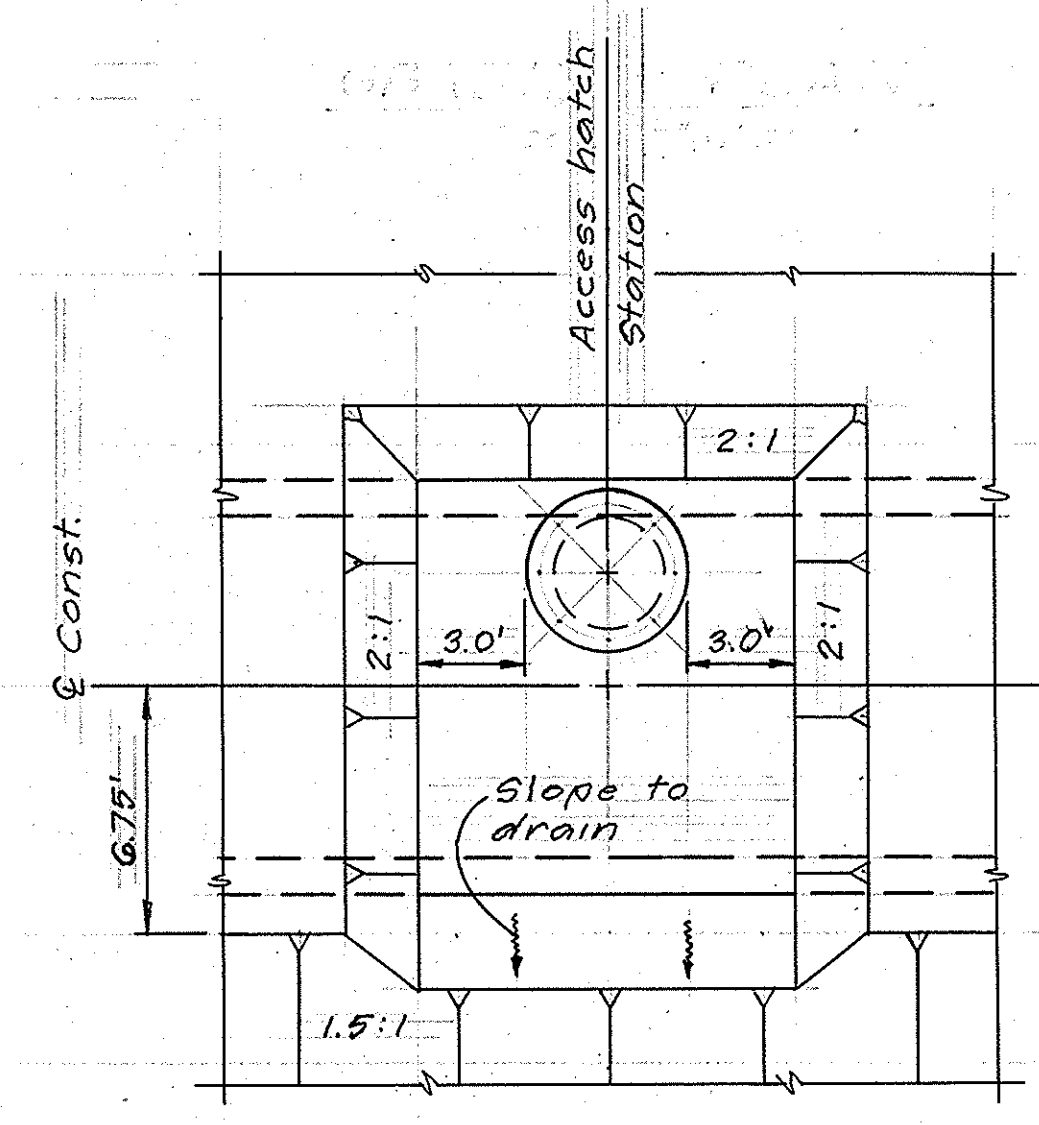

STA. 23+10
GRADING PLAN
Scale: $\frac{3}{16}'' = 1'-0''$

CONSTRUCTION NOTES

9 For construction details of manhole steps, see O.C.E.M.A. Std. Plan No. 507

1 1/2 0 1 2
3 inches on original drawing

ORANGE COUNTY ENVIRONMENTAL MANAGEMENT AGENCY			
EOIP 54-701-1			
WEIR CANYON ROAD			
EAST DRAIN			
ACCESS HATCH DETAILS			
MARK	DATE	DESCRIPTION	PREPARED UNDER SUPERVISION OF <i>John W. Pulver</i>
REVISIONS			DATE
DESIGNED	B.A.B.	SCALE	DATE
DRAWN	B.Y.I.	CHECKED	J.W.P.
AS SHOWN			DATE
AUG. 82			DWG. NO.
EOIP 54-701-1			SHEET
			E-7
			OF 11