


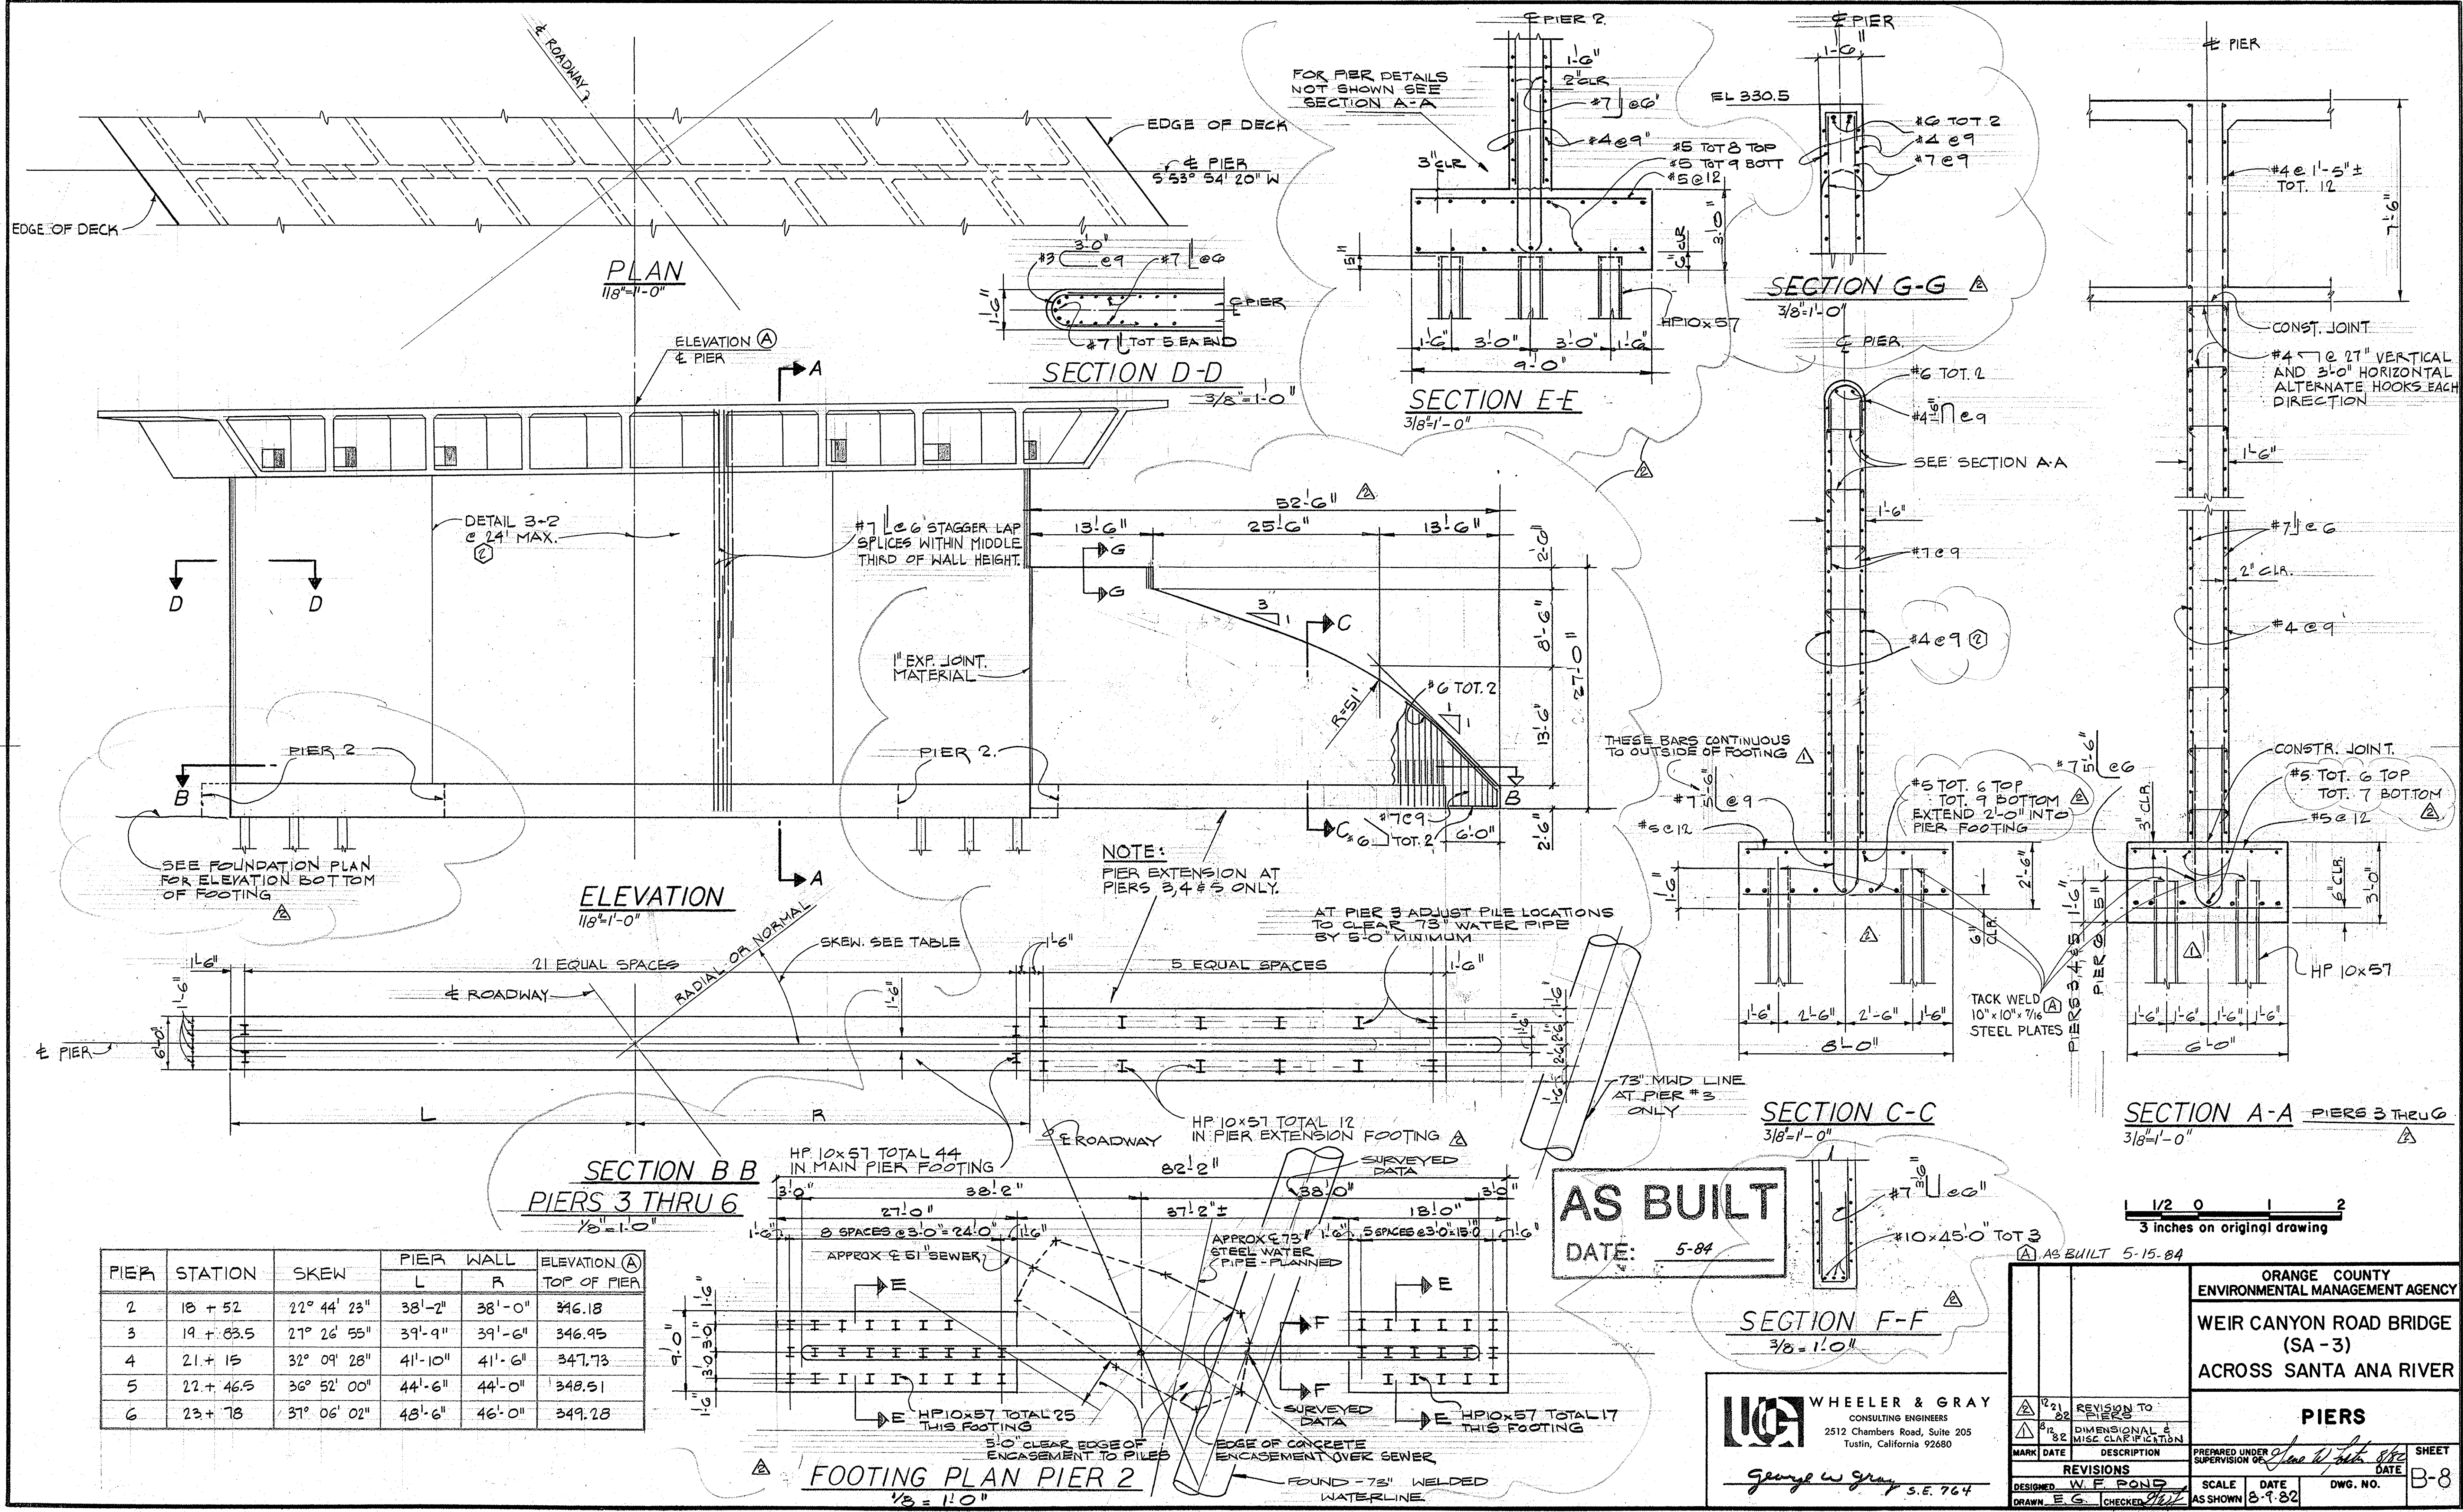

AS BUILT
DATE: 5-84

WHEELER & GRAY
CONSULTING ENGINEERS
2512 Chambers Road, Suite 205
Tustin, California 92680
George W. Gray S.E. 764

ORANGE COUNTY ENVIRONMENTAL MANAGEMENT AGENCY			
WEIR CANYON ROAD BRIDGE (SA-3) ACROSS SANTA ANA RIVER			
PIERS			
DESIGNED W.F. PONG	CHECKED E.G.	DATE 8-9-82	SHEET B-8