



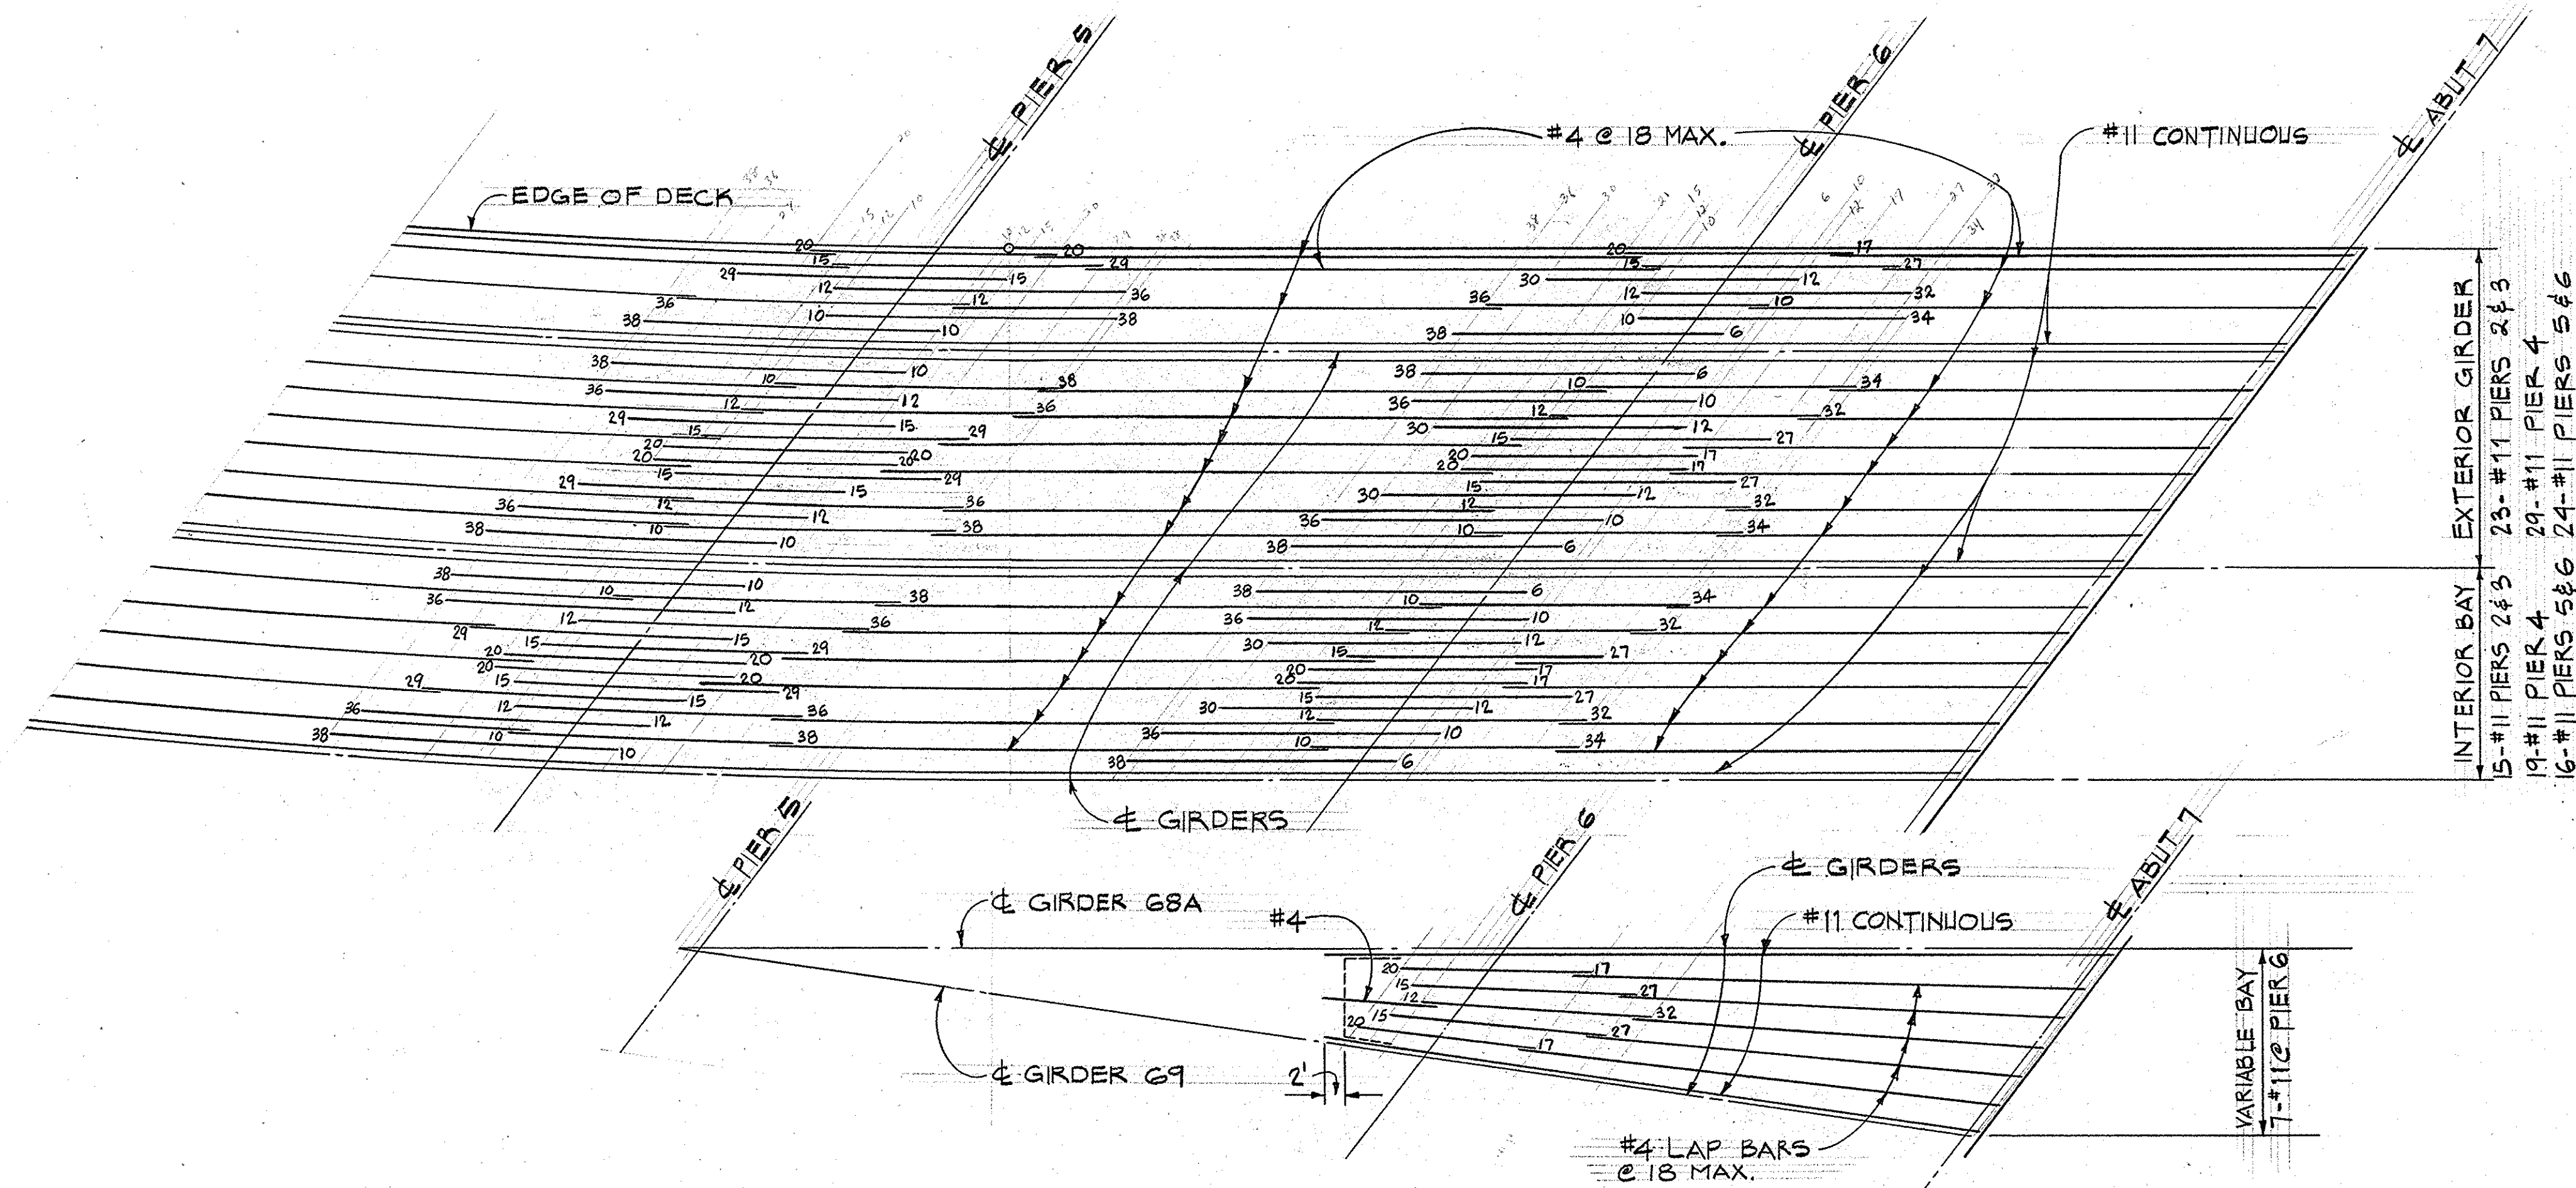

TOP REINFORCEMENT

HORIZ. 1" = 20'
VERT. 1" = 5'

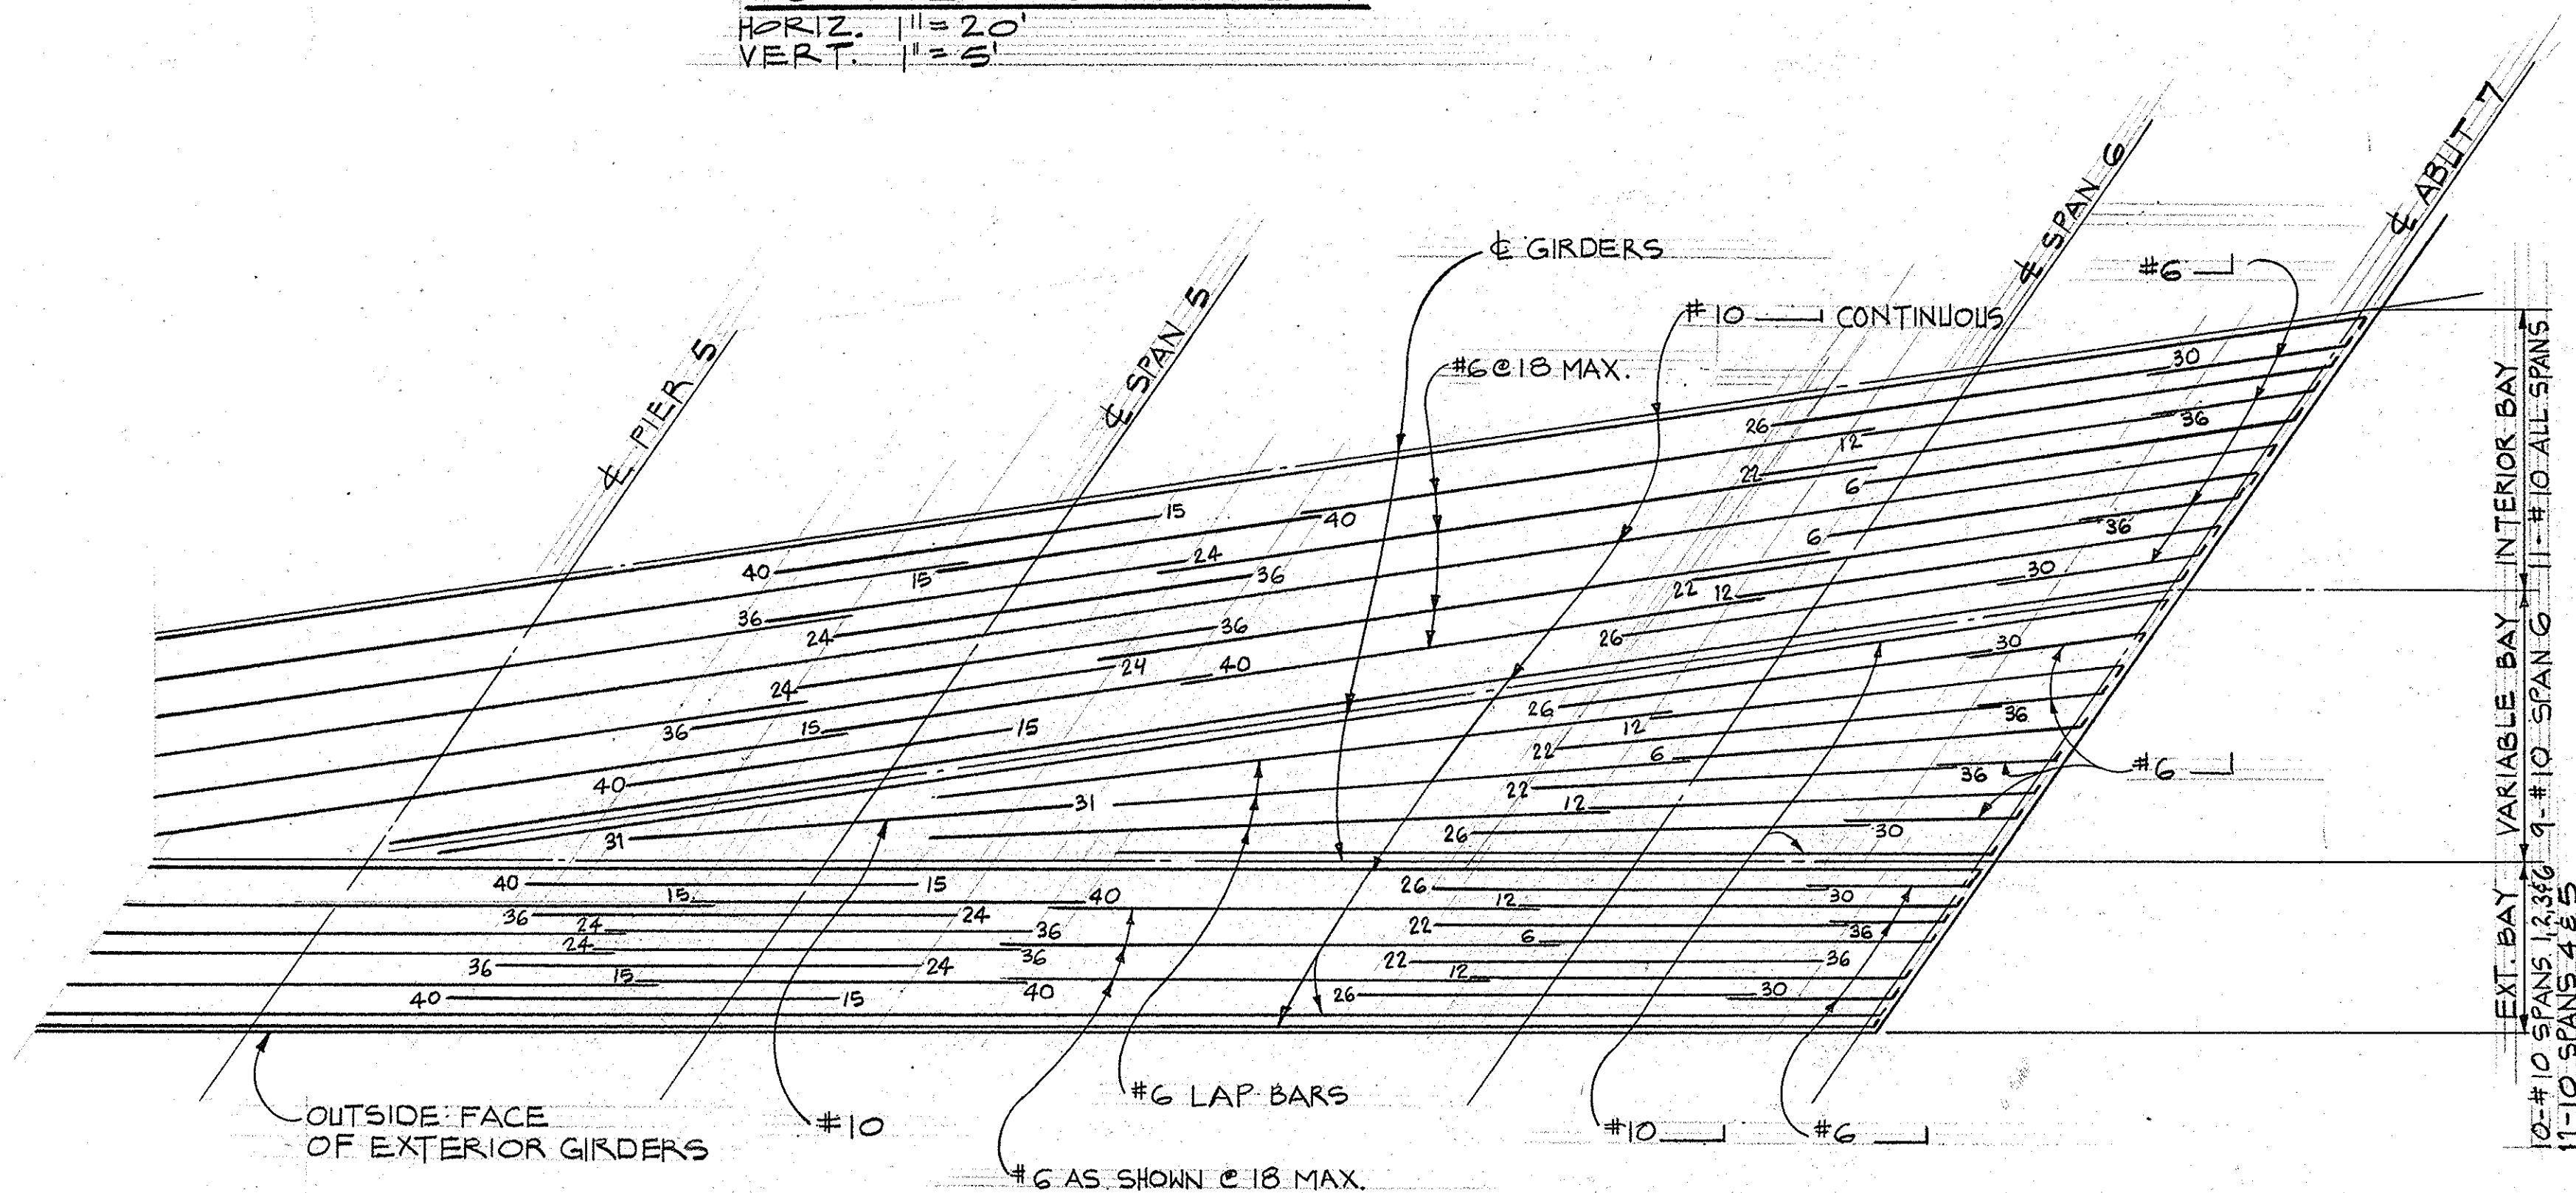

BOTTOM REINFORCEMENT

HORIZ. 1" = 20'
VERT. 1" = 5'

1 1/2 0 1 2
3 inches on original drawing

AS BUILT

DATE: 5-84

WHEELER & GRAY
CONSULTING ENGINEERS
2512 Chambers Road, Suite 205
Tustin, California 92680

George W. Gray S.E. 764

ORANGE COUNTY
ENVIRONMENTAL MANAGEMENT AGENCY
WEIR CANYON ROAD BRIDGE
(SA-3)
ACROSS SANTA ANA RIVER

**GIRDER
REINFORCEMENT 2**

MARK	DATE	DESCRIPTION	PREPARED UNDER SUPERVISION OF	DATE	SHEET
DESIGNED	W.F. POND	SCALE	DATE	DWG. NO.	B-12
DRAWN	E.G.	CHECKED	AS SHOWN	8-9-82	