




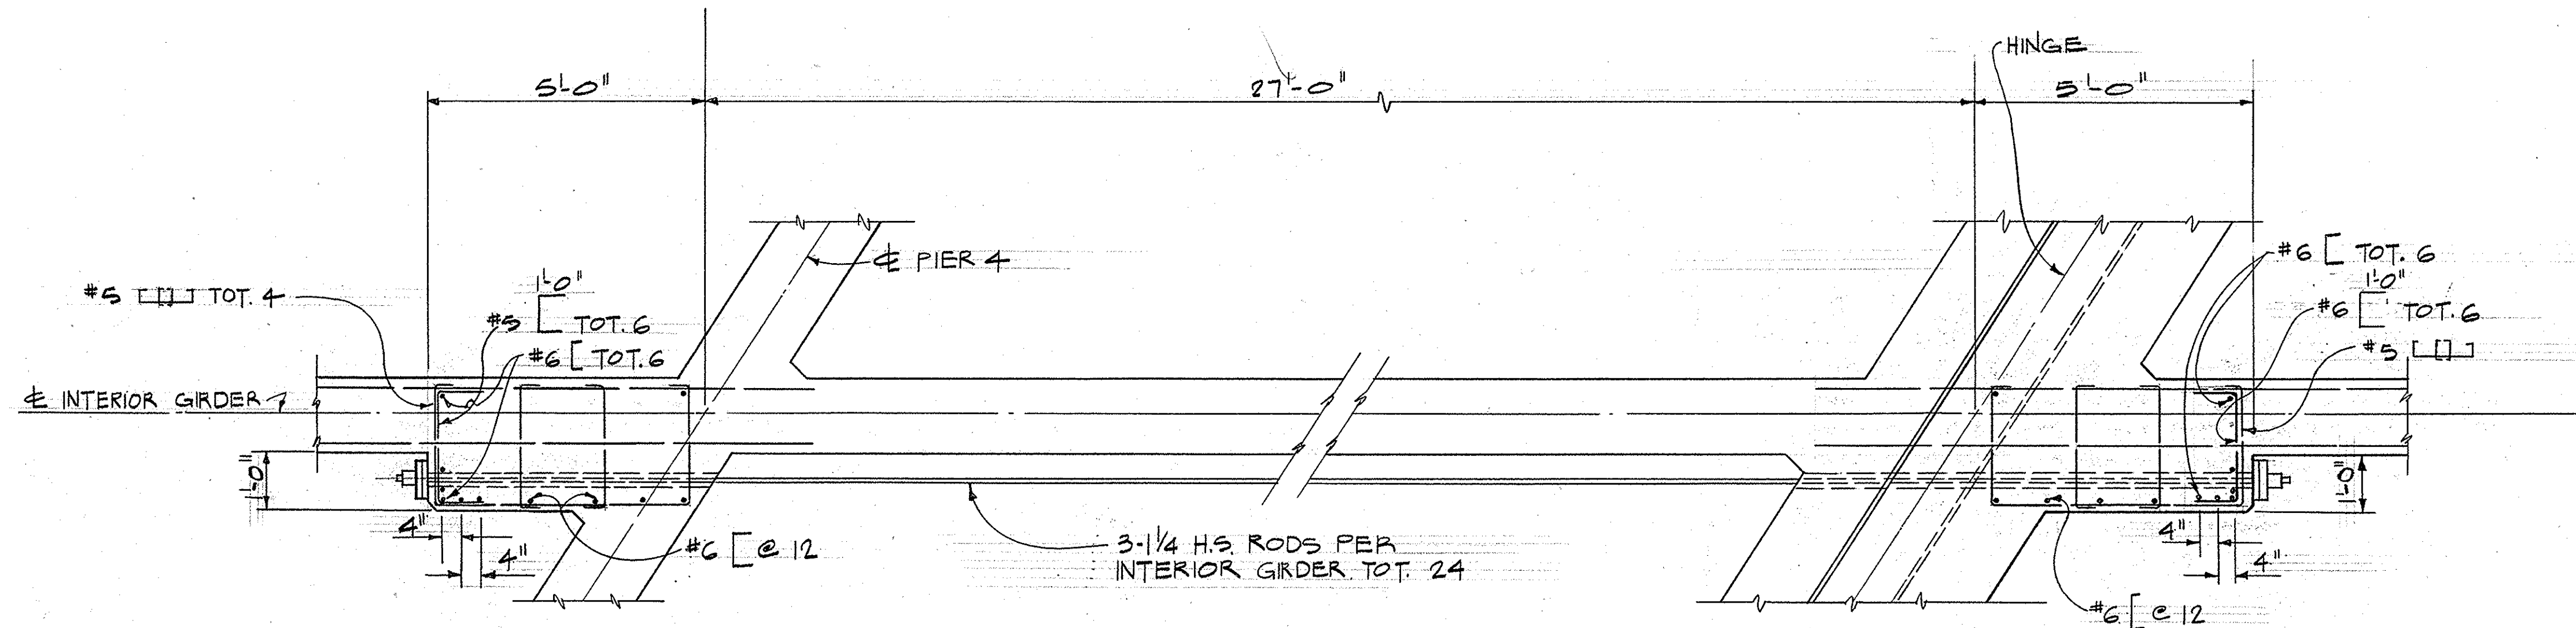

PLAN
1/2"=1'-0"

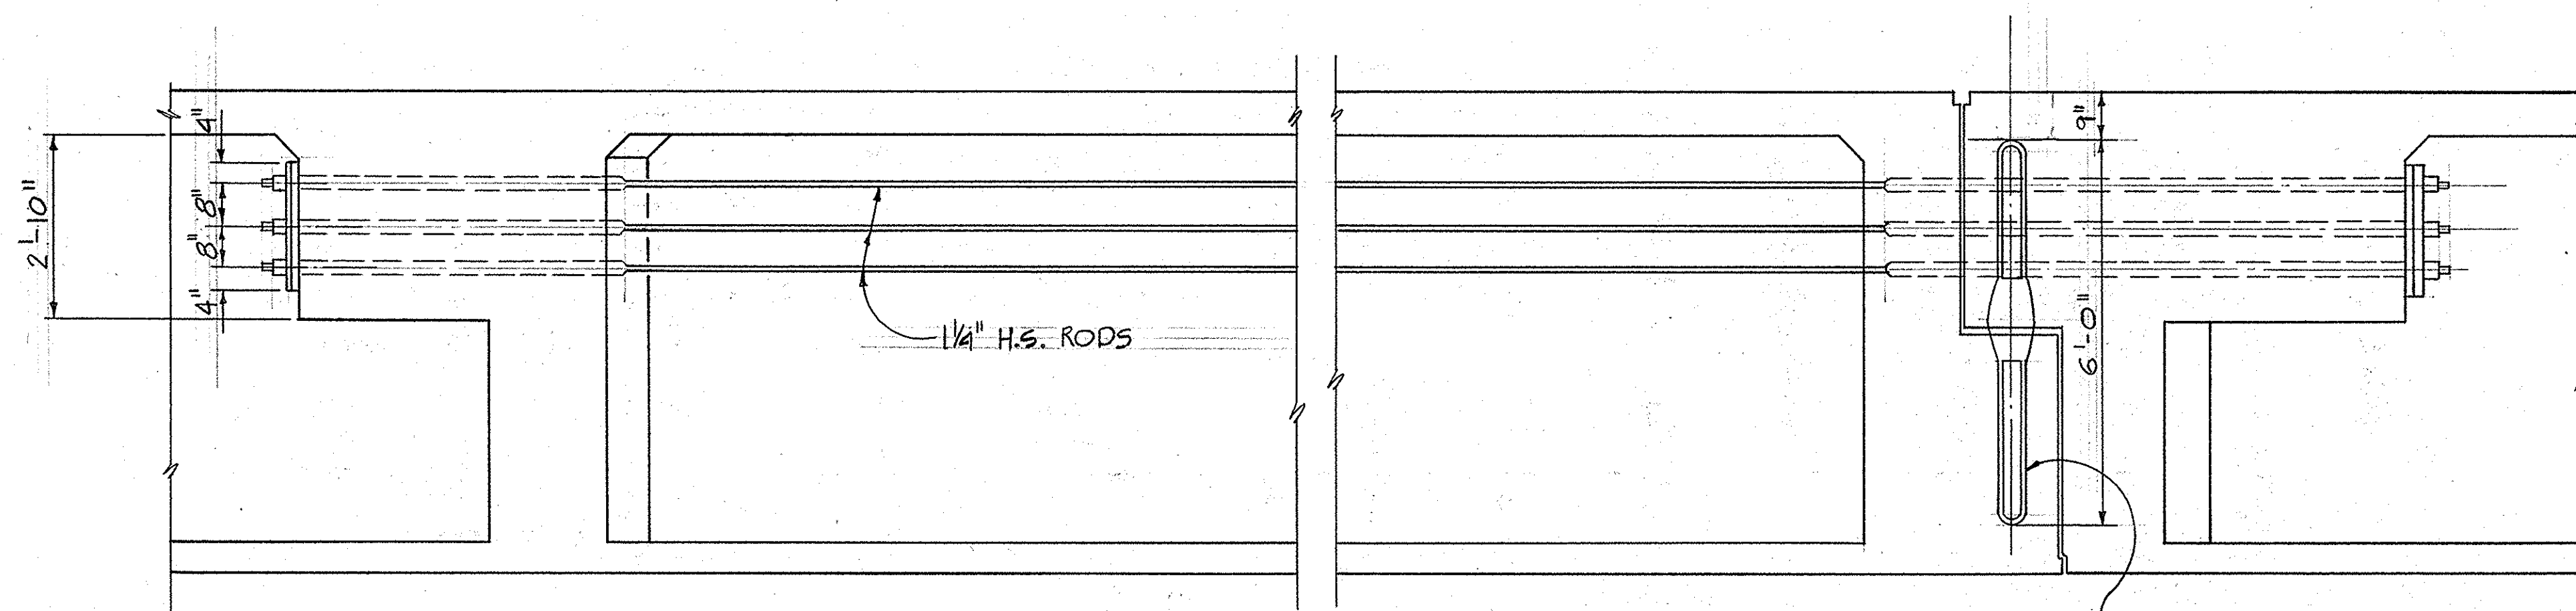


ELEVATION
1/2"=1'-0"

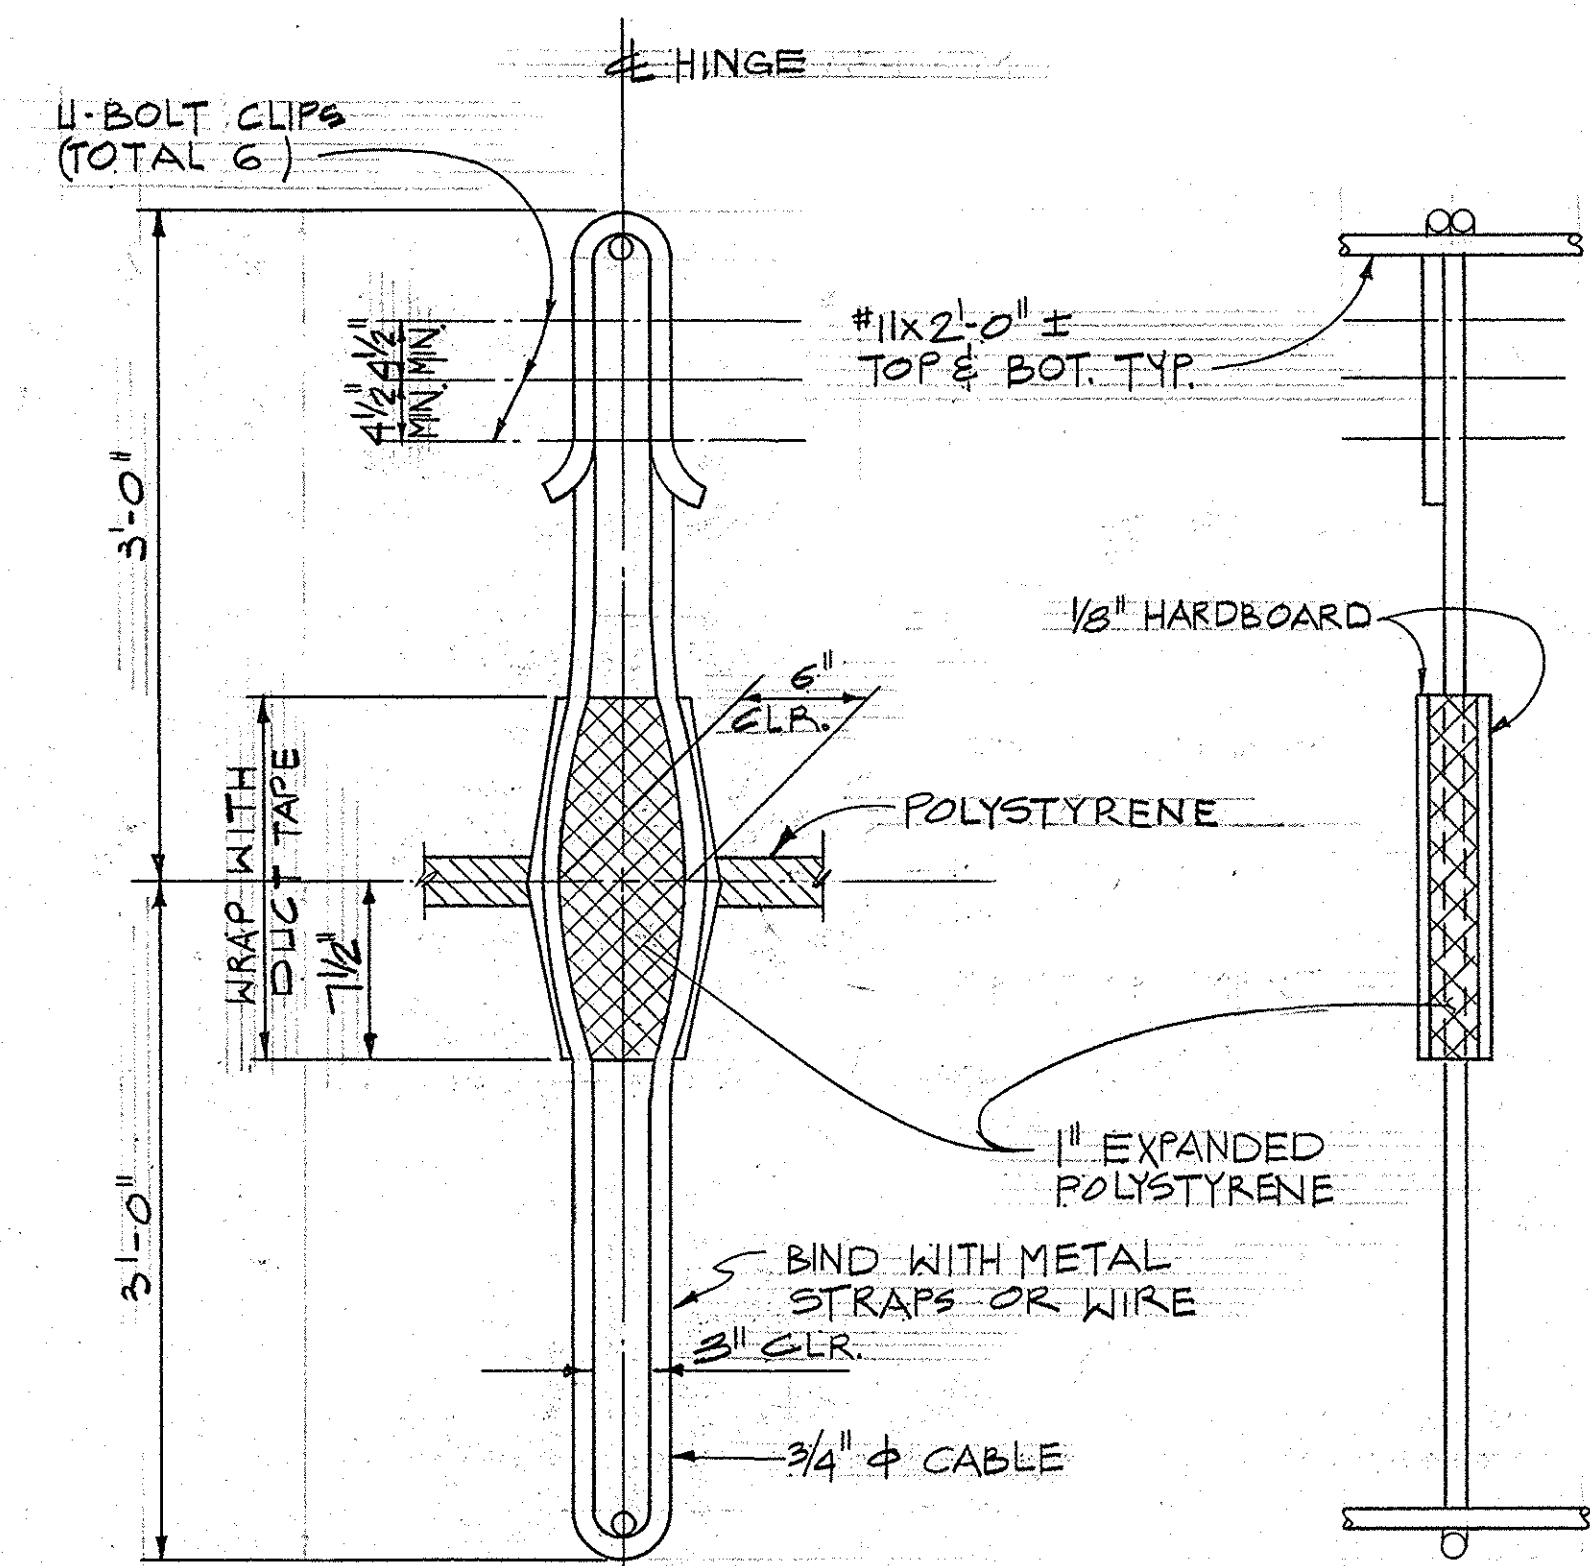

ELEVATION

SECTION

VERTICAL RESTRAINER
NO SCALE

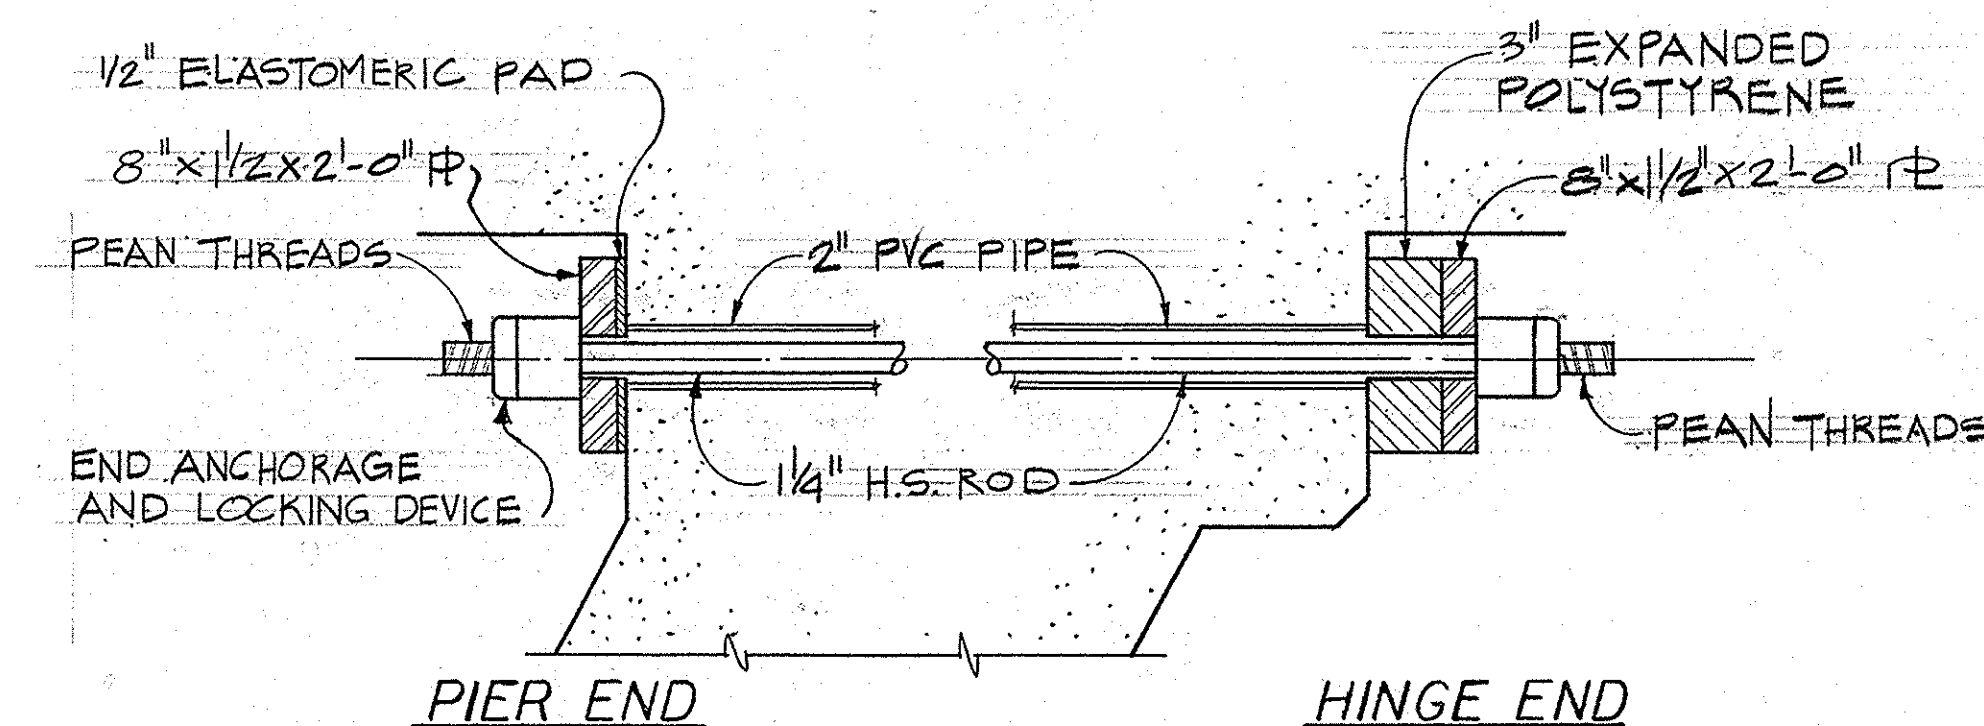

BAR DETAIL
1/2"=1'-0"

NOTES

1. ALL STEEL PARTS TO BE GALVANIZED.
2. SEE ABUTMENTS FOR LOCATION AND SIZE OF ADDITIONAL VERTICAL RESTRAINER.

1 1/2 0 1 2
3 inches on original drawing

AS BUILT
DATE: 5-84

WHEELER & GRAY
CONSULTING ENGINEERS
2512 Chambers Road, Suite 205
Tustin, California 92680
George W. Gray
S.E. 764

ORANGE COUNTY ENVIRONMENTAL MANAGEMENT AGENCY			
WEIR CANYON ROAD BRIDGE (SA-3) ACROSS SANTA ANA RIVER			
RESTRAINER DETAILS			
MARK	DATE	DESCRIPTION	PREPARED UNDER SUPERVISION OF
DESIGNED	W.F. POND	SCALE	DATE
DRAWN	E.G.	CHECKED	AS SHOWN
			DWG. NO.
			B-14