
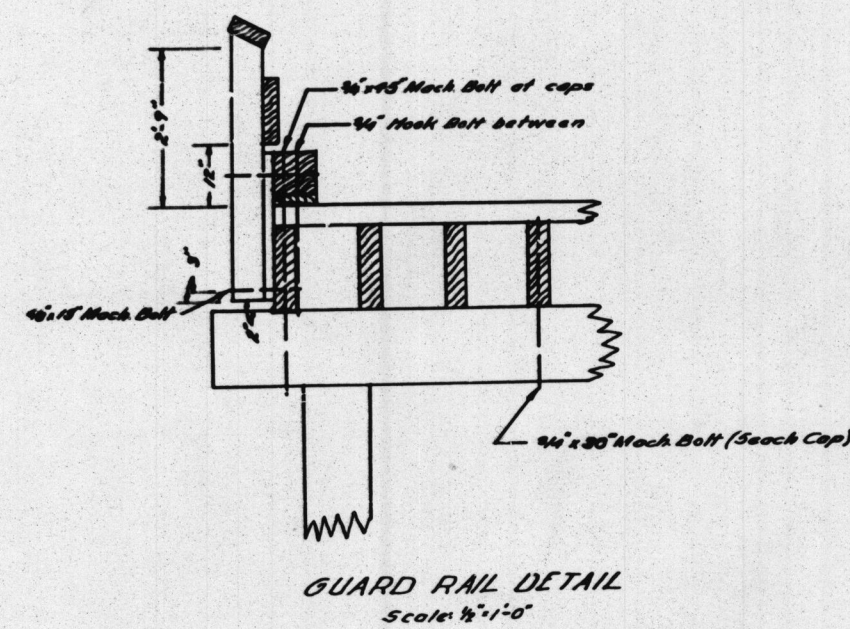
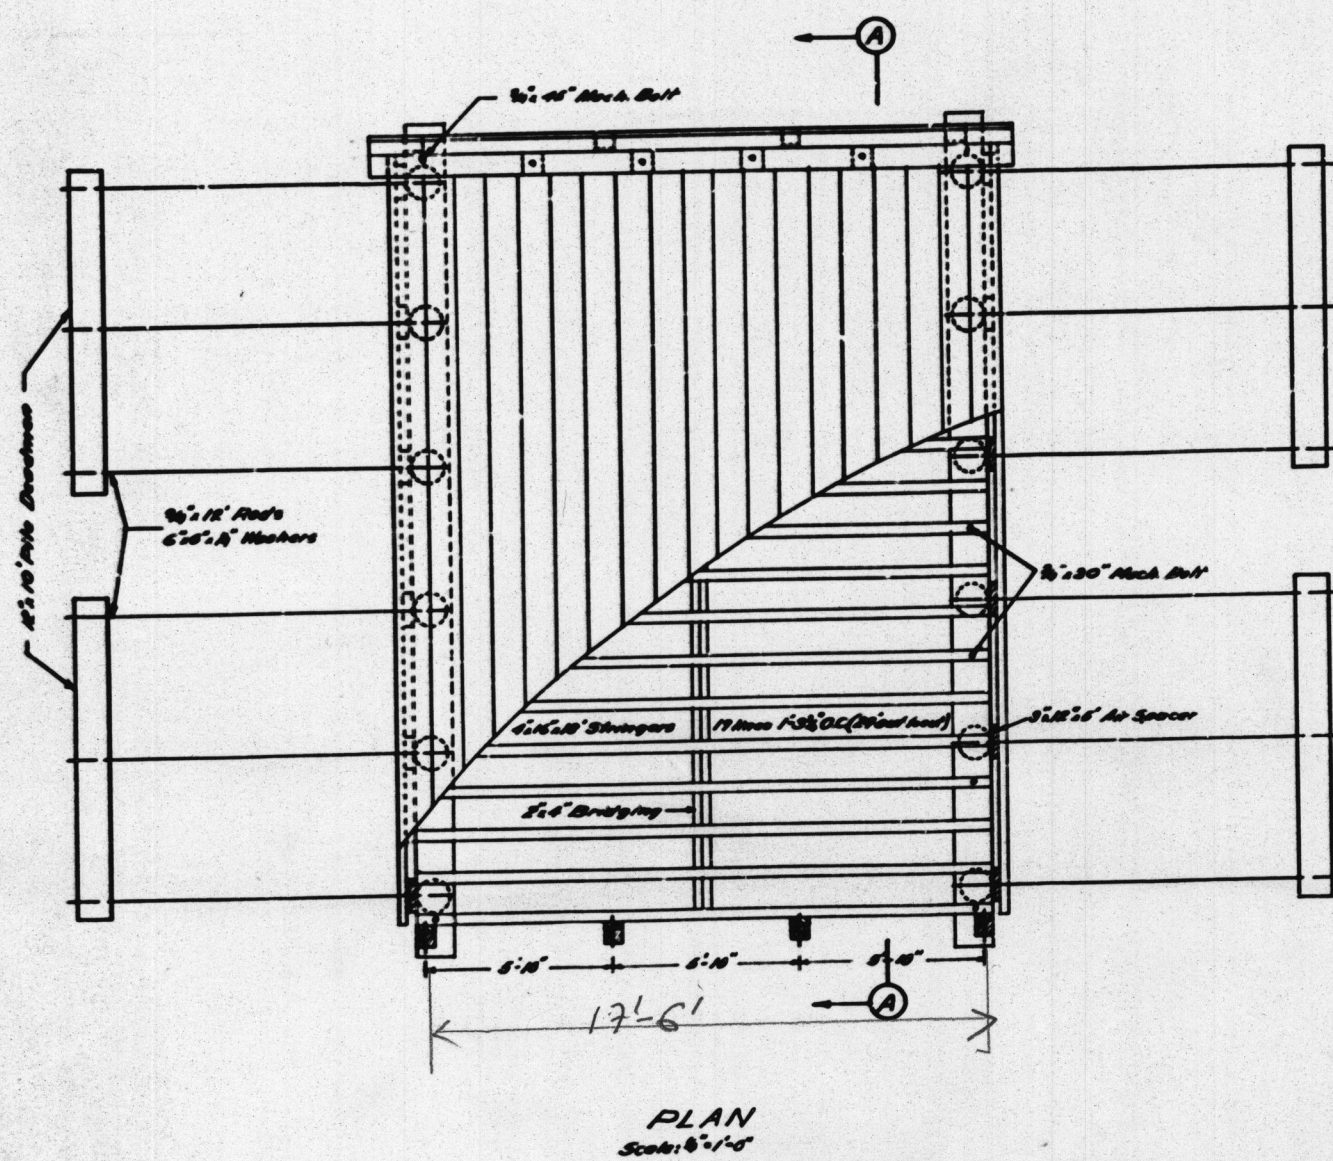
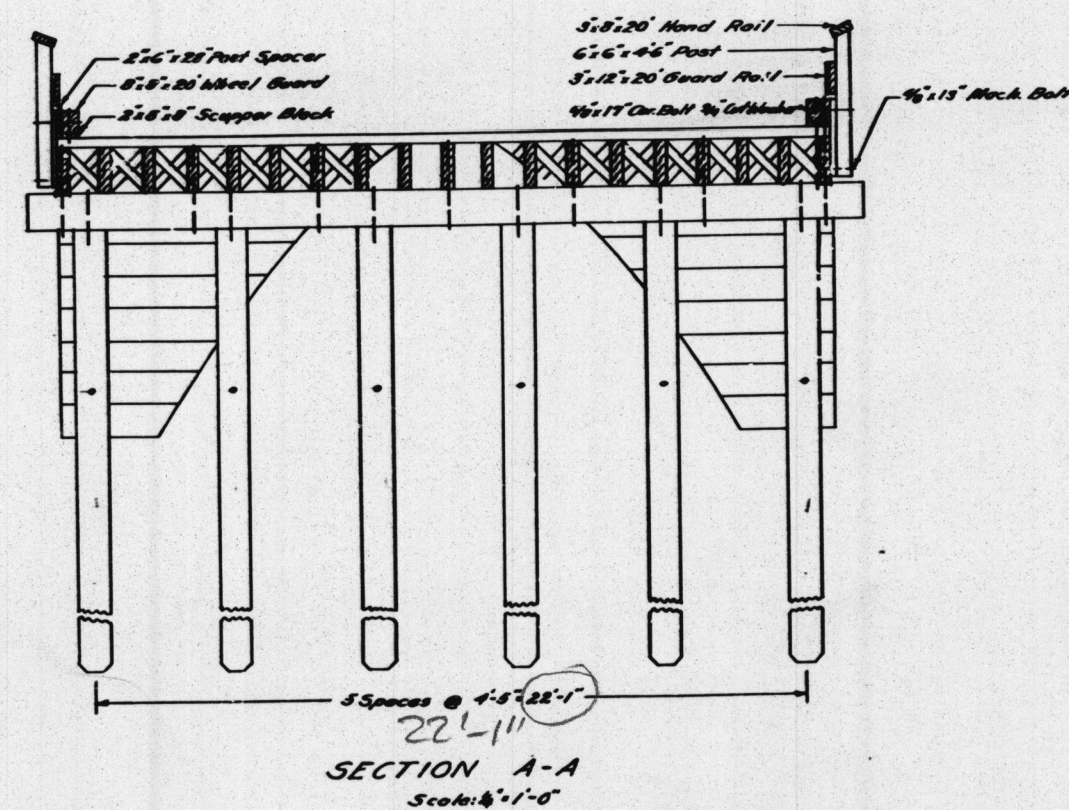


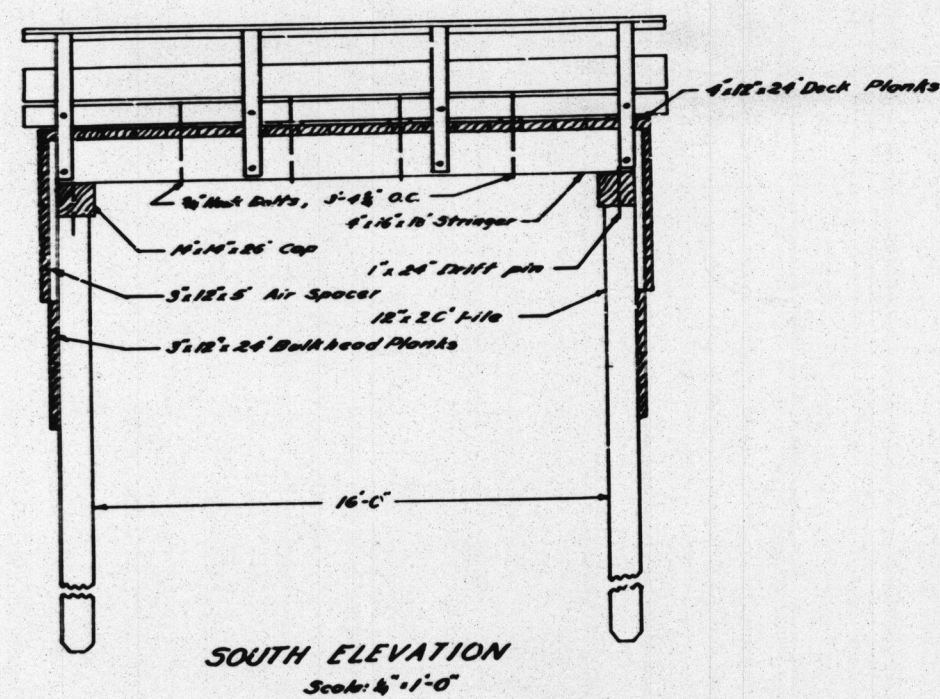

GEORGE CO. MONITOR DEPT.		
	Initial	Date
Prepared by	Victor	Aug 1960
Checked by		
Approved		

Orange County Highway Department
WOODEN CULVERT
STRUCTURE
ON 1
ACUACHEMA STREET
0.02 MI. E. of LA GALERA ST
Approved _____
H. Springer, Road Commissioner
Scale as shown Aug. 1969

ACTAGHEMA ST.
0.025/0 La Calera St.
Thomas 972-C1

#14612
S-170 1949