
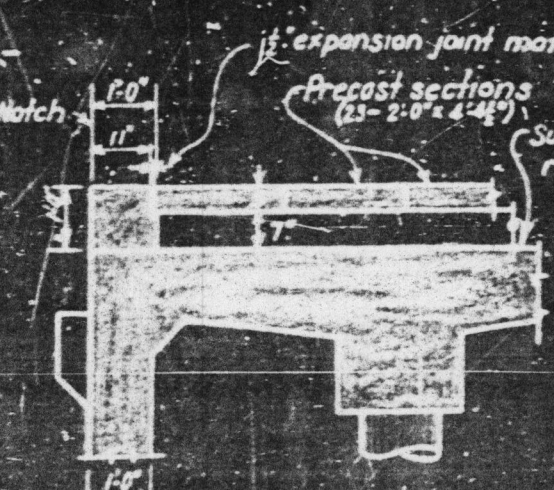
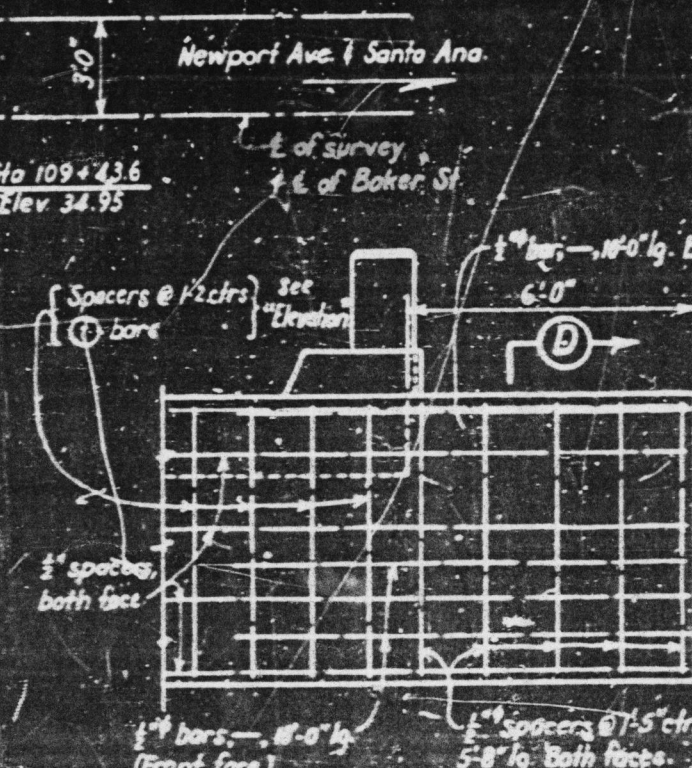
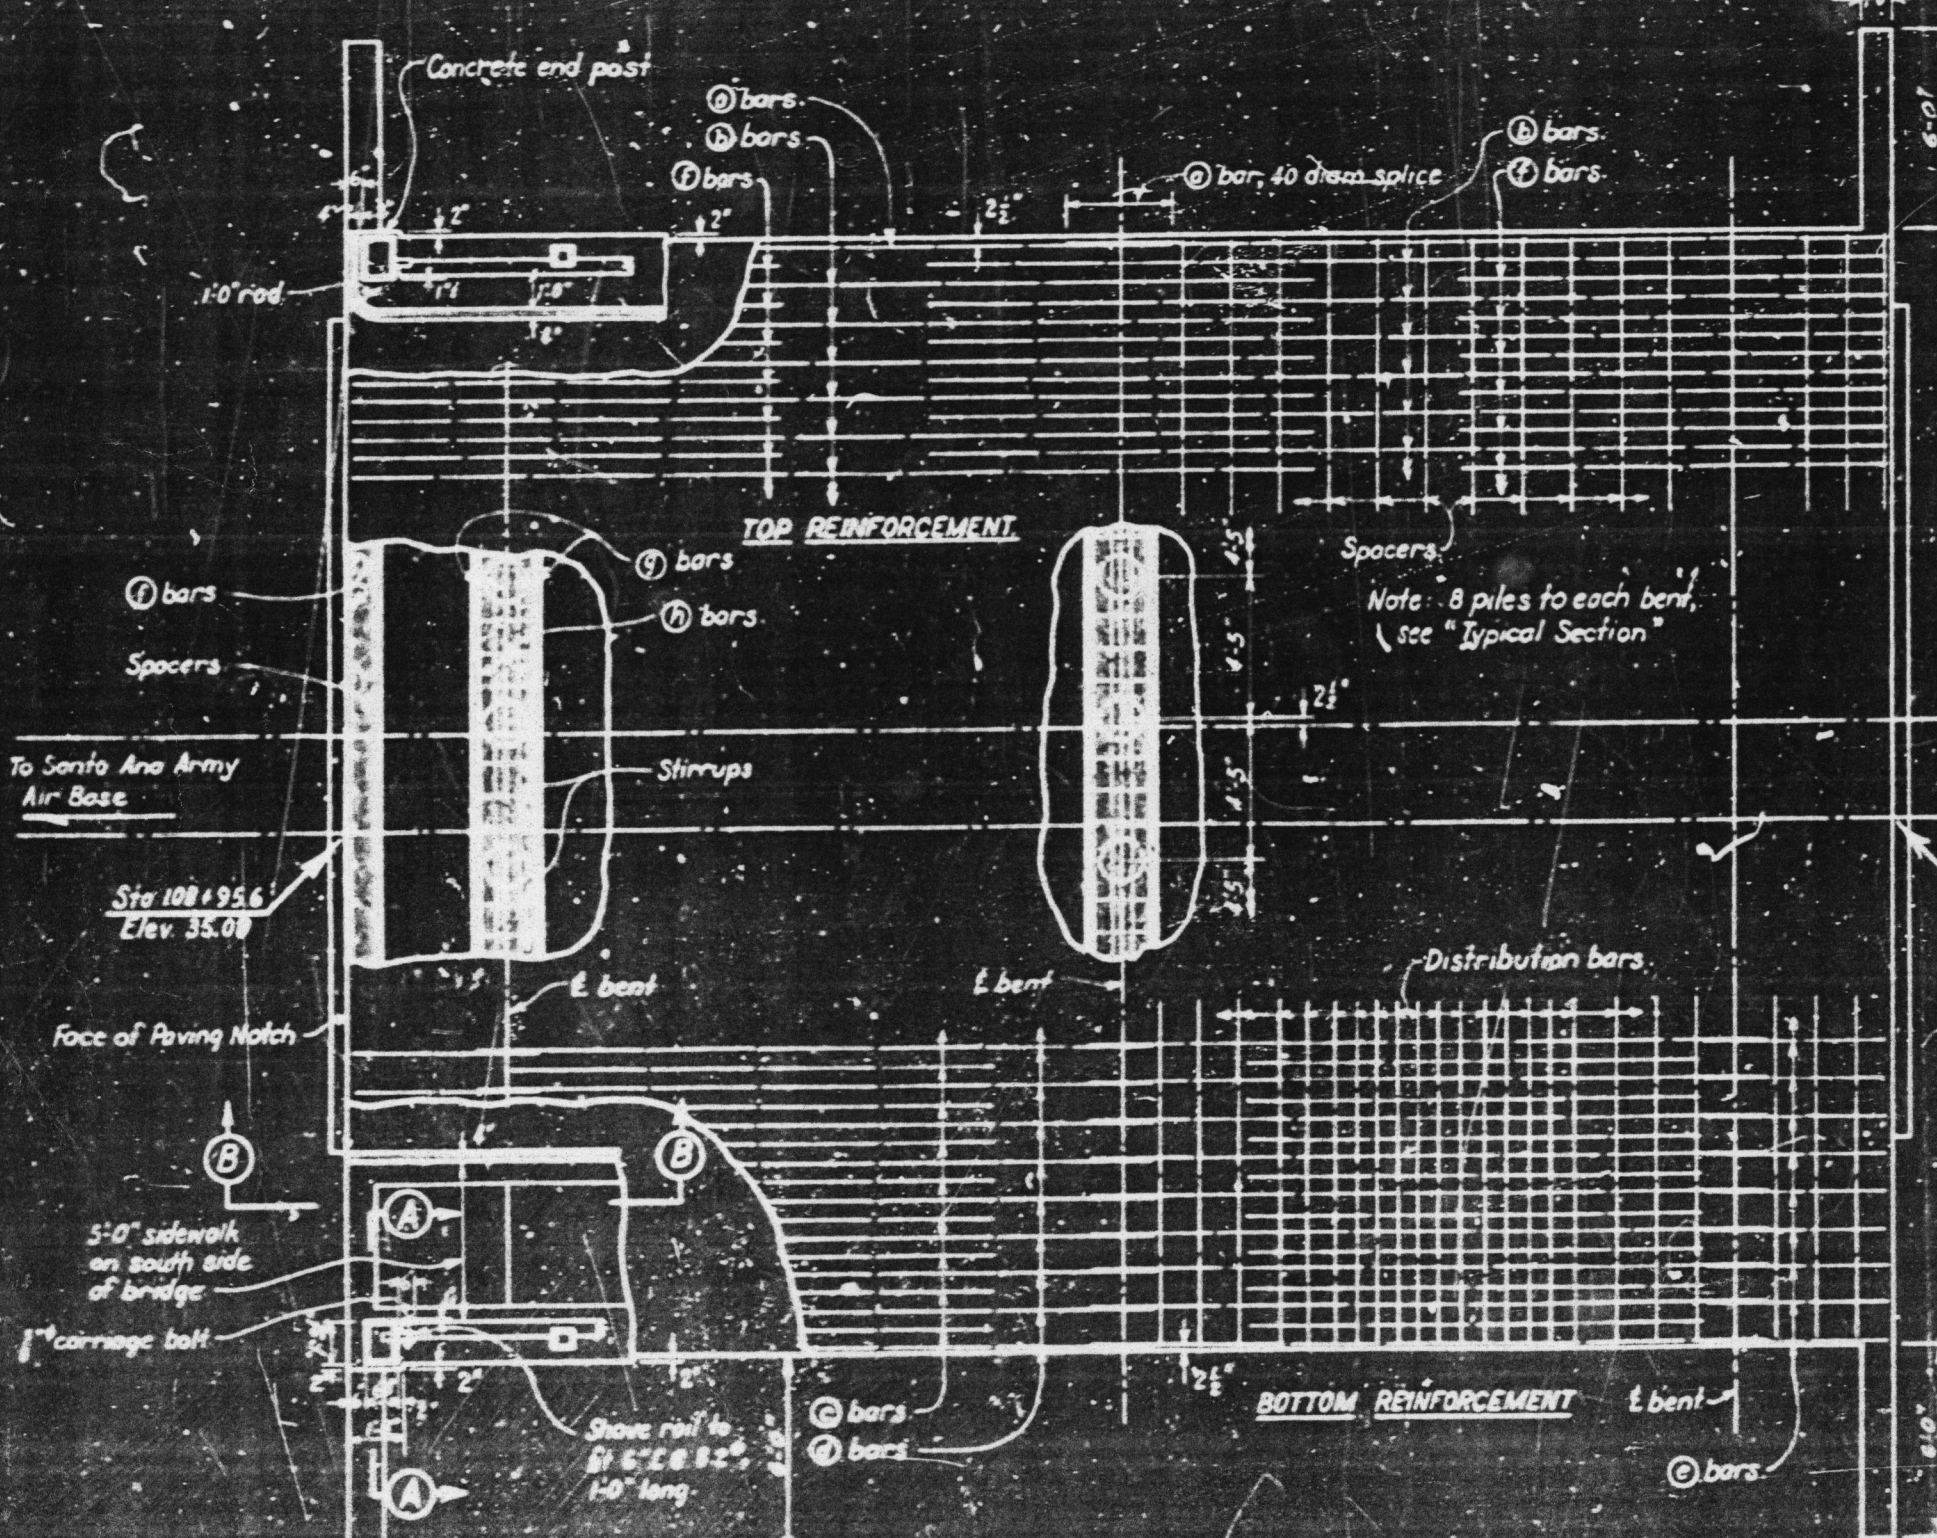
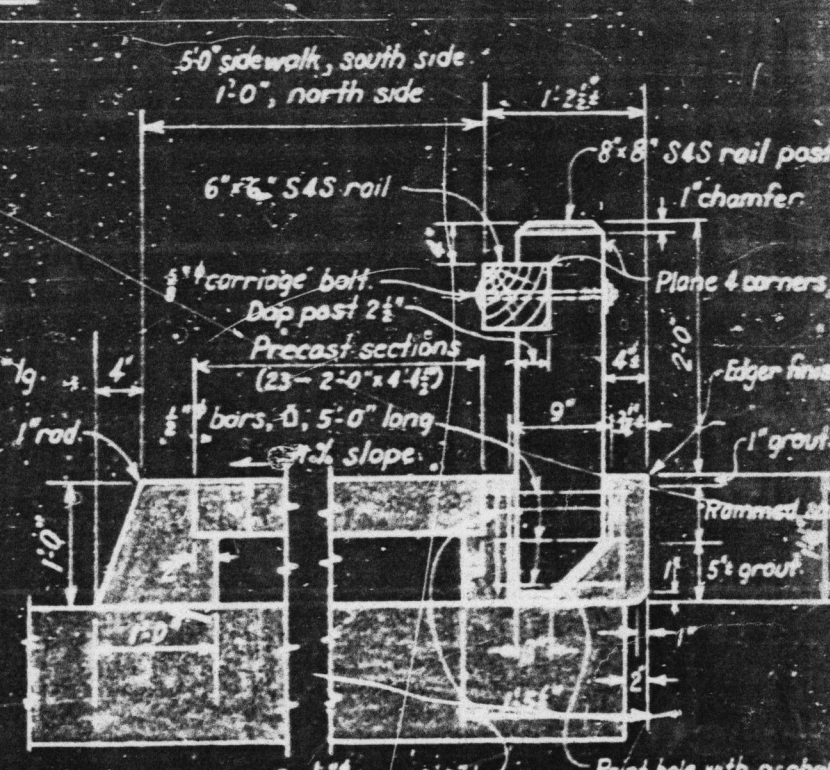
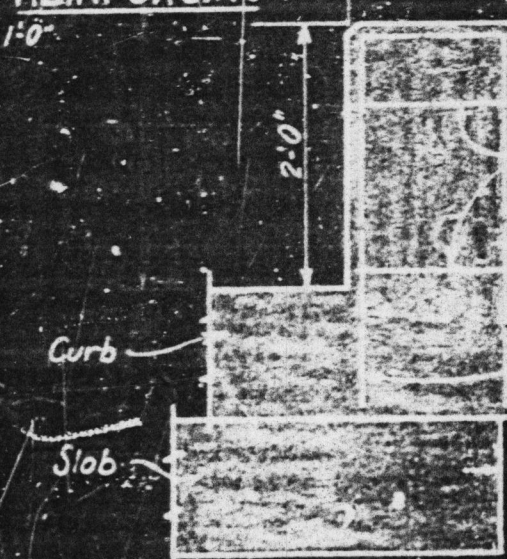
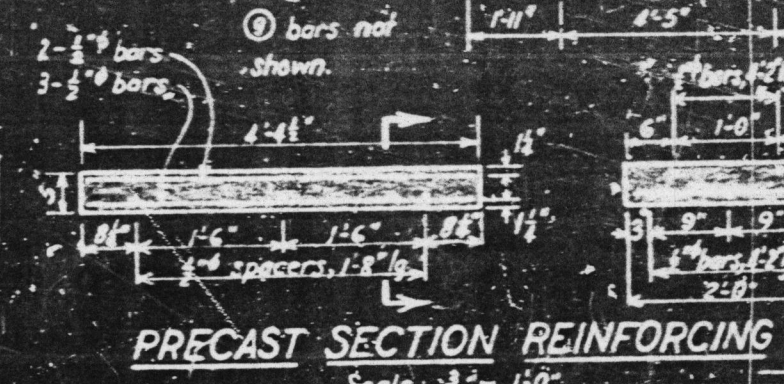
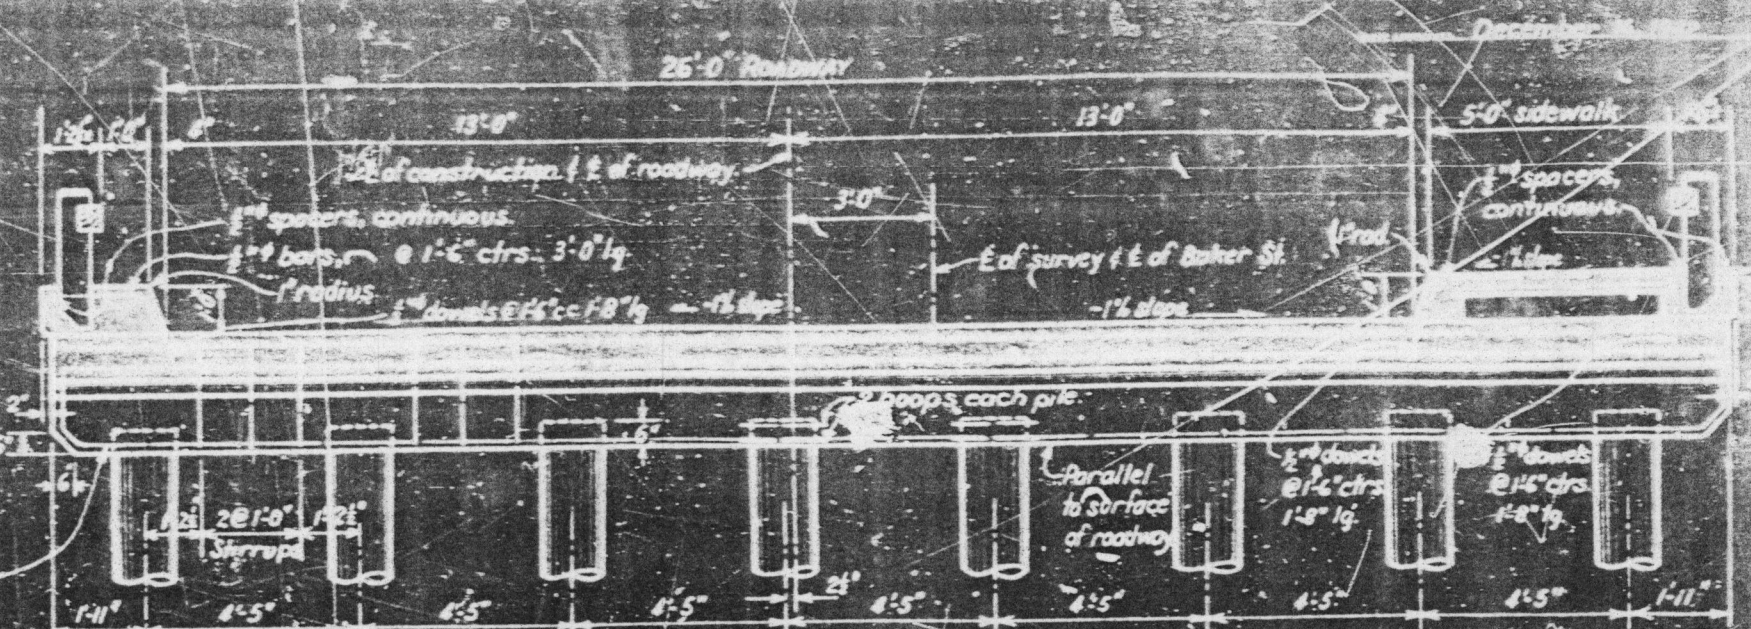


DA WRS

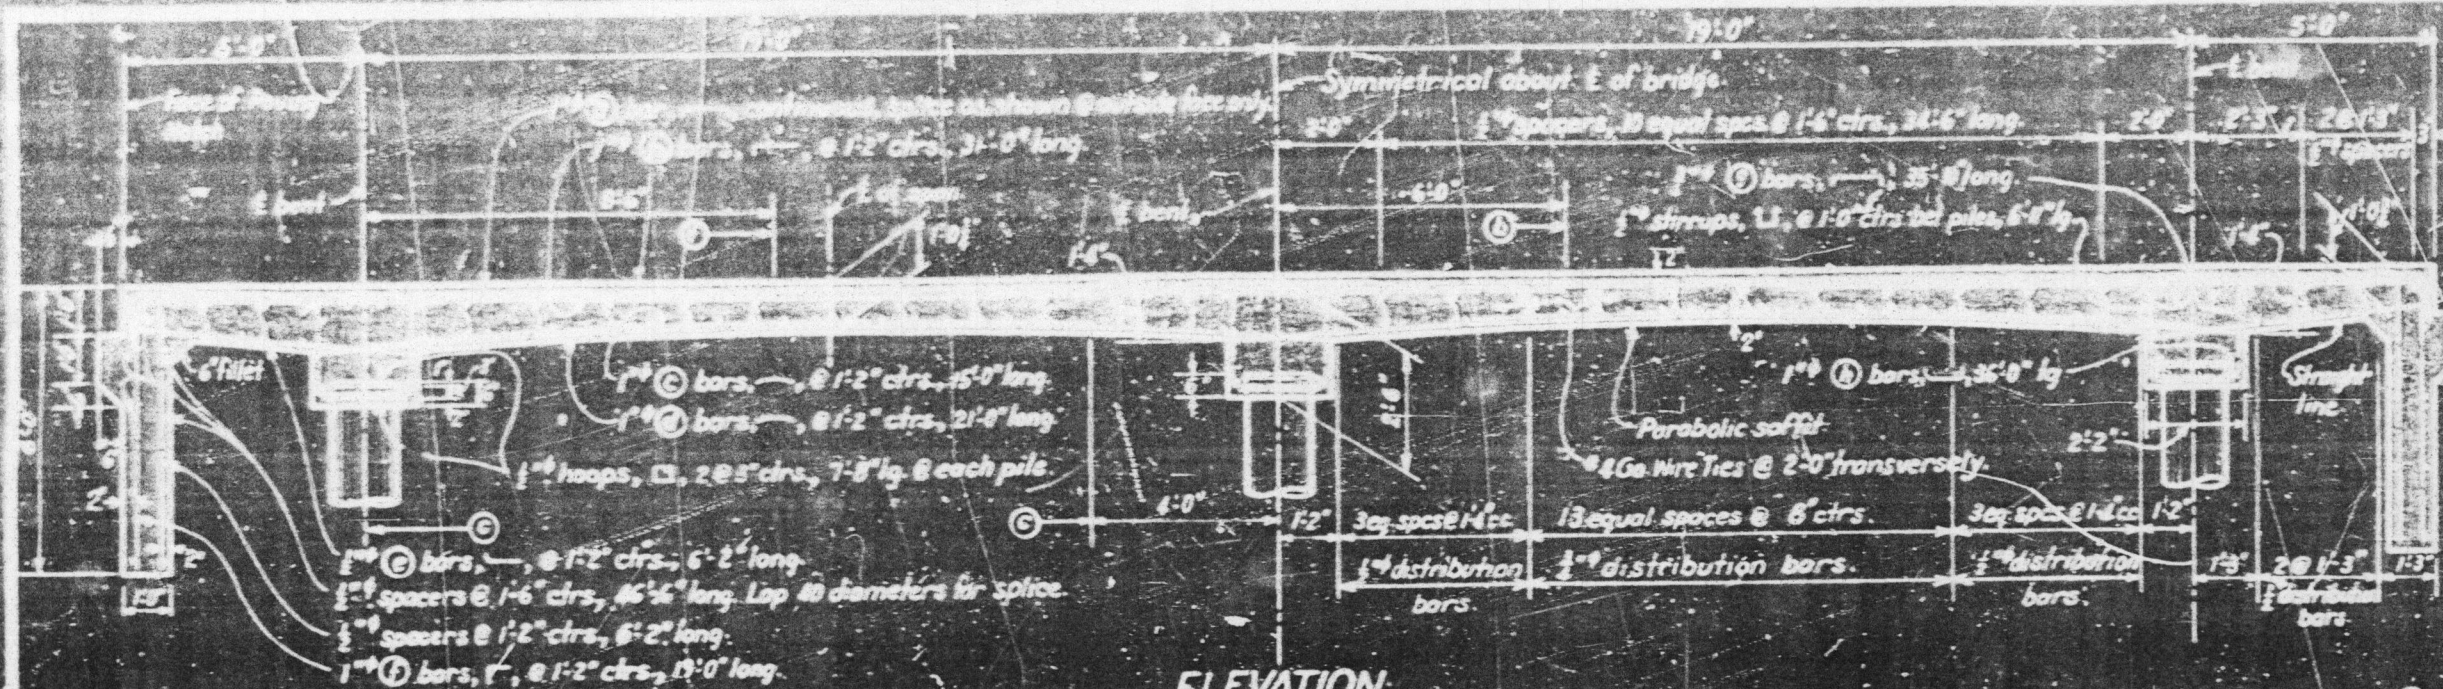

DE. 6
Bridge Across Delhi Drainage Ditch
Sheet 2 of 2
Red: 23.5.71 SCALE- AS SHOWN
BLUEPRINT

BRIDGE ACROSS DELHI DRAINAGE DITCH	
PLAN & DETAILS	
SCALE: As shown	FILE NO.
BRIDGE NO. 55C-7	DRAWING NO. C-1126