


14 15 16 17 18 19 20 21

23 24 25 26 27 28 29 30 31 32 33 34 35 36 37 38 39

41 42 43 44 45 46 47 48 49

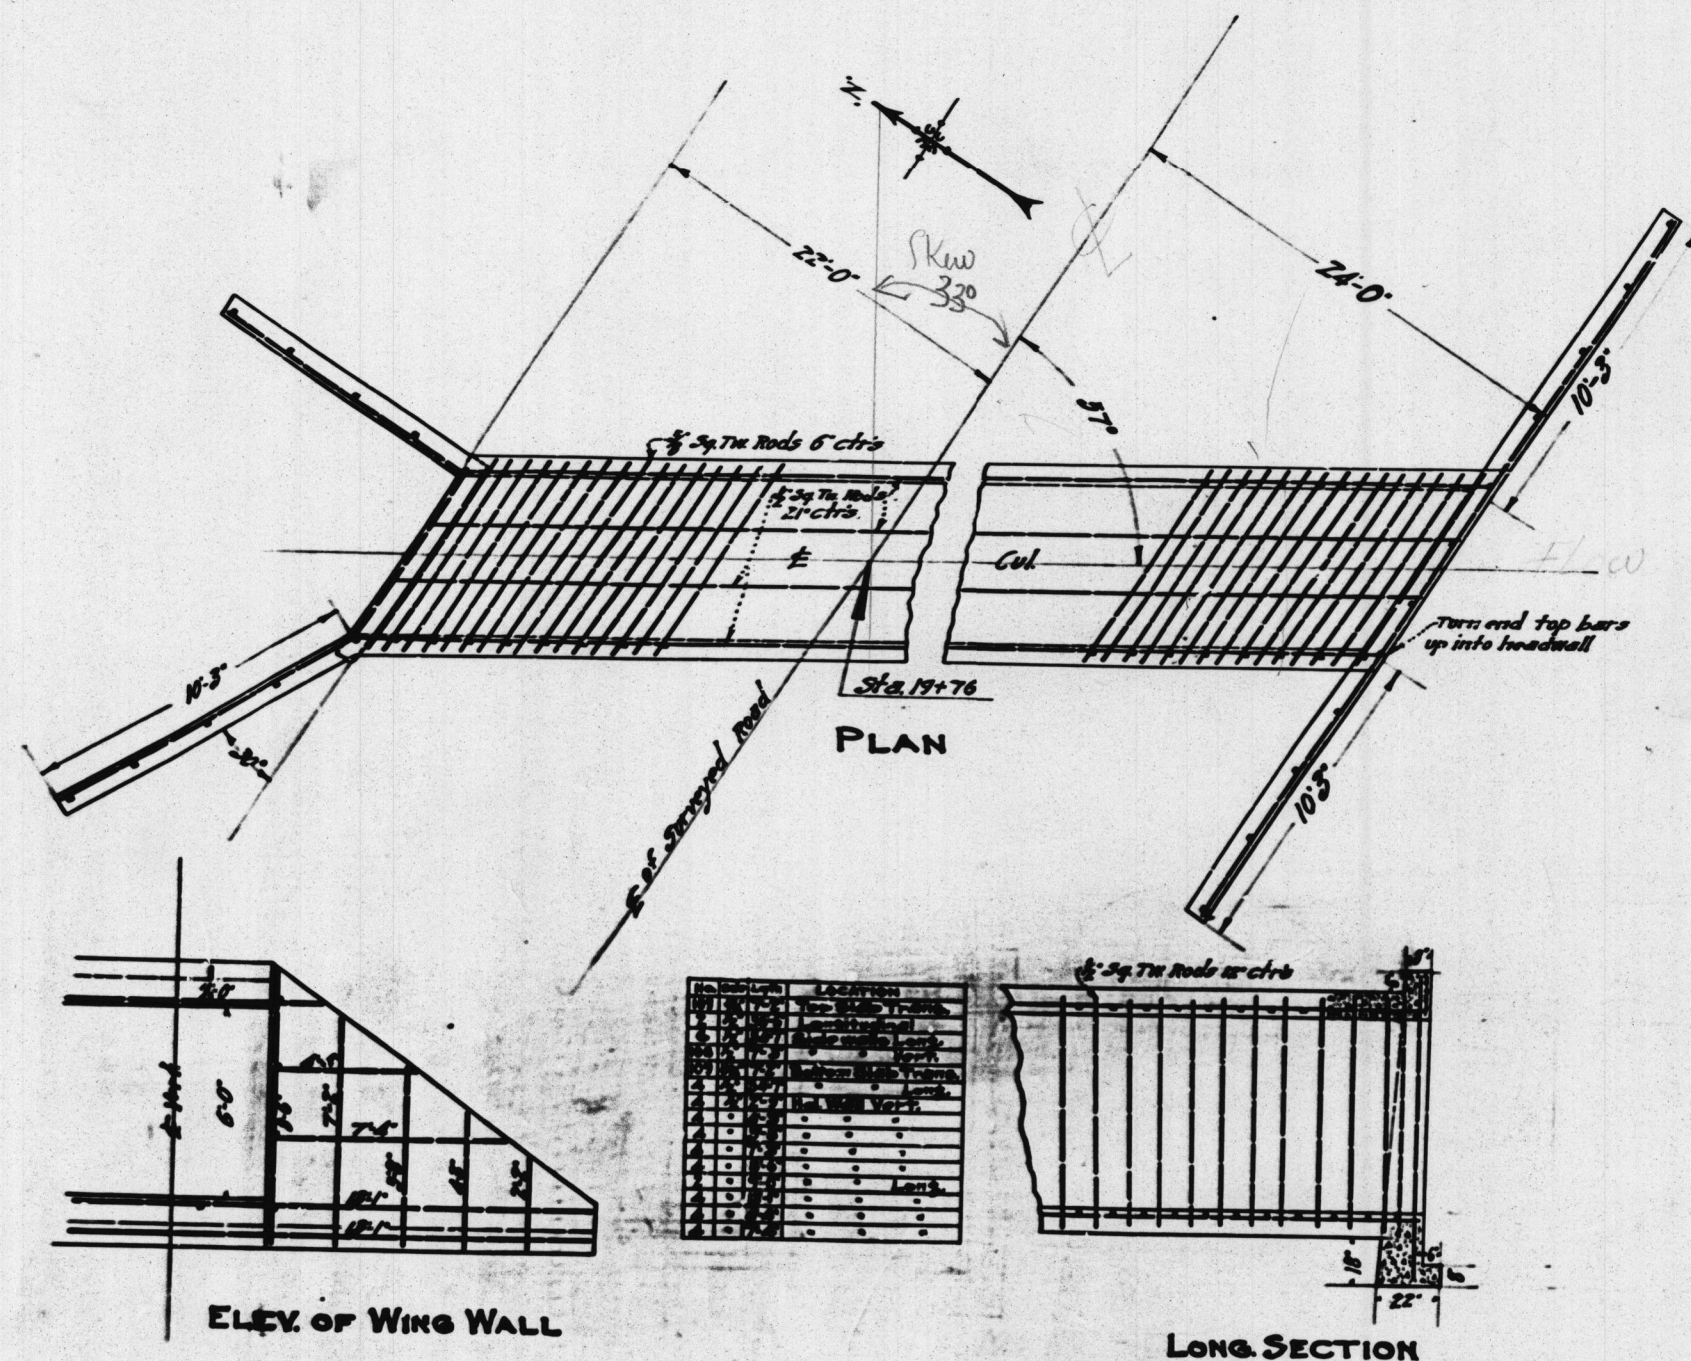

Culvert #S-128
Box Culvert
Brea-Olinda Road
Sheet 1 of 1
Red: J2.5' / Scale 1/4"=1'
Linen

MICROFILMED

JUL 1 1960

J.A.T.

L=55' Skew: 33°00'
W=46'
#14595 Before 1960
S-128
BREA-OLINDA Rd