

EXACT®




EXACT LEVEL & TOOL MFG. CO., Inc.

HIGH BRIDGE, N. J., U. S. A.


STRAIGHT EDGE RULE SE-48

20

ORANGE COUNTY HIGHWAY DEPARTMENT
PROJECT S-14 BRIDGE, BRYAN AVE
LIMITS 128+00 TO 129+00
SCALE 1"=20' SHEET 1 OF 3

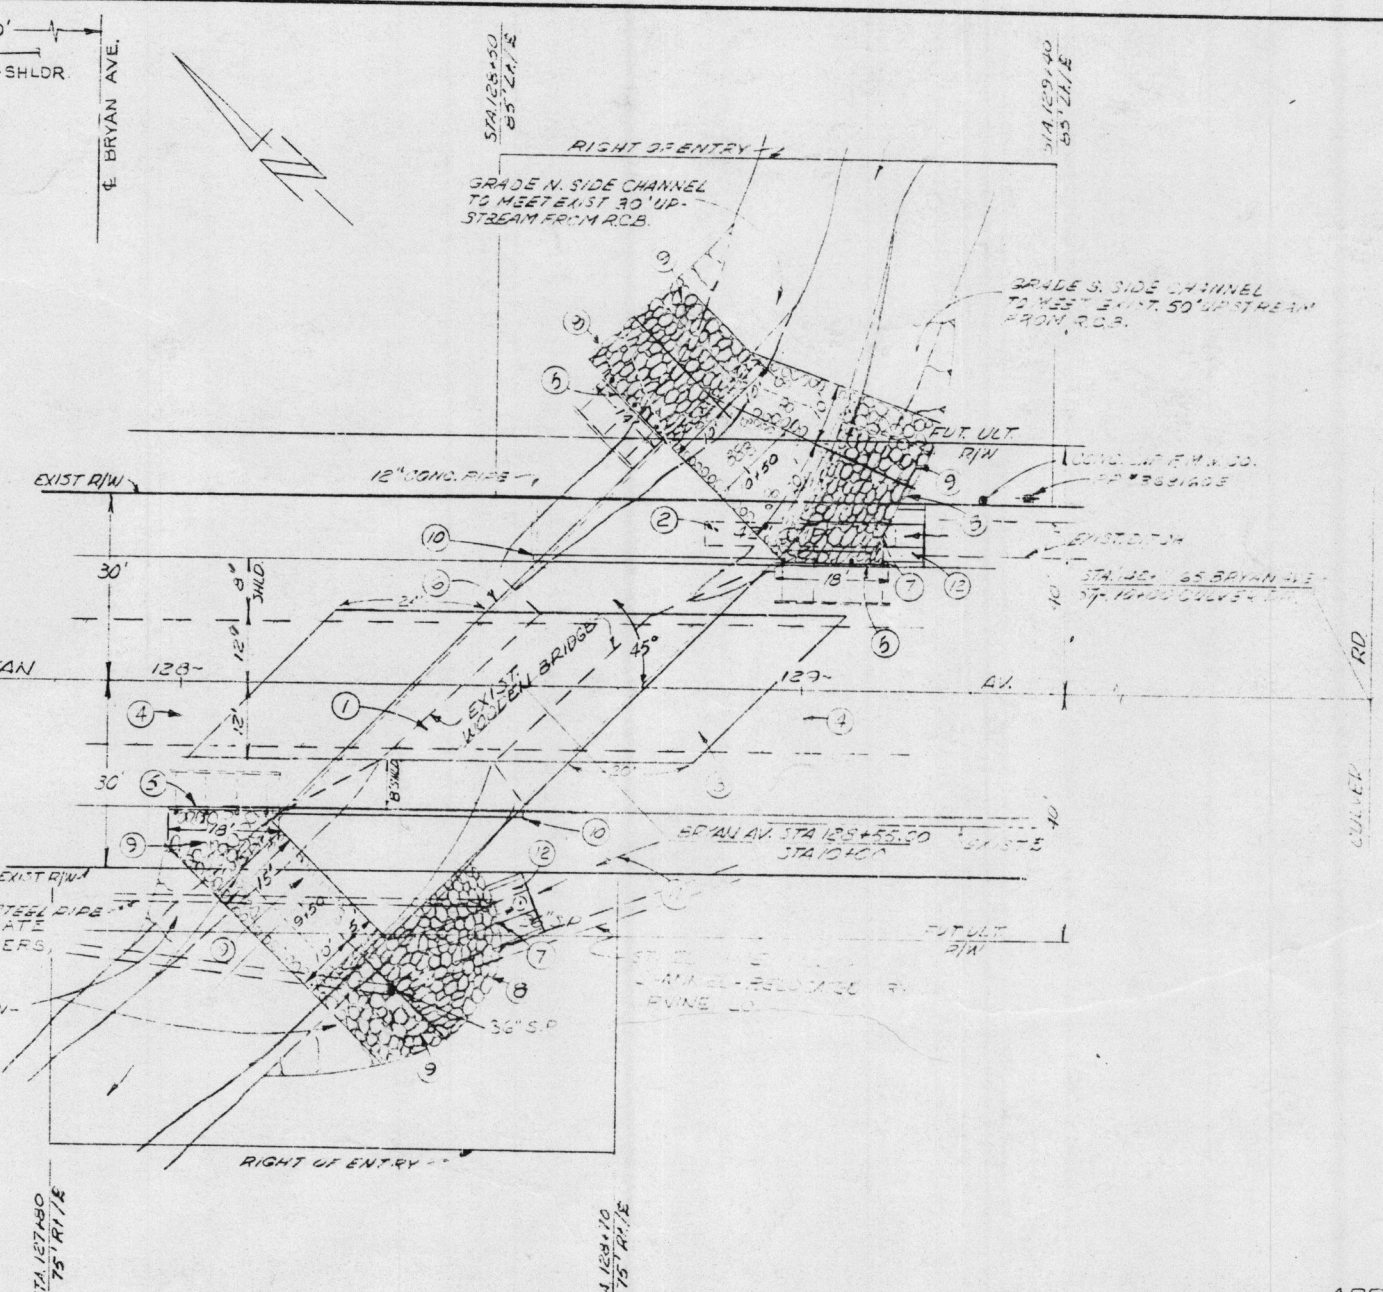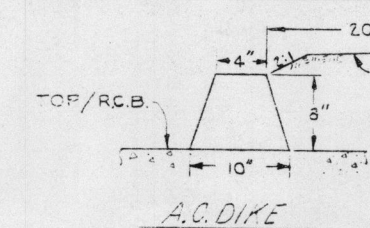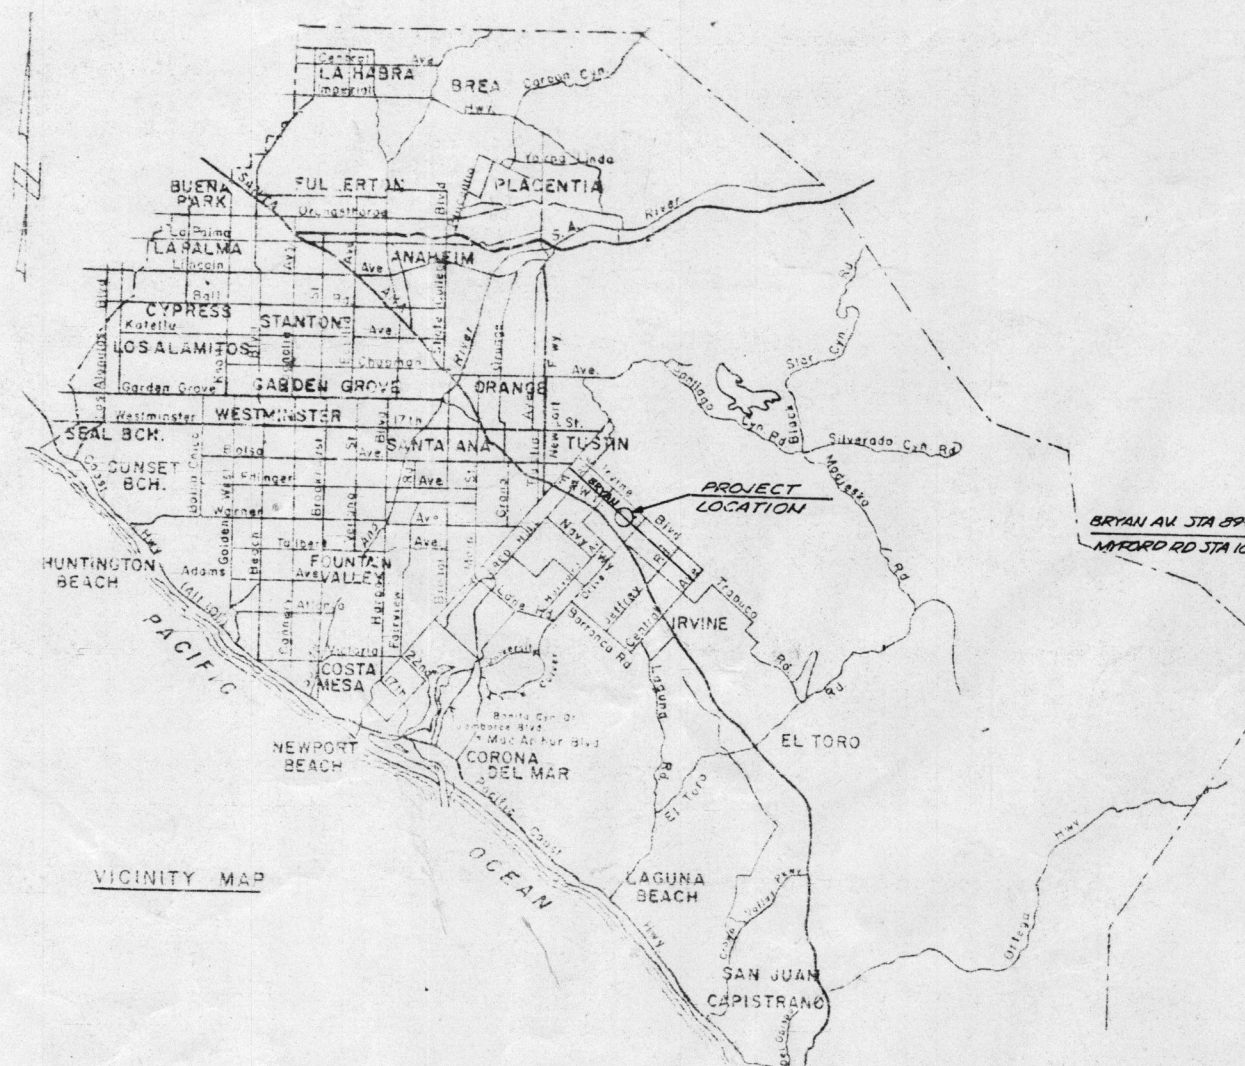


1. CONSTRUCT 24" DIA. R.C. PIPE
2. 10' LONG R.C. PIPE
3. 10' LONG R.C. PIPE
4. 10' LONG R.C. PIPE
5. 10' LONG R.C. PIPE
6. 10' LONG R.C. PIPE
7. 10' LONG R.C. PIPE
8. 10' LONG R.C. PIPE
9. 10' LONG R.C. PIPE
10. 10' LONG R.C. PIPE

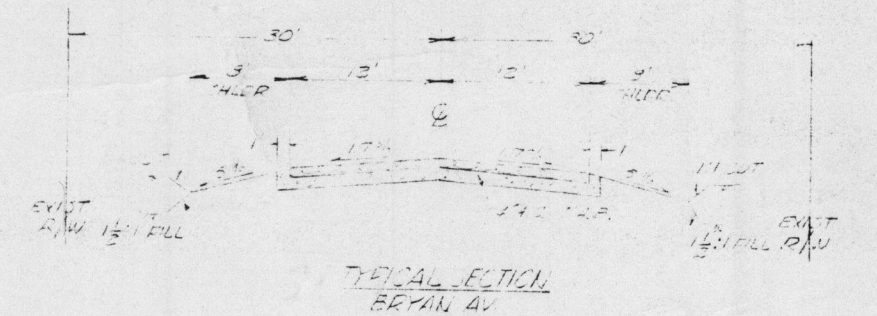

APPROVED: *Allen I. Korn* 5-15-69
ROAD COMMISSIONER, DCE 7372 DATE

BENCH MARK
128+00
128+00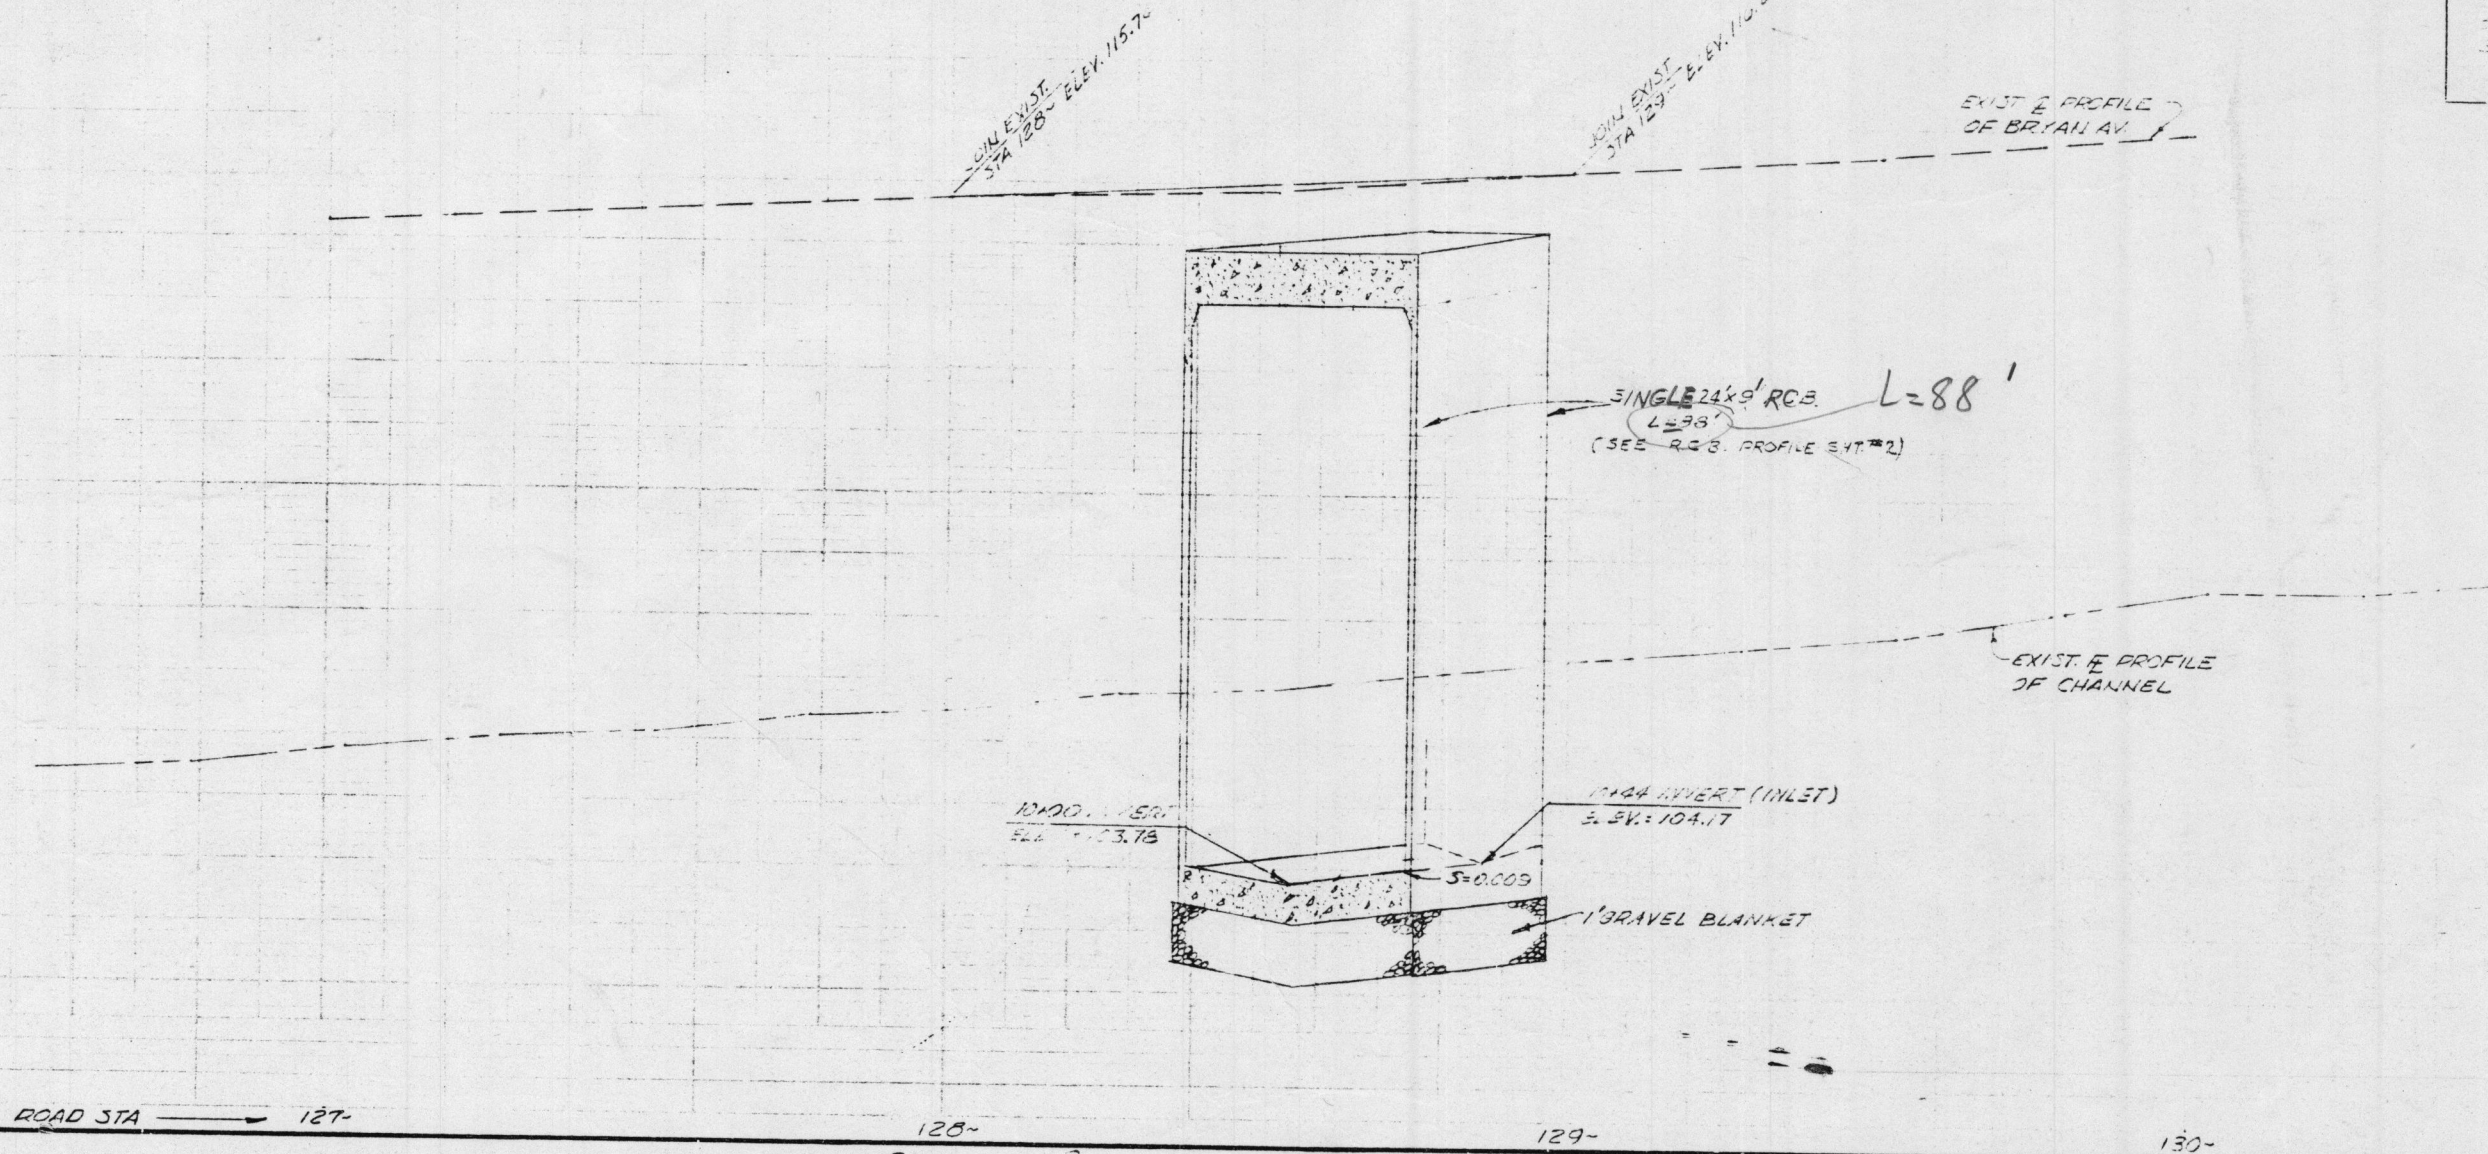
AS BUILT
P.S. 1000 R. BROWN

Exc. CU.
YDS. EMB.
STA.

Exc. CU.
YDS. EMB.
STA.

SHT. 1/2

#10061
S-14
BRYAN ME. BR.
Thos. Map: 830-F6