
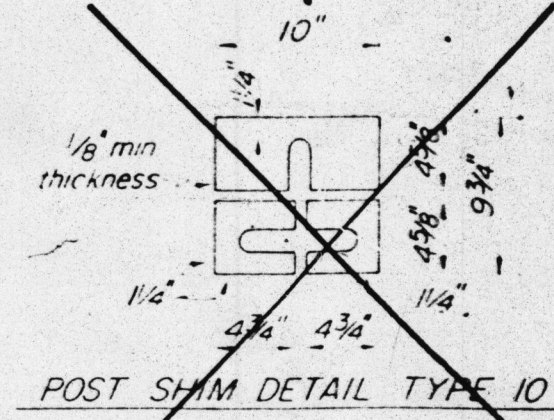
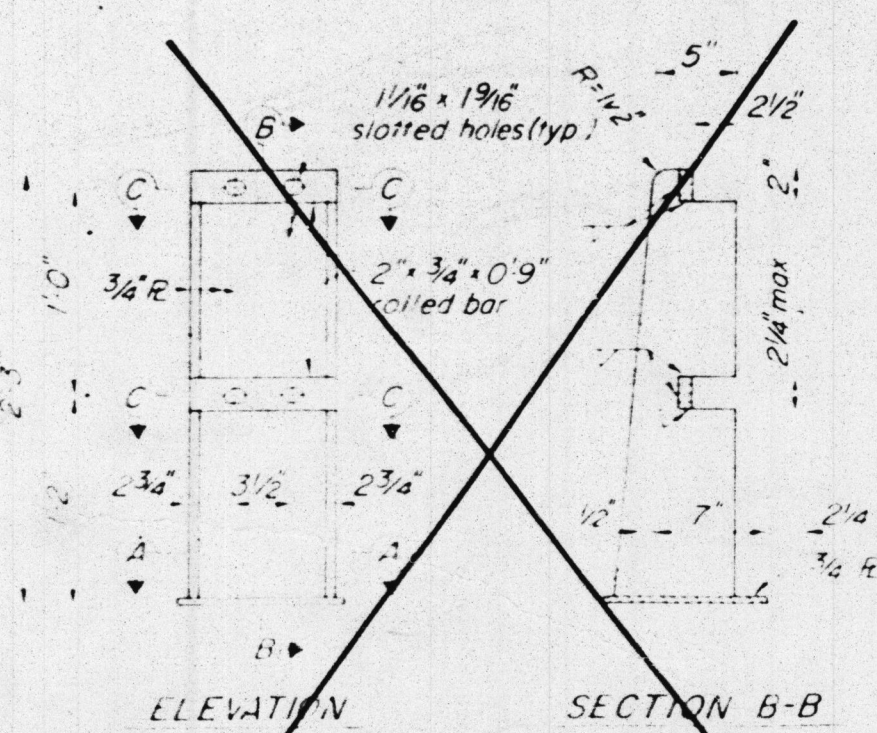
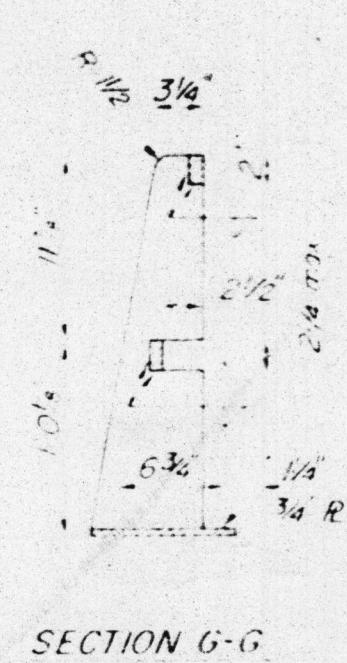
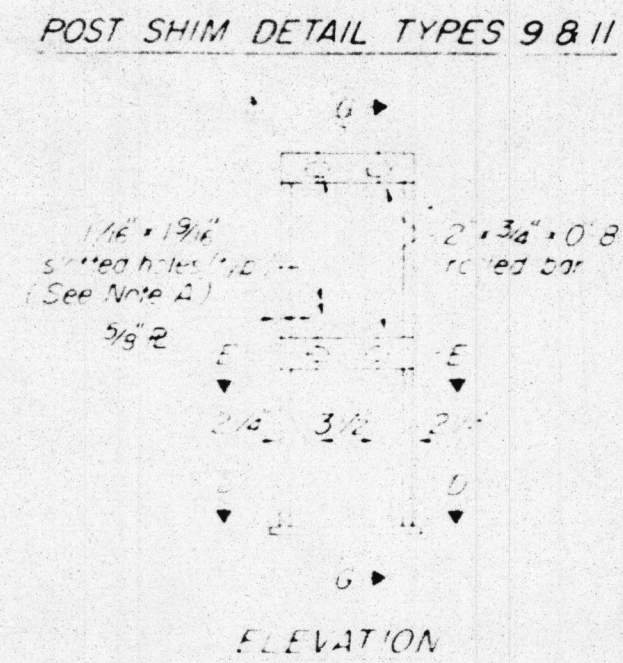
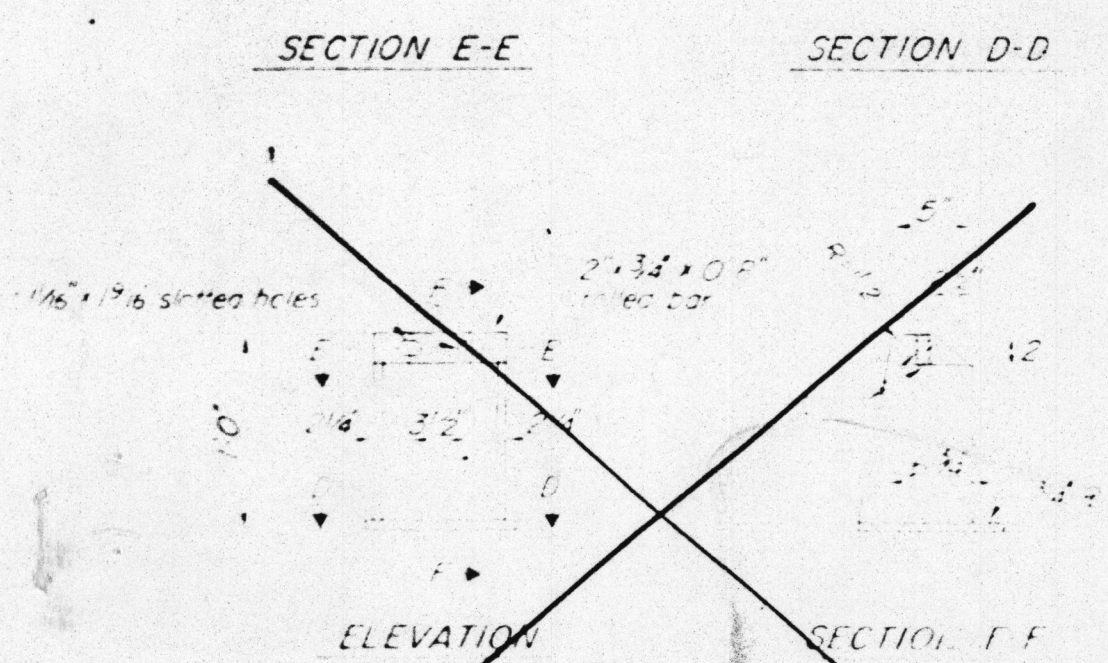
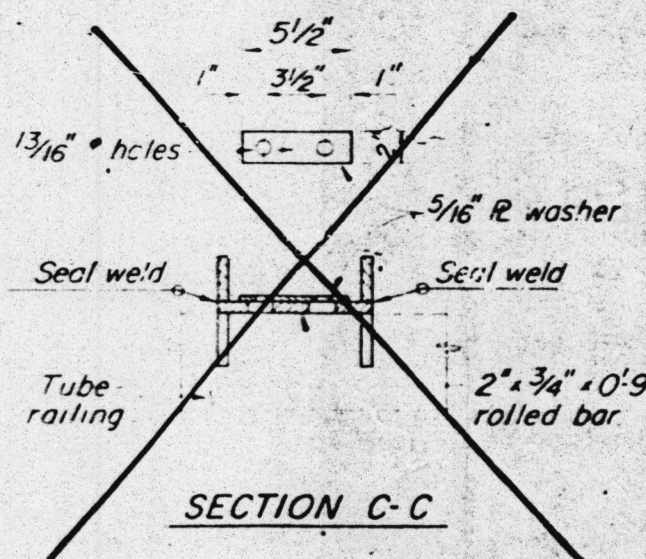
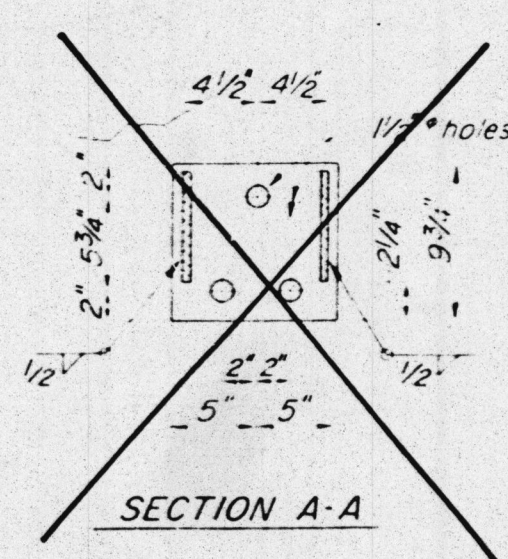
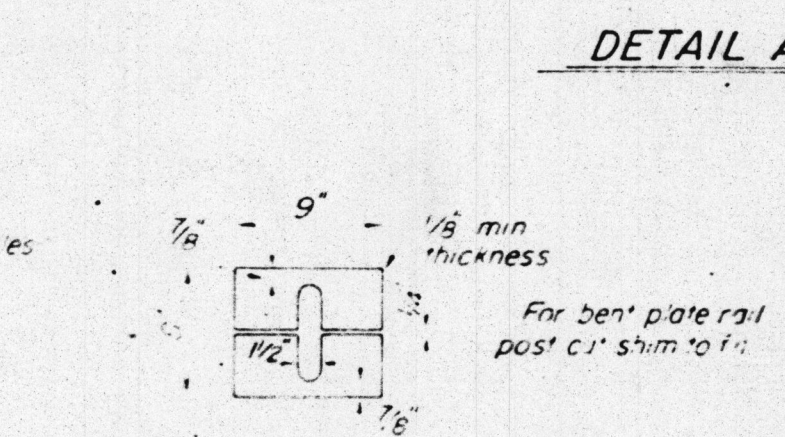
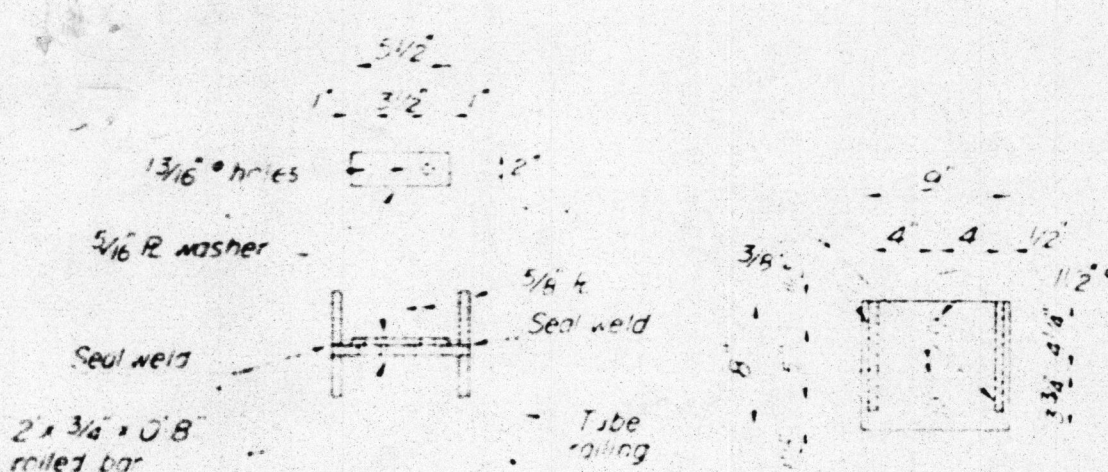
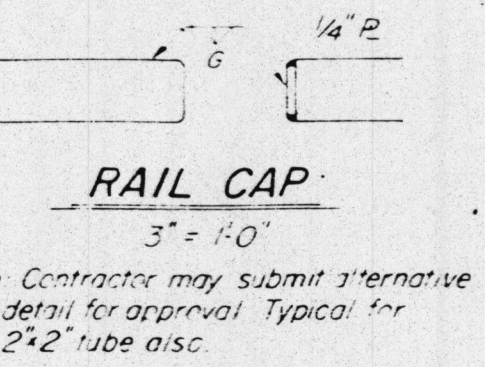
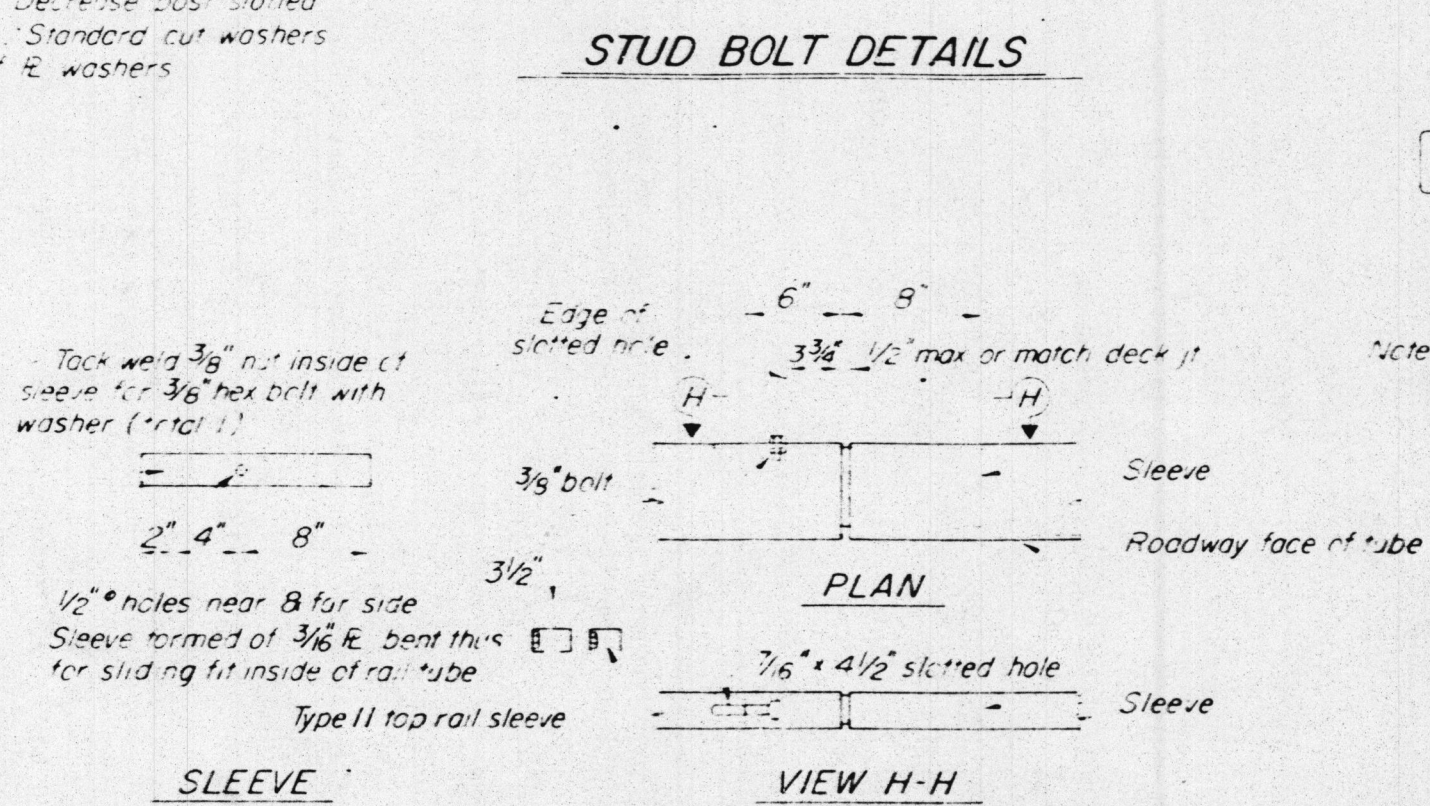
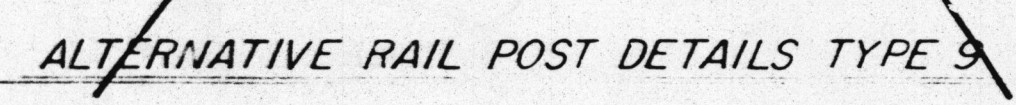
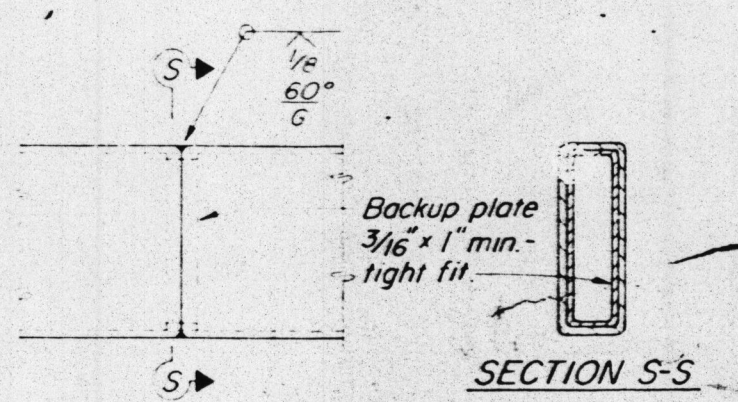
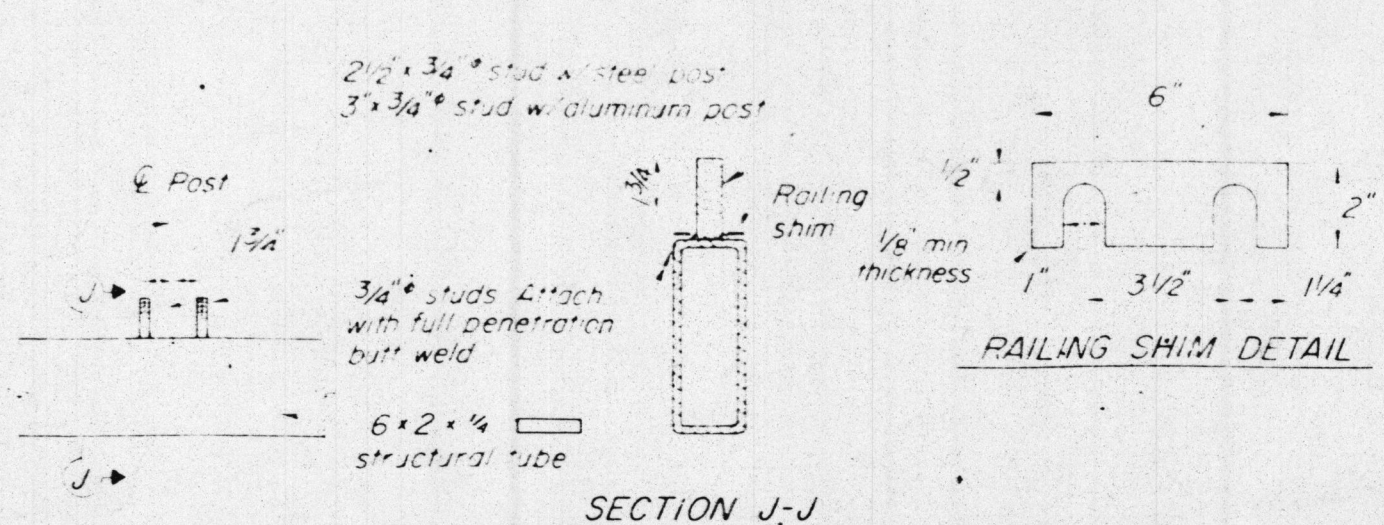
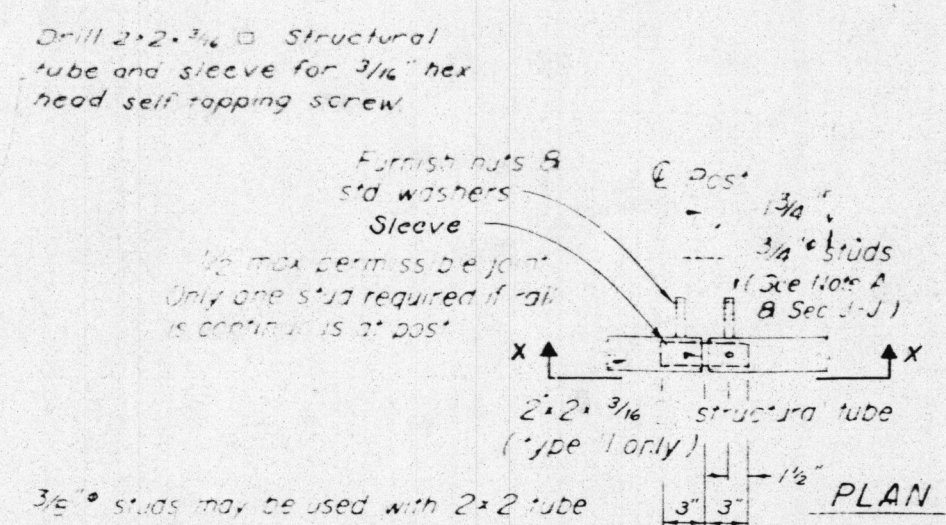


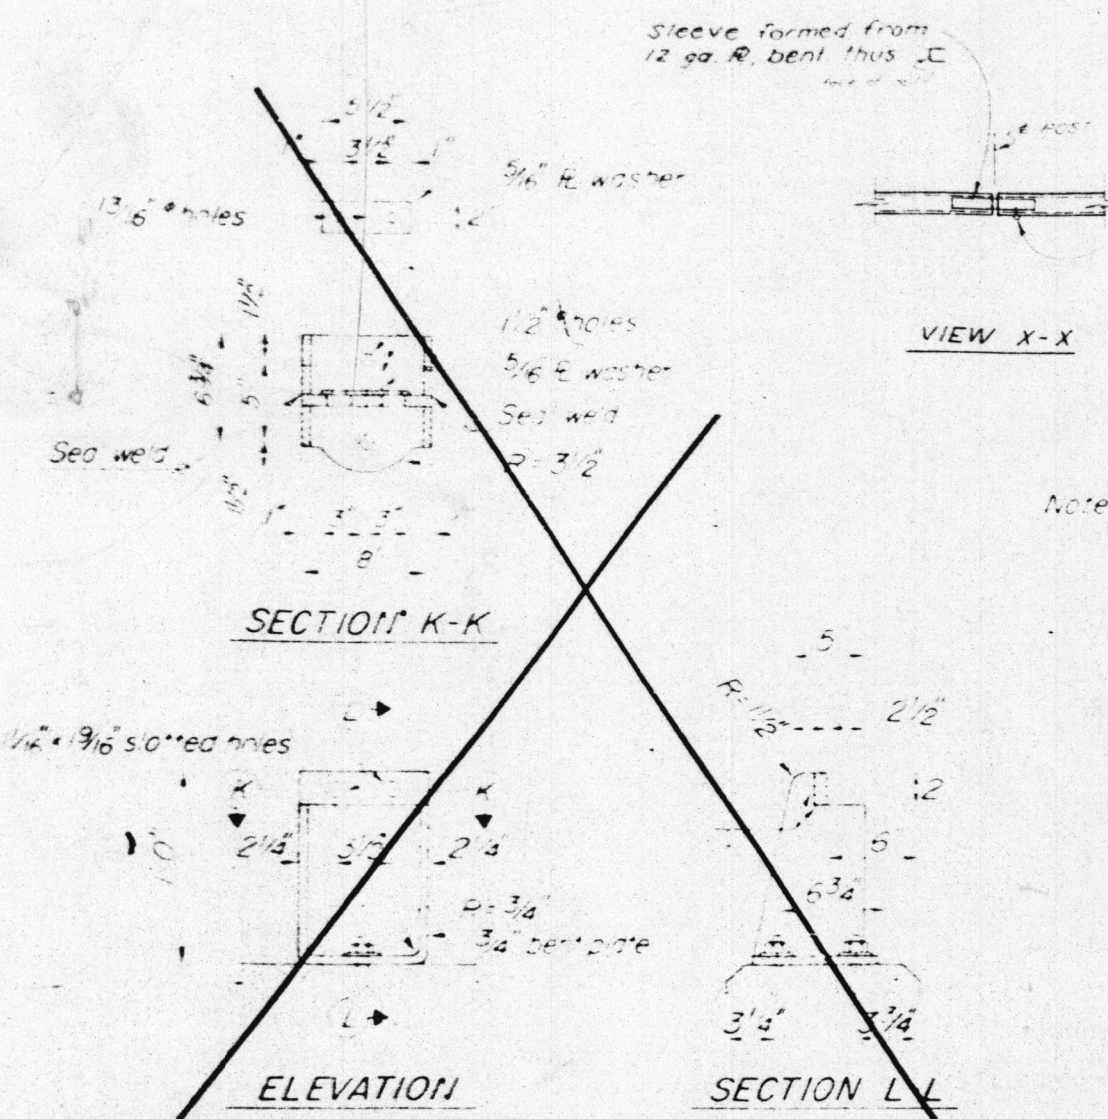

Note: This sheet supersedes Sheet No B11-43
page 112 of the Standard Plans dated February 1968

1971 or
#10871 Later
CAMBRIDGE ST. BRIDGE
OVER SANTIAGO CREEK
SC-18
55C-0333 Thomas 799-HS