


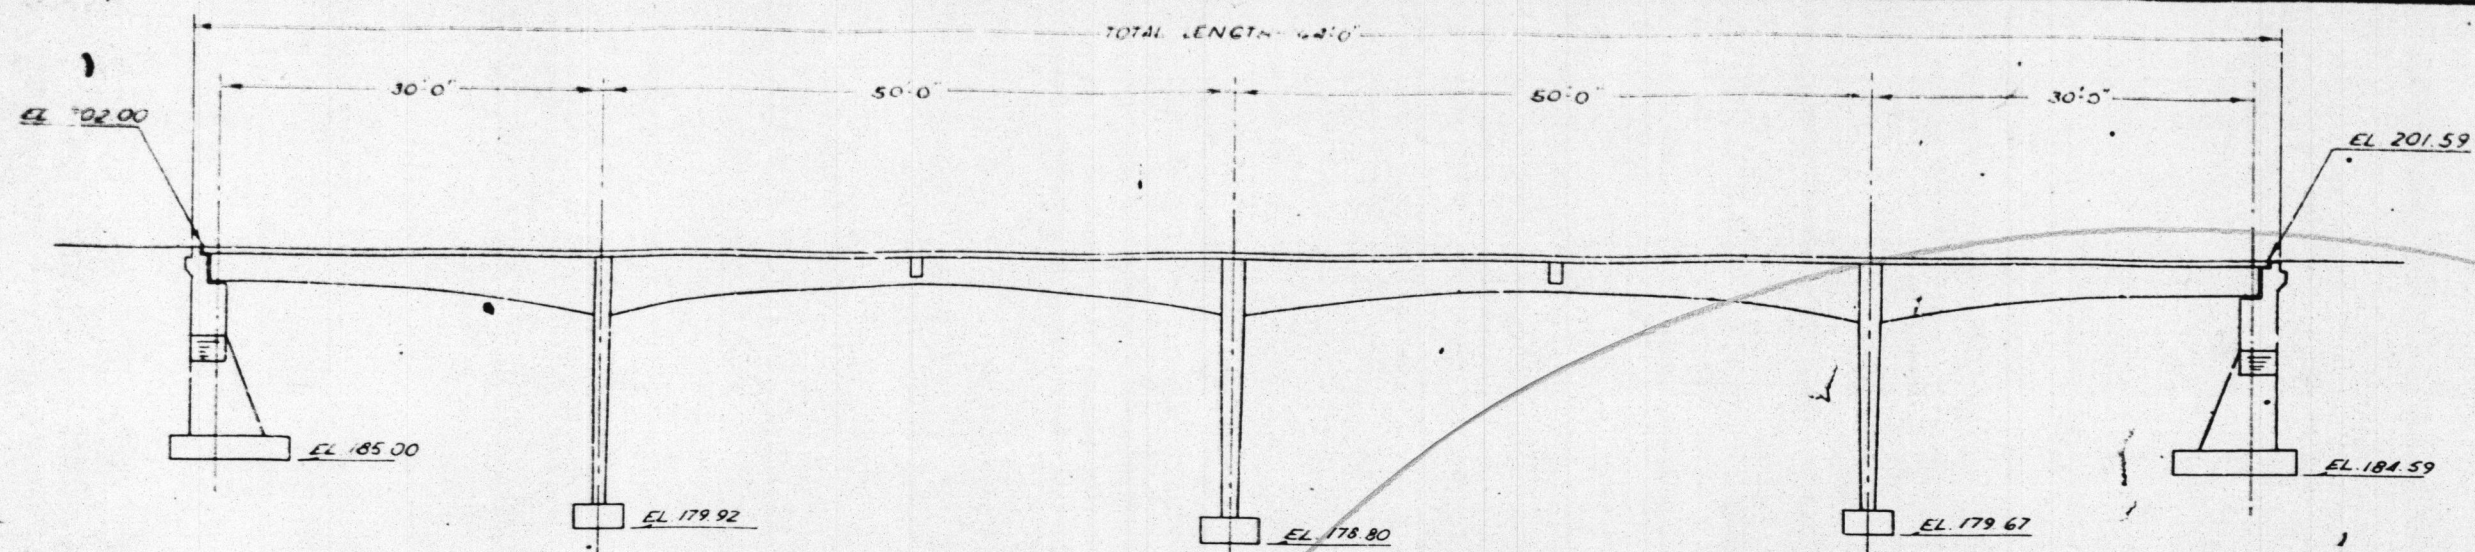

EXISTING G. BRIDGE
© 1946

