



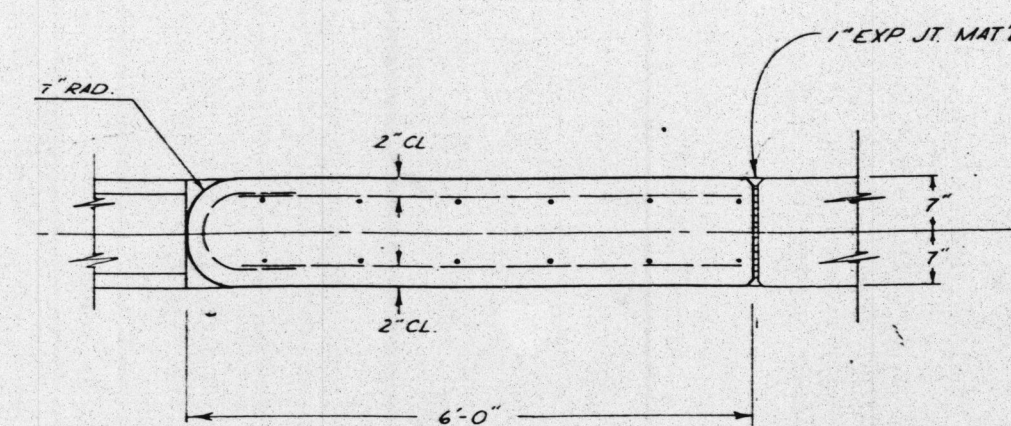


SECTION C-C
SCALE 3/4" = 1'-0"

TYPICAL PIER EXTENSION DETAILS
SCALE 1/2" = 1'-0"

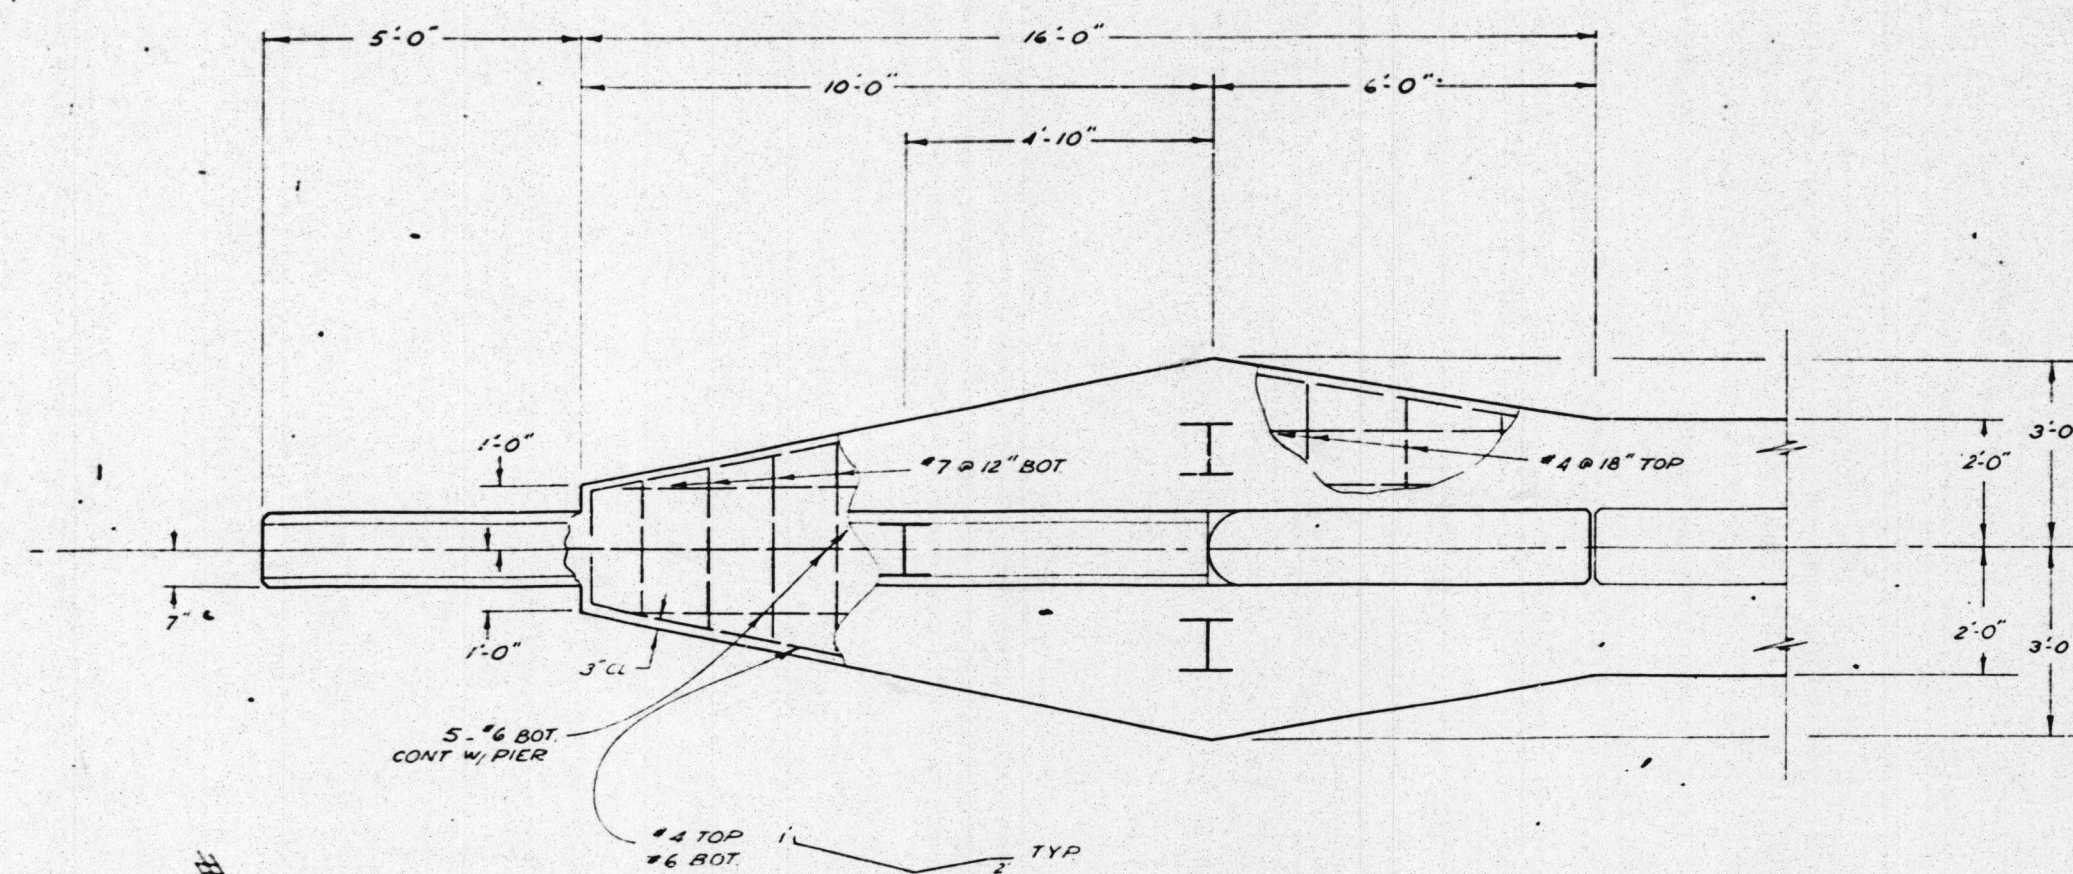

SECTION A-A
SCALE 1/2"=1'-0"

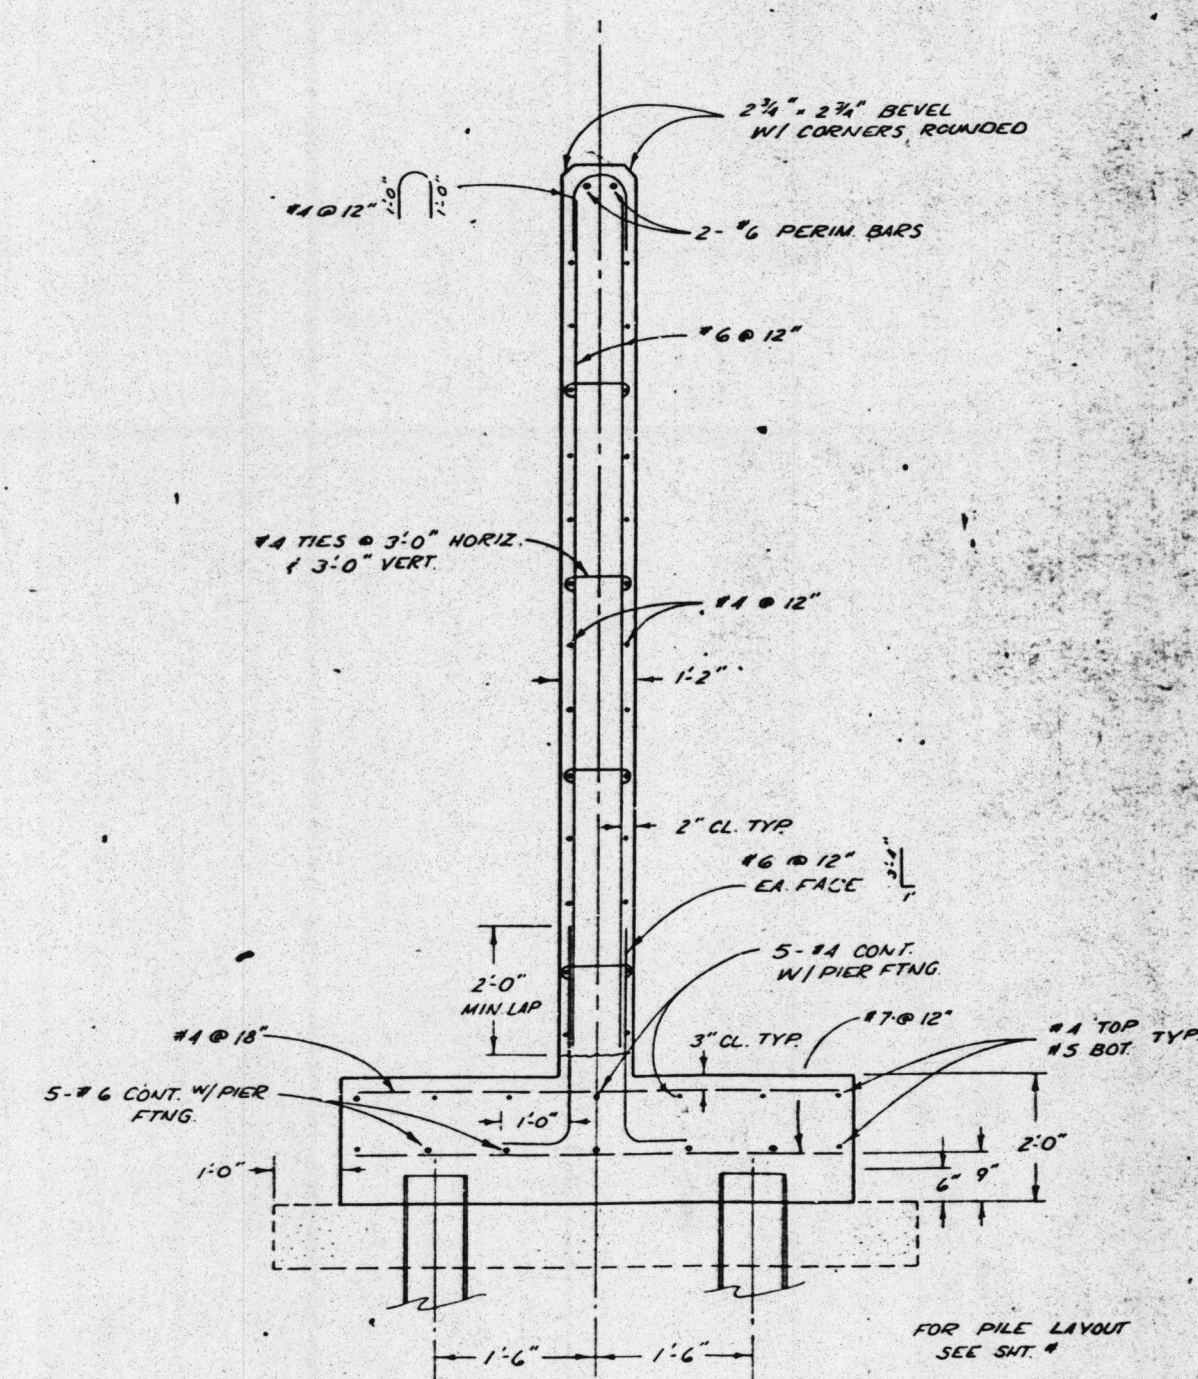

SECTION B-B
SCALE NONE