
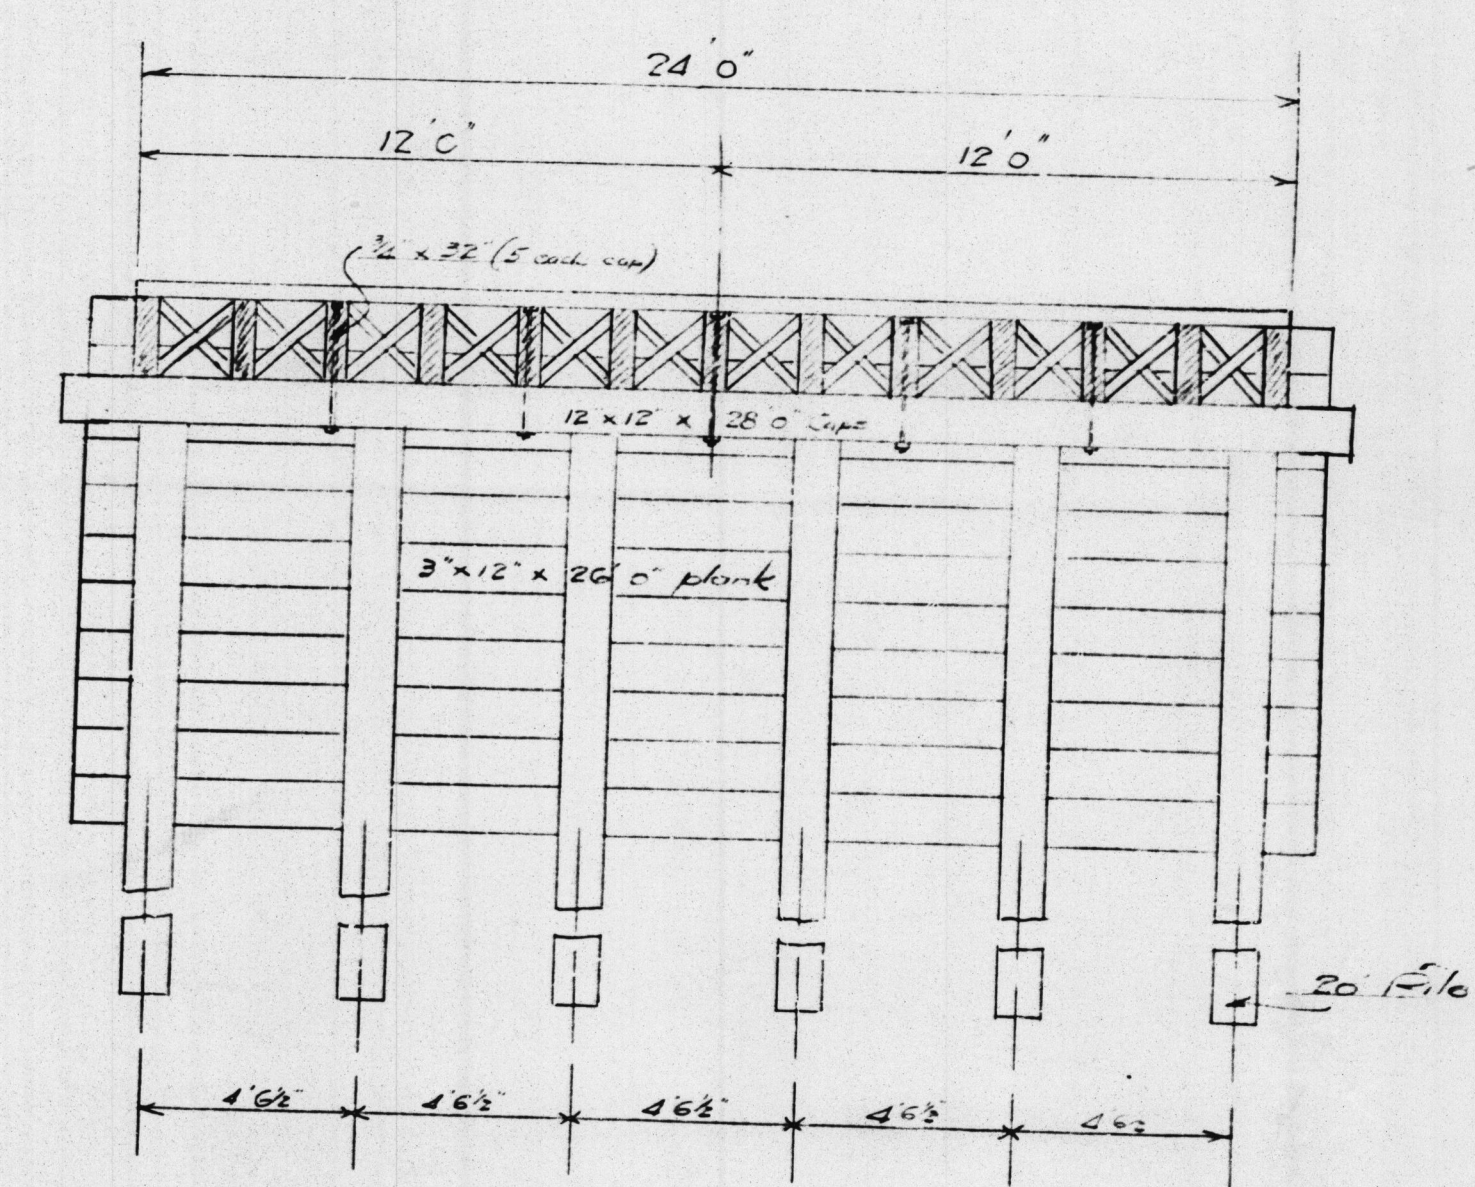
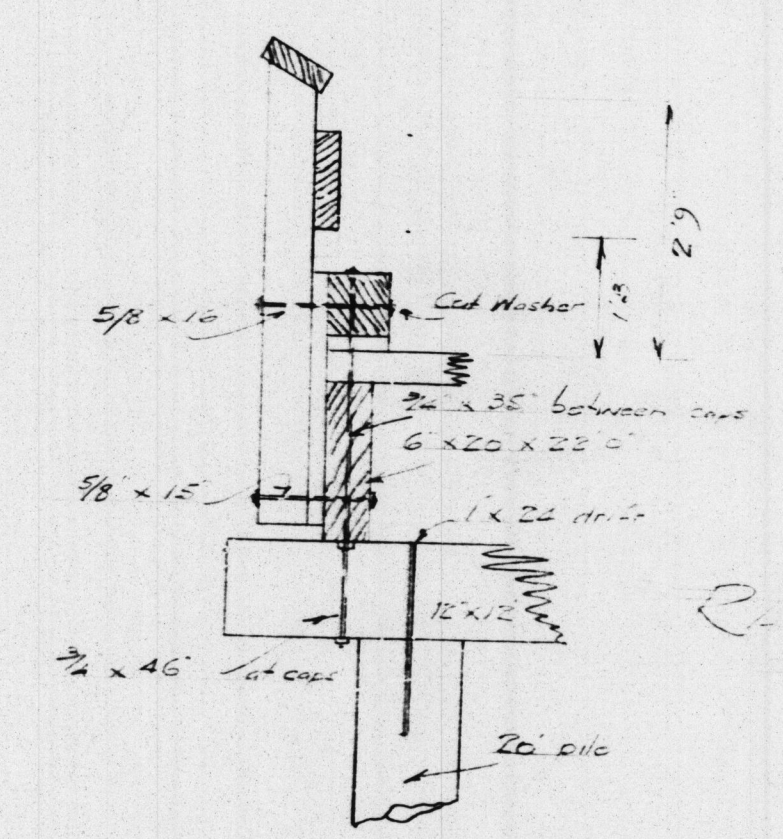


ORANGE COUNTY ROAD DEPARTMENT
 CULVERT #1
 CANYON ACRES DR.
 AT LAGUNA CANYON RD.
 OCT. 1939
 SCALES AS SHOWN

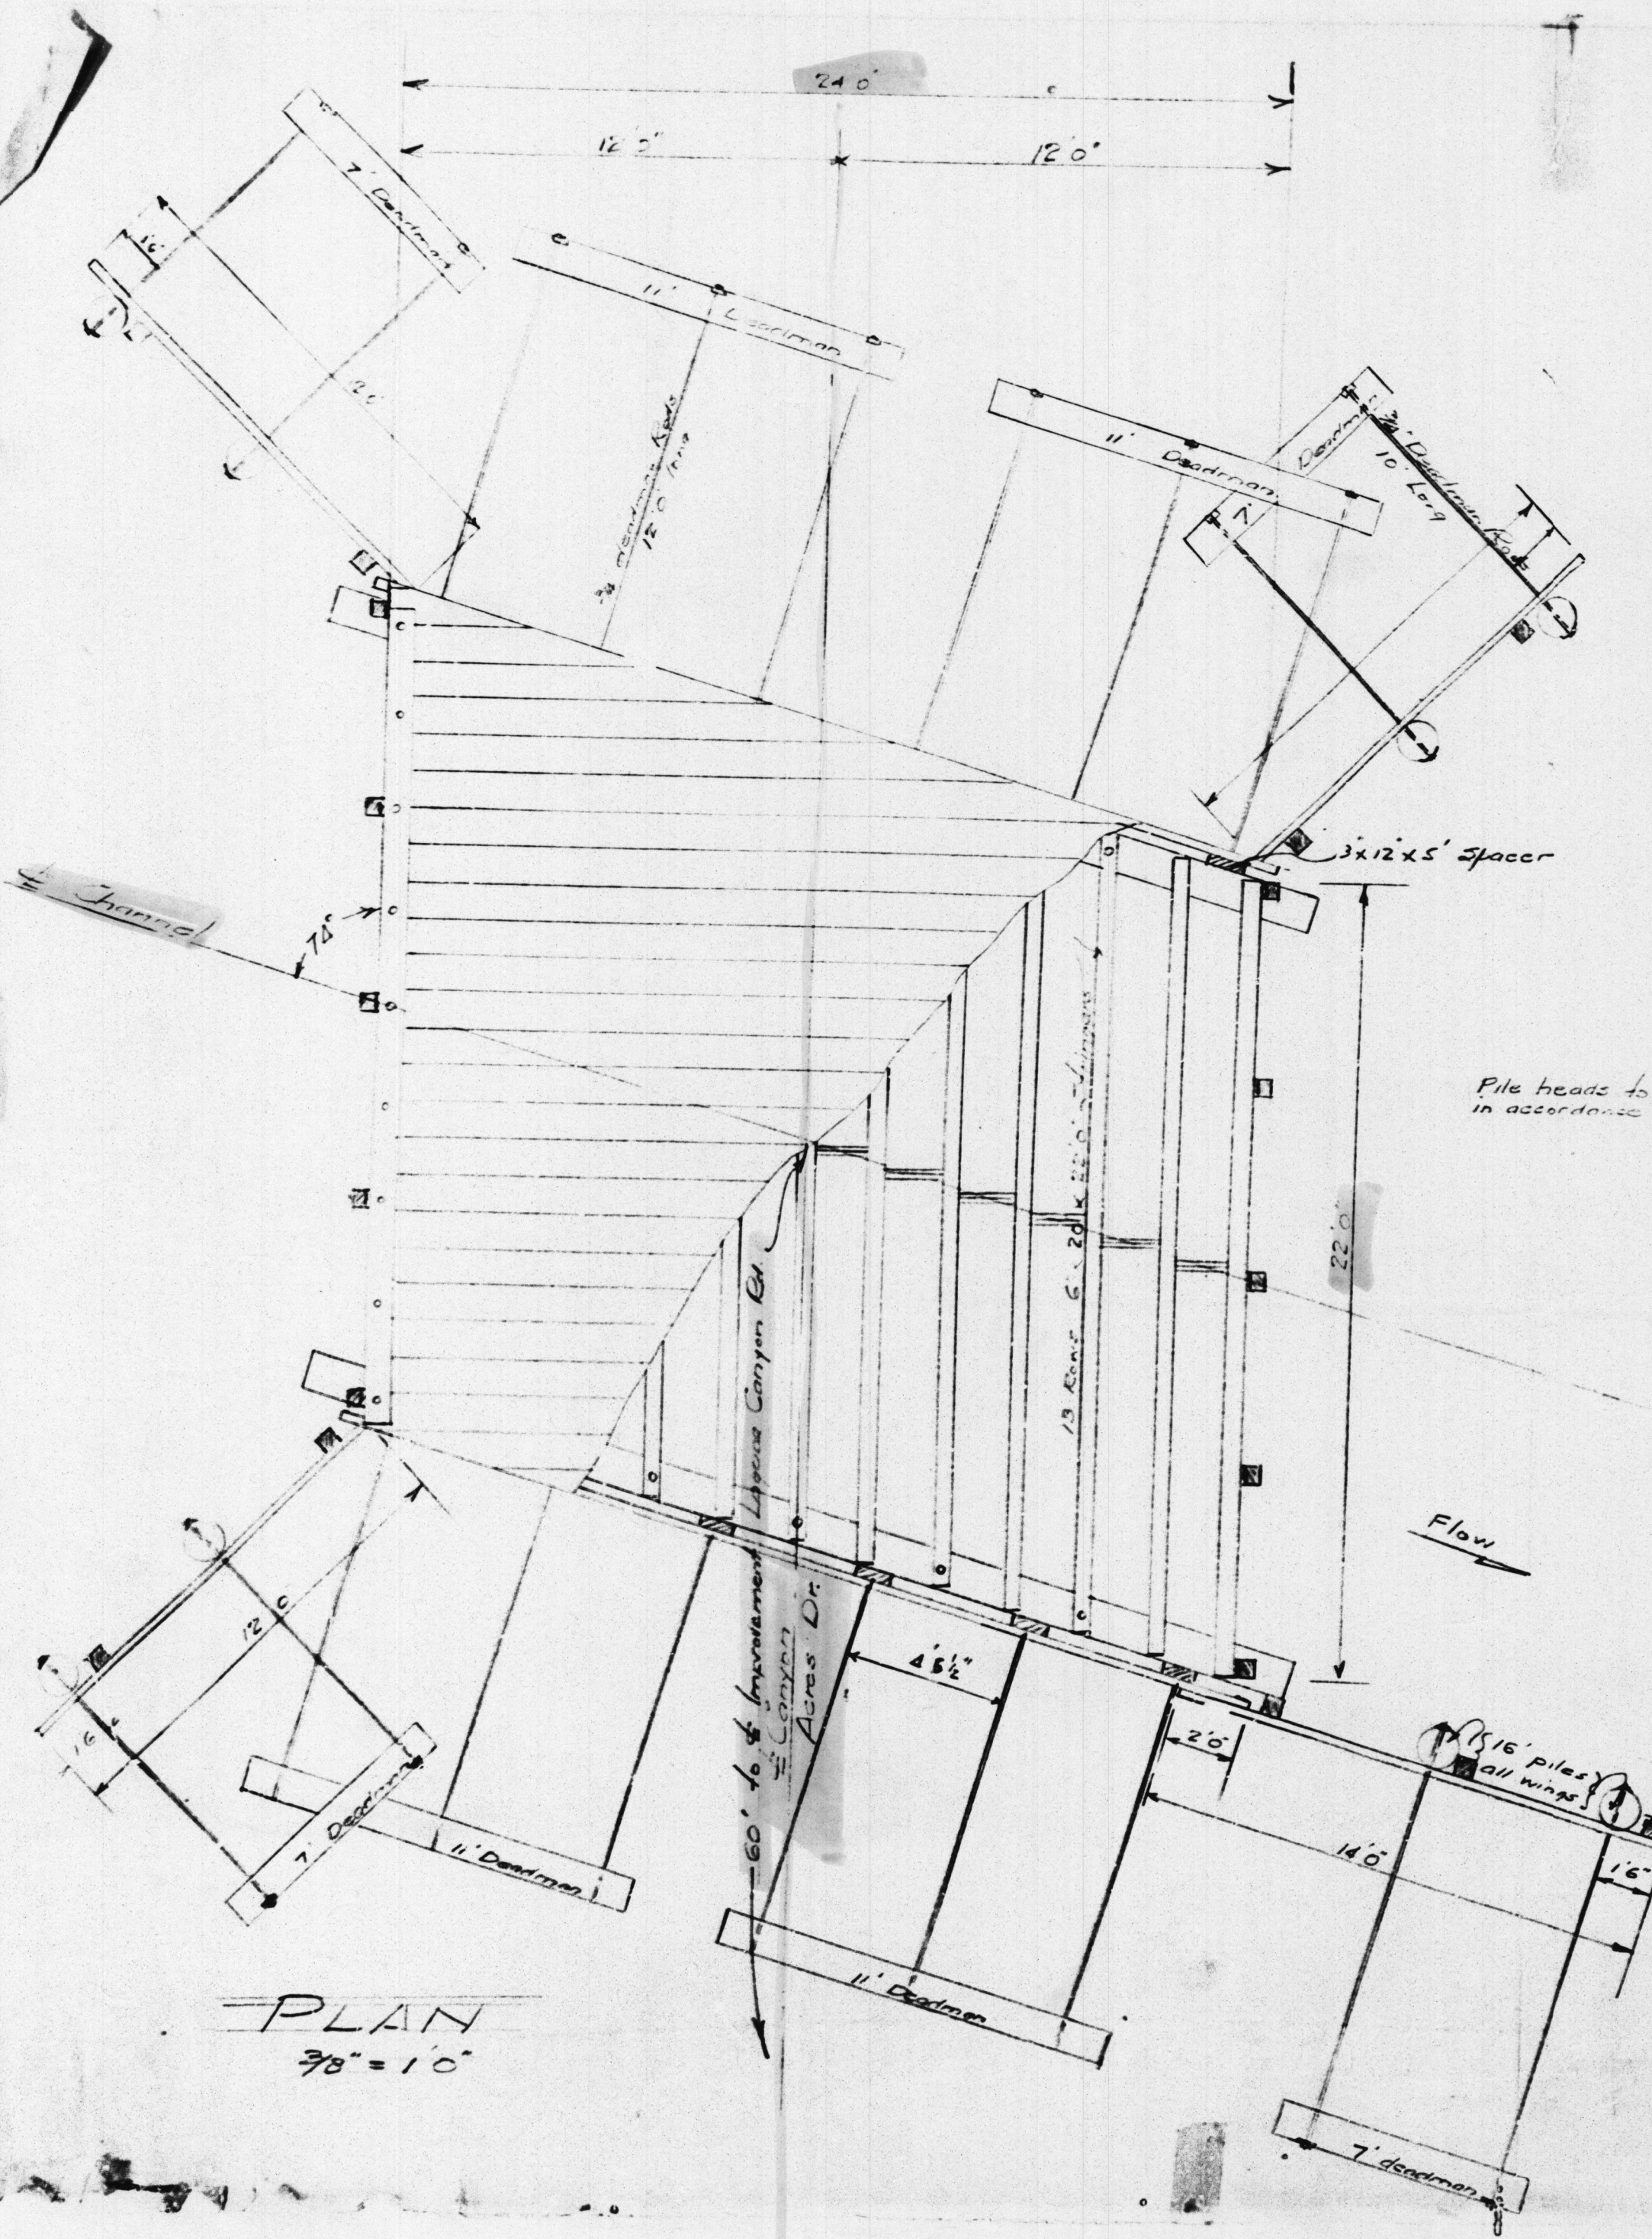

Pile heads to be treated with K.H. & C. in accordance with Standard Specifications

Culvert #8-24
 Canyon Acres Dr.
 at Laguna Cyn Rd.
 Sheet 1 of 1
 R.D. 275' Scale as shown
 Vellum-Pencil Sketch

JUL 6 1960

#14554 1939
 S-24
 Canyon Acres Dr. at
 Laguna Cyn Road.
 Thomas 950-H1, LAGUNA BEACH CITY