


9 10 11 12 13 14 15 16 17 19 20 21 22 23 24 25 26 27 28 29 30 31 32 33 34 35 36 37 38 39 40 41 42 43 44 45 46 47 49 50 51 52 53 54 55

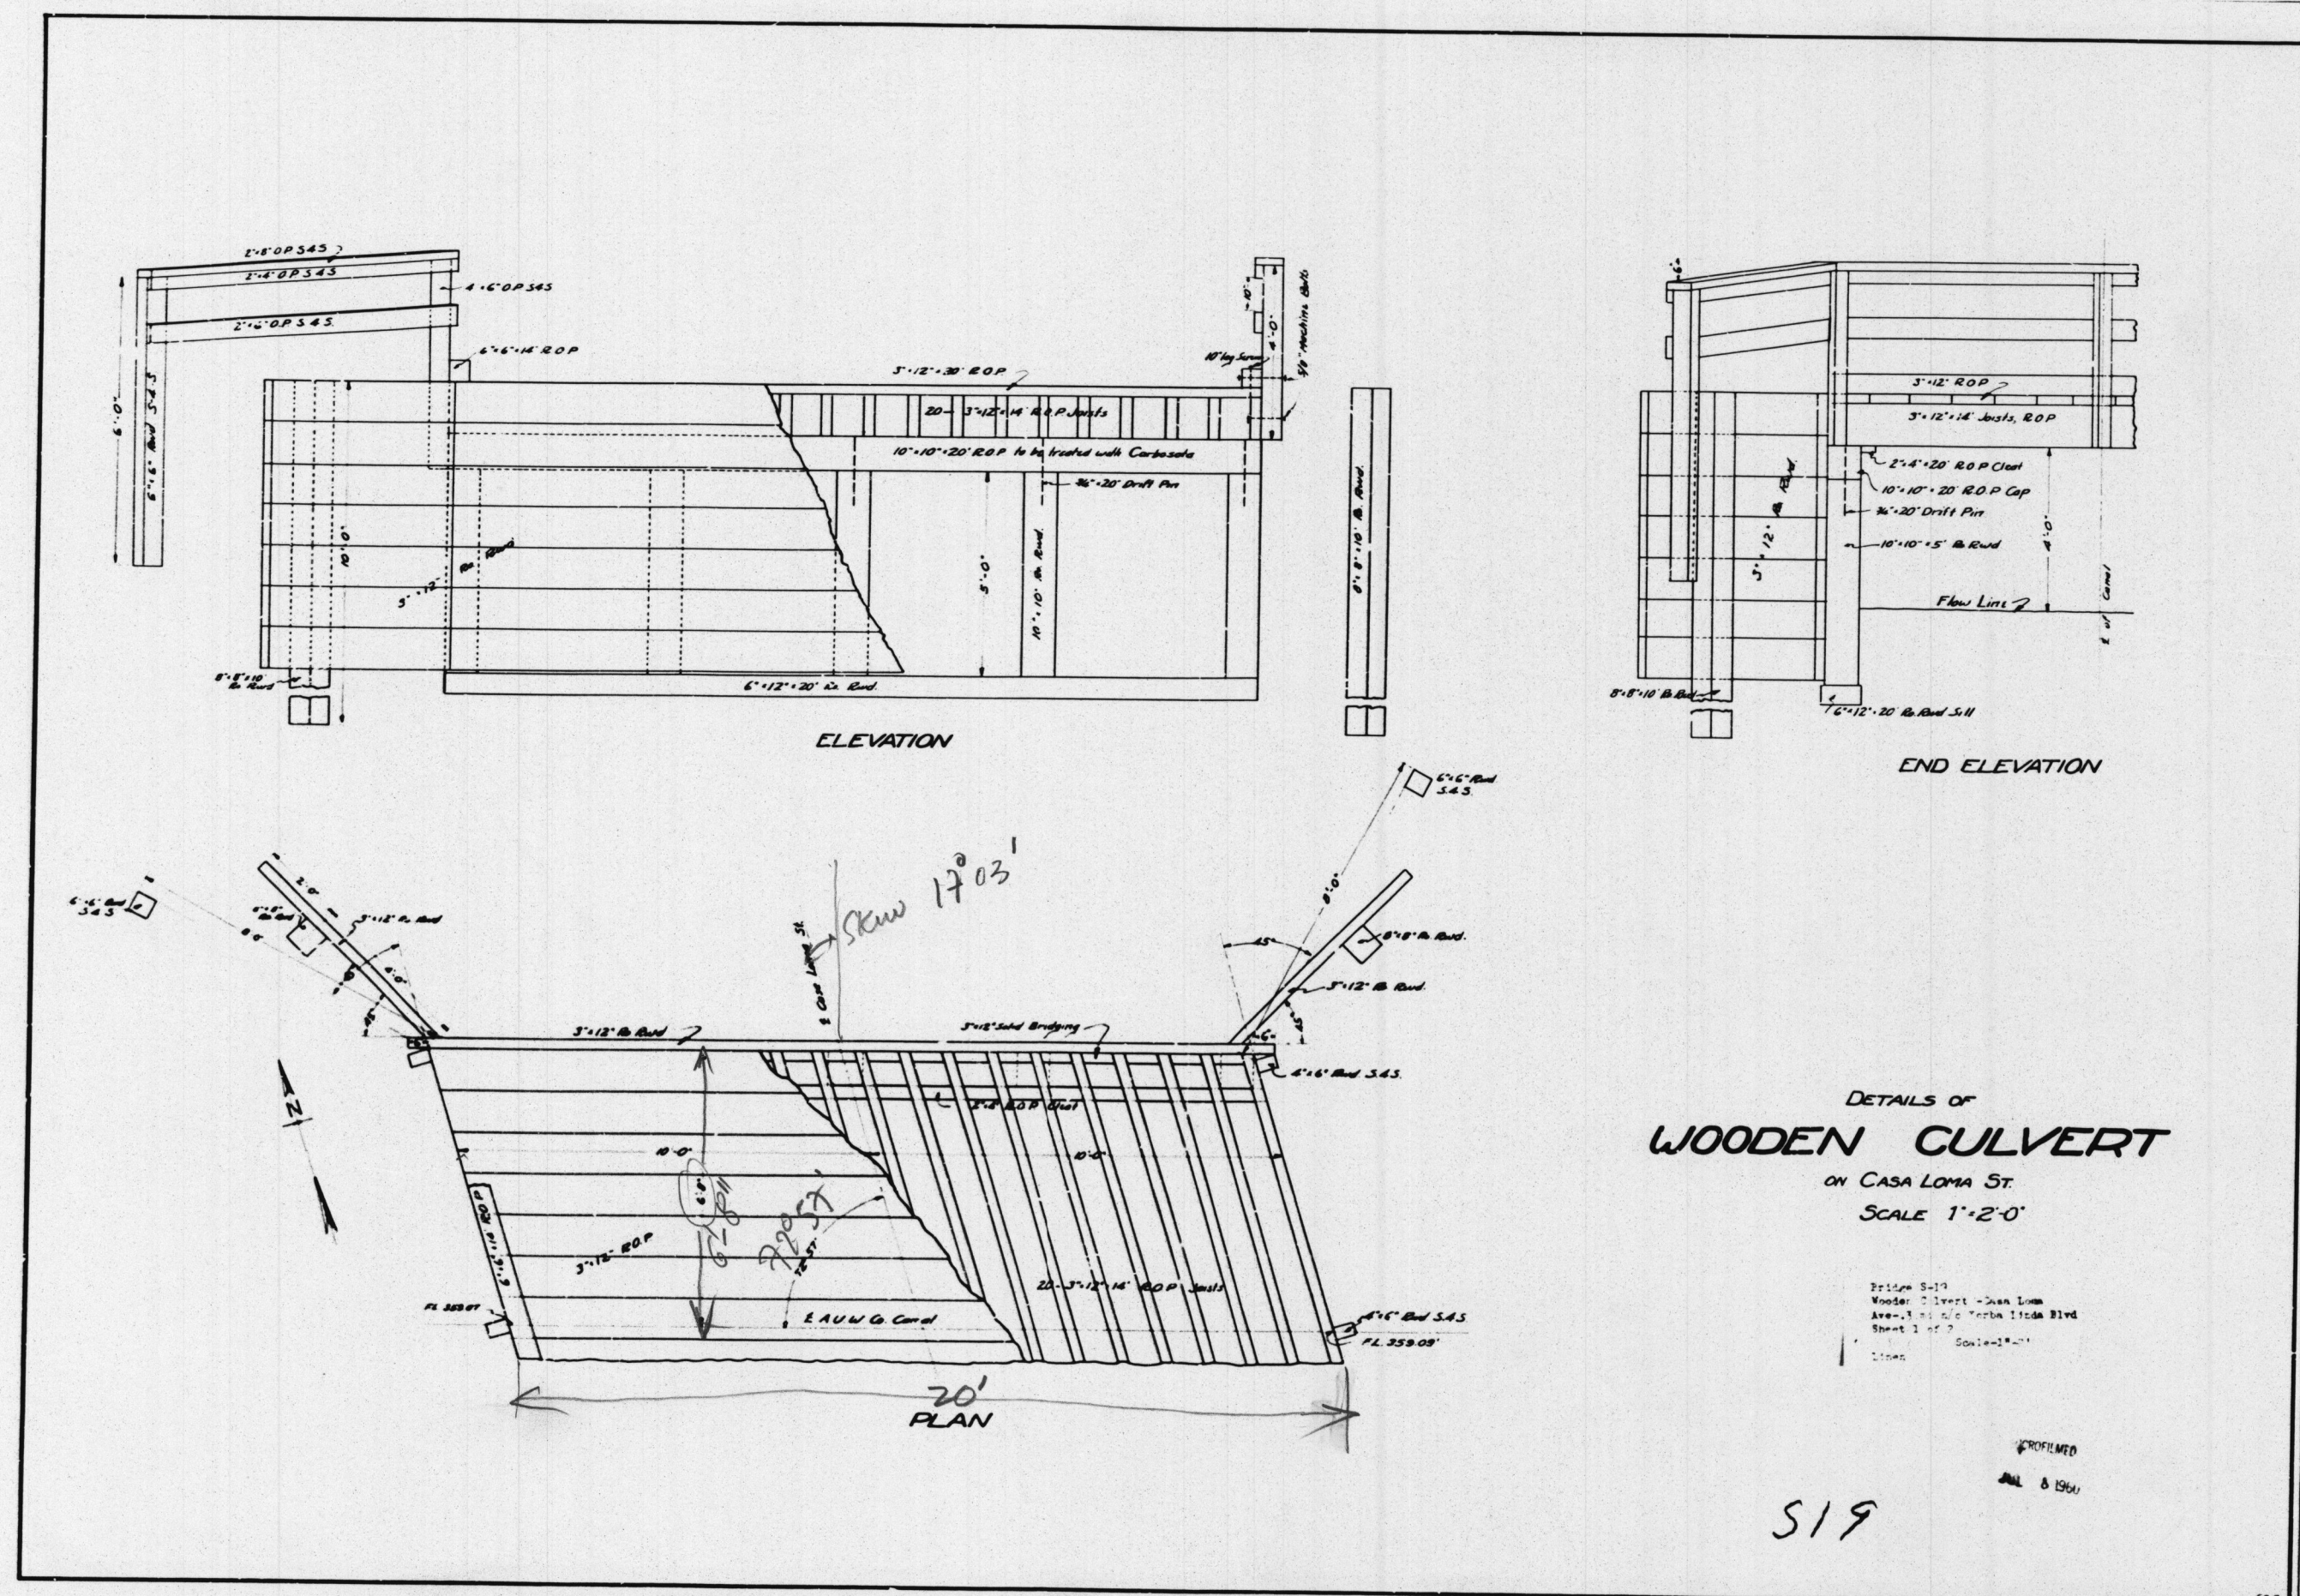

W = 24'8"
L = 20'
Skew = 17°3'

#14549 1943
(S-19)
CASA LOMA ST. AVE.
0.3 Mi N/OF JORBA LINDA BLVD
Thomas 740-A4