
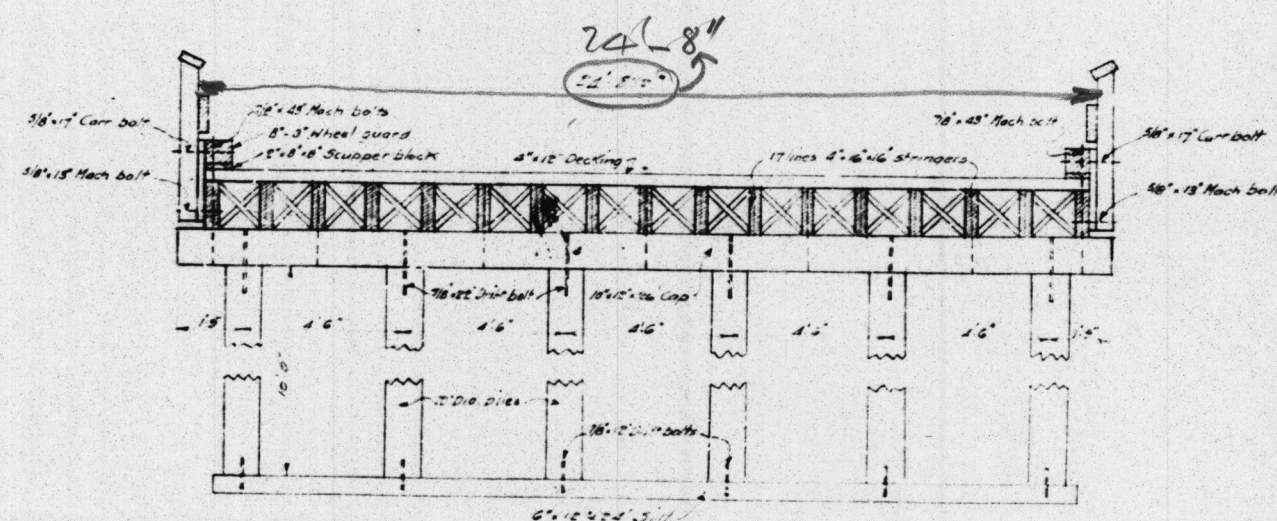
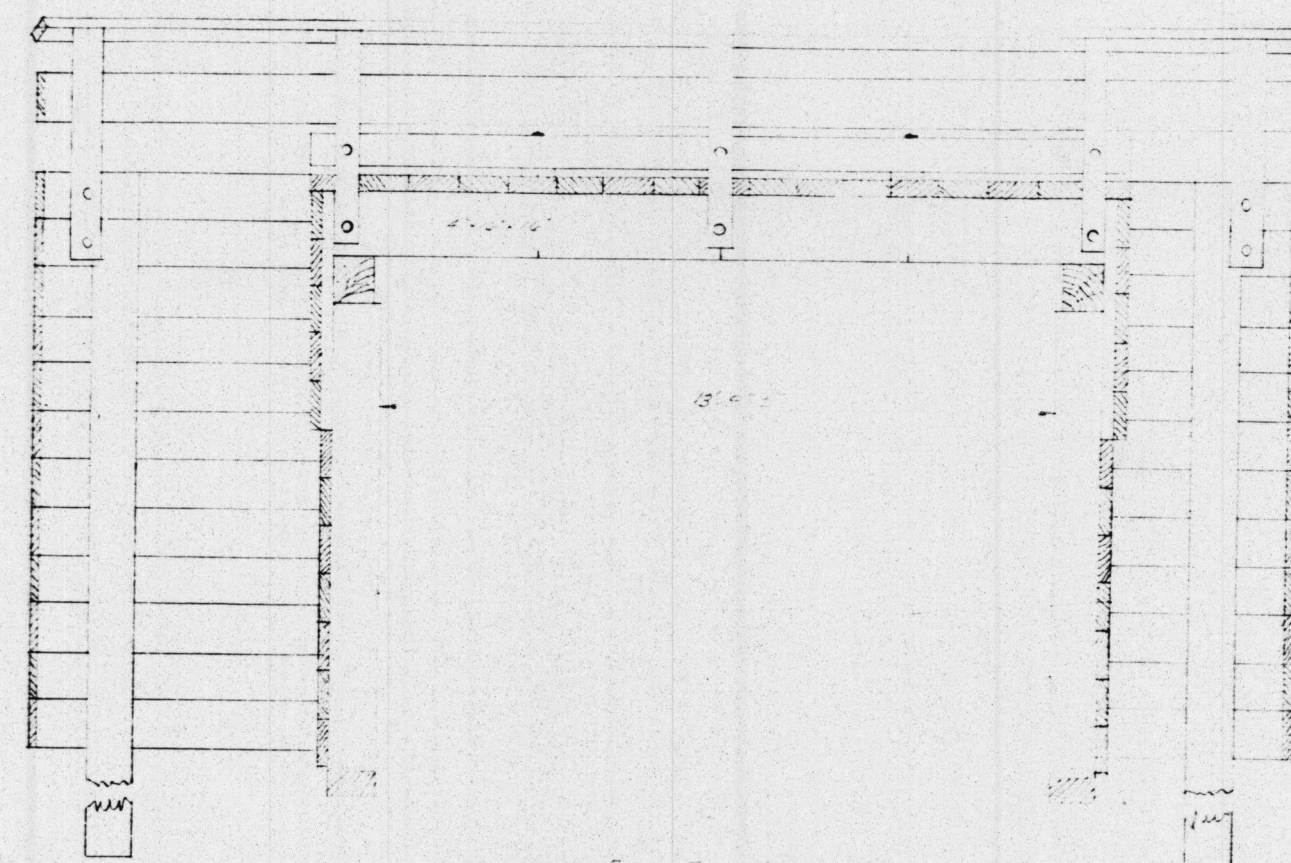


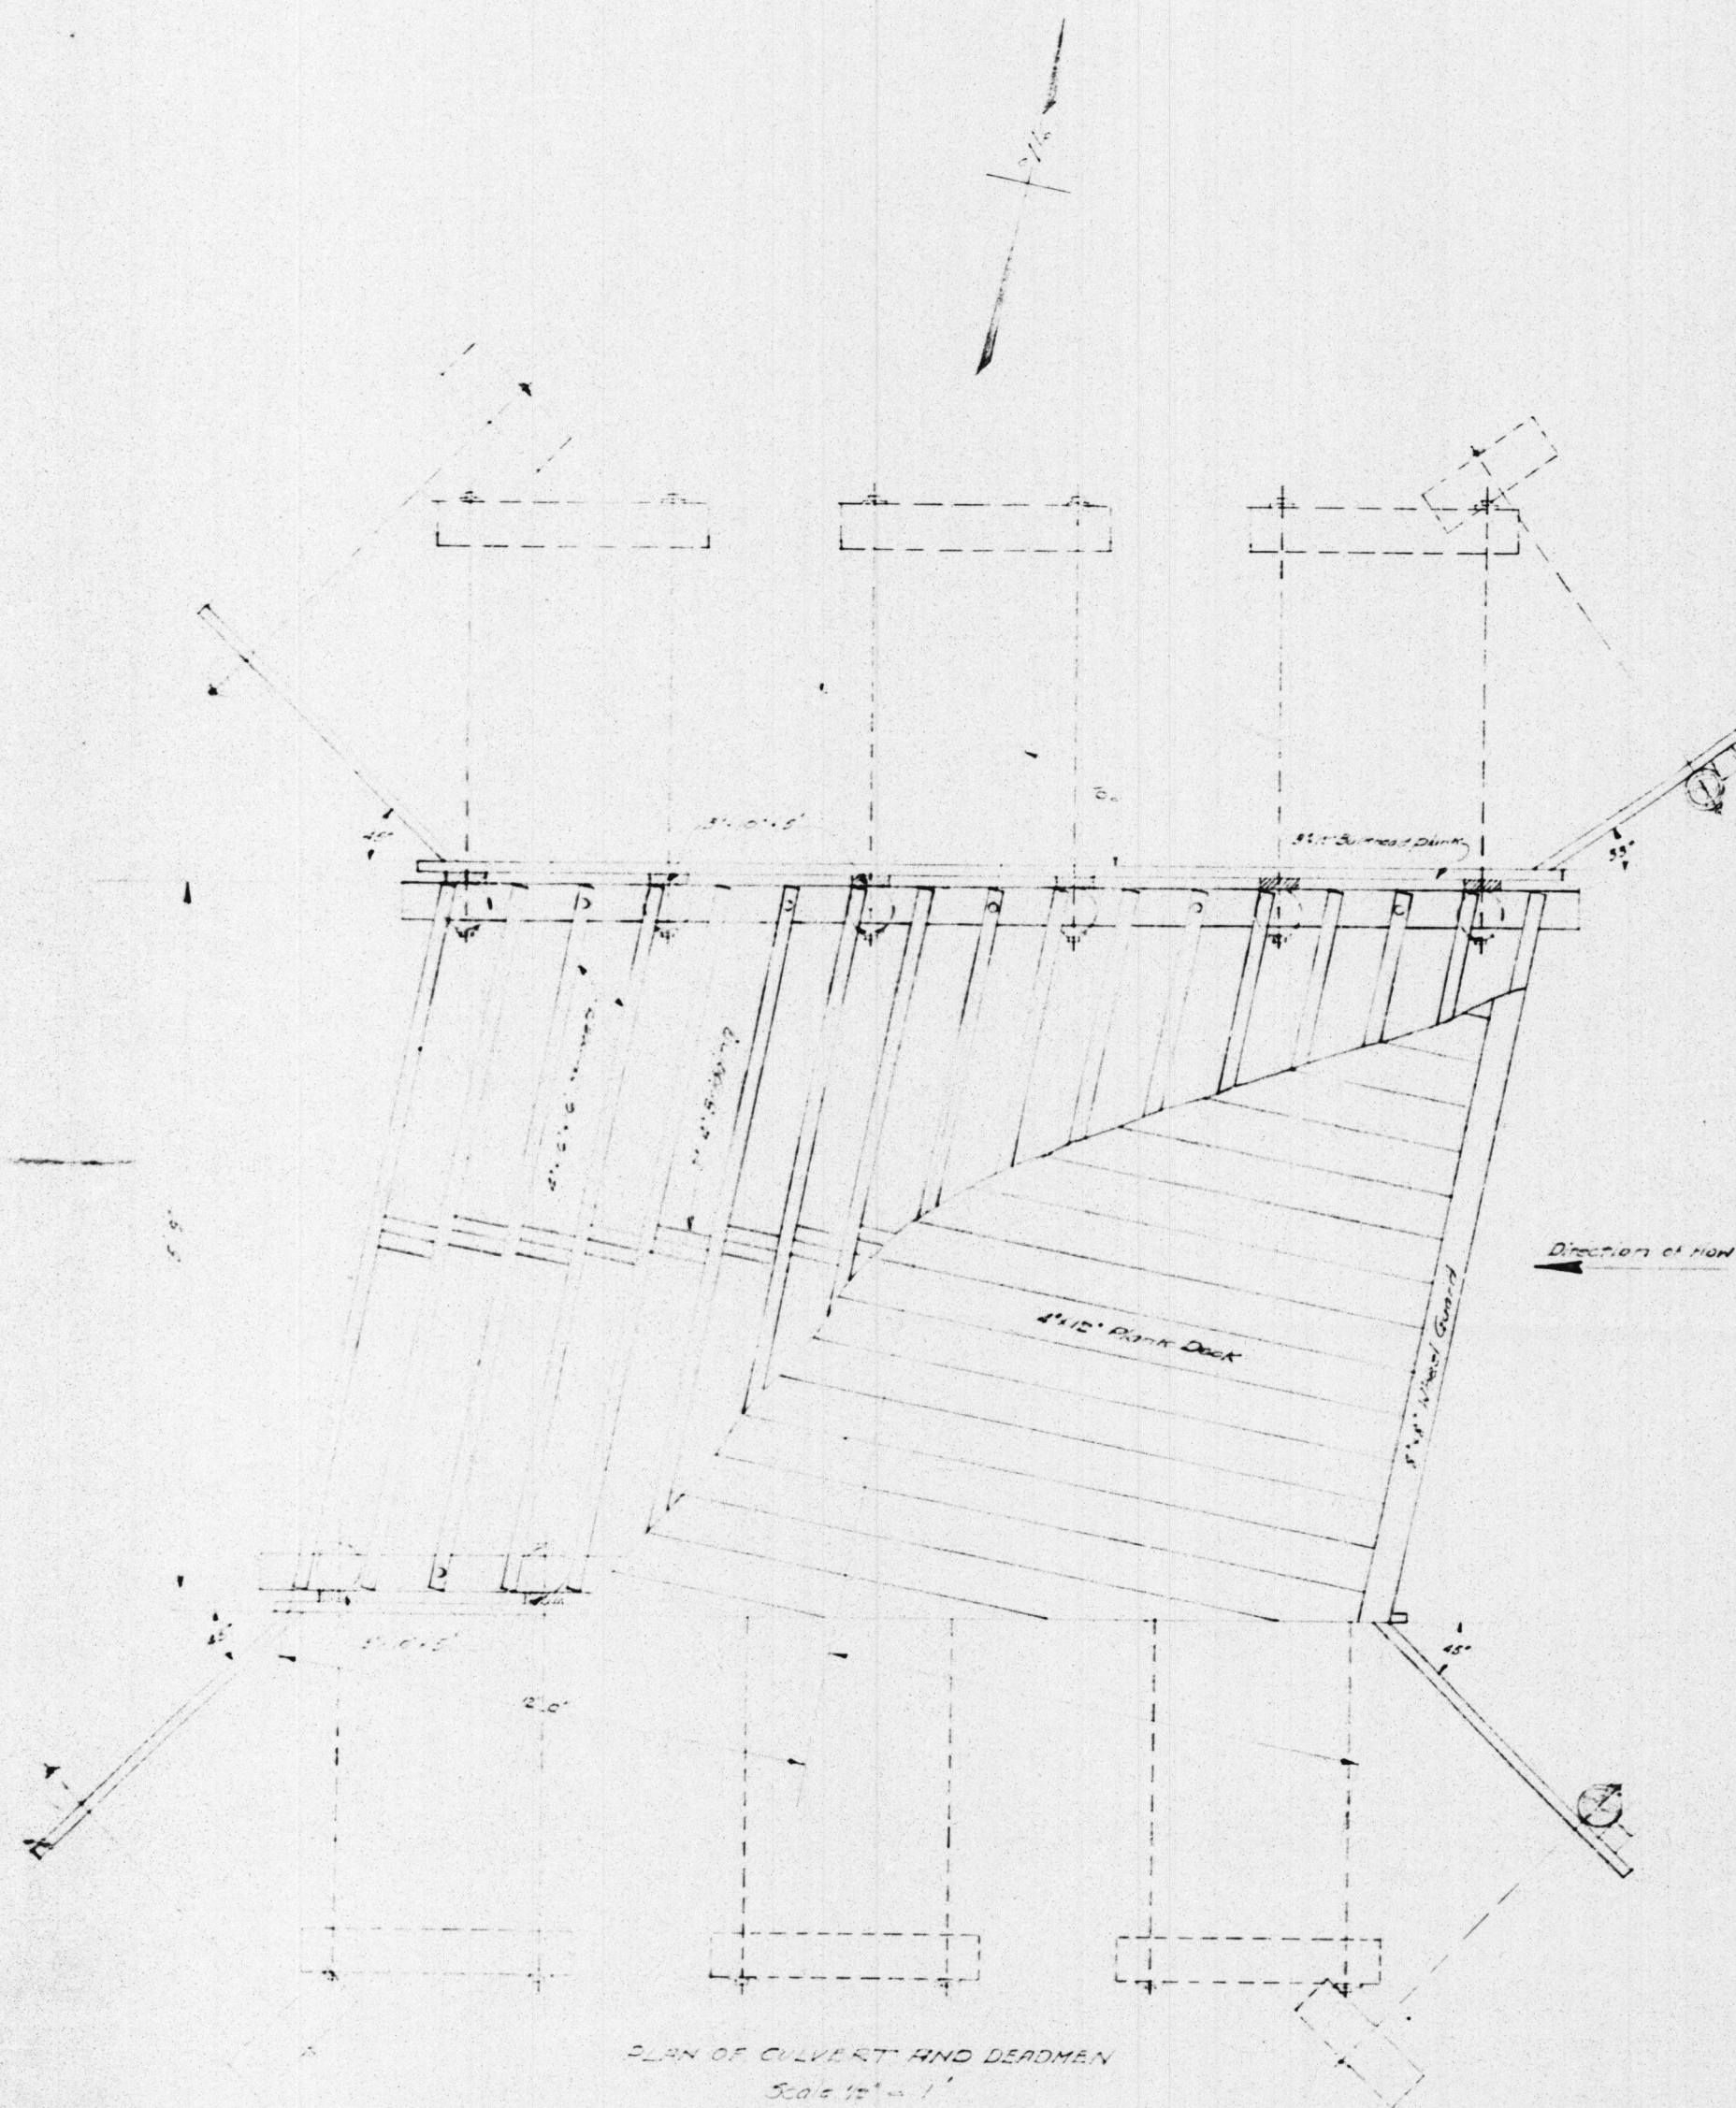

NOTES

All sawn lumber, except when surfaced to be select structural grade Douglas fir (stringers to be S.1.S.) and to be creosoted or empty cell treatment. The posts are to be Douglas fir creosoted. Wheel guards, handrails and posts to be structural grade Douglas fir. Hardware is to be galvanized hot dipped when same is available. After galvanized hardware is not obtainable it shall be made up from material now in stock. Deadmen shall be made from 12" diameter creosoted piles or posts. Deadmen rods to be 1/2" diameter 10' in length threaded 3" both ends.

Bridge 5-19
Wooden Culvert-Casa Loma
Area 3 at 1/2 mile Torba Linda Blvd
Sheet 2 of 2
Scale-As Shown
Francis Nelson

ORANGE COUNTY ROAD DEPT.
WOODEN CULVERT
CASA LOMA AVENUE
0.3 MI. N. OF TORBA LINDA BLVD
STRUCTURE No 19
Scales as shown Nov 1943

MICROFILMED
JUL 3 1960