


15 16 17 18 19 20 21 22 23 24 25 26 27 28 29 30 31 32 33 34 35 36 37 38 39 40 41 42 43 44 45 46 47 48 49 50

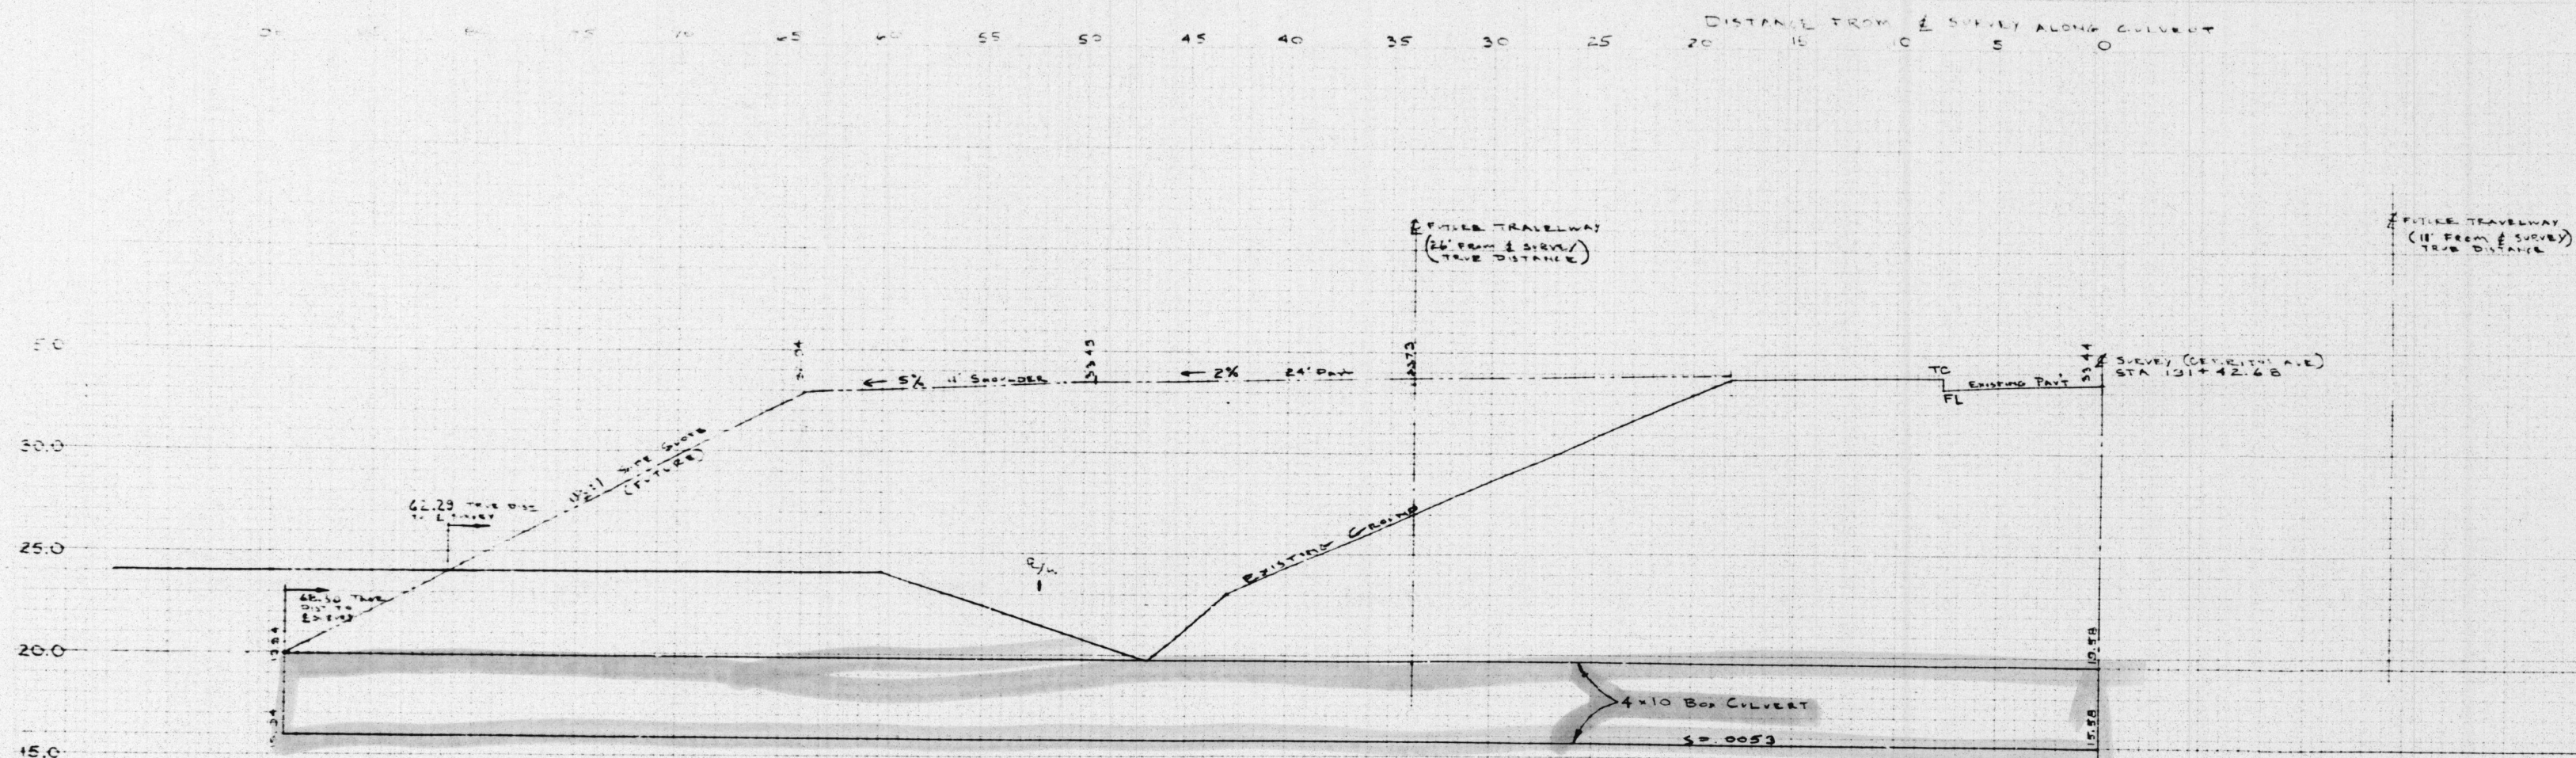

SECTION TAKEN AT CULVERT AND PARALLEL TO CULVERT (LOOKING EASTWARD)
TOTAL LENGTH OF CULVERT = $66.55 + 10 / 74782341 = 141.23'$
SCALE: 1" = 5'

Structure# C1-1
Cerritos Ave Bridge over
Channel #1 w/o Los Alamitos
Sheet 2 of 4
Red: 22.5' Scale 1"=40' H
1"=4' V
X-Section

MICROFILMED
JUL 5 1960