
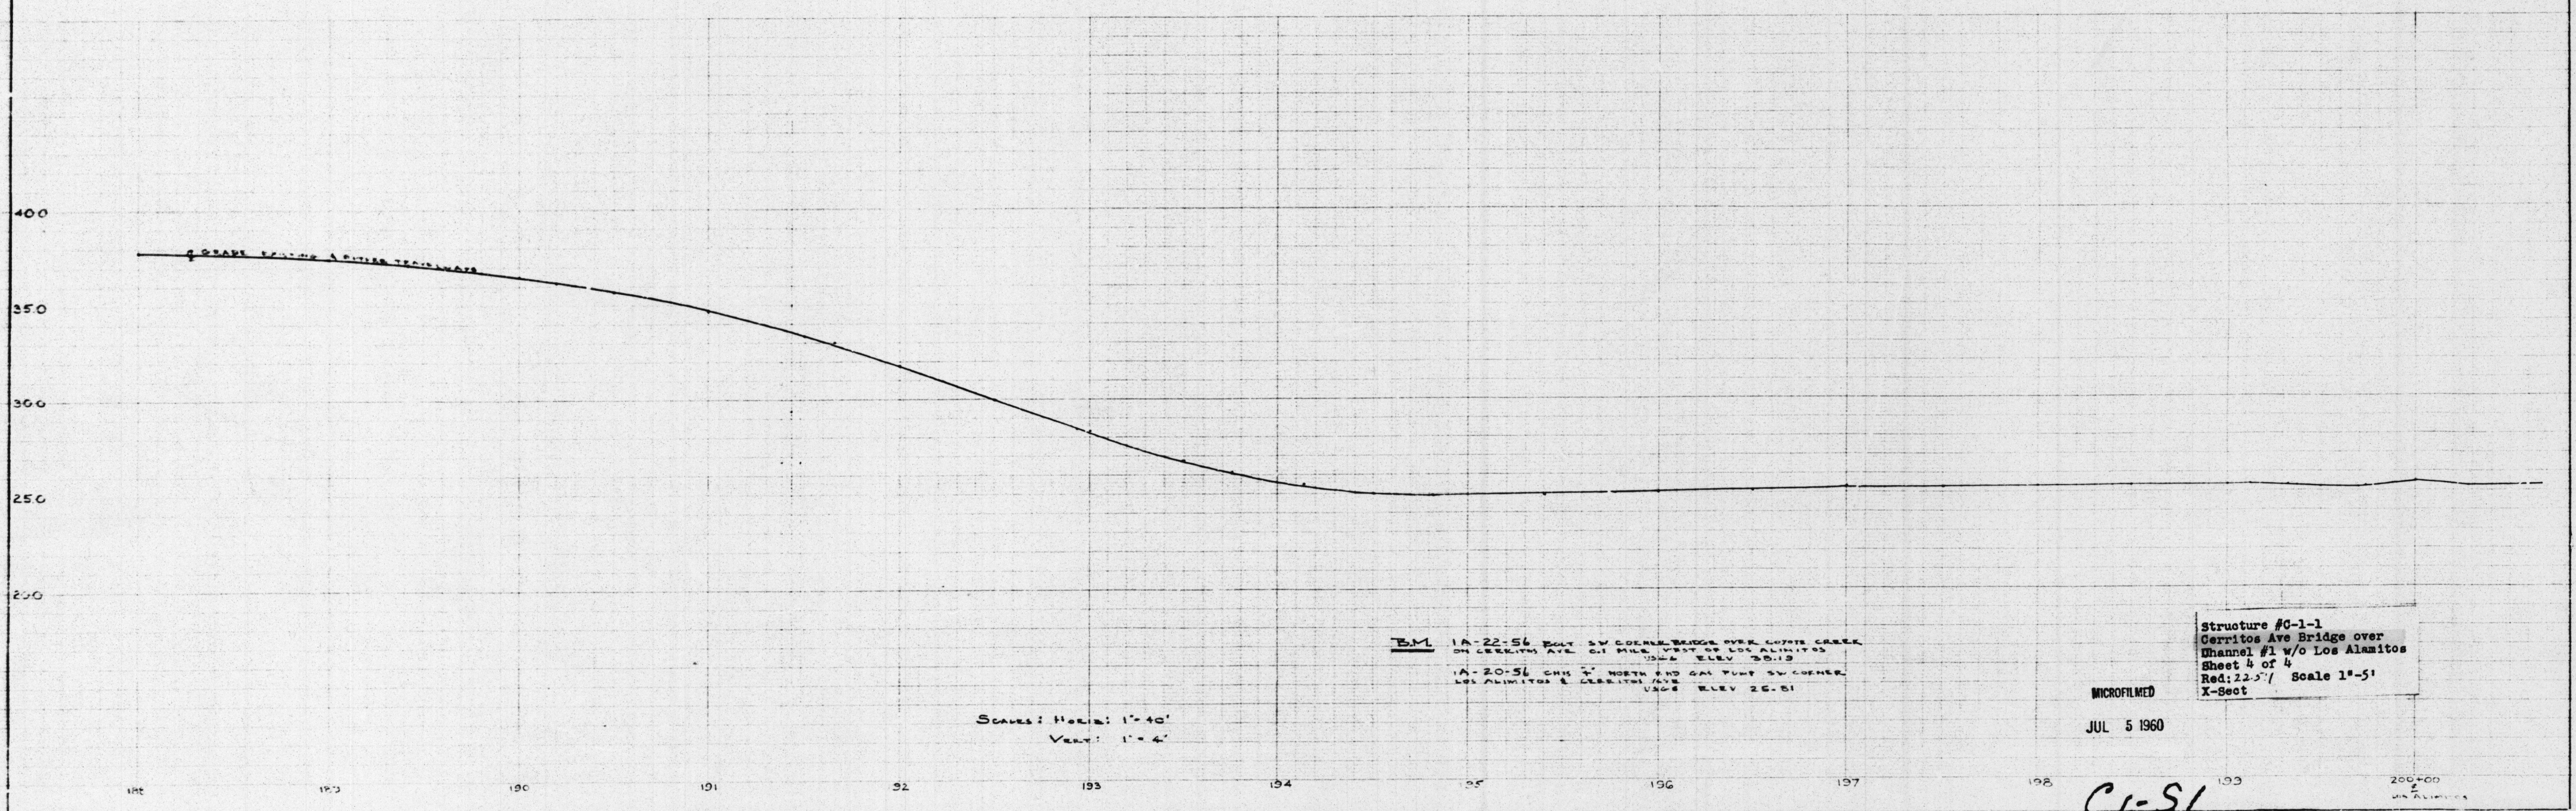


15 16 17 18 19 20 21 22 23 24 25 26 27 28 29 30 31 32 33 34 35 36 37 38 39 40 41 42 43 44 45 46 47 48 49 50

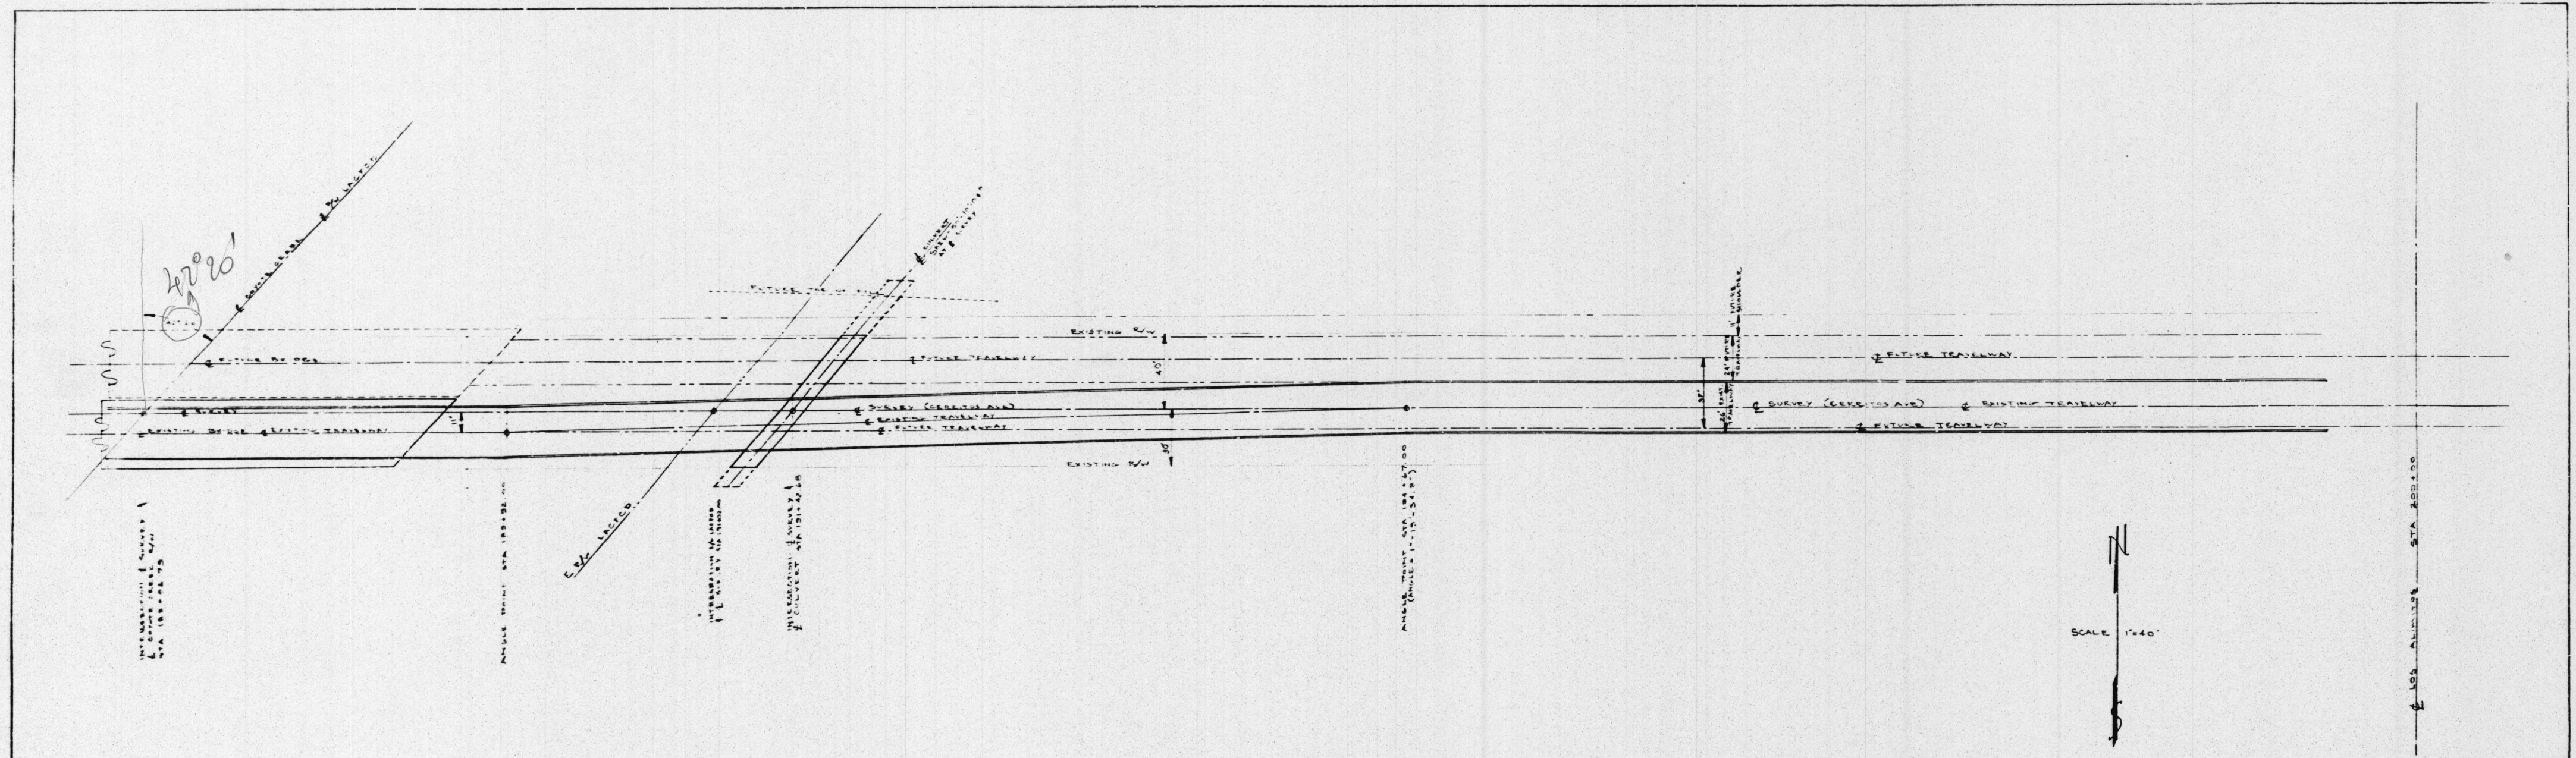

B.M. 1A-22-56 BOLT SW CORNER BRIDGE OVER LOS ALAMOS CREEK
ON CERRITOS AVE 0.1 MILE WEST OF LOS ALAMOS
DATA ELEV 25.13

1A-20-56 CHIS 2" NORTH END GAL PUMP SW CORNER
LOS ALAMOS & CERRITOS AVE
DATA ELEV 25.51

Structure #C-1-1
Cerritos Ave Bridge over
Channel #1 w/o Los Alamos
Sheet 4 of 4
Red: 22.5' Scale 1"=5'
X-Section

MICROFILMED
JUL 5 1960

C1-S1