


14 15 16 17 18 19 20 21 22 23 3ft.

26 27 28 29 30 31 32 33 34 35 3ft. 37

39 40 41 42 43 44 45 46 47 4ft. 48

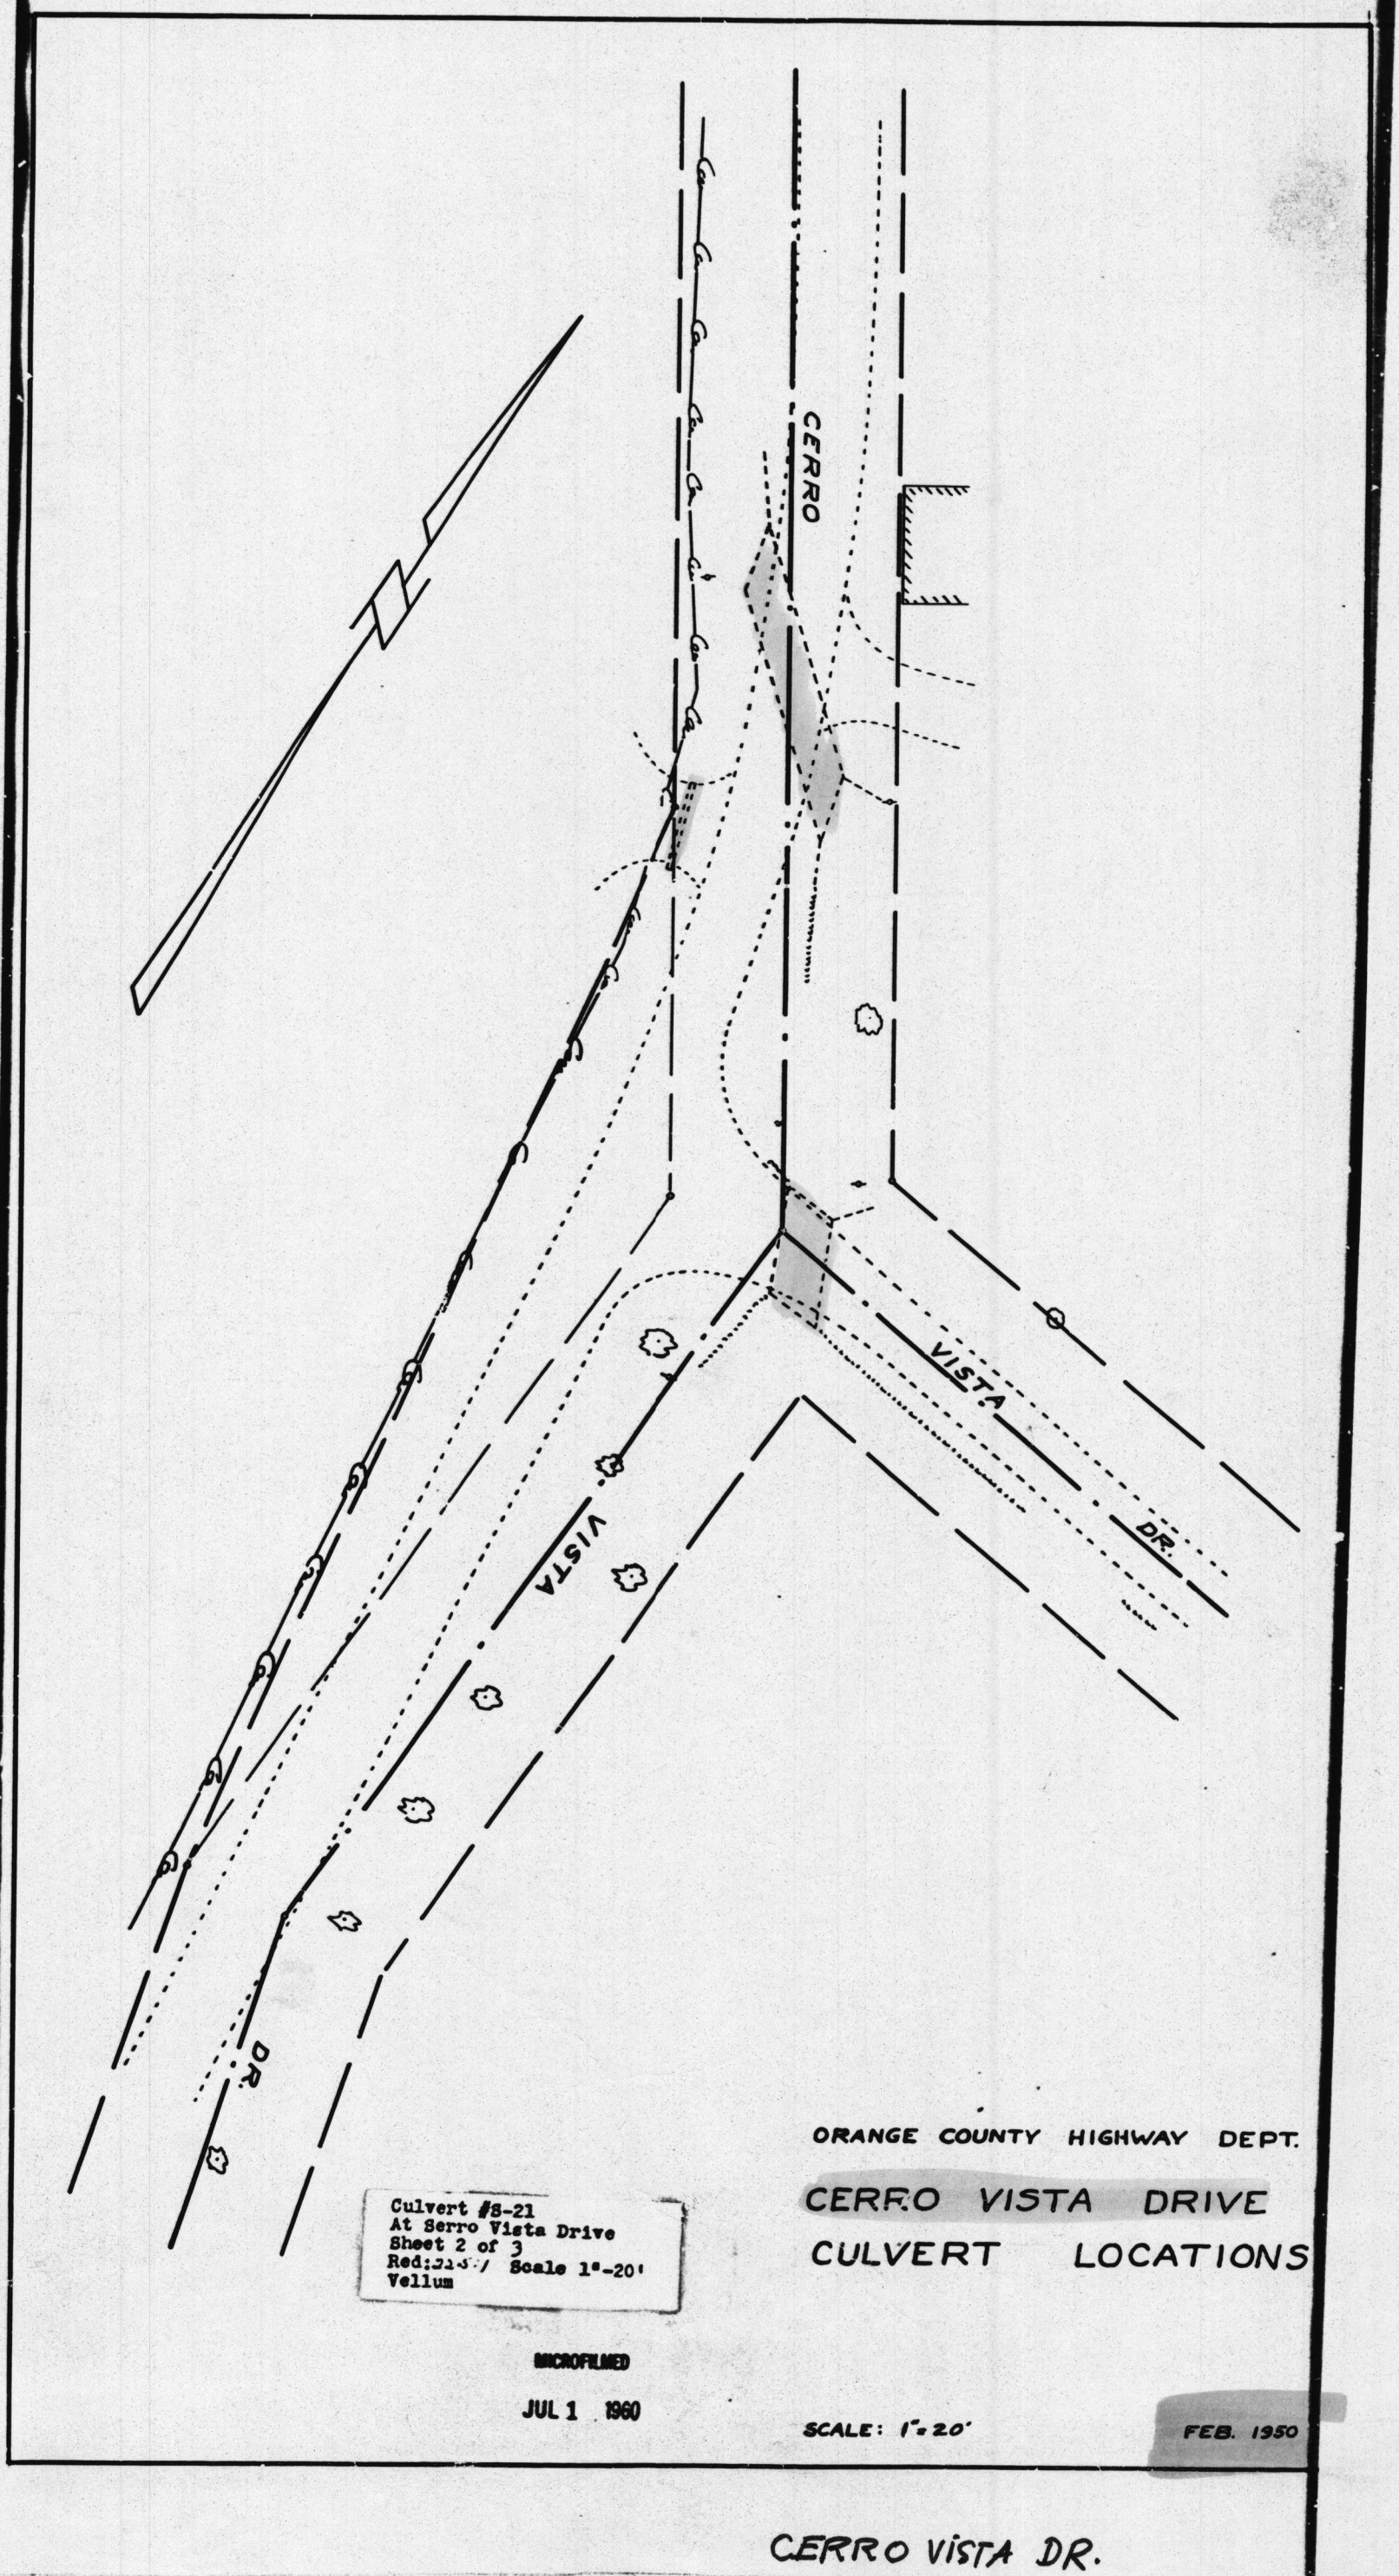

Culvert #8-21
At Cerro Vista Drive
Sheet 2 of 3
Red: 11-13-57 / Scale 1"=20"
Vellum

ORANGE COUNTY HIGHWAY DEPT.
CERRO VISTA DRIVE
CULVERT LOCATIONS

MICROFILMED
JUL 1 1960

SCALE: 1"=20"

FEB. 1950

CERRO VISTA DR.