


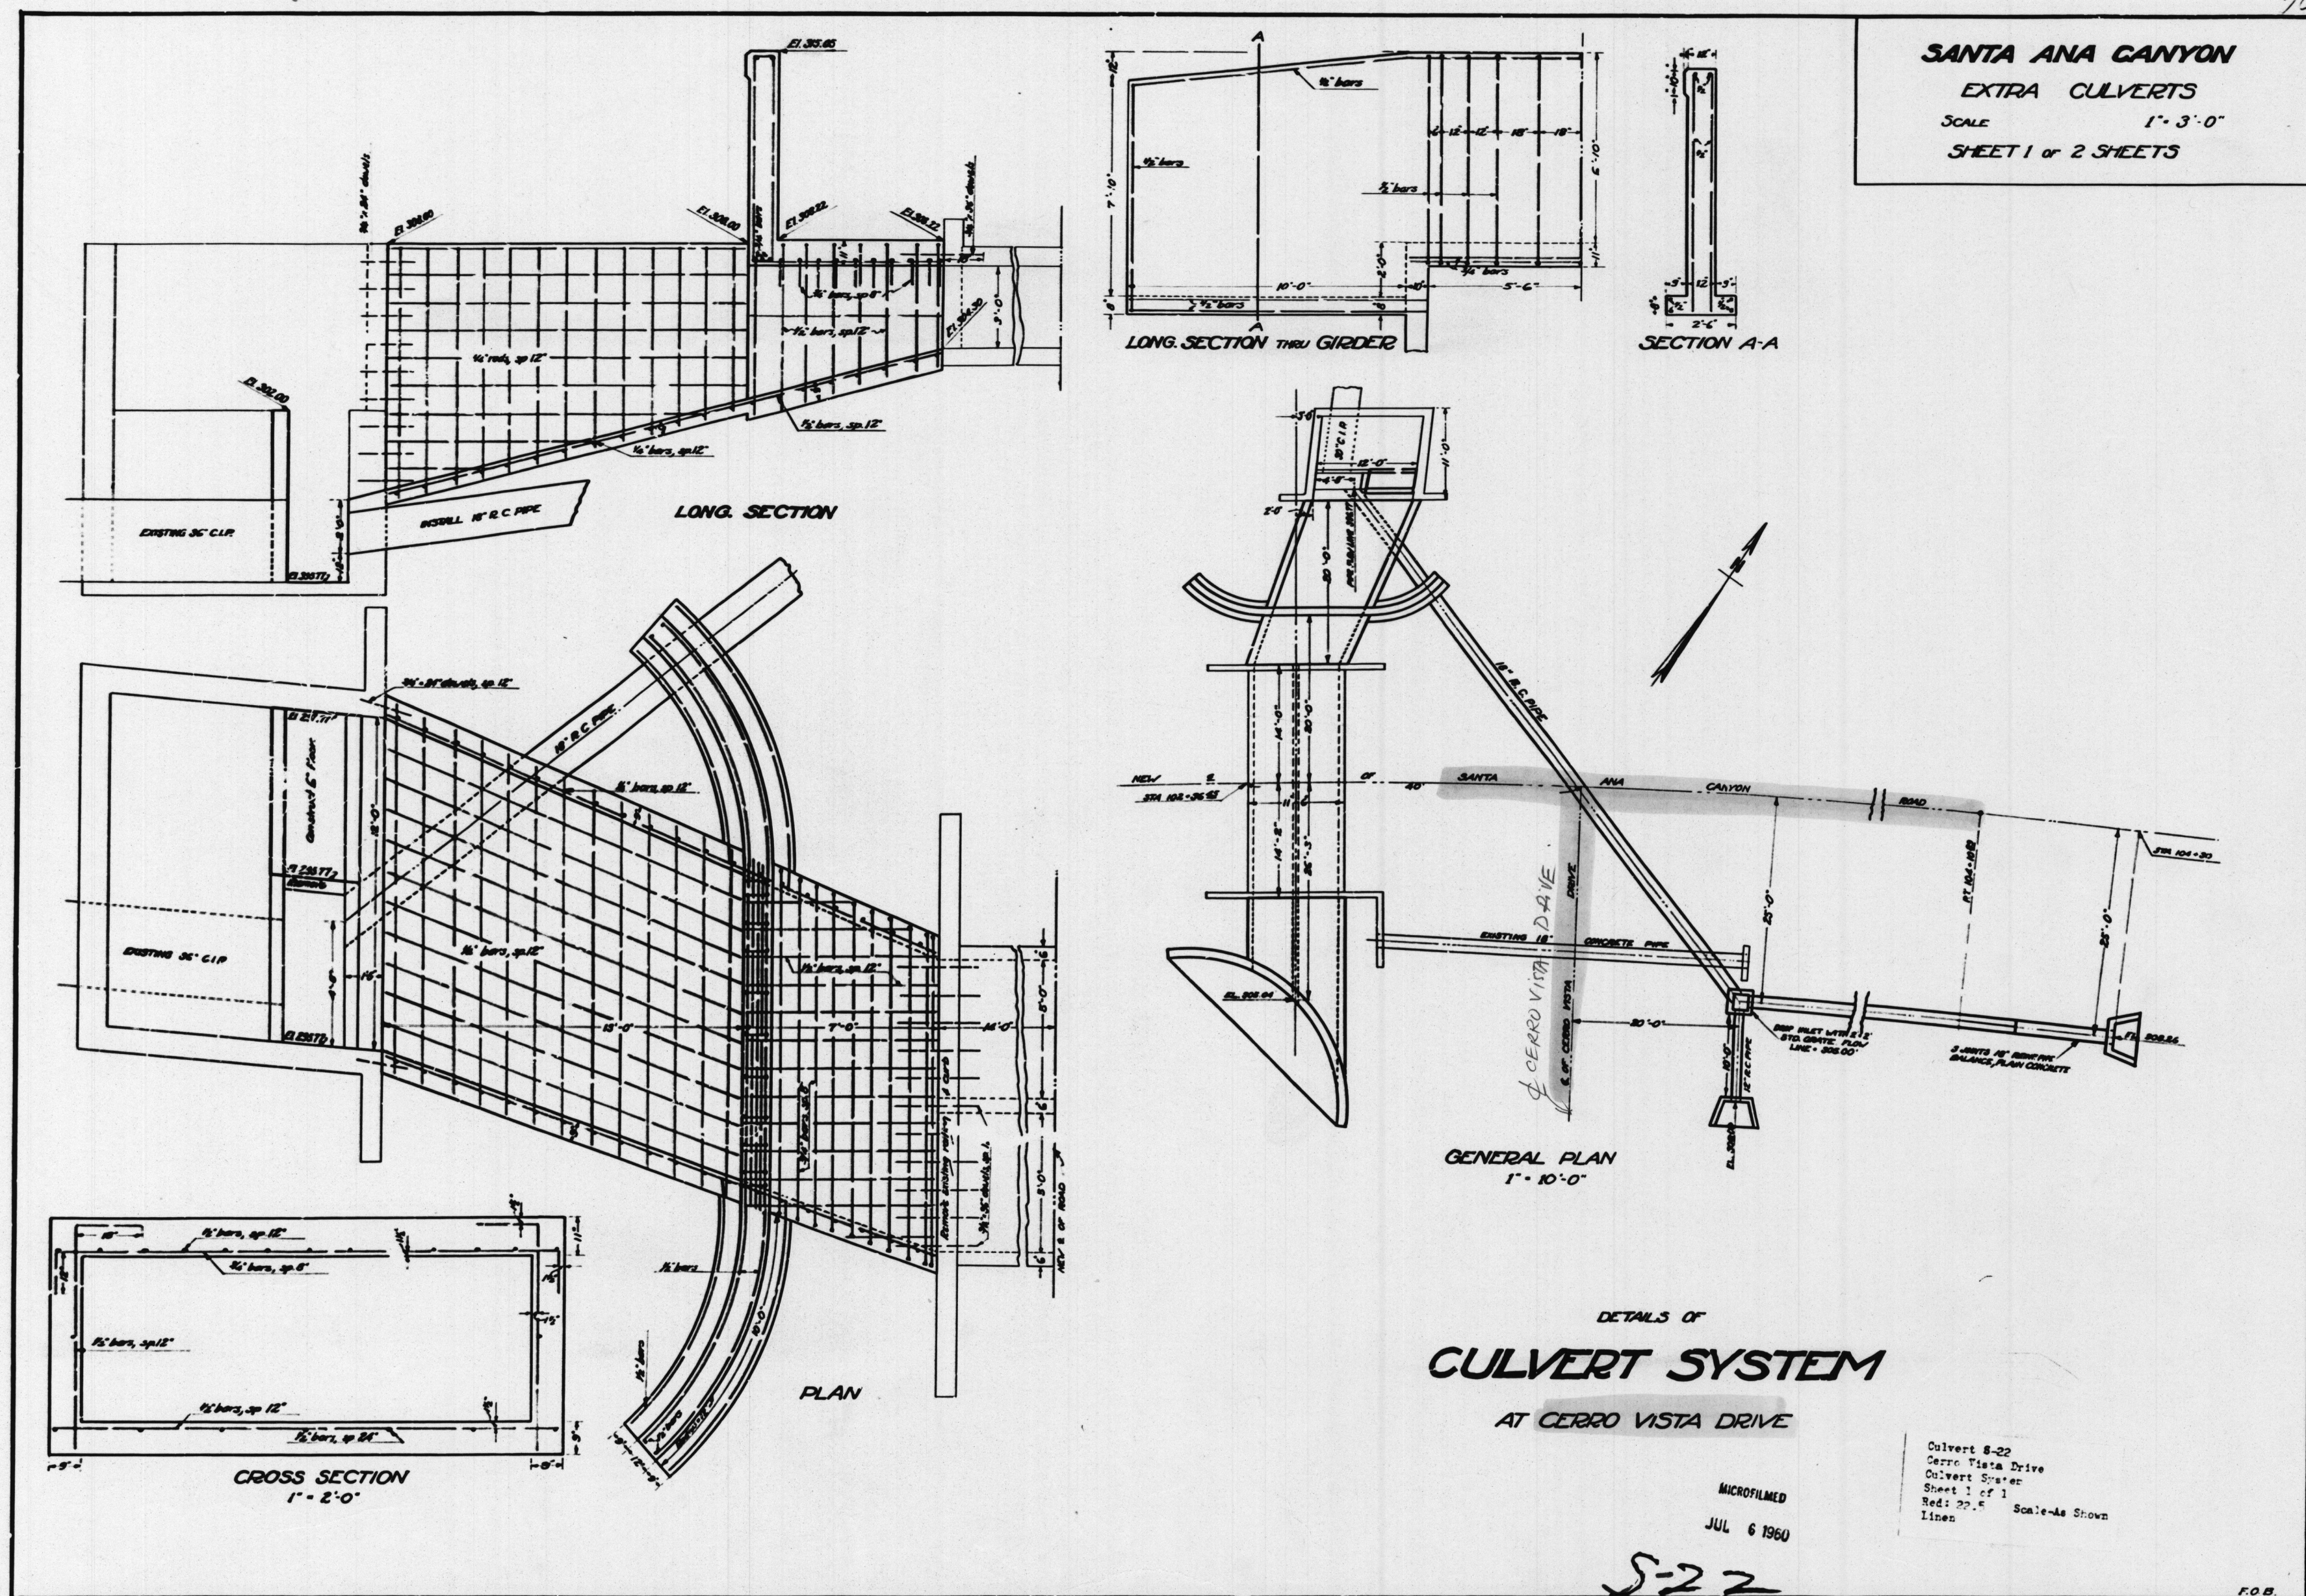

#14553
 (S-22) 2 1950
 CERRO VISTA DR.

Thomas 770-B3