

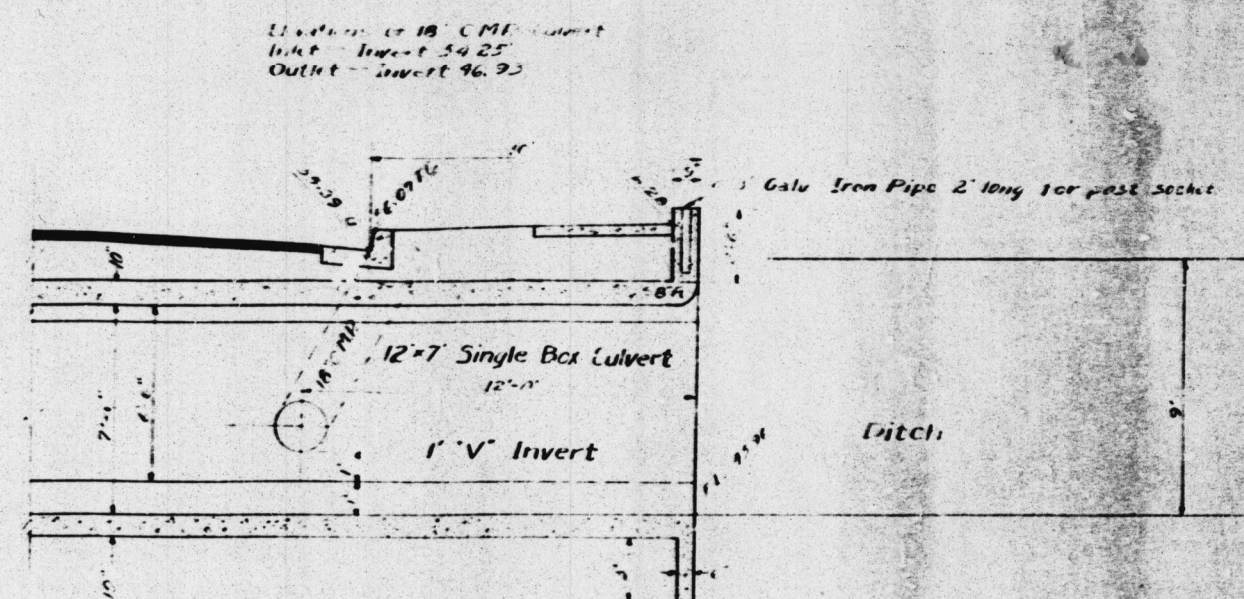


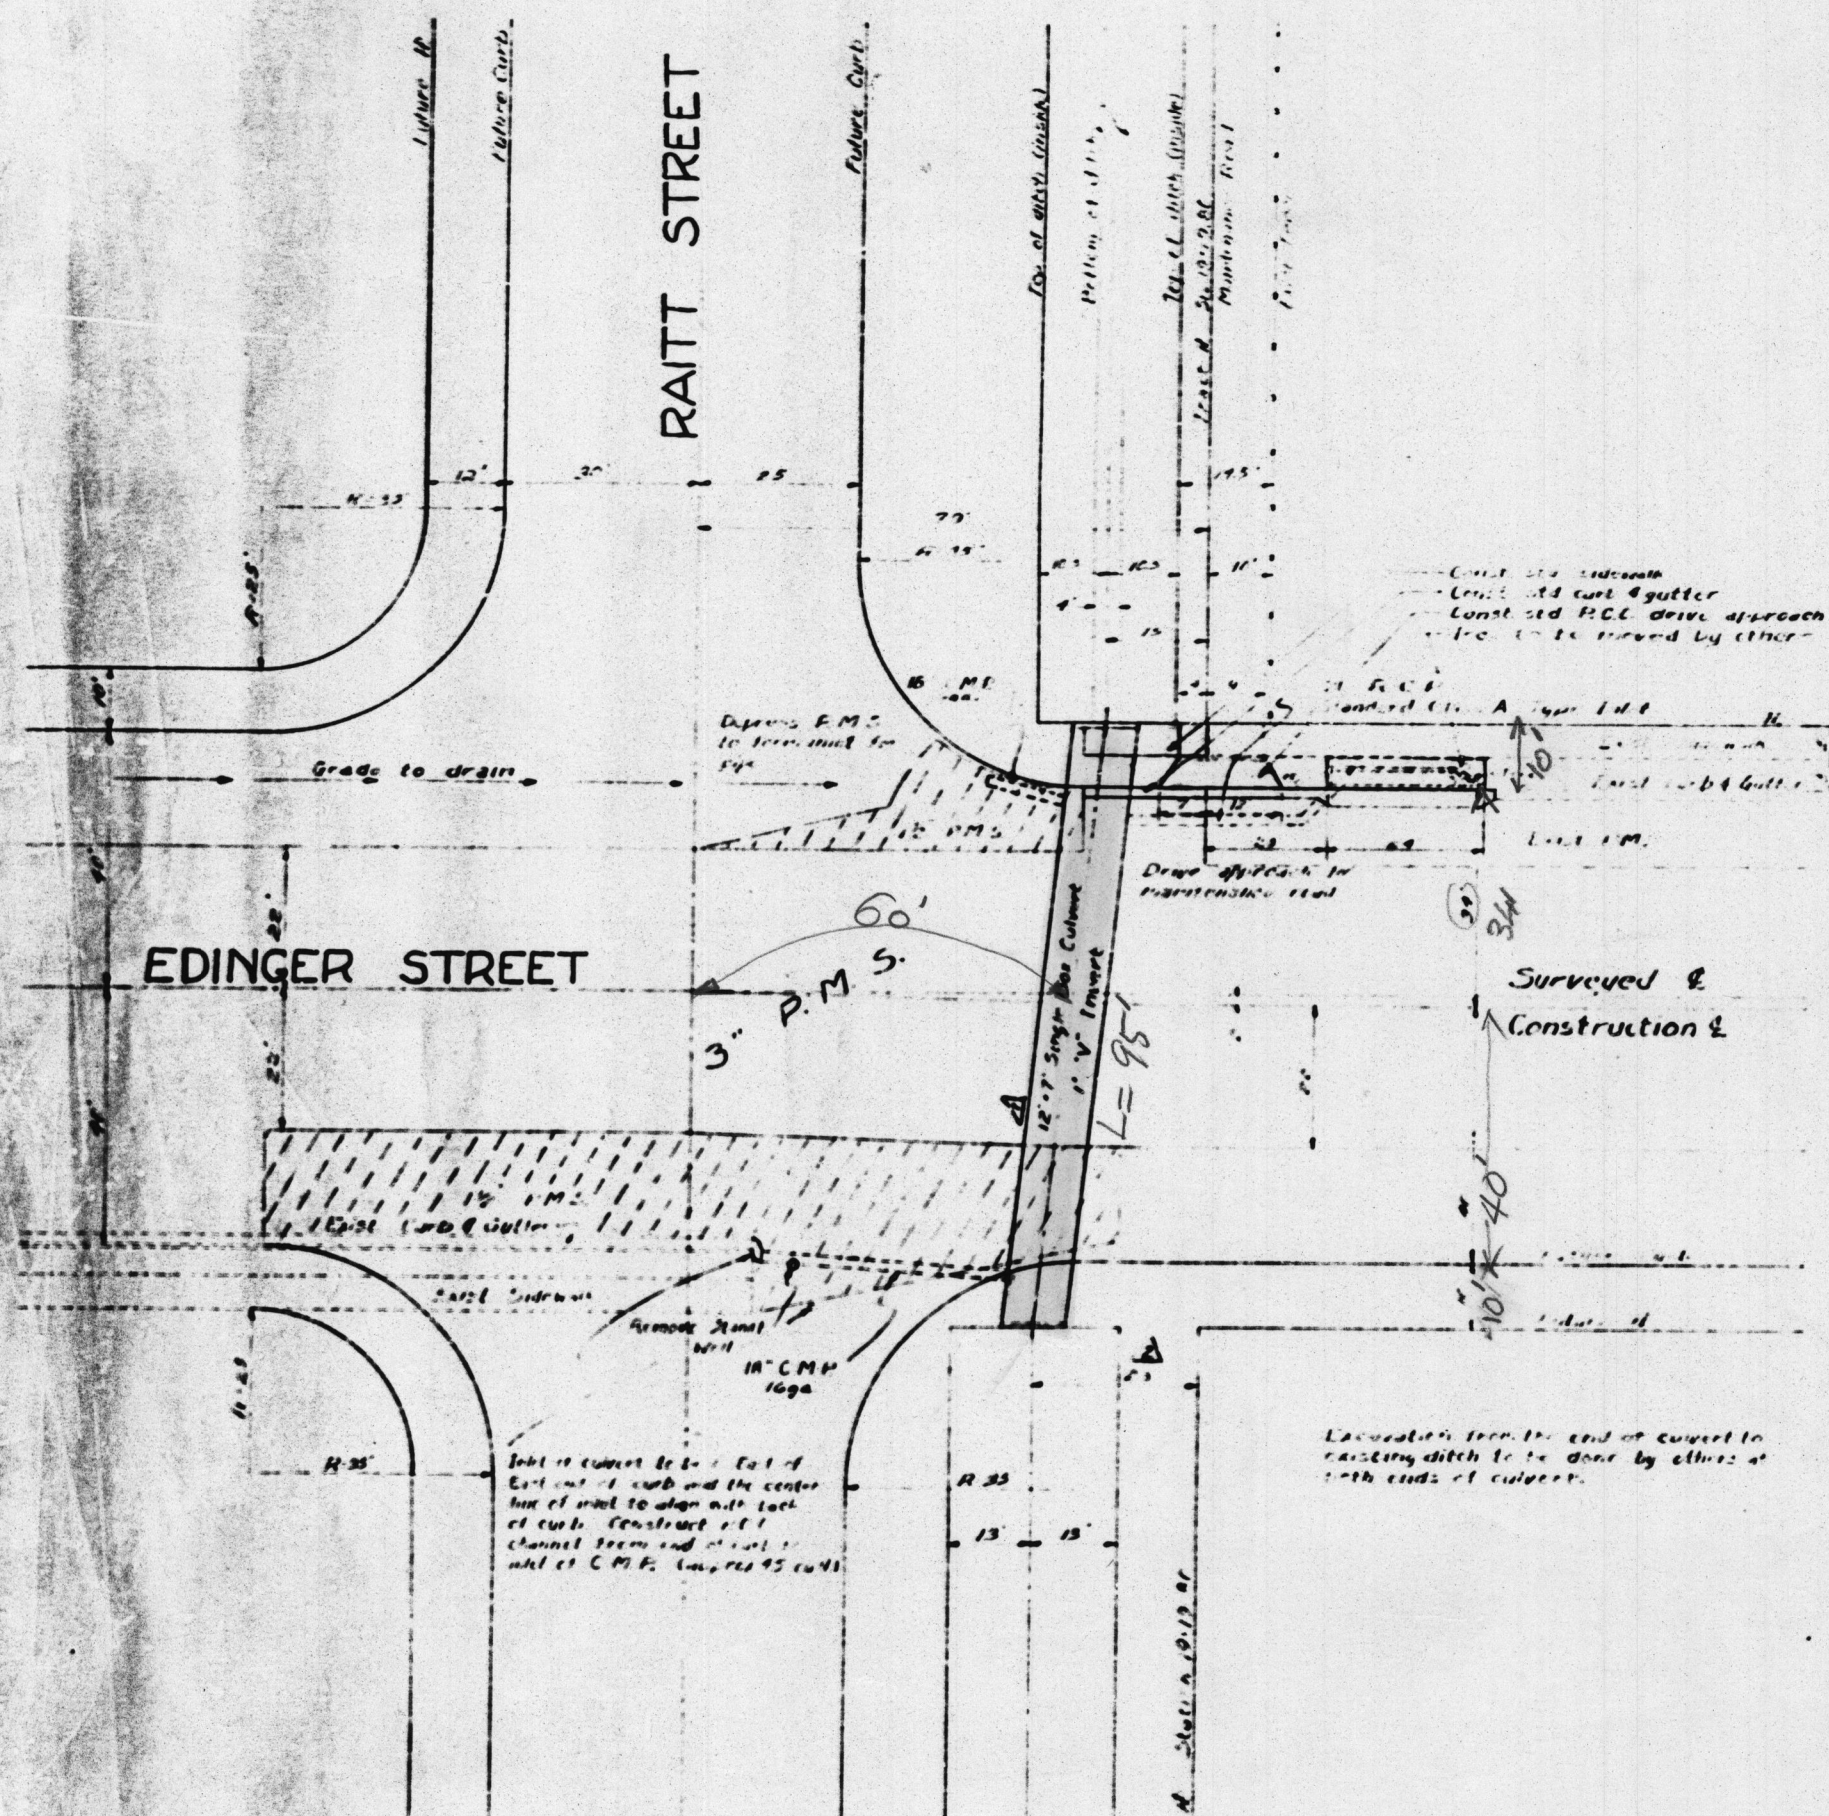

CROSS-SECTION OF CULVERT
NORTH END
Scale: 1 inch

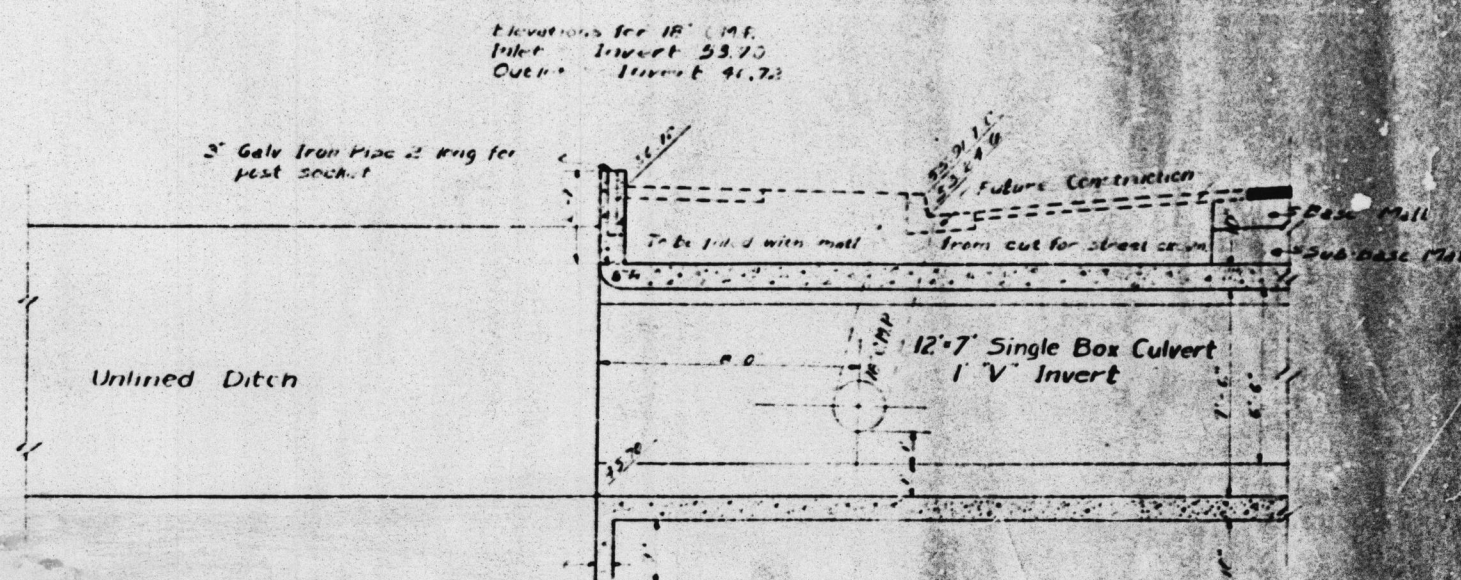

CROSS-SECTION OF CULVERT
SOUTH END

Bridge S-167
Box Culvert
Edinger St at Raitt
Sheet 1 of 1
RCD 22.5' / Scale-As Shown
Brownline Print

MICROFILMED
JUL 8 196

REVISIONS 1. 6' culvert changed to 12' 6" 5-31-57 2. 23' was 25'	Drawn: CSE Check: Hall Wall	ENGINEERING DEPARTMENT CITY OF SANTA ANA DRAWN BY CSE DATE 5-31-57 CHECKED BY Hall DATE 5-29-57 APPROVED <i>[Signature]</i> REGISTERED CIVIL ENGINEER 21340
--	--	---

12'x7' Single Box Culvert
L = 95'

#14611 1957
S-167

EDINGER ST. (CULVERT)
60' E/O RAITT ST. Thms 829-C6