


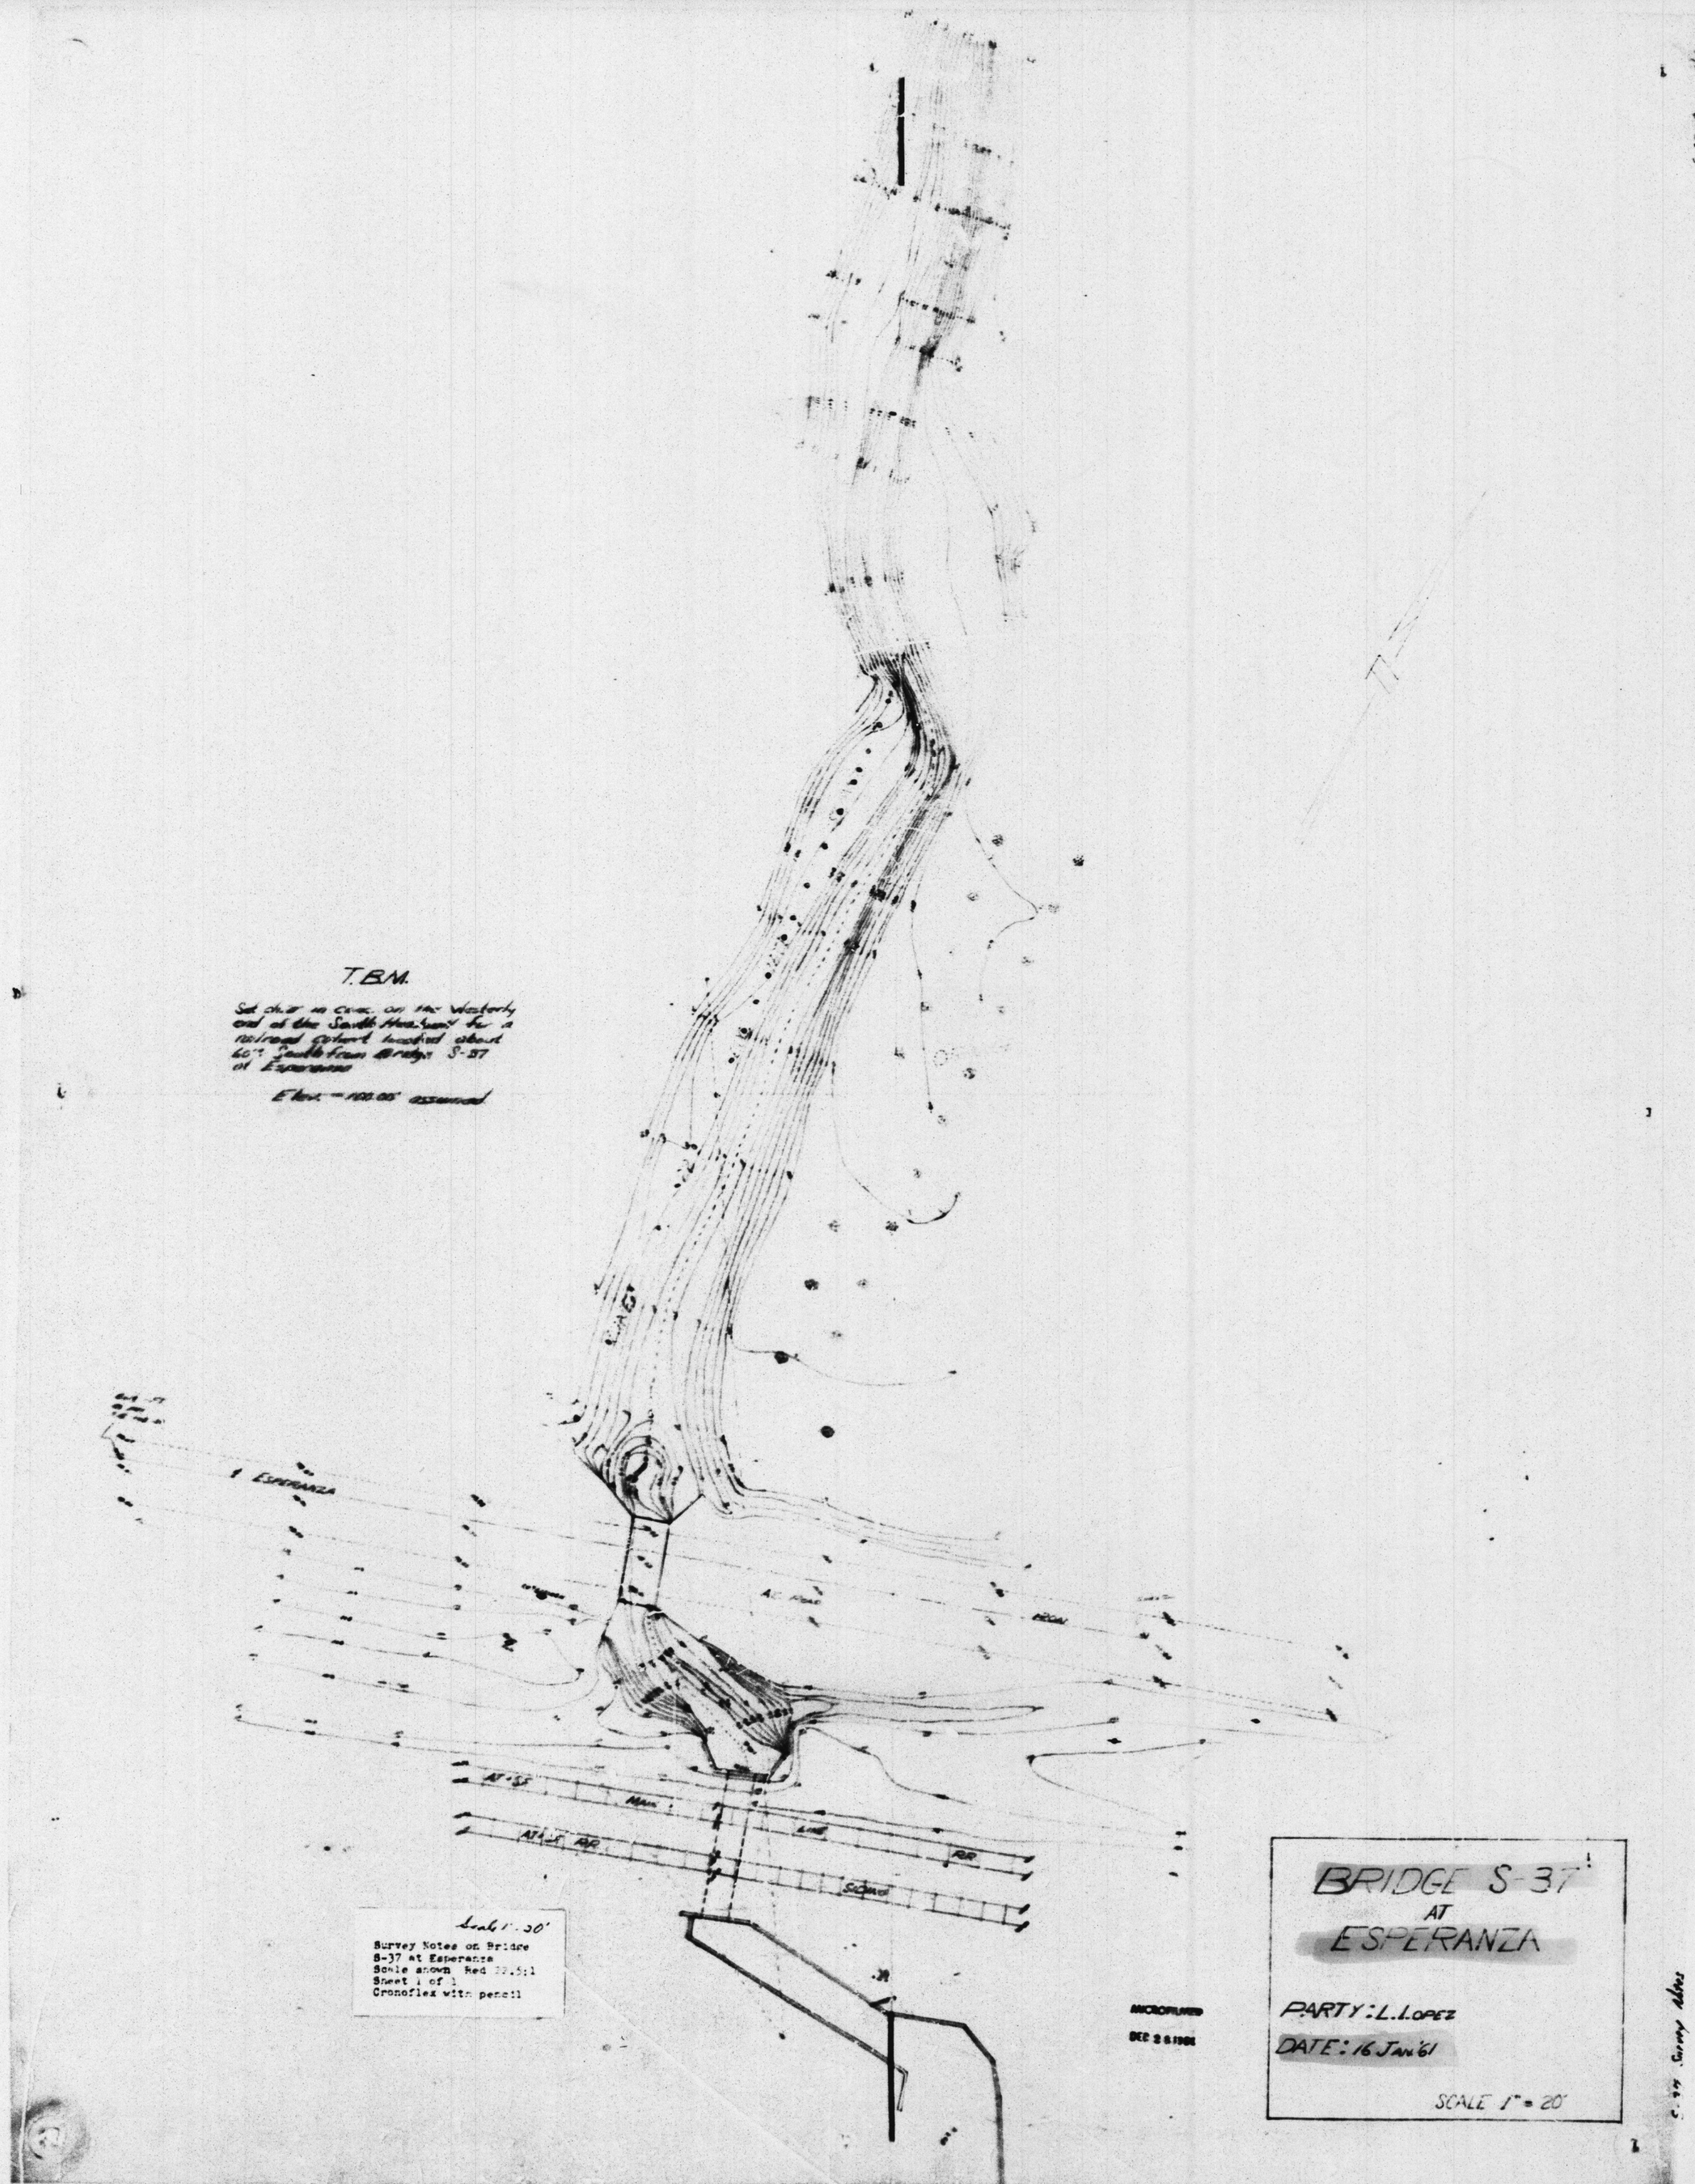

T.B.M.
Set this as a corner on the West side of the South Main Street for a National Grid point located about 60' South from Bridge S-37 at Esperanza
Elev. - 100.00 assumed

Scale 1" = 20'
Survey Notes of Bridge S-37 at Esperanza
Scale shown Red 10:1
Sheet 1 of 1
Contours with pencil

BRIDGE S-37
AT
ESPERANZA
PARTY: L. LOPEZ
DATE: 16 Jan 61
SCALE 1" = 20'

MICROFILMED
DEC 2 6 1961

POOR CONTRAST
FOR MICROFILM

ESPERANZA SURVEY
#14559 1961
S-37
1/1