



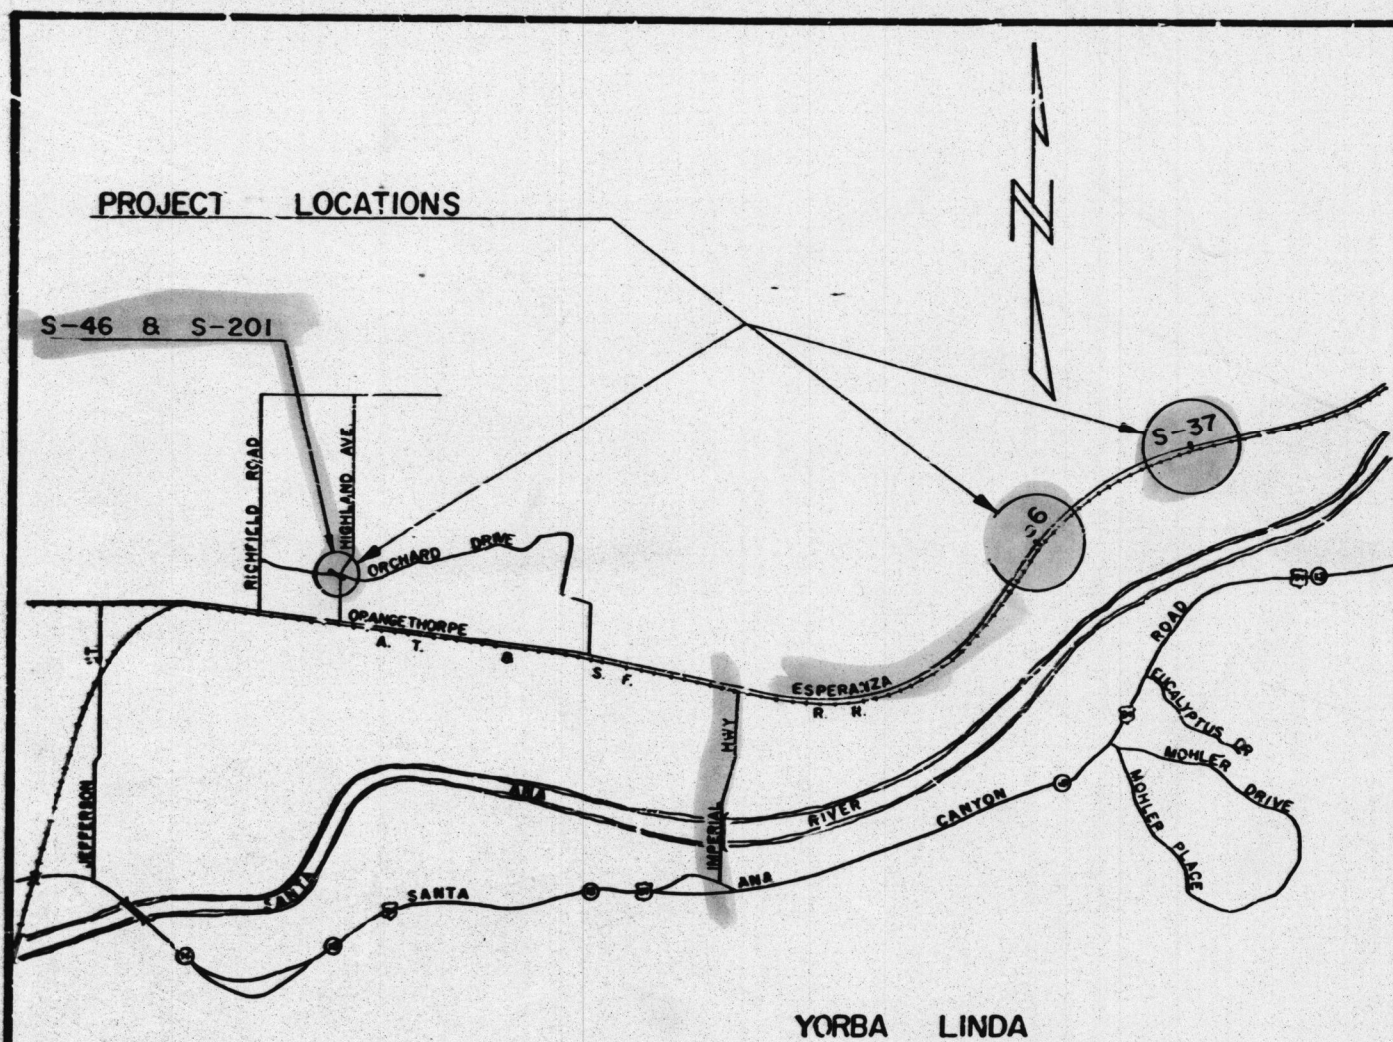

LOCATION MAP
SCALE: 1" = 2000'

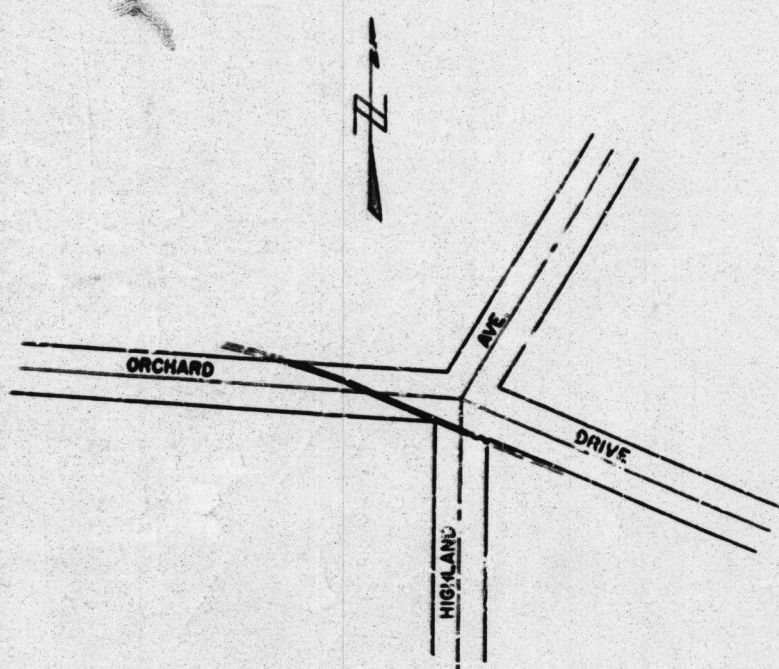

BRIDGE S-46 & S-201 REPLACEMENT
1.77 MILES W'LY OF IMPERIAL HWY & 0.19 MILES N'LY OF ORANGETHORPE AVE.


SEE SHEET
S-46 & S-201 Thomas: 740-B7

CONVENTIONAL SIGNS	
COUNTY LINE	--- -- --
CITY LIMITS	--- -- --
PAV. LINE	--- -- --
BASE OR SURVEY LINE	--- -- --
E. CONSTRUCTION	--- -- --
PAVING TRUCKS	--- -- --
CULVERTS	--- -- --
WOOD PILE	--- -- --
WIRE FENCE	--- -- --
CHAIN LINK FENCE	--- -- --
CONCRETE WALL	--- -- --
MASONRY WALL	--- -- --
WEDGE OR BUSHES	--- -- --
EDGE OF RETAINING	--- -- --
FILL SLOPE	--- -- --
CUT SLOPE	--- -- --
TREE STAND	--- -- --
FRUIT TREES	--- -- --
SUCKERED TREE	--- -- --
EVERGREEN TREE	--- -- --
PAV. TREE	--- -- --
POWER POLE	--- -- --
TELEPHONE POLE	--- -- --
IRON POLE & ANCHOR	--- -- --
STANDARD	--- -- --
PIPE HYDRANT	--- -- --
STANDARD	--- -- --
WEIR BOX	--- -- --
GAS & WATER METERS	--- -- --
WATER VALVE	--- -- --
GUARD RAIL	--- -- --
LEVEL	--- -- --
RAILROAD	--- -- --
SIDEWALKS	--- -- --
UNFENCED PROPERTY	--- -- --

ORANGE COUNTY HIGHWAY DEPARTMENT STATE OF CALIFORNIA PLAN AND PROFILE FOR REPLACEMENT OF BRIDGES S-36, S-37, S-46 & S-201

AS BUILT

RESIDENT ENG'R: R. KEITH HART
ASS'T. RES. ENG'R: WM. G. GUSTAFSON
6-62

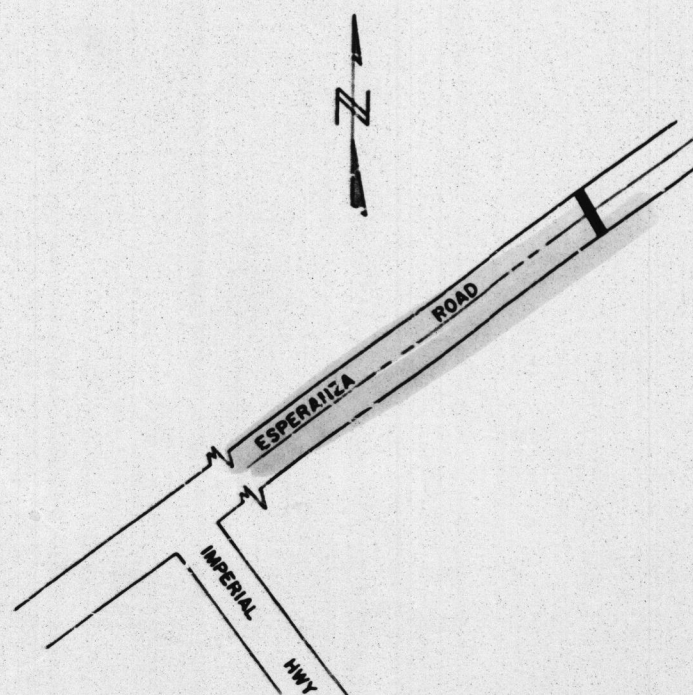


BRIDGE S-36 REPLACEMENT
1.45 MILES N.E'LY OF IMPERIAL HWY.

SEE SHEET 2
Thomas: 740-K6

Plan & Profile for Re-
placement of Bridges
S-36, S-37, S-46 & S-201
Scale shown Sepia
Sheet 1 of 5
Scale 1" = 2680'

SHEET INDEX

SHEET 1	-----	TITLE SHEET
SHEET 2-3-4	-----	PLAN & PROFILE
SHEET 5	-----	MISC. DETAILS

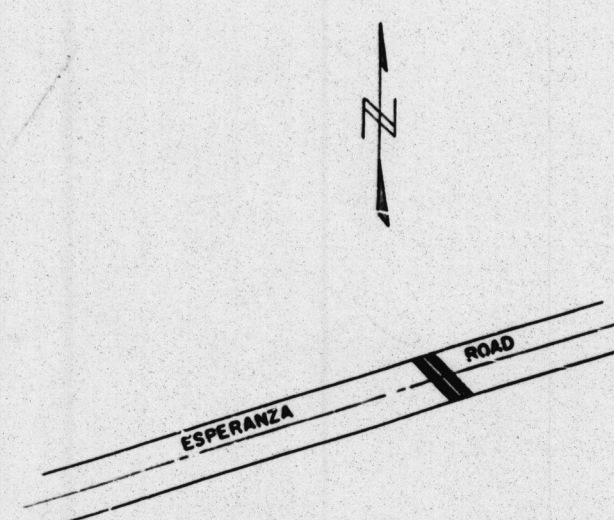

BRIDGE S-37 REPLACEMENT
2.20 MILES N.E'LY OF IMPERIAL HWY.

SEE SHEET 3
Thomas: 740-J6

Approved: _____
ORANGE COUNTY ROAD COMMISSIONER RCE 7872

DATE
1-23-62

DEC 28 1961

S-36, S-37, S-46 & S-201 HP FOR REPLACEMENT OF BRIDGES.

#14558 SK. 1 of 5 1962
ESPERANZA S-36
As Orchard & Highland BR. Replacements 1/5