
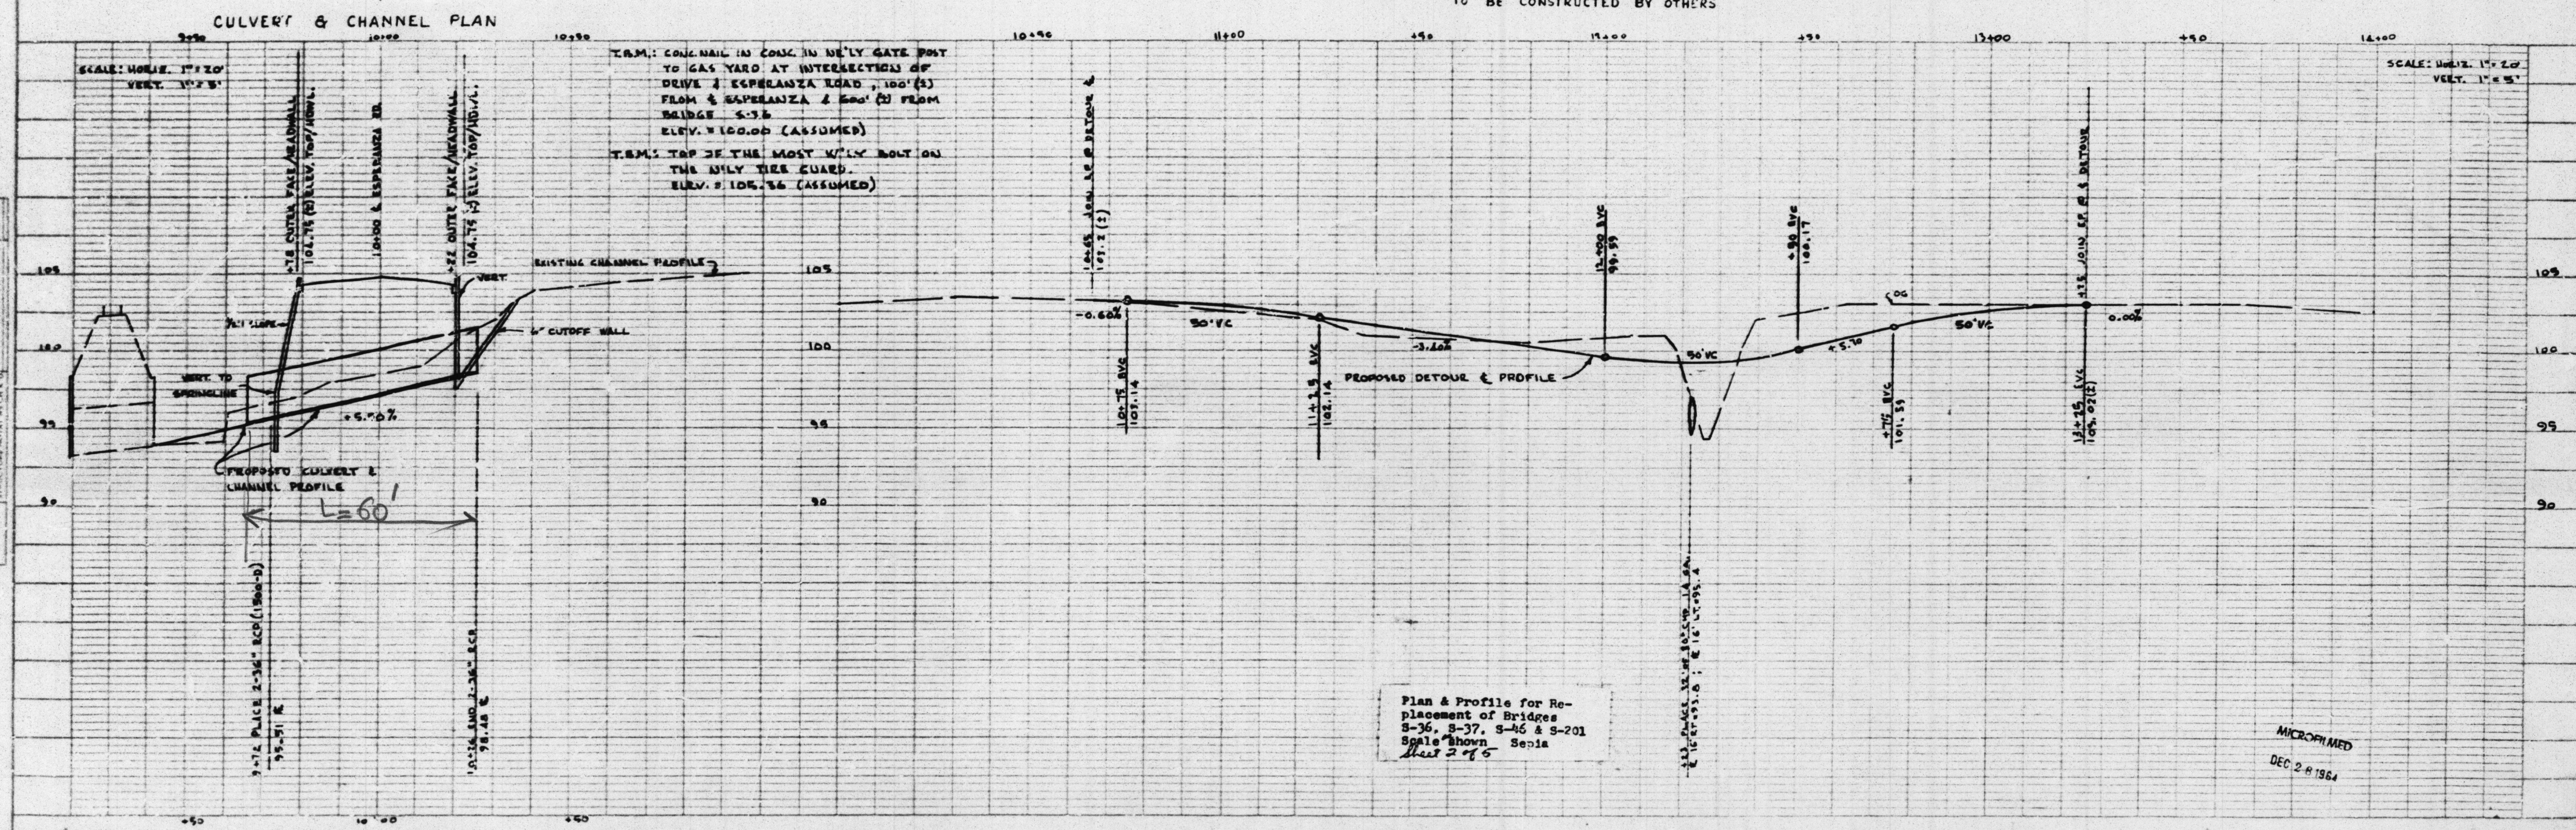
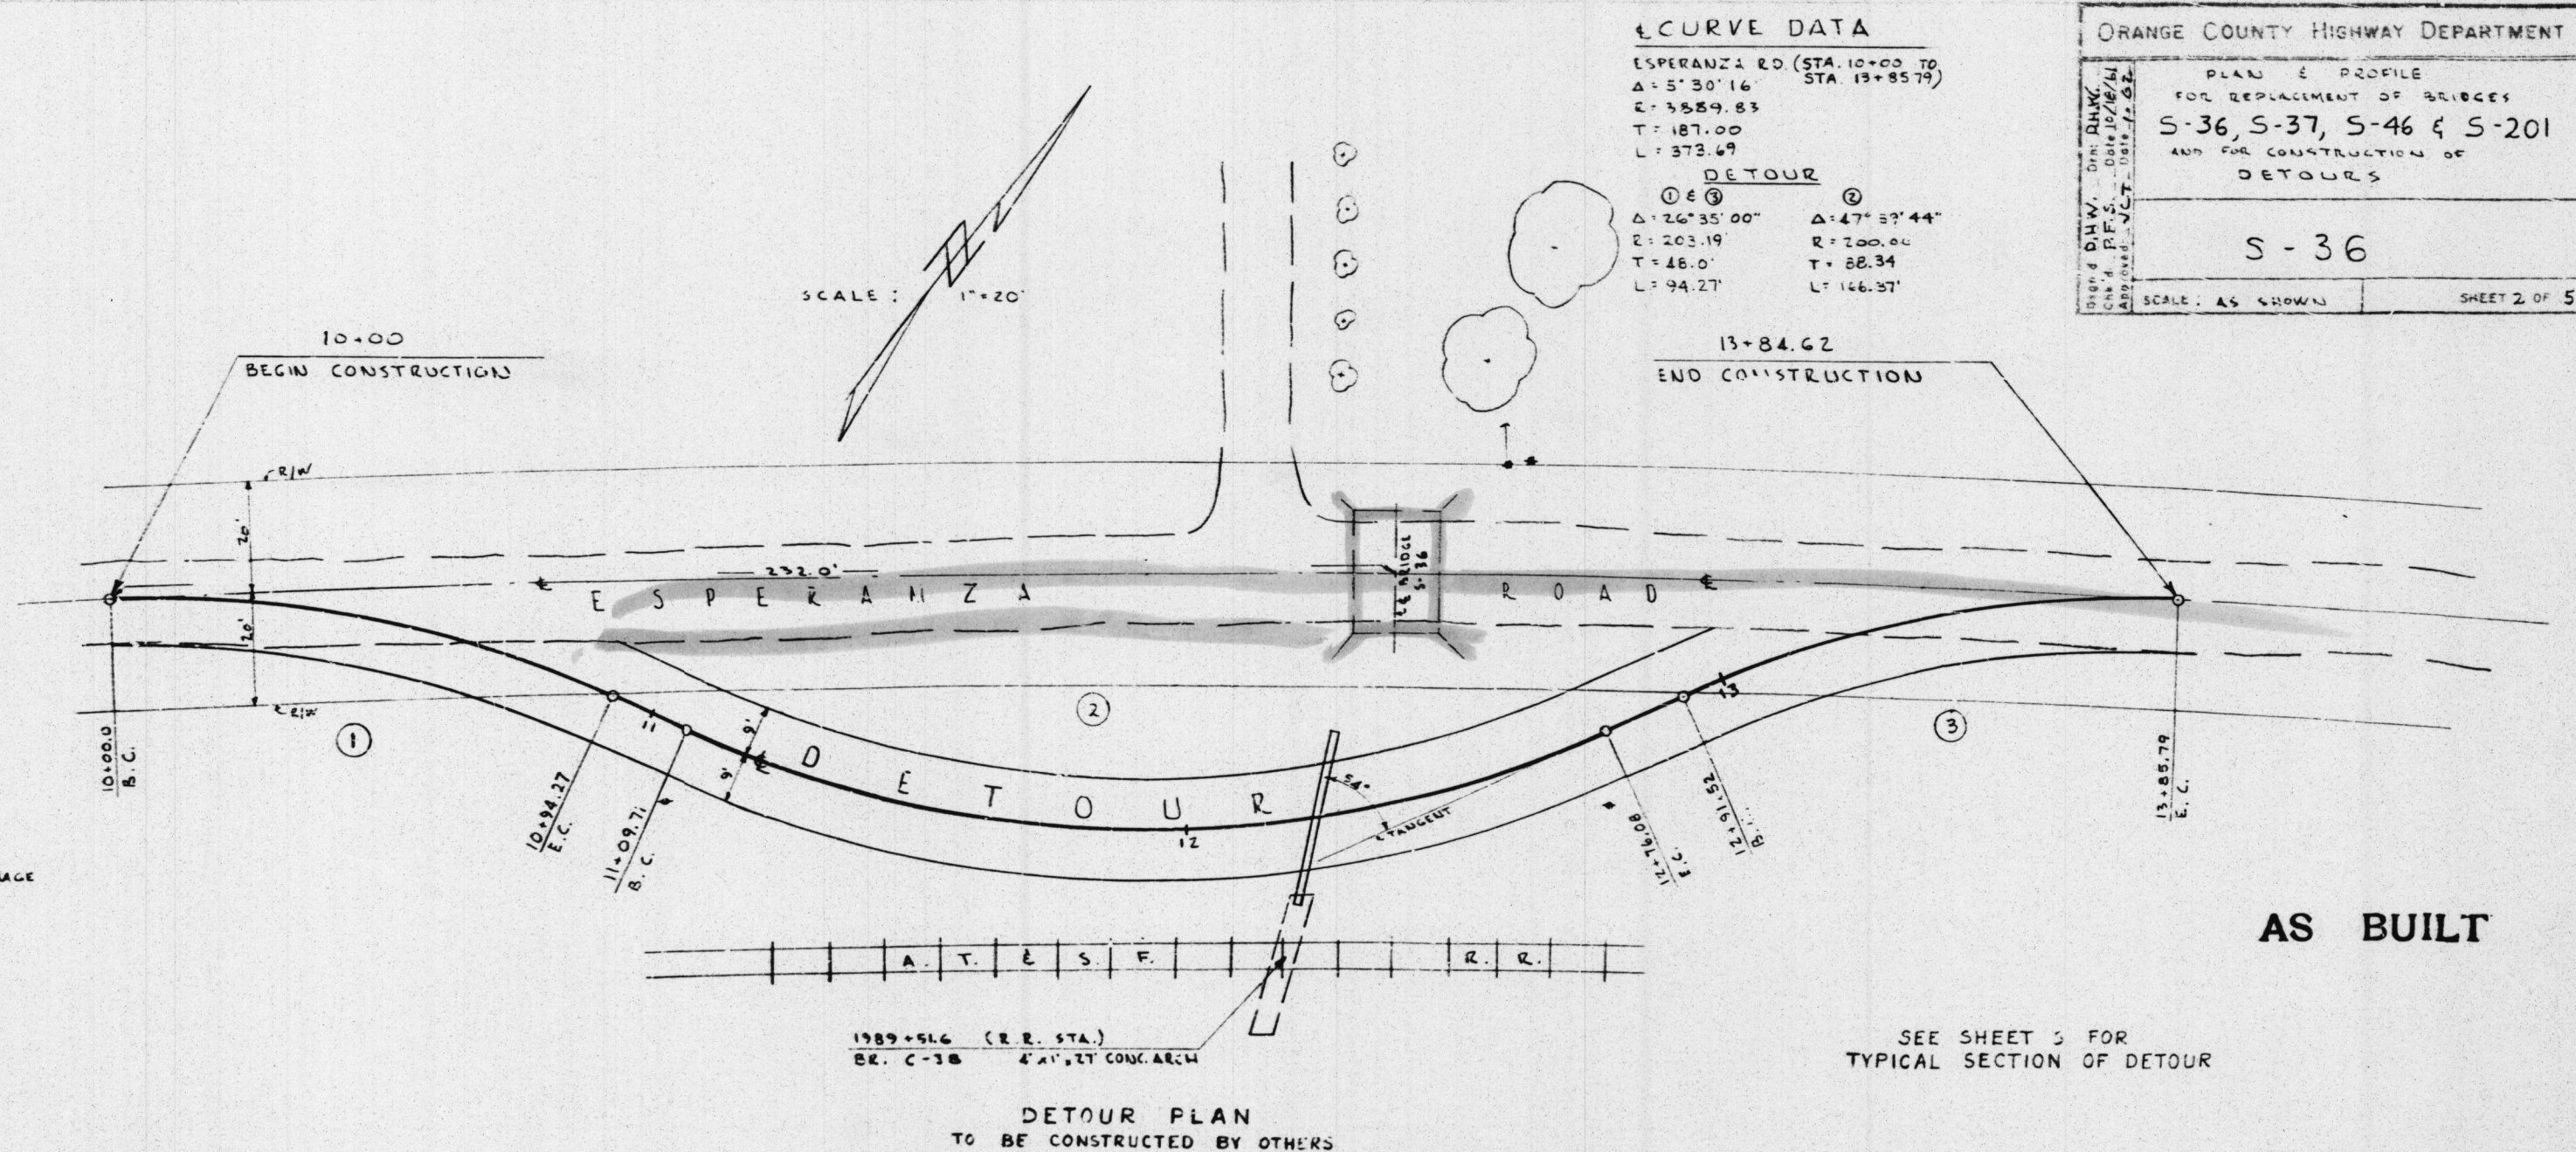


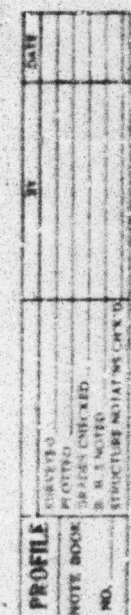

S-36 $\Delta K_{\text{new}} = 90^\circ - 83^\circ = 7^\circ$
L = 60'
2-36' RCP (1500-D)

Sht 2 of 5

 $\frac{3}{6}$