




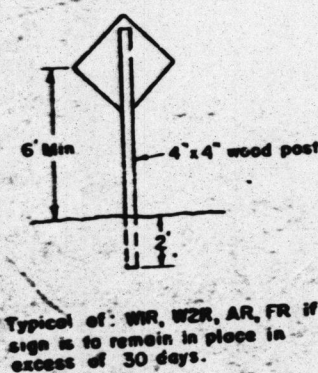


Typical of: WHP, WSR, AR, FR. If sign is to remain in place in excess of 30 days.

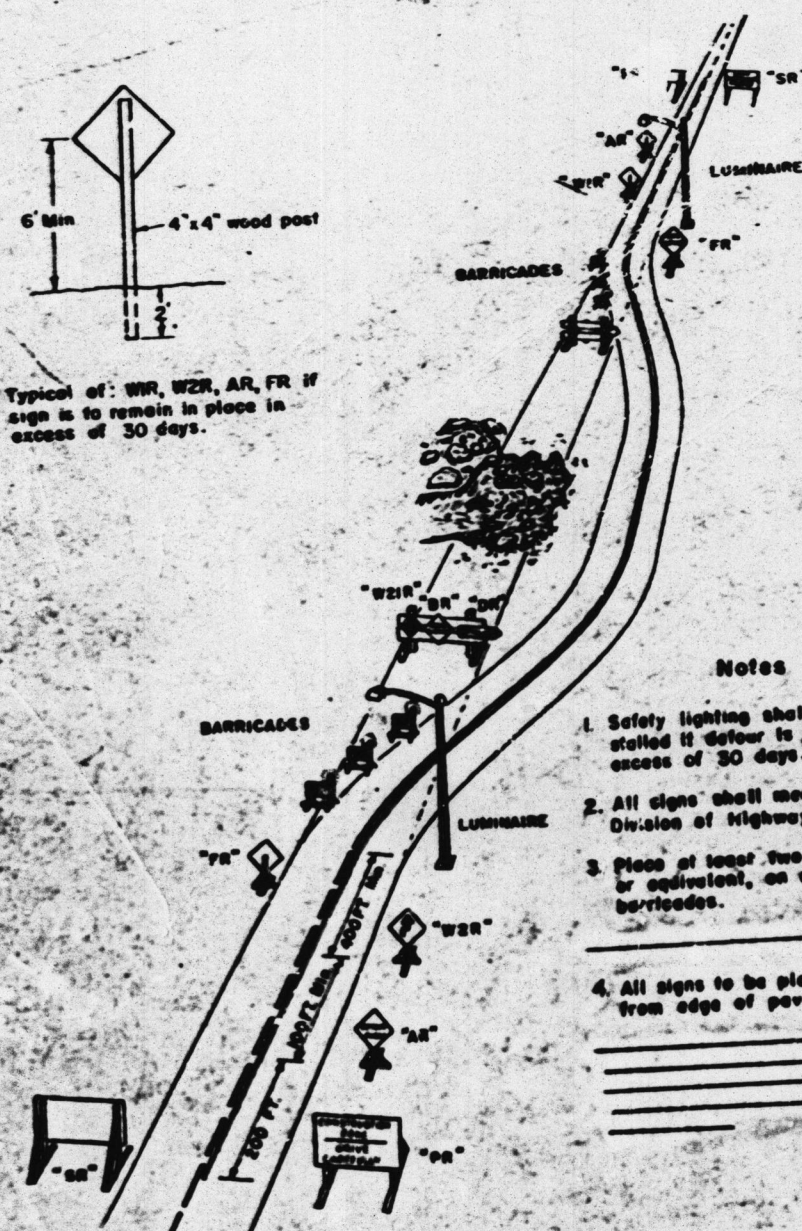


CONSTRUCTION ZONE & DETOUR SIGNING
BY OTHERS

- Notes
1. Safety lighting shall be in-stalled if detour to be remain in excess of 30 days.
 2. All signs shall meet 300 ft of Coll. Division of Highway Standards.
 3. Place at least two (2) "Flashers" or equivalent, on each group of barricades.
 4. All signs to be placed 4'-12' from edge of pavement.

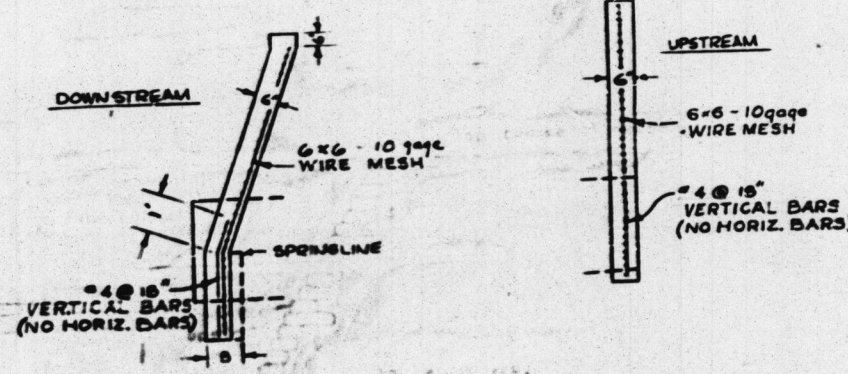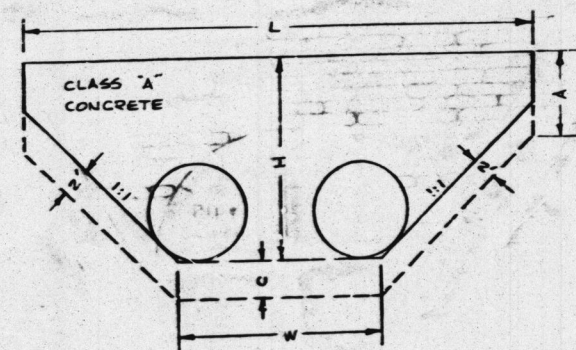


	8-36	8-37
DOWN	1.0	1.0
UP	0.5	0.5
DOWN	1.0	1.0
UP	0.5	0.5
HEADWALL DETAILS (S-36, S-37)
NOT TO SCALE

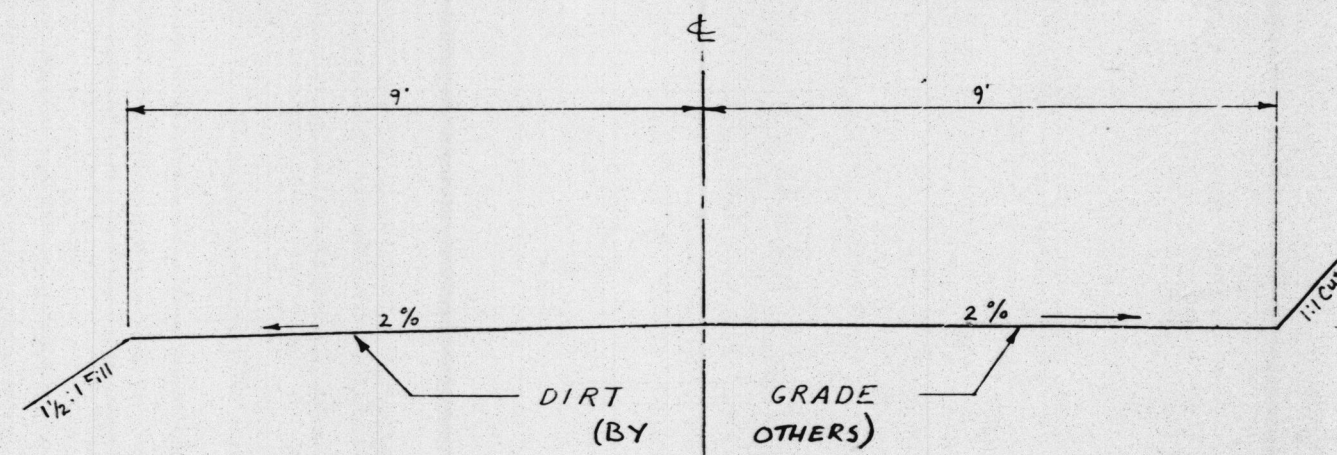


DETOUR TYPICAL SECTION
Scale 1" = 2'

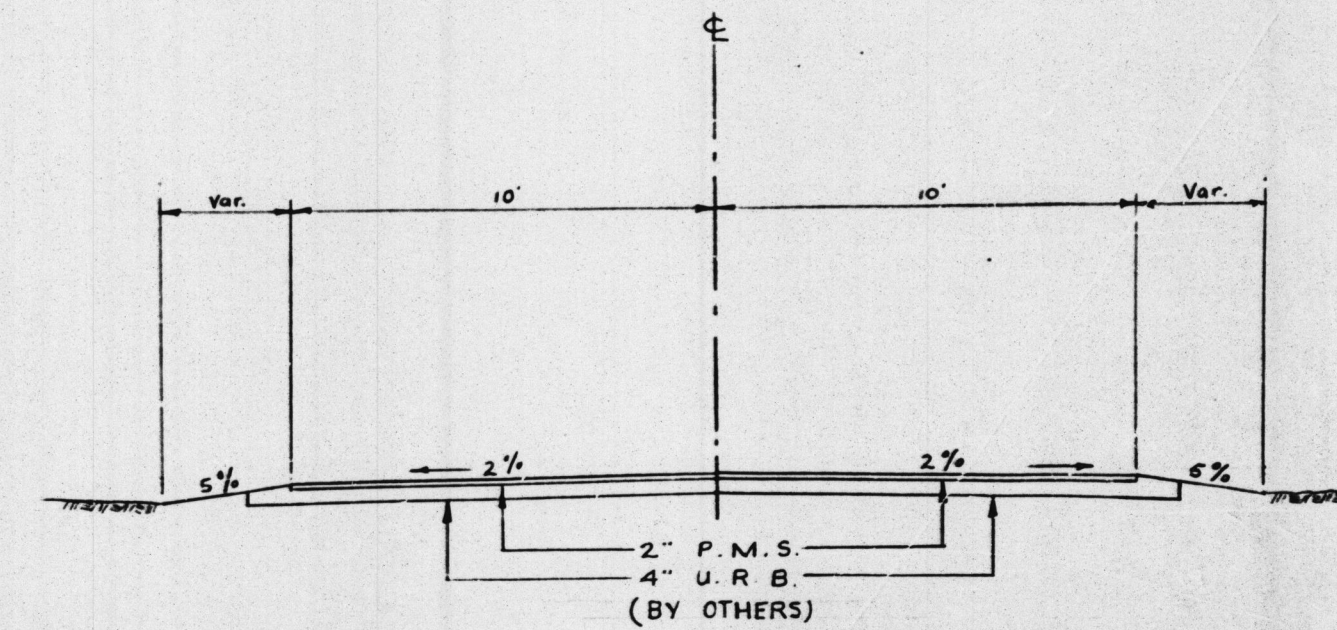


TYPICAL SECTION - ESPERANZA RD
Scale 1" = 3'

DETOUR CONST. & ROADWAY RECONSTRUCTION TO BE DONE BY OTHERS

AS BUILT

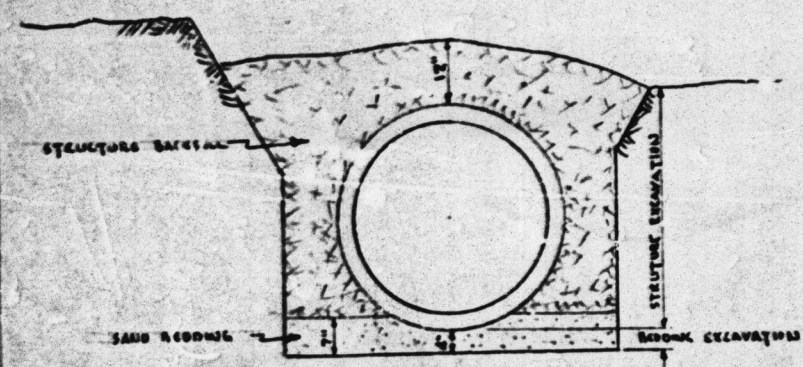

TYPICAL SECTION
PIPE INSTALLATION DETAIL
S-46 & S-201 LOCATION
SCALE 1" = 2'

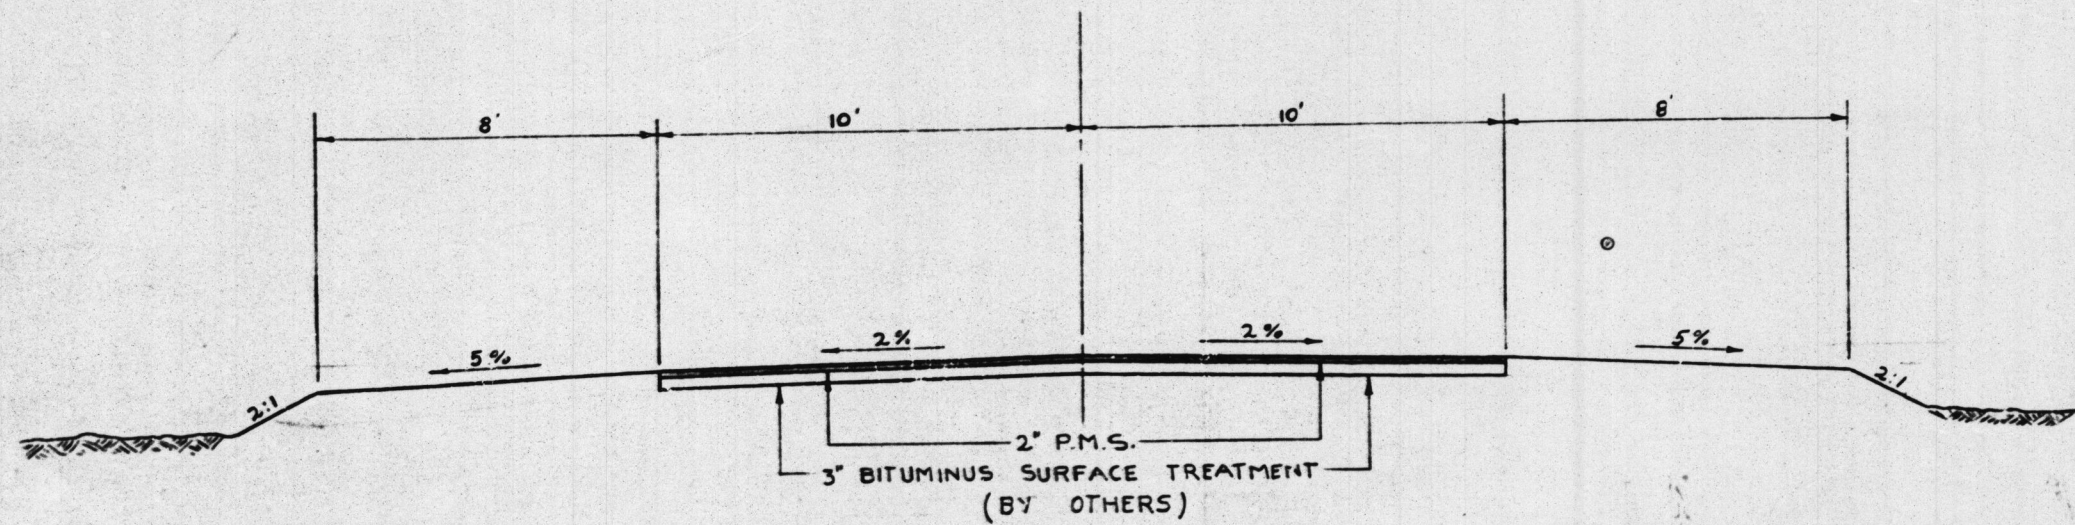

TYPICAL SECTION
HIGHLAND AVE. & ORCHARD DRIVE
SCALE: 1" = 3'

Plan & Profile for Re-
placement of Bridges
S-36, S-37, S-46 & S-201
Sheet 5 of 5
Scale shown Sepia

Sheet 5 of 5

MICROFILMED
DEC 28 1984

ORANGE COUNTY HIGHWAY DEPARTMENT	
PLAN & PROFILE FOR REPLACEMENT OF BRIDGES S-36, S-37, S-46 & S-201 & FOR CONSTRUCTION OF DETOURS	
MISCELLANEOUS DETAILS	
SCALE AS SHOWN	SHEET 5 OF 5

3/4 5/4 5