



NOTE: Roadway to be raised by others.




EAST ELEVATION
SCALE: 1/4" = 1'-0"

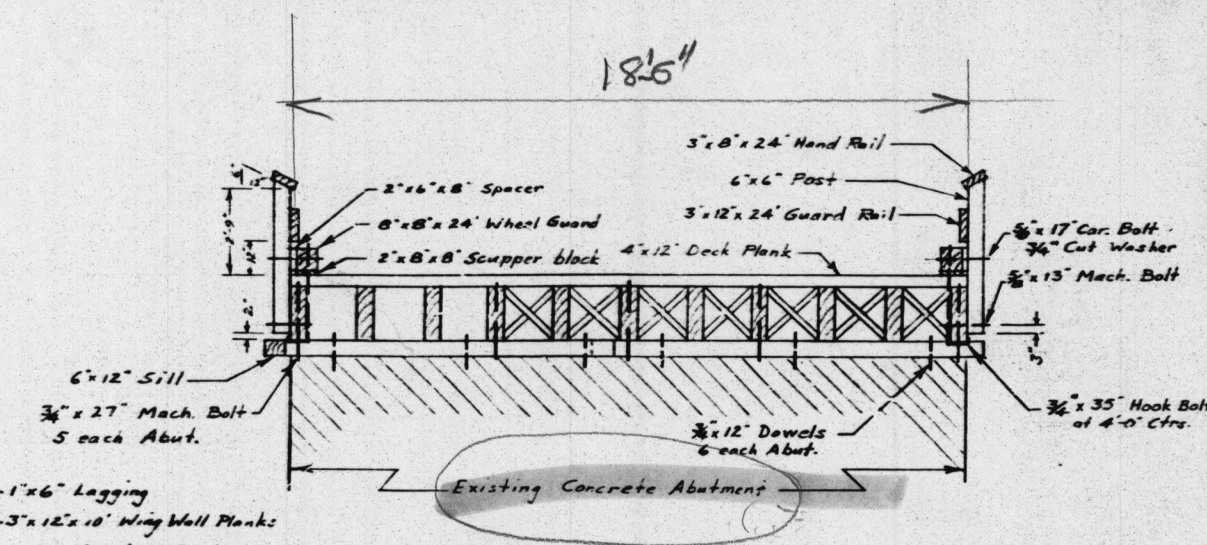


SECTION A-A
SCALE: 1/4" = 1'-0"

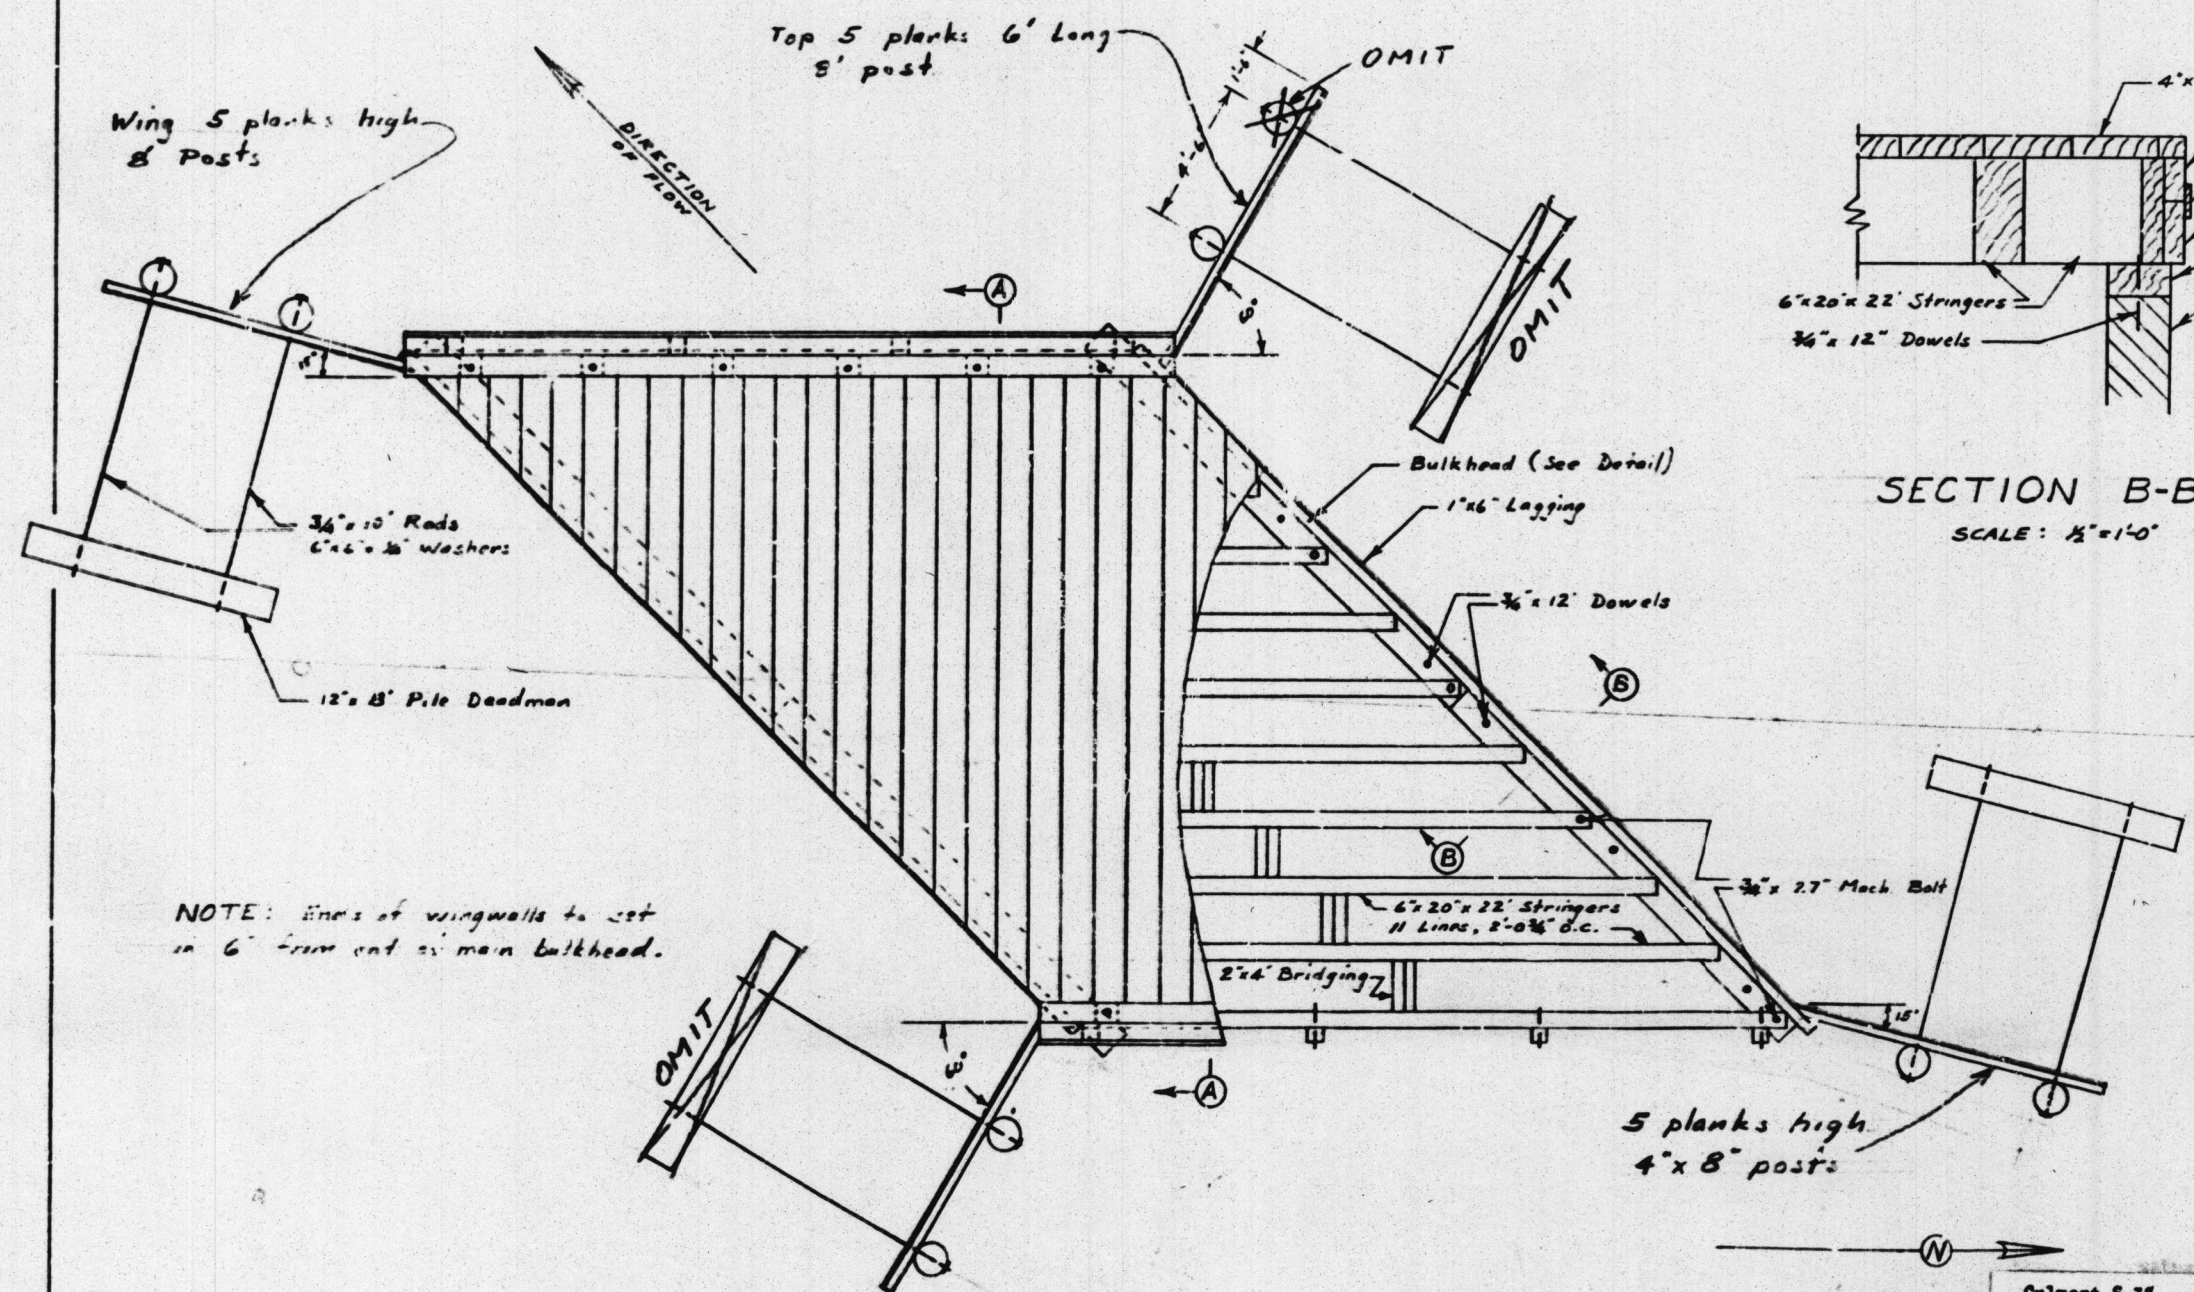

PLAN
SCALE: 1/4" = 1'-0"

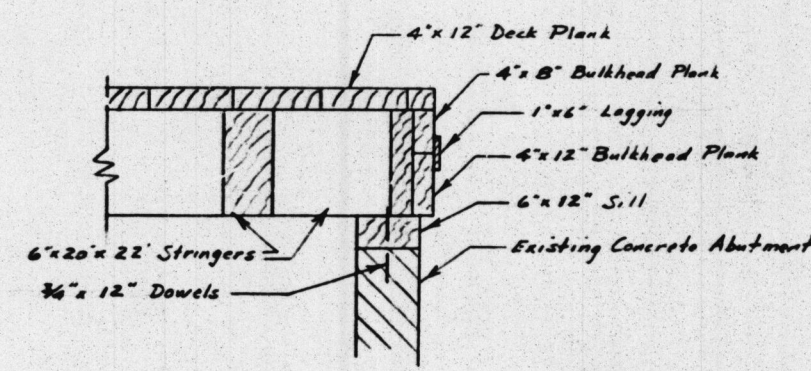

SECTION B-B
SCALE: 1/4" = 1'-0"

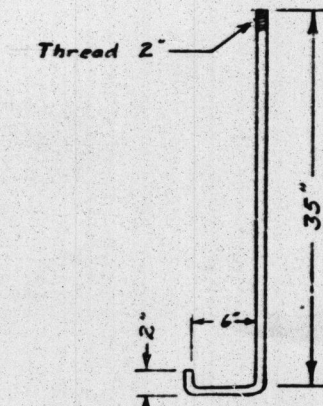

HOOK BOLT DETAIL
SCALE: 1" = 1'-0"

NOTE: All lumber except wheel guard and guard rail members will be rough, creosoted.
Wheel guard and guard rail members will be S&S and will receive 3 coats of white lead paint.
All bolt assemblies to have malleable washers except as noted.
Changes shown in Red

MICROFILMED
JUL 6 1960

Culvert 6-34
Esplanade Street
at Dodge Street
Sheet 1 of 1
Red: 22.511
Scale: As Shown
Vellum-Pencil

Prepared by	Checked by	Approved
R.M.B.	C.R.N.	T.W.C.
2-4-48	4-5-48	1-5-48

ORANGE COUNTY HIGHWAY DEPT.
WOODEN CULVERT
STRUCTURE NO. 3-38
ON
ESPLANADE STREET
AT DODGE STREET
APPROVED
H. SPRENGER, ROAD COMMISSIONER
SCALE: AS SHOWN
FEB. 1948

#14561 1948
(S-38) ESPLANADE AVE.
DODGE AVE.
Thomas 800-C7