
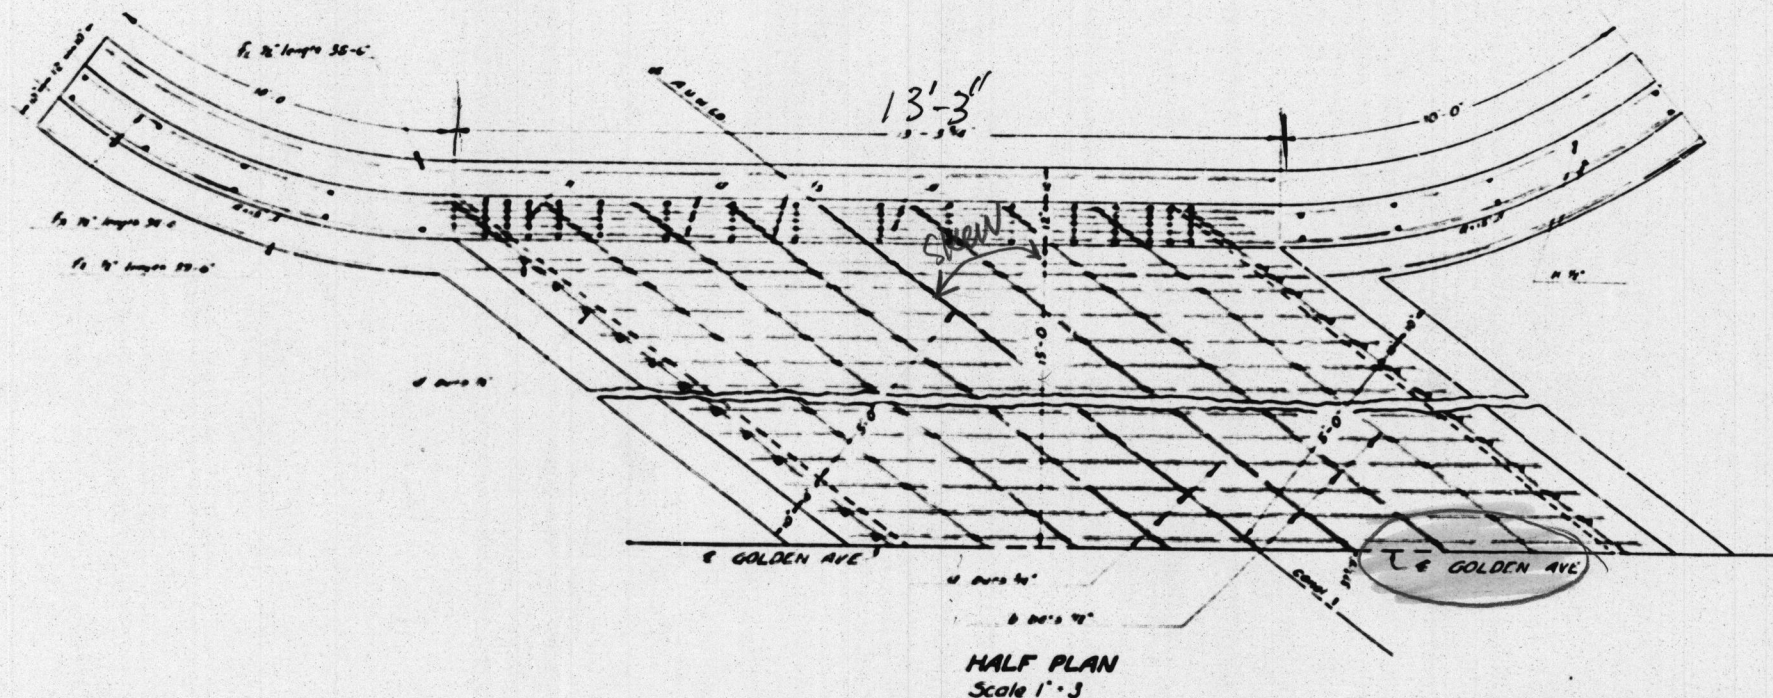


ACQUISITION AND IMPROVEMENT DIST. NO 1
SHEET NO 73 OF 104 SHEETS
SCALES: As Shown
Approved _____ Engineer _____

$$Slope \ 90^\circ - 37^\circ 10' = 52^\circ 50'$$

$$L = \frac{30'}{\sin 37^\circ 10'} = 49.6'$$

Note -
All Portland Cement Concrete to be Class A

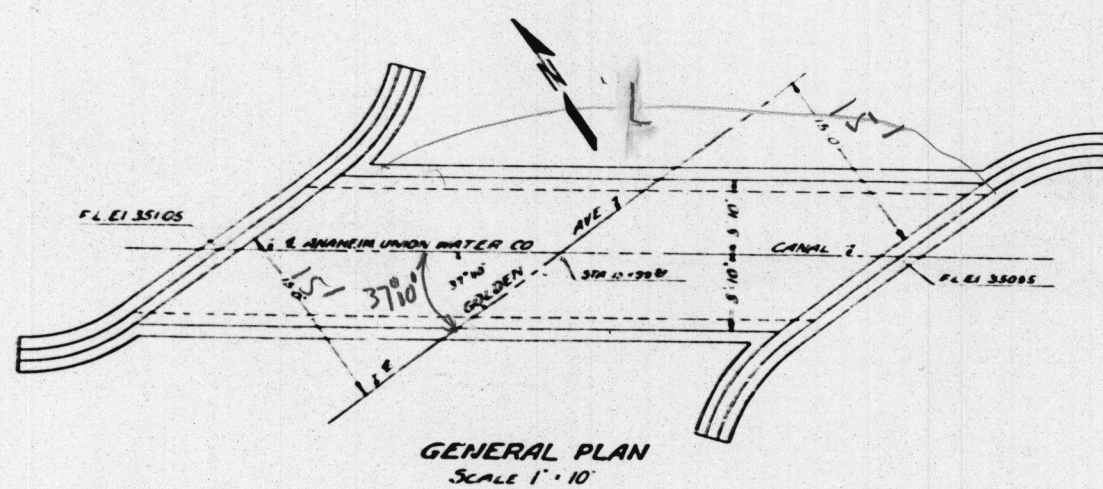

Note -
Deck to be brought to grade of roadway, with
approximately 1 1/2" A.C. wearing surface



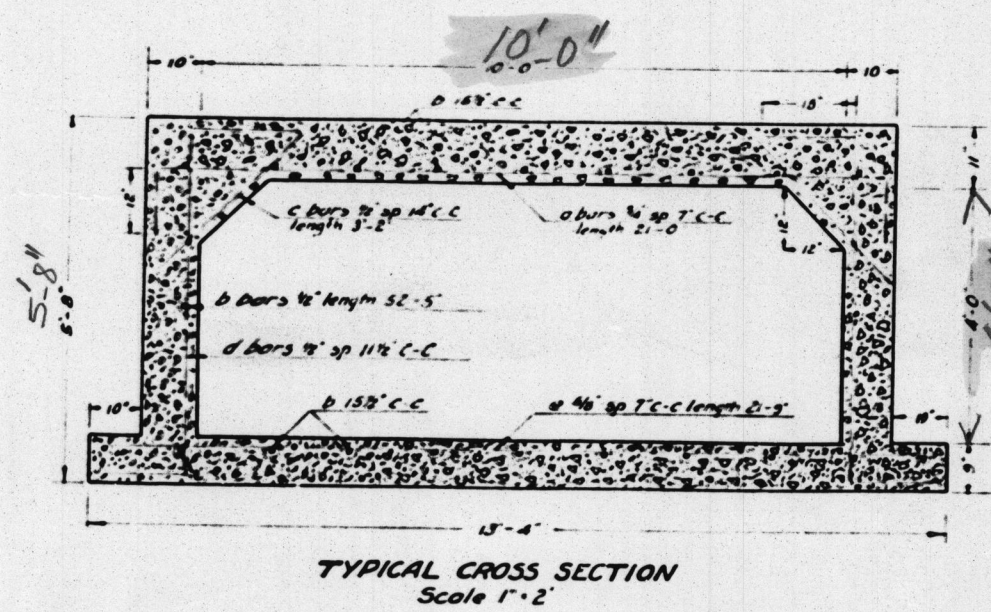


TABLE OF QUANTITIES				
Name	No.	Size	Length	
A	60	1/2"	21'-0"	
B	22	1/2"	16'-6"	
C	22	1/2"	5'-2"	
D	100	1/2"	6'-6"	
E	22	1/2"	21'-0"	
F	4	1/2"	30'-0"	
G	4	1/2"	30'-0"	
H	4	1/2"	30'-0"	
I	4	1/2"	30'-0"	
J	4	1/2"	30'-0"	
K	4	1/2"	30'-0"	
L	4	1/2"	30'-0"	
M	4	1/2"	30'-0"	
N	4	1/2"	30'-0"	
O	4	1/2"	30'-0"	
P	4	1/2"	30'-0"	
Q	4	1/2"	30'-0"	
R	4	1/2"	30'-0"	
S	4	1/2"	30'-0"	
T	4	1/2"	30'-0"	
U	4	1/2"	30'-0"	
V	4	1/2"	30'-0"	
W	4	1/2"	30'-0"	
X	4	1/2"	30'-0"	
Y	4	1/2"	30'-0"	
Z	4	1/2"	30'-0"	
6167 Corrugated Sq DORS				
1200 Cu Yds PORTLAND				
Cement Concrete				

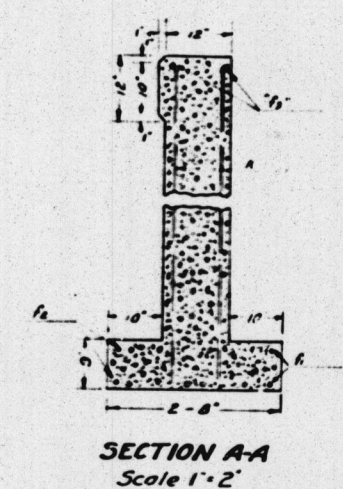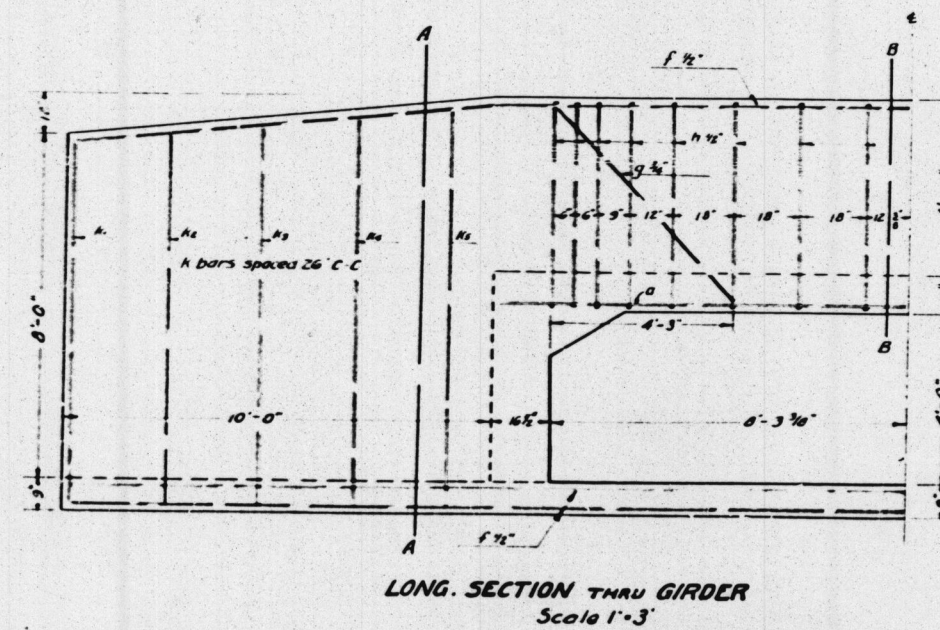

REINFORCED PORTLAND CEMENT
CONCRETE CULVERT
GOLDEN AVE. OVER A.U.W.CO. CANAL

MICROFILMED
JUL 6 1960

Culvert #8-142
Concrete Culvert
Golden Ave over
A.U.W. Co. Canal
Sheet 1 of 2
Red: 22.5' Scale as shown
Blue: line Print

#14602 Before 1960
S-142
GOLDEN AVE