

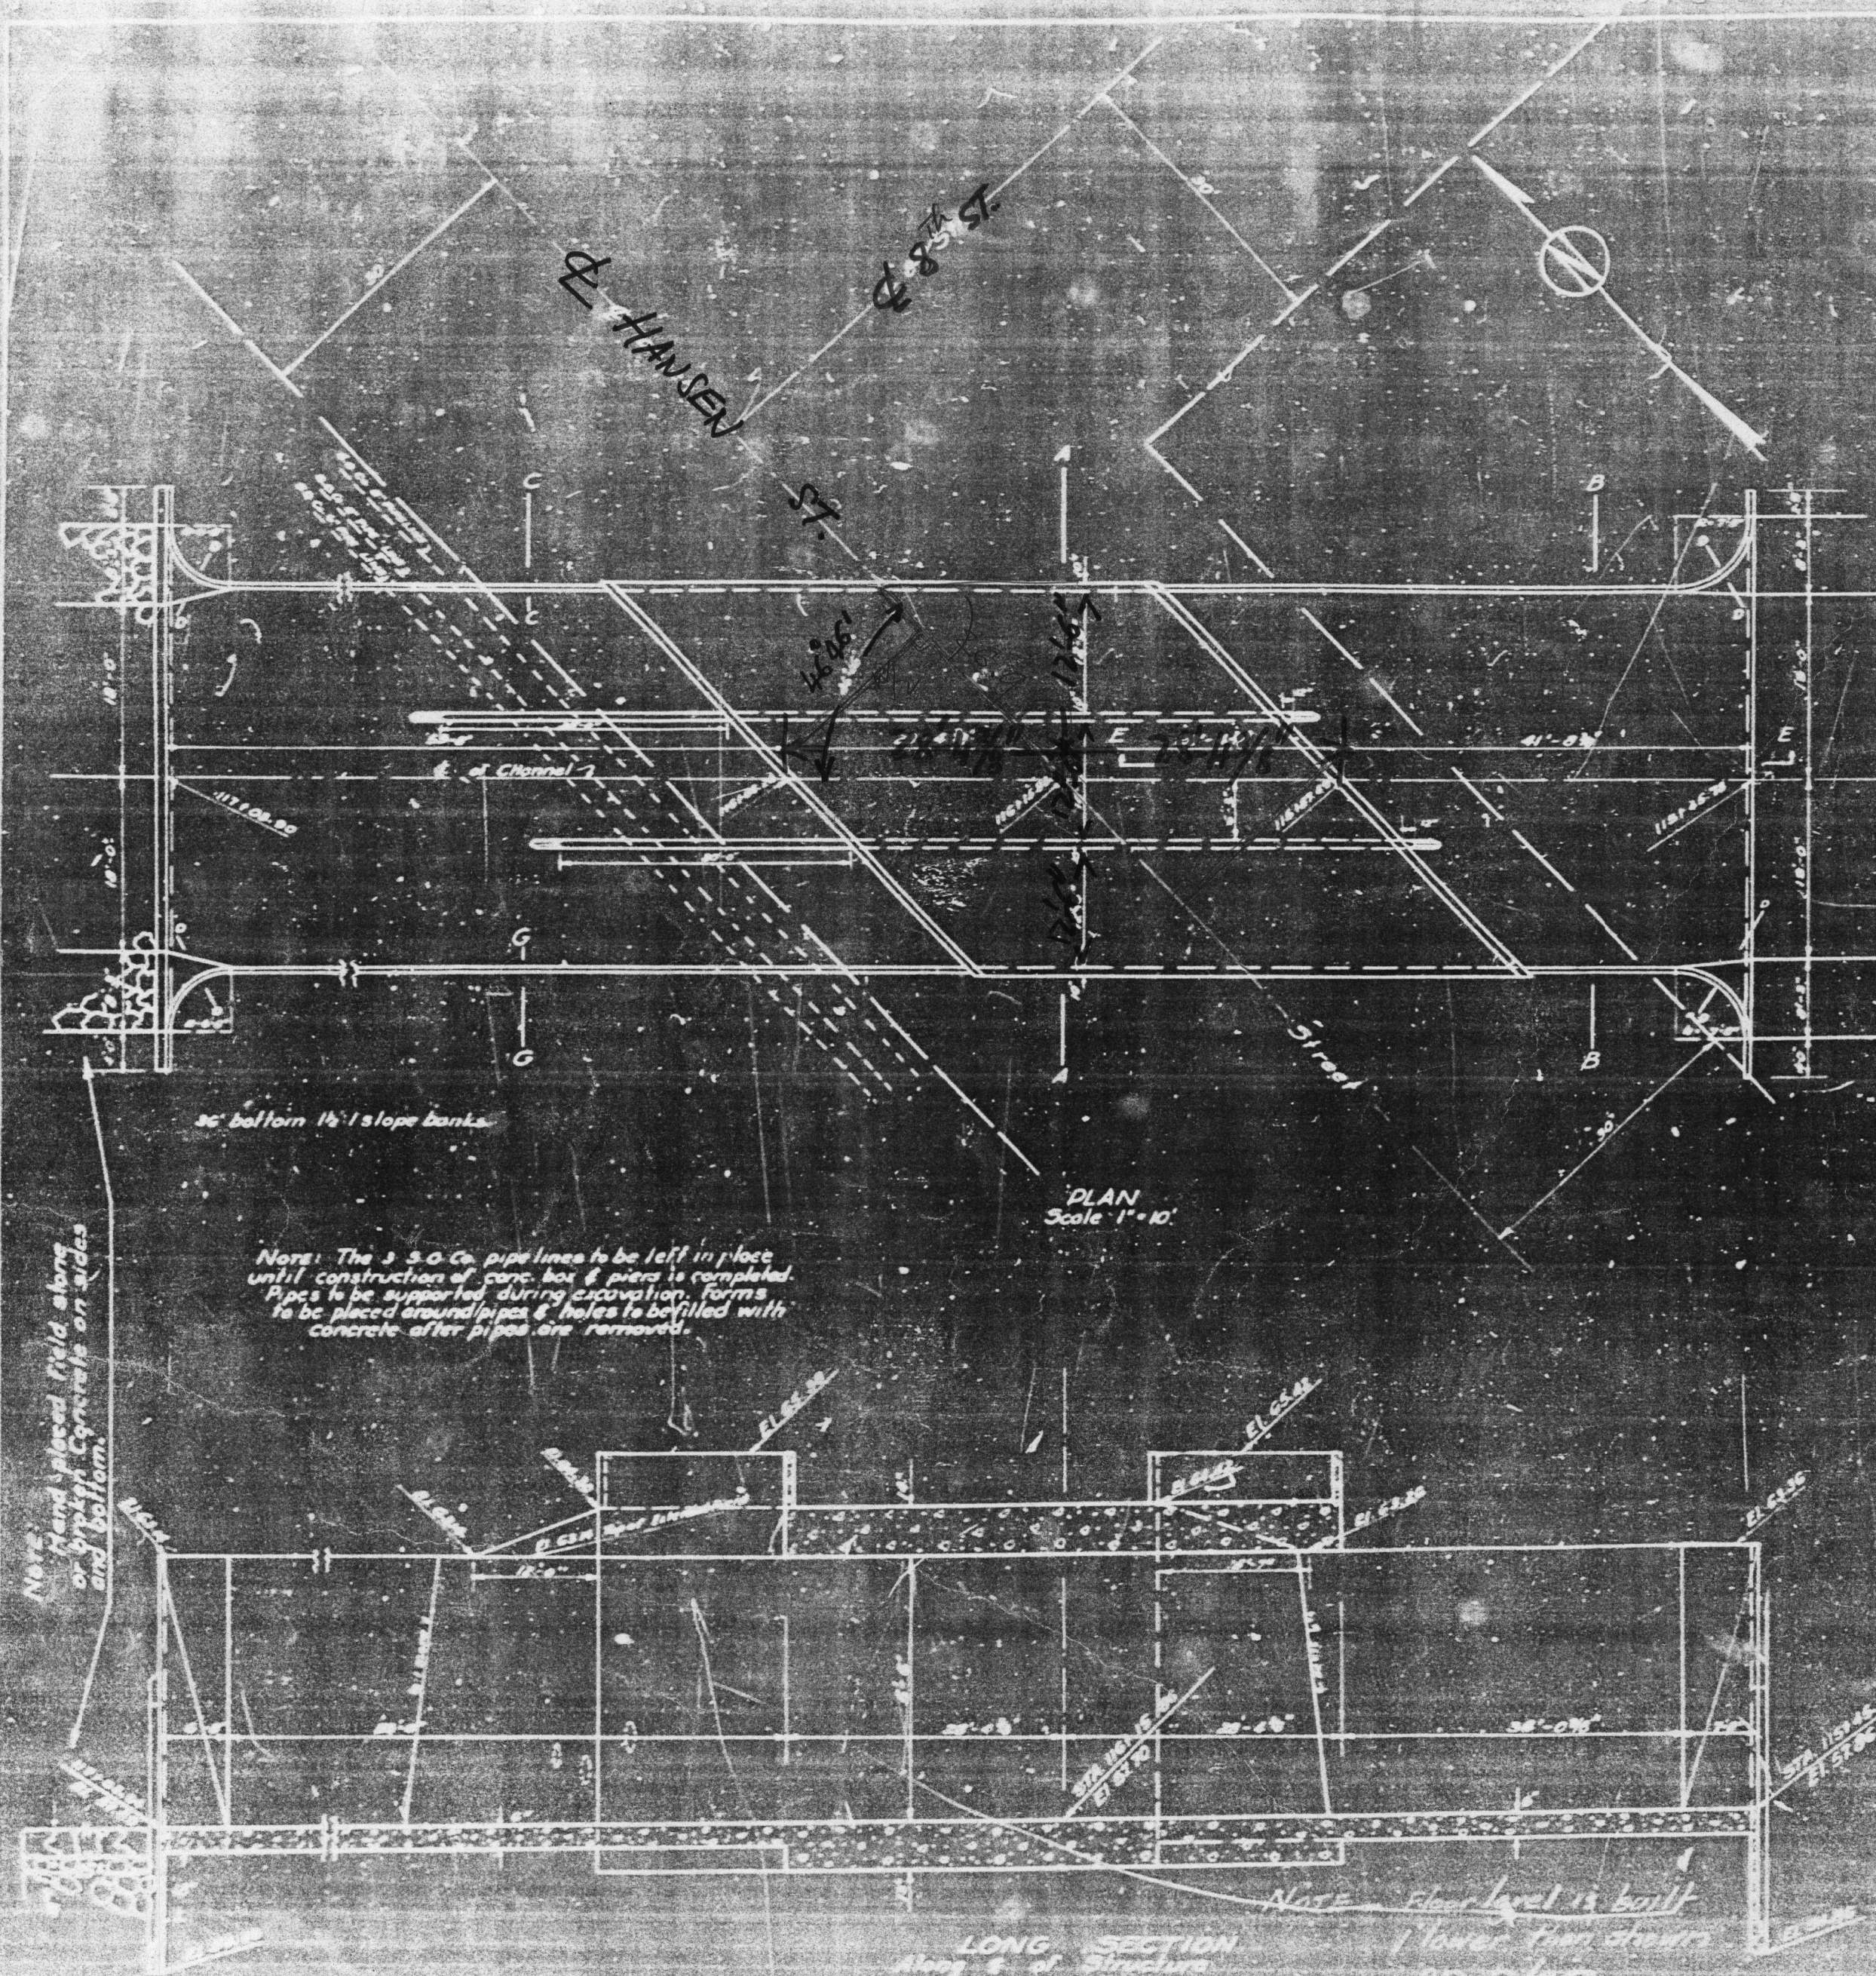


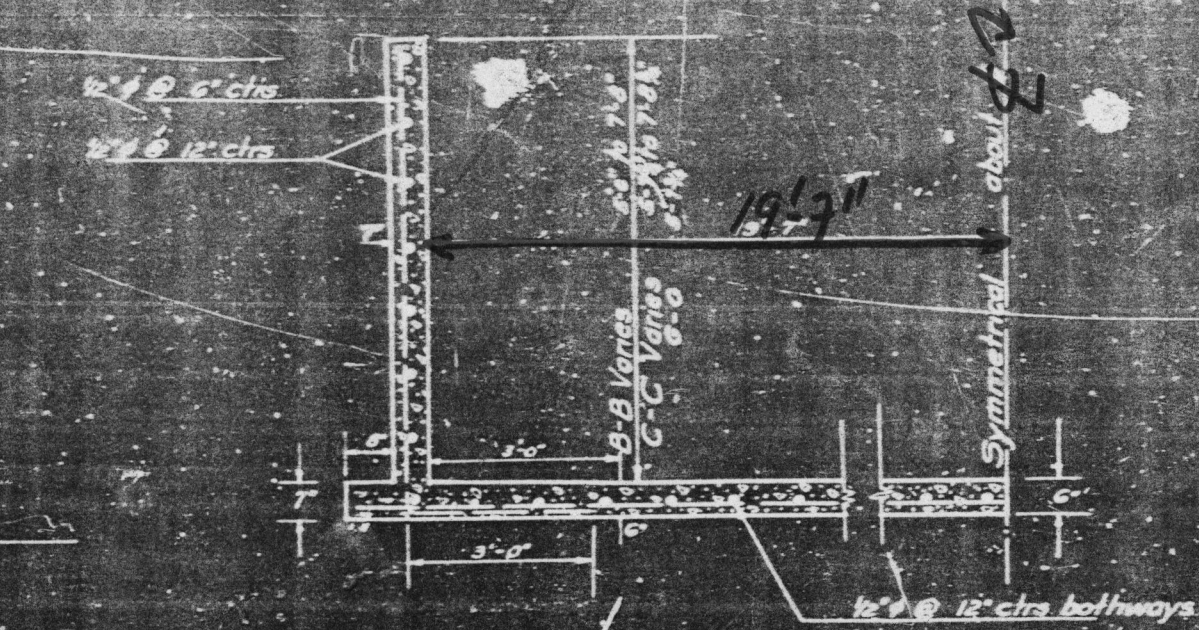


Note: The 3 S.O. Co. pipelines to be left in place until construction of conc. box & piers is completed. Pipes to be supported during excavation. Forms to be placed around pipes & holes to be filled with concrete after pipes are removed.

Note: Hand placed field along or through concrete on sides and bottom.

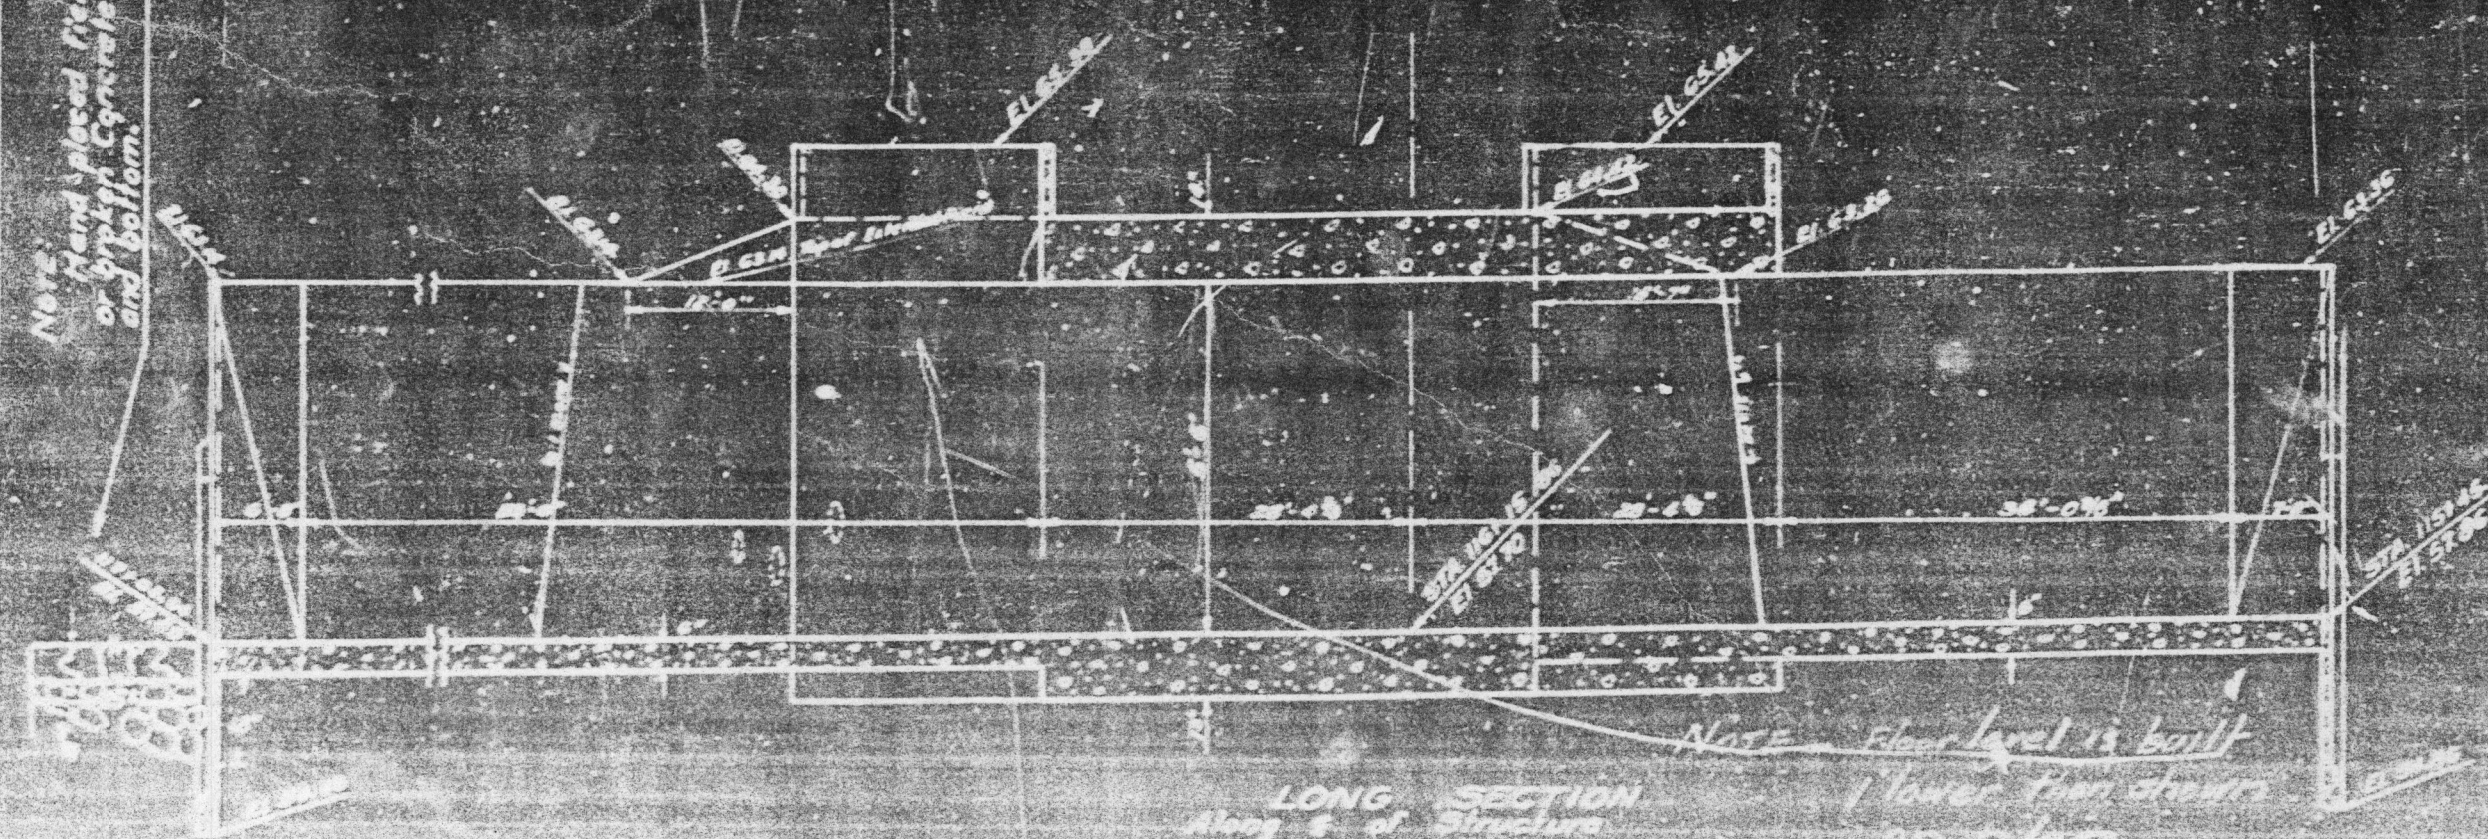

SECTION B-B & C-C
Scale 1/2"=1'-0"

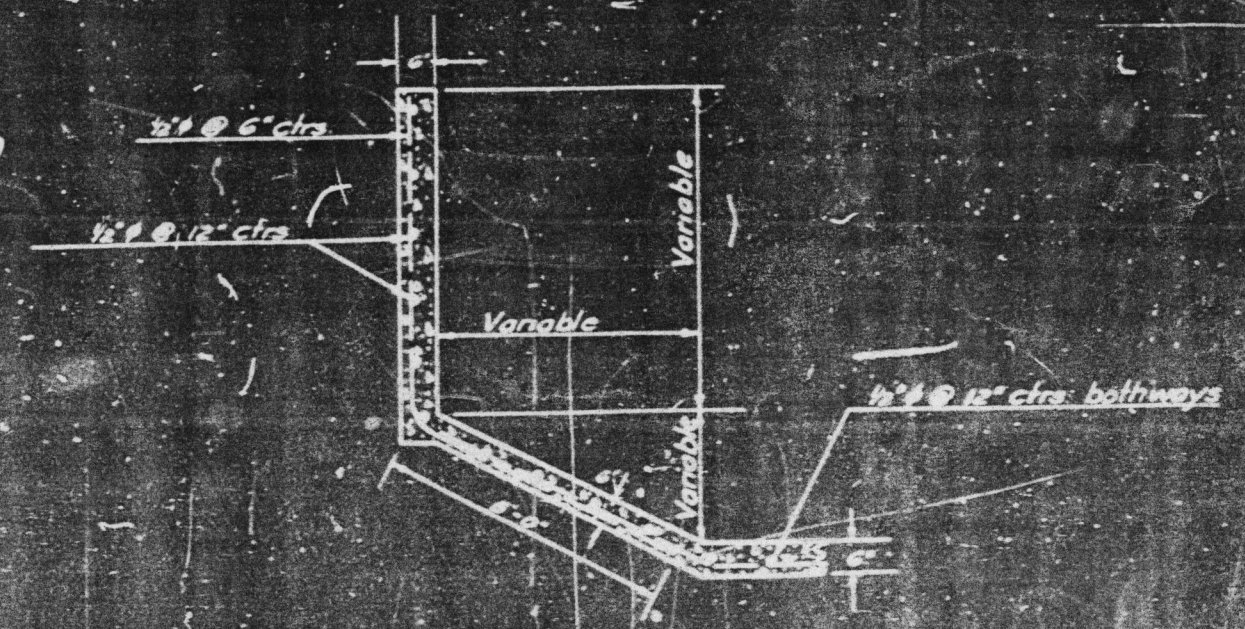

SECTION D-D
Scale 1/2"=1'-0"

Calcut FR-6
Hansen Ave
Sheet 1 of 2
Oct. 22, 1940
Blueprint

SPECIAL LAYOUT #9

ORANGE COUNTY FLOOD CONTROL DISTRICT
FULLERTON RELIEF CH.

Skew : $43^{\circ}14' = 43.23$
 $W = 41.3'$
 $L = 53.7$
 Temp 5'6" x 12'6" RCB, $L = 56.9'$
 Box

HANSEN No. #14522
 O.V. Fullerton Relief Ch. July 1940
 FR-6
 Thomas 739-D7