


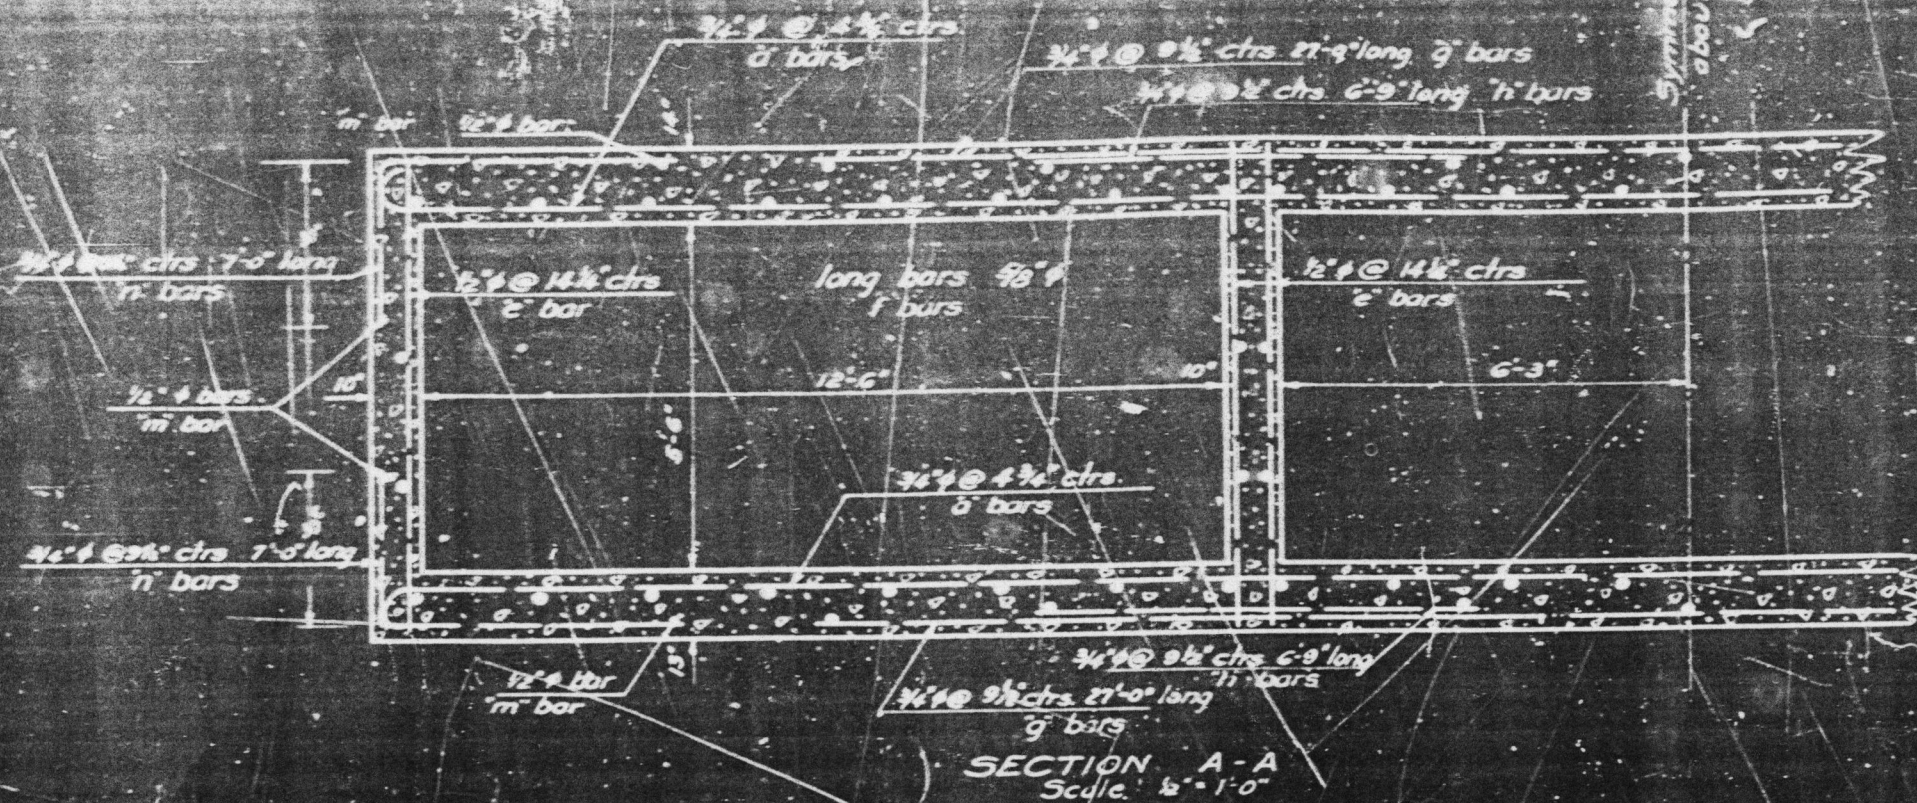


SECTION A-A
Scale: 1/2" = 1'-0"


End of Box
Note: Walls to extend 30'-0" from end of box on downstream end & 1'-0" on upstream side.



SECTION F-F
Scale: 1/2" = 1'-0"

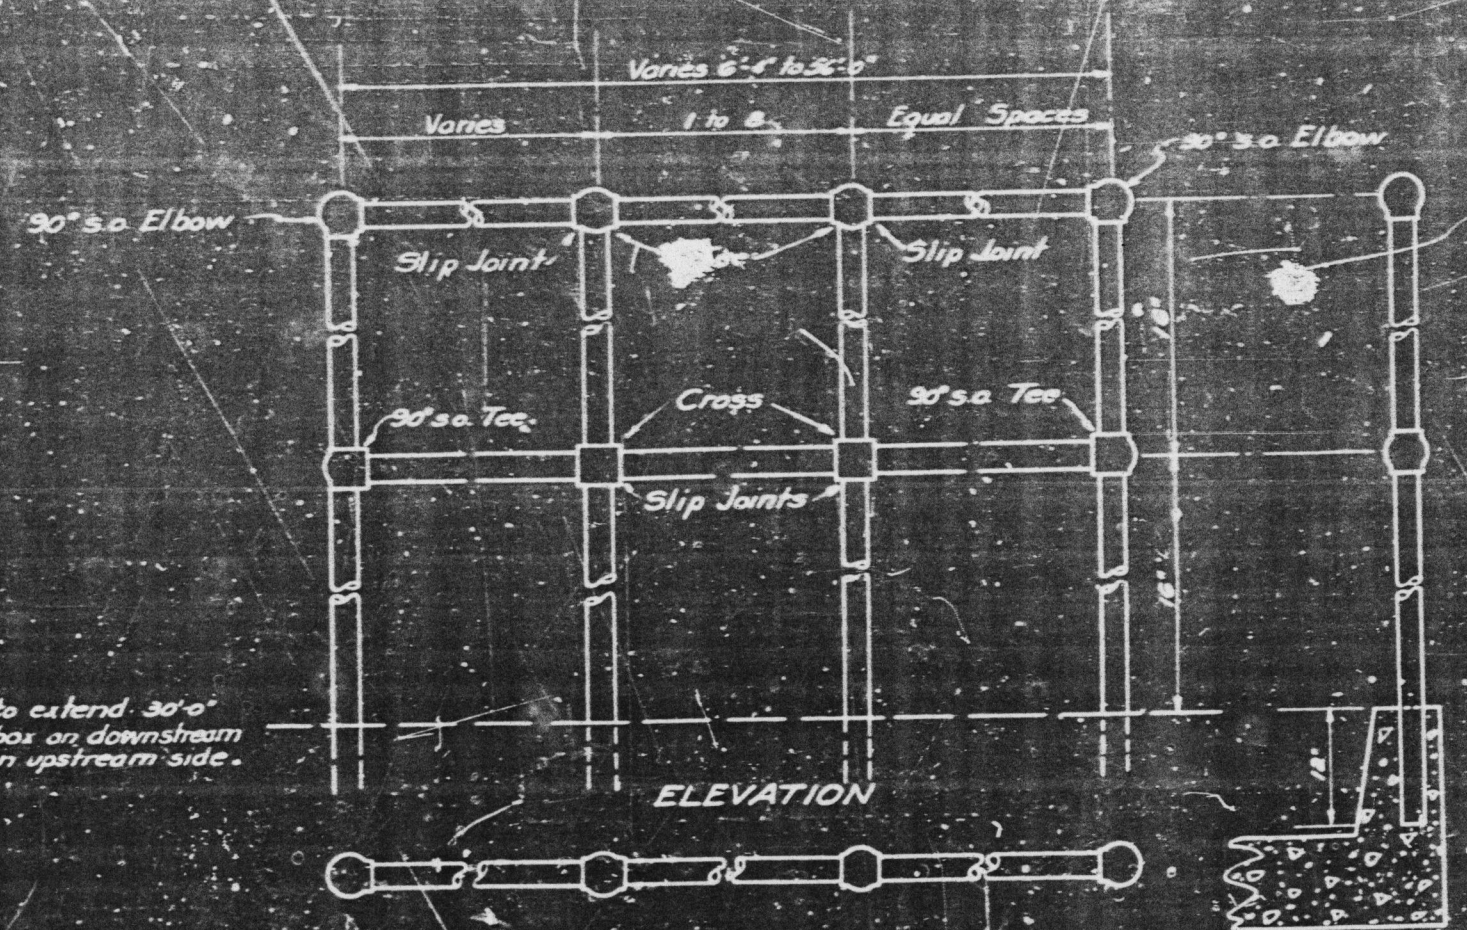


NOTE: Standard 2" Galvanized Iron Pipe. All Fittings 2" Galvanized Iron Railing Fittings. Reamed Where Slip Joints are Shown.

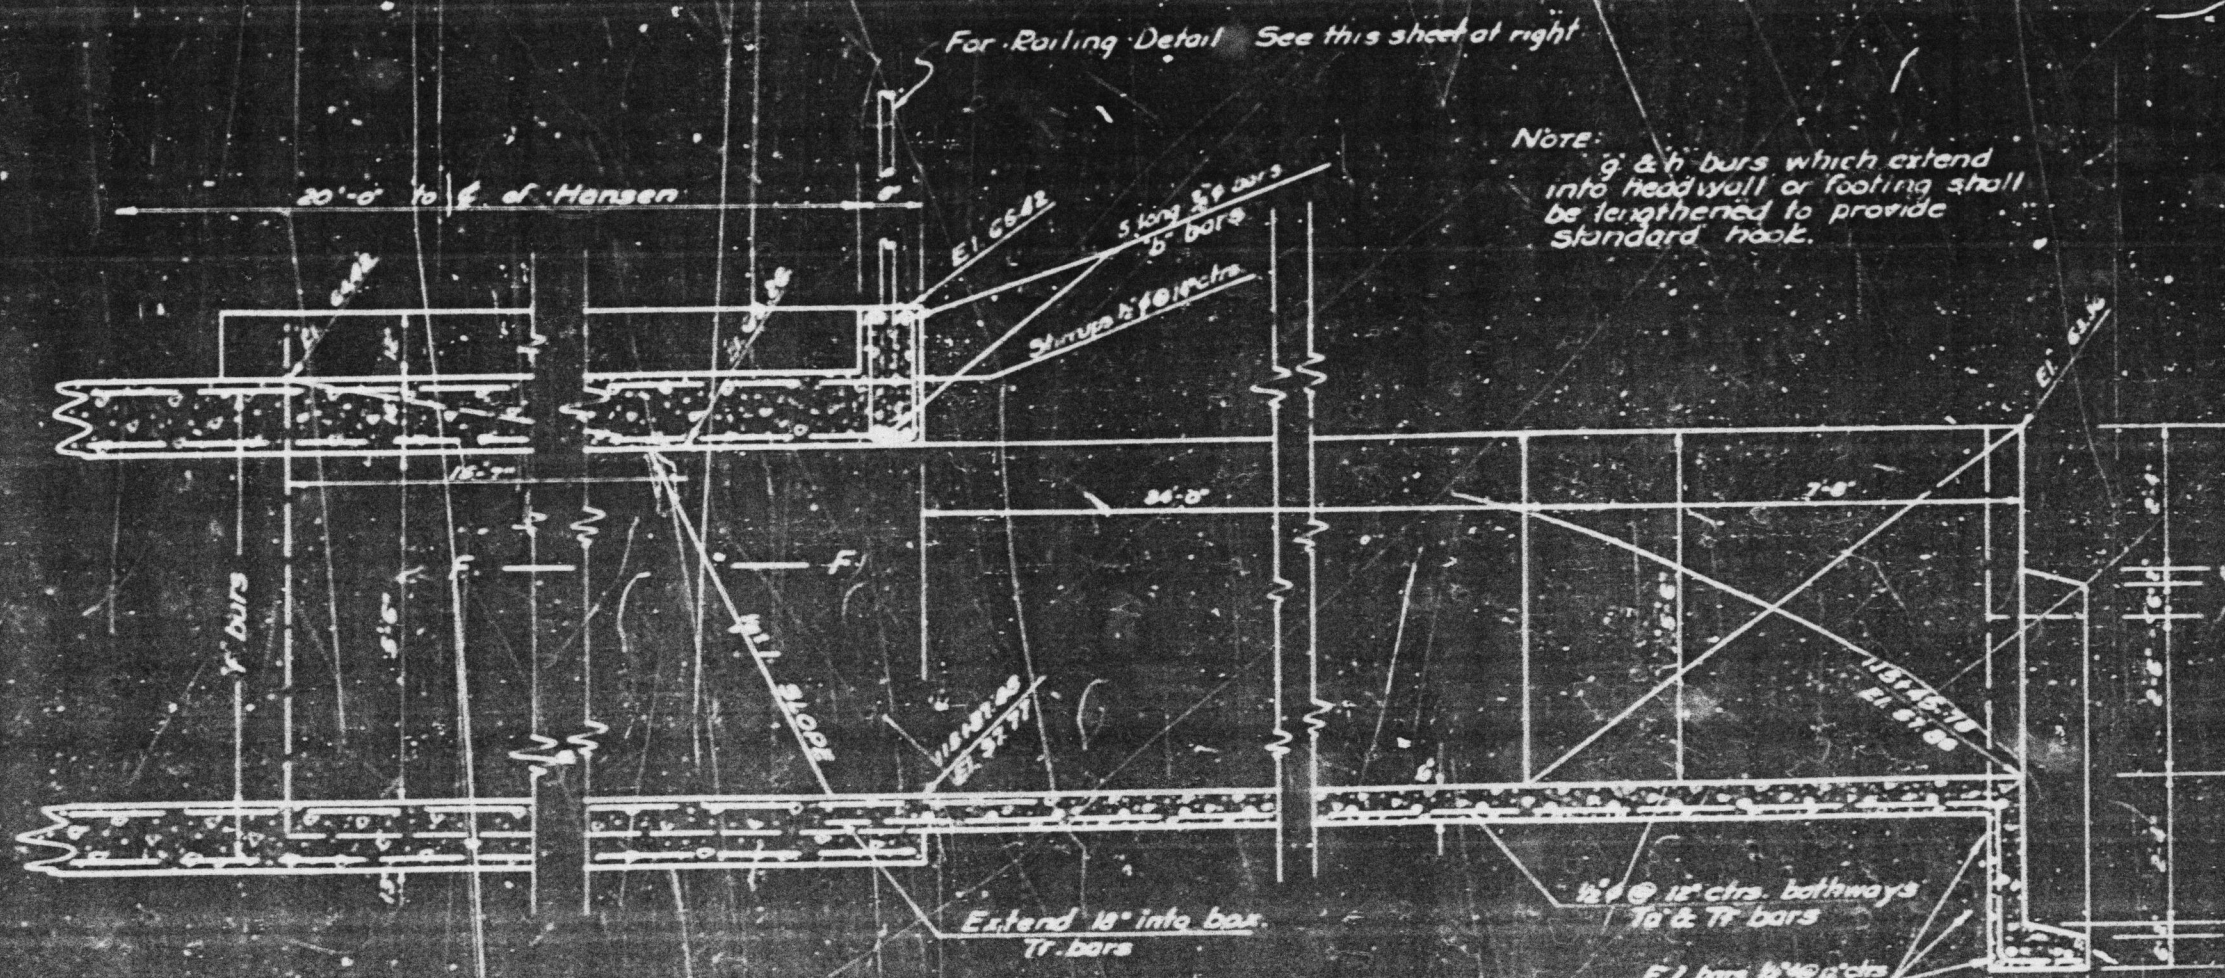

SECTION E-E
Scale: 1/2" = 1'-0"

Note: 1/2" x 14" bars which extend into headwall or footing shall be lengthened to provide standard hook.

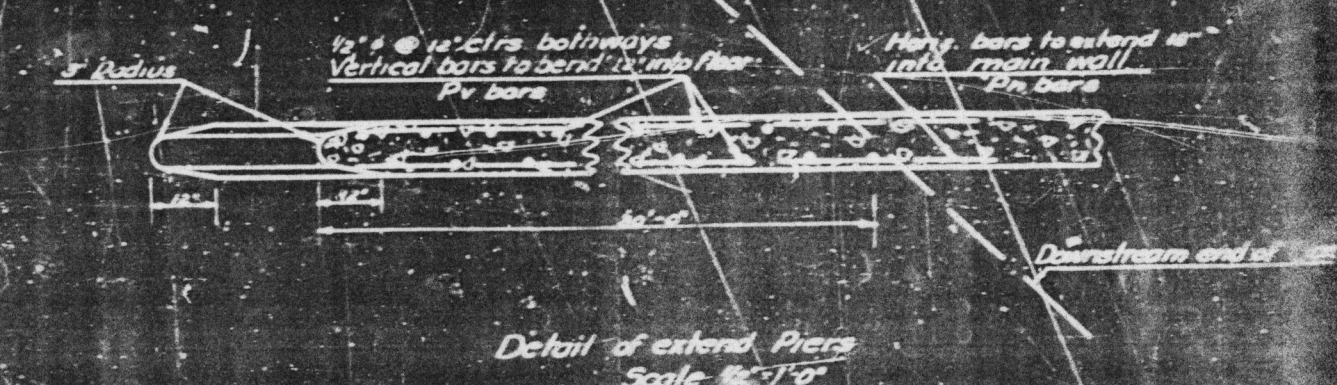

Detail of extend. Piers
Scale: 1/2" = 1'-0"

NOTE: Floor level is built lower than shown on plan

Culvert-FR6
Hansen Ave
Sheet 2 of 2
Rev. 22.5.1 Scale: As Shown
Blueprint

SPECIAL LAYOUT #9