


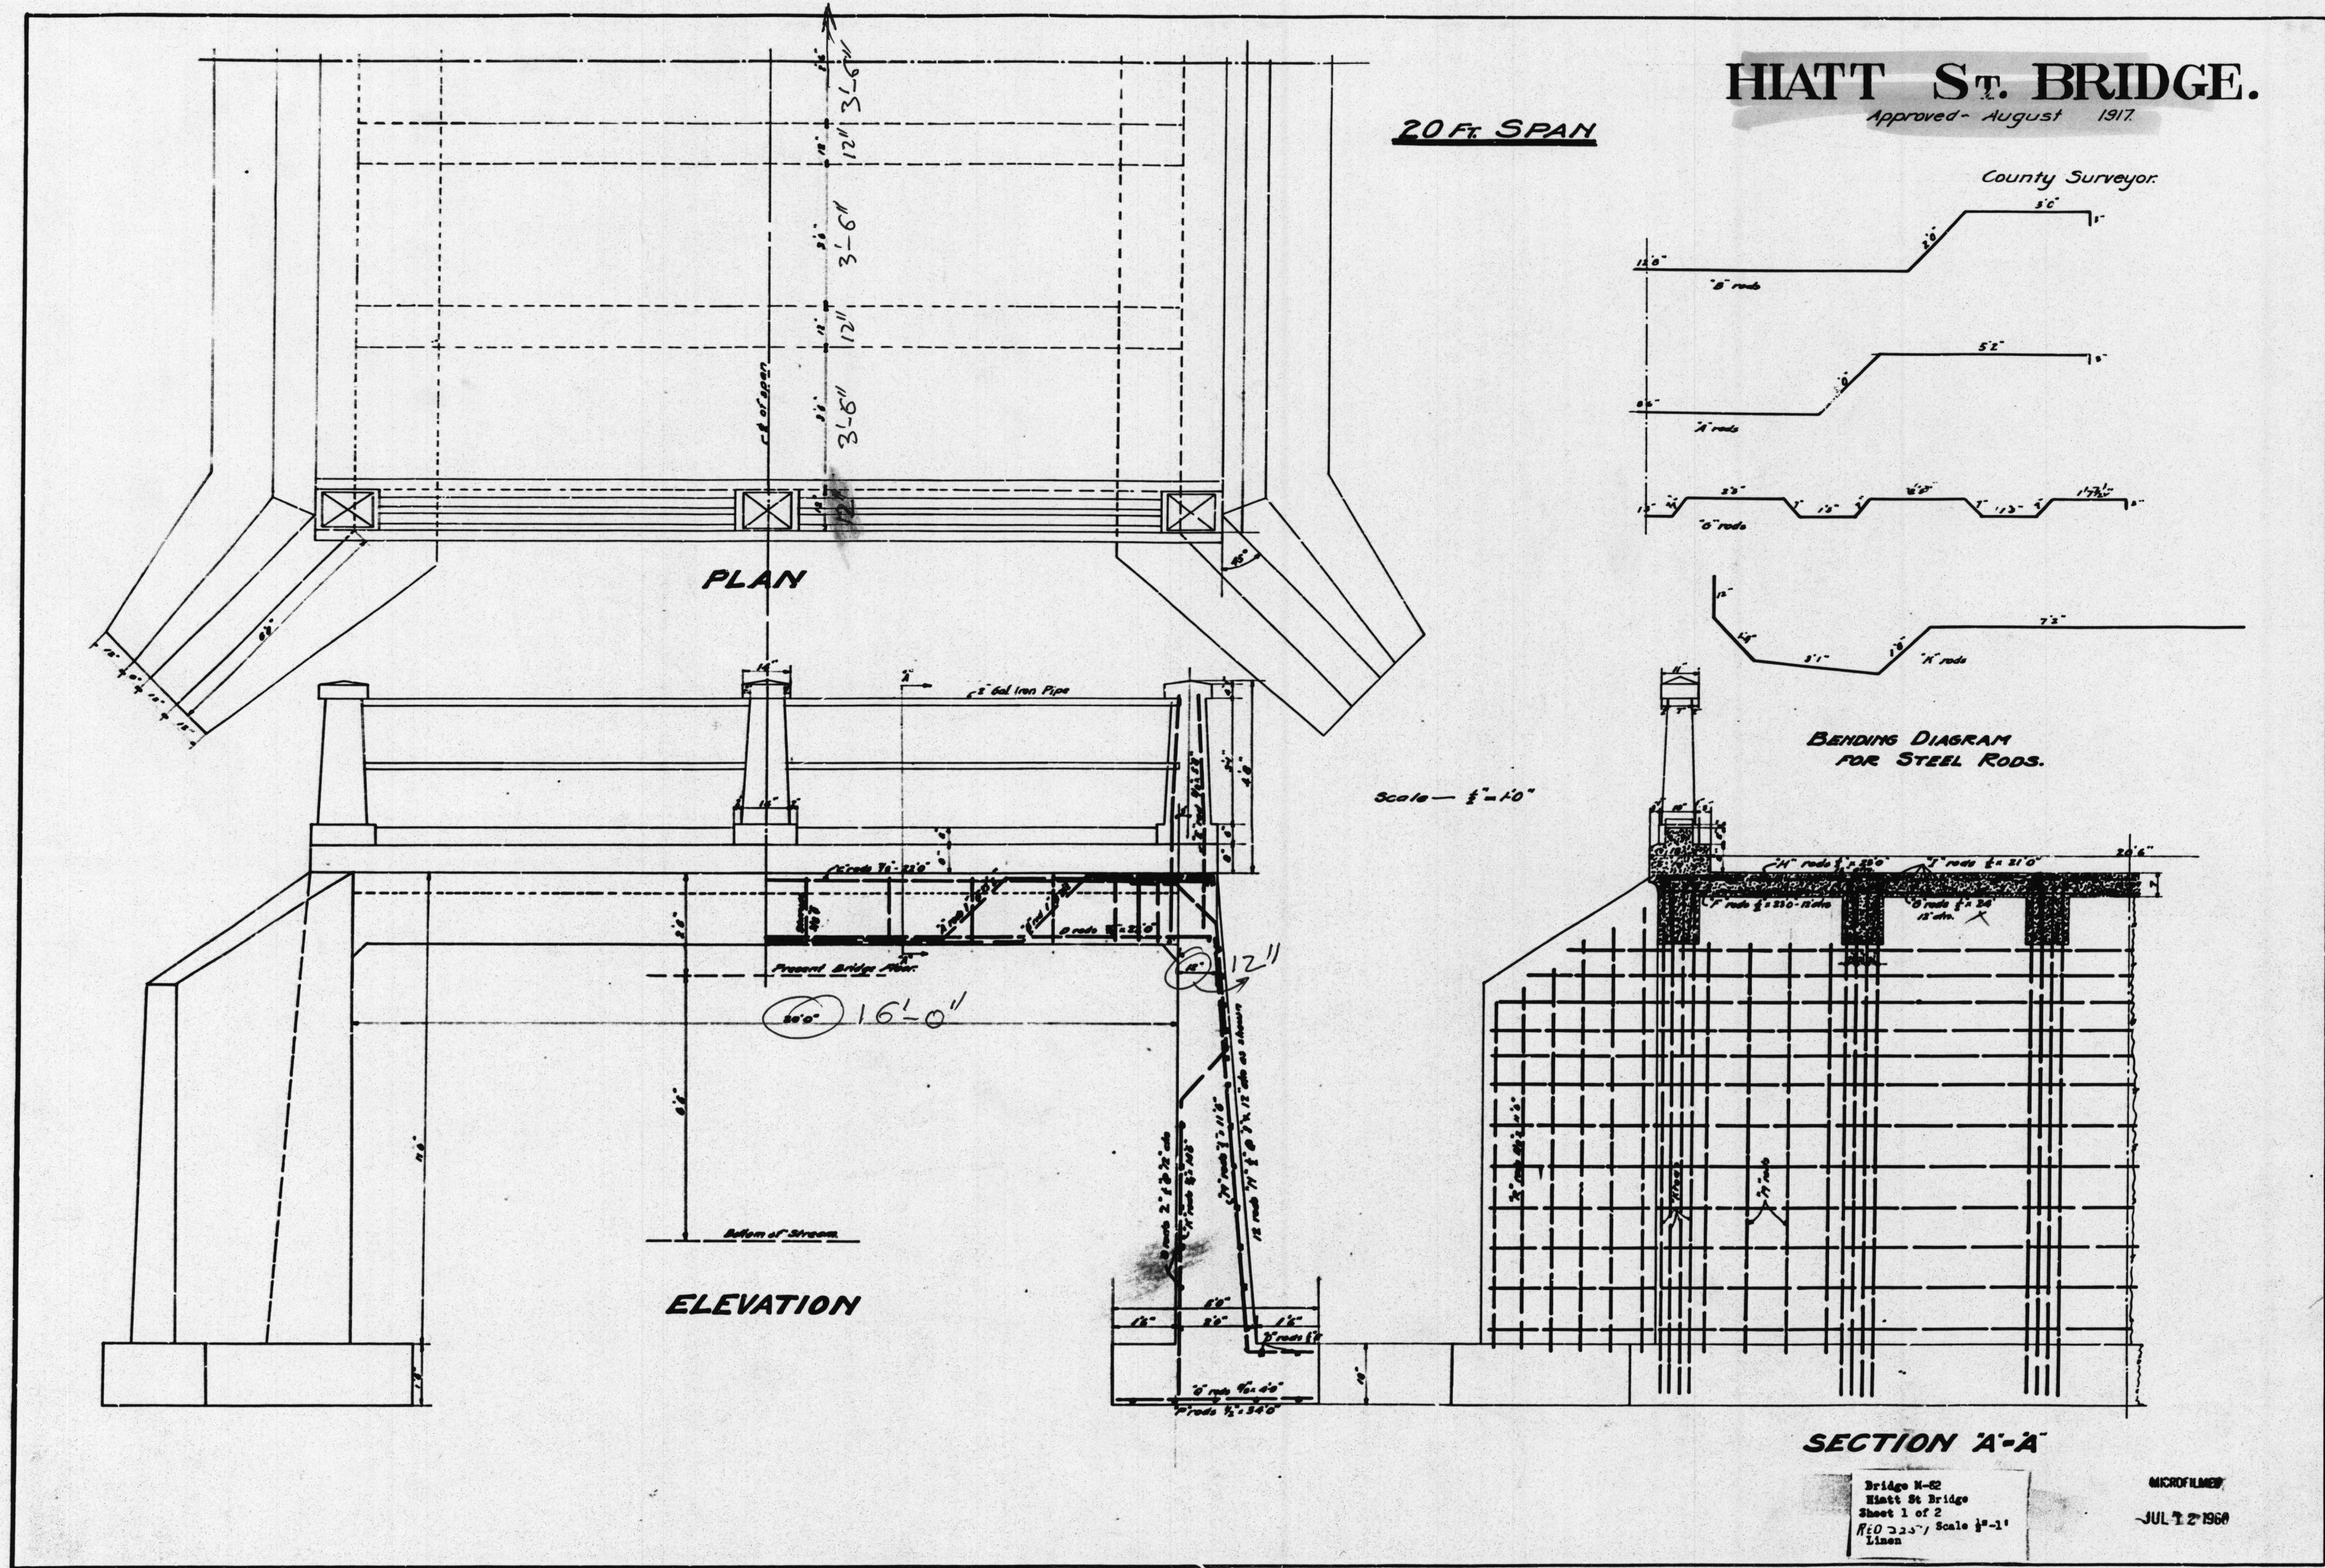

Bridge M-82  
Hiatt St. Bridge  
Sheet 1 of 2  
R/O 333, Scale 1/4"=1'  
Linen

MICROFILMED  
JUL 12 1968

#14532 1917  
M-82

W=23'6"  
L=18'0"  
HIATT ST. BR.

Thoms 708-E3