


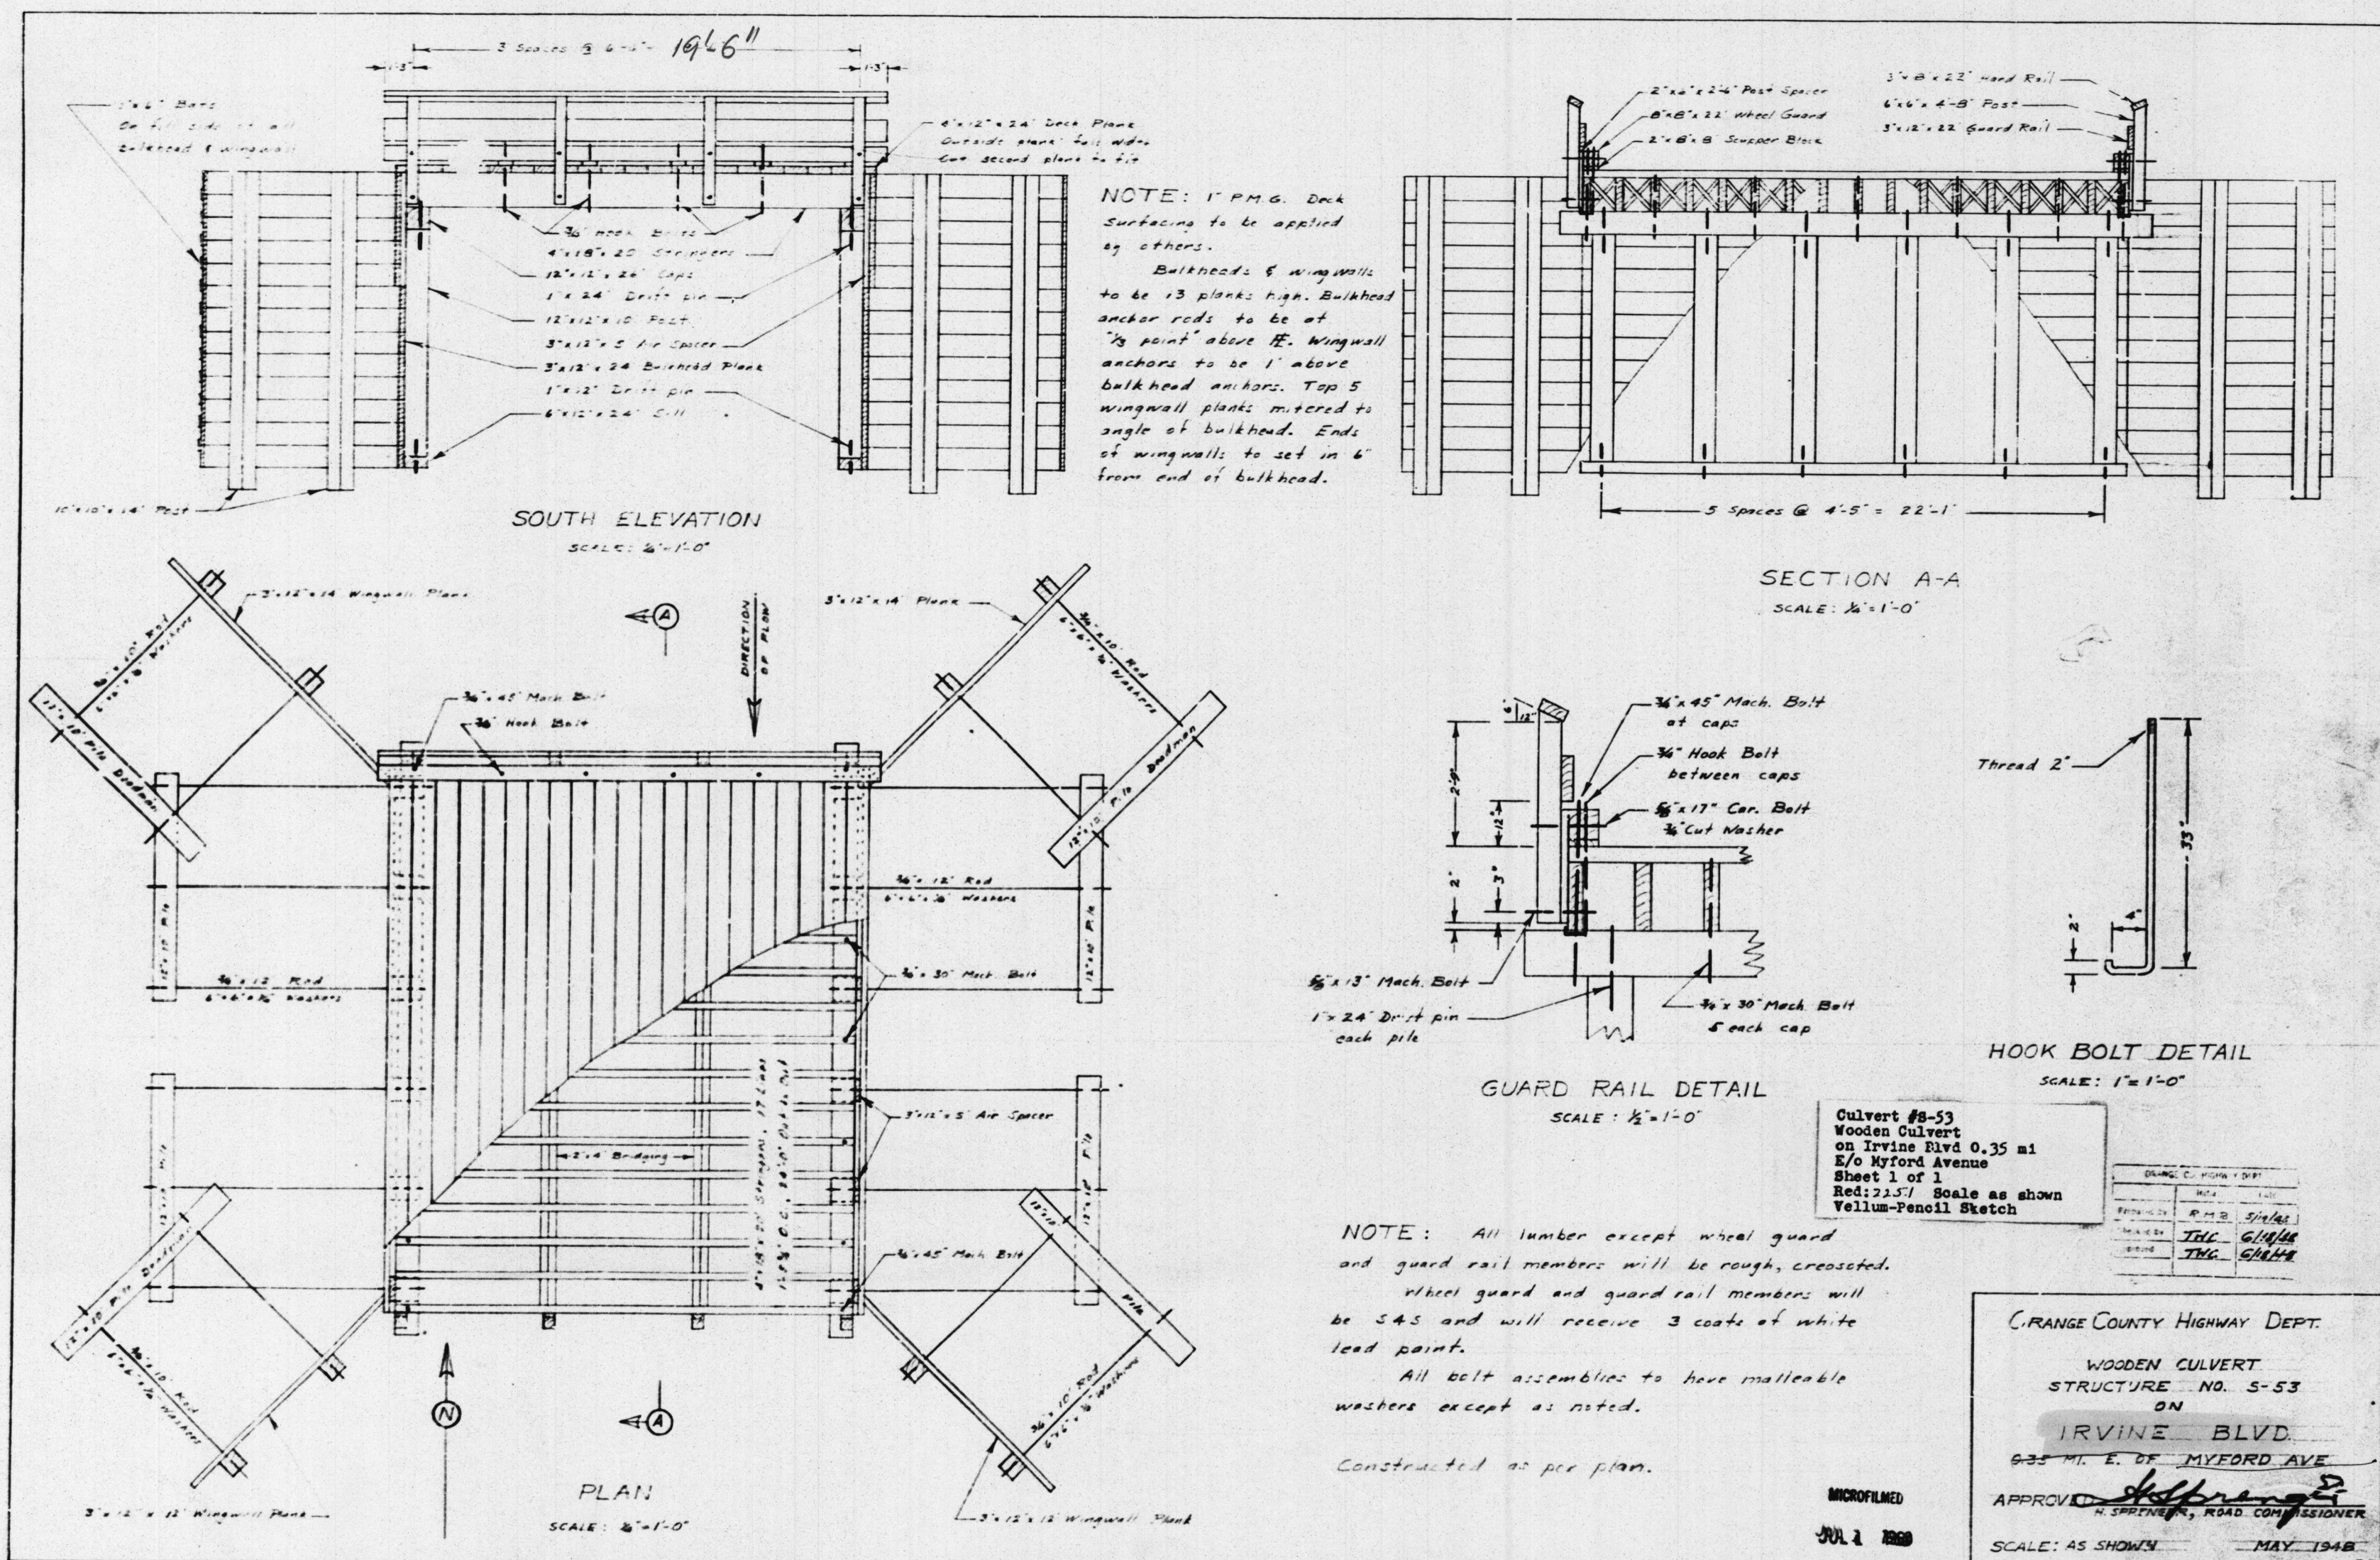

#14567 1948
S-53
IRVINE BVD
Thomas 830-63